
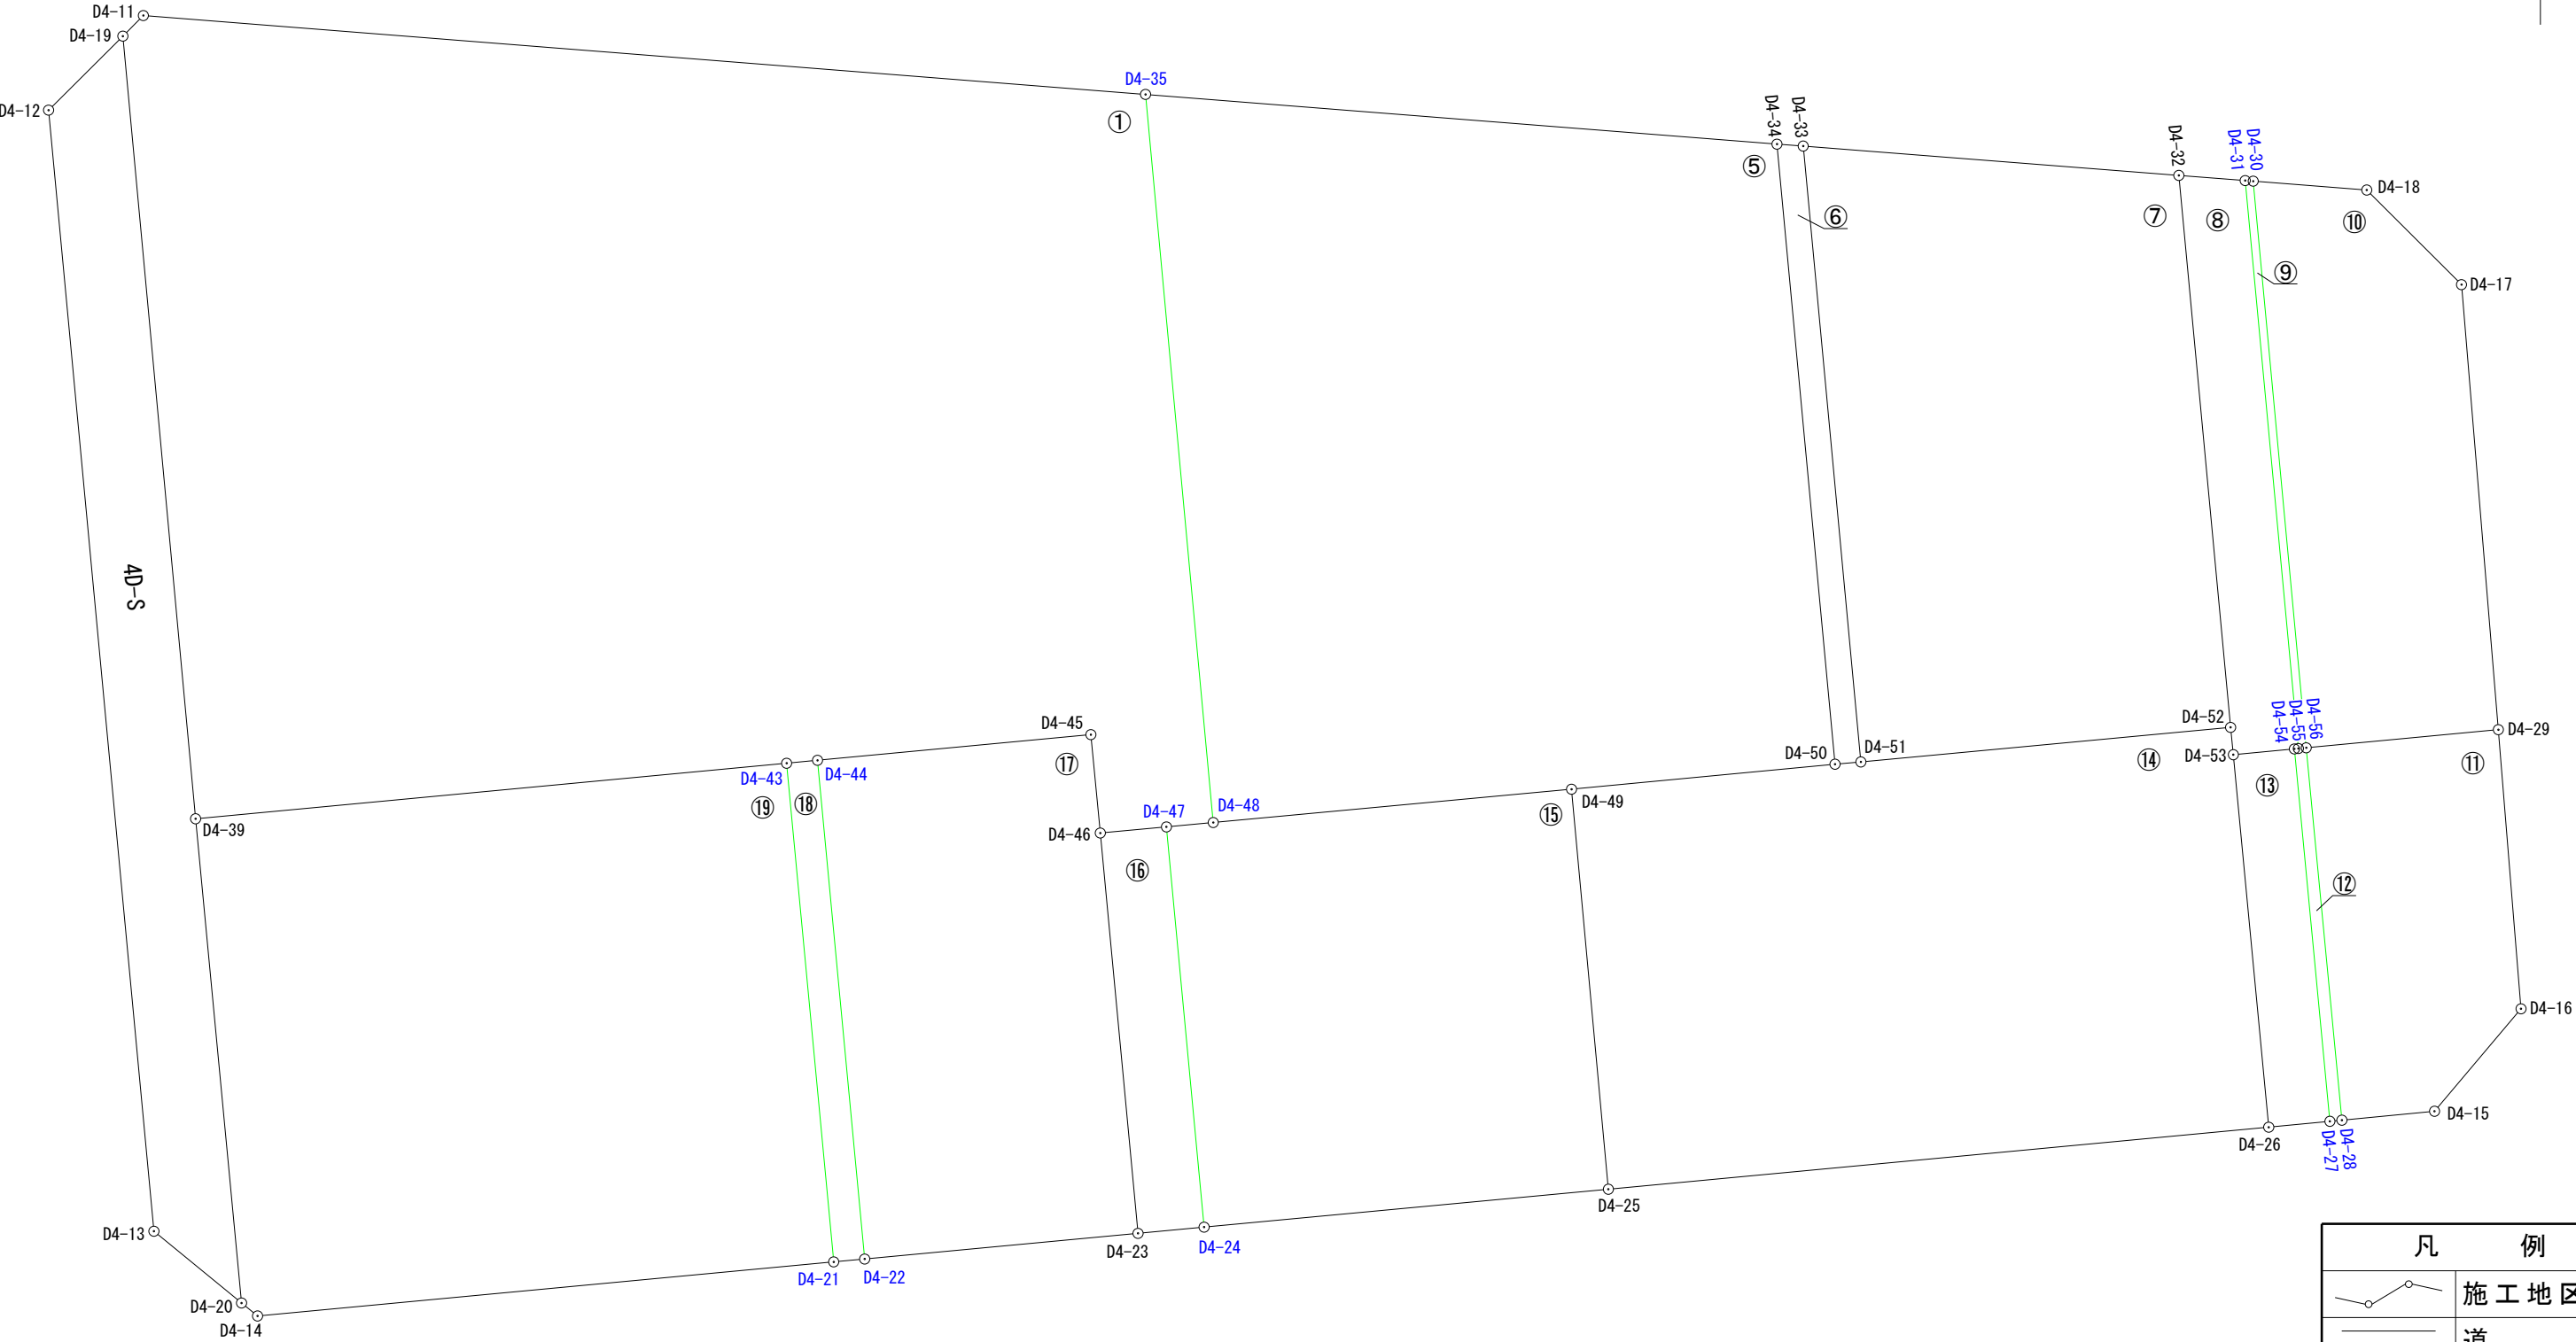


出来形確認測量図（縮尺1：250）

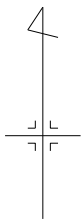

凡 例	
	施工地区界
	道 路
	街区番号
	画地番号
D14-1	計 算 点
D14-2	境界標あり

平成24年 9月21日測量
平成23年10月21日測量

面積（座標法）計算書

地番： 4D-1

測点名	[1] X(i)	[2] X(i+1)-X(i-1)	[3] Y(i)	[4] Y(i+1)-Y(i-1)	[2]*[3]	[1]*[4]	方向角	夾角	距離
D4-11	62090.479	2.174	-7174.558	-38.170	-15597.489092	-2369993.583430	224-44-19	130-14-13	1.085
D4-19	62089.708	-29.982	-7175.322	1.952	215130.504204	121199.110016	174-41-17	129-56-58	29.337
D4-39	62060.497	-27.139	-7172.606	24.774	194657.354234	1537486.752678	84-38-01	89-56-44	22.155
D4-43	62062.569	2.180	-7150.548	23.211	-15588.194640	1440534.289059	84-38-56	180-00-55	1.158
D4-44	62062.677	1.067	-7149.395	11.355	-7628.404465	704721.697335	84-37-48	179-58-52	10.247
D4-45	62063.636	-2.714	-7139.193	10.557	19375.769802	655205.805252	174-28-46	269-50-58	3.690
D4-46	62059.963	-3.443	-7138.838	2.822	24579.019234	175133.215586	84-40-25	90-11-39	2.478
D4-47	62060.193	0.392	-7136.371	4.214	-2797.457432	261521.653302	84-42-08	180-01-43	1.754
D4-48	62060.355	27.341	-7134.624	-0.781	-195067.754784	-48469.137255	354-41-10	89-59-02	27.296
D4-35	62087.534	30.124	-7137.152	-39.934	-214999.566848	-2479403.582756	274-30-06	99-48-56	37.522
合計				倍面積	2063.780213	-2063.780213			136.722
				面積	1031.8901065	1031.8901065			
				坪数	312.14	312.14			

面積（座標法）計算書

地番： 4D-5

測点名	[1] X(i)	[2] X(i+1)-X(i-1)	[3] Y(i)	[4] Y(i+1)-Y(i-1)	[2]*[3]	[1]*[4]	方向角	夾角	距離
D4-35	62087.534	-25.324	-7137.152	-21.040	180741.237248	-1306321.715360	174-41-10	80-11-09	27.296
D4-48	62060.355	-25.935	-7134.624	15.900	185036.473440	986759.644500	84-41-06	89-59-56	13.430
D4-49	62061.599	2.178	-7121.252	23.208	-15510.086856	1440325.589592	84-34-32	179-53-26	9.880
D4-50	62062.533	24.080	-7111.416	7.668	-171242.897280	475895.503044	354-38-56	90-04-24	23.247
D4-34	62085.679	25.001	-7113.584	-25.736	-177846.713584	-1597837.034744	274-30-01	99-51-05	23.641
合計				倍面積	1178.012968	-1178.012968			97.494
				面積	589.0064840	589.0064840			
				坪数	178.17	178.17			

面積（座標法）計算書

地番： 4D-6

測点名	[1] X(i)	[2] X(i+1)-X(i-1)	[3] Y(i)	[4] Y(i+1)-Y(i-1)	[2]*[3]	[1]*[4]	方向角	夾角	距離
D4-34	62085.679	-23.073	-7113.584	1.188	164131.723632	73757.786652	174-38-56	80-23-20	23.247
D4-50	62062.533	-23.060	-7111.416	3.133	163989.252960	194441.915889	84-54-26	90-15-30	0.969
D4-51	62062.619	23.073	-7110.451	-1.188	-164059.435923	-73730.391372	354-38-57	89-44-31	23.088
D4-33	62085.606	23.060	-7112.604	-3.133	-164016.648240	-194514.203598	274-15-36	99-36-39	0.983
合計				倍面積	44.892429	-44.892429			48.287
				面積	22.4462145	22.4462145			
				坪数	6.78	6.78			

面積（座標法）計算書

地番： 4D-7

測点名	[1] X(i)	[2] X(i+1)-X(i-1)	[3] Y(i)	[4] Y(i+1)-Y(i-1)	[2]*[3]	[1]*[4]	方向角	夾角	距離
D4-33	62085.606	-21.892	-7112.604	-11.868	155709.126768	-736831.972008	174-38-57	80-11-01	23.088
D4-51	62062.619	-21.698	-7110.451	15.950	154282.565798	989898.773050	84-39-45	90-00-48	13.857
D4-52	62063.908	21.892	-7096.654	11.868	-155359.949368	736574.460144	354-39-04	89-59-19	20.693
D4-32	62084.511	21.698	-7098.583	-15.950	-154025.053934	-990247.950450	274-27-56	99-48-52	14.064
合計				倍面積	606.689264	-606.689264			71.702
				面積	303.3446320	303.3446320			
				坪数	91.76	91.76			

面積（座標法）計算書

地 番： 4D-8

測点名	[1] X(i)	[2] X(i+1)-X(i-1)	[3] Y(i)	[4] Y(i+1)-Y(i-1)	[2]*[3]	[1]*[4]	方向角	夾 角	距 離
D4-32	62084.511	-20.410	-7098.583	-0.545	144882.079030	-33836.058495	174-39-04	80-11-26	20.693
D4-52	62063.908	-21.622	-7096.654	2.030	153443.852788	125989.733240	174-20-22	179-41-18	1.024
D4-53	62062.889	-0.804	-7096.553	2.383	5705.628612	147895.864487	84-37-04	90-16-42	2.292
D4-54	62063.104	0.228	-7094.271	2.429	-1617.493788	150751.279616	84-56-46	180-19-42	0.148
D4-55	62063.117	21.214	-7094.124	-1.838	-150494.746536	-114072.009046	354-39-04	89-42-18	21.294
D4-31	62084.318	21.394	-7096.109	-4.459	-151814.155946	-276833.973962	274-27-38	99-48-34	2.482
合計				倍面積	105.164160	-105.164160			47.933
				面 積	52.5820800	52.5820800			
				坪 数	15.90	15.90			

面積（座標法）計算書

地番：4D-9

測点名	[1] X(i)	[2] X(i+1)-X(i-1)	[3] Y(i)	[4] Y(i+1)-Y(i-1)	[2]*[3]	[1]*[4]	方向角	夾角	距離
D4-31	62084.318	-21.178	-7096.109	1.685	150281.396402	104612.075830	174-39-04	80-16-01	21.294
D4-55	62063.117	-21.173	-7094.124	2.281	150203.887452	141565.969877	84-35-46	89-56-42	0.297
D4-56	62063.145	21.178	-7093.828	-1.685	-150233.089384	-104576.399325	354-38-57	90-03-11	21.243
D4-30	62084.295	21.173	-7095.809	-2.281	-150239.563957	-141614.276895	274-23-03	99-44-06	0.301
合計				倍面積	12.630513	-12.630513			43.135
				面積	6.3152565	6.3152565			
				坪数	1.91	1.91			

面積（座標法）計算書

地番：4D-10

測点名	[1] X(i)	[2] X(i+1)-X(i-1)	[3] Y(i)	[4] Y(i+1)-Y(i-1)	[2]*[3]	[1]*[4]	方向角	夾角	距離
D4-30	62084.295	-20.821	-7095.809	-2.257	147741.839189	-140124.253815	174-38-57	80-12-37	21.243
D4-56	62063.145	-20.476	-7093.828	9.149	145253.222128	567815.713605	84-37-42	89-58-45	7.200
D4-29	62063.819	17.288	-7086.660	5.794	-122514.178080	359597.767286	355-16-20	90-38-38	16.671
D4-17	62080.433	20.147	-7088.034	-4.911	-142802.620998	-304877.006463	314-58-03	139-41-43	4.999
D4-18	62083.966	3.862	-7091.571	-7.775	-27387.647202	-482702.835650	274-26-20	139-28-17	4.251
合計				倍面積	290.615037	-290.615037			54.364
				面積	145.3075185	145.3075185			
				坪数	43.95	43.95			

面積（座標法）計算書

地番：4D-11

測点名	[1] X(i)	[2] X(i+1)-X(i-1)	[3] Y(i)	[4] Y(i+1)-Y(i-1)	[2]*[3]	[1]*[4]	方向角	夾角	距離
D4-56	62063.145	-14.573	-7093.828	-5.839	103378.355444	-362386.703655	174-32-17	89-54-35	13.962
D4-28	62049.246	-13.568	-7092.499	4.785	96231.026432	296905.642110	84-31-45	89-59-28	3.472
D4-15	62049.577	4.158	-7089.043	6.684	-29476.240794	414739.372668	40-08-49	135-37-04	5.007
D4-16	62053.404	14.242	-7085.815	2.383	-100916.177230	147873.261732	355-21-42	135-12-53	10.449
D4-29	62063.819	9.741	-7086.660	-8.013	-69031.155060	-497317.381647	264-37-42	89-16-00	7.200
合計				倍面積	185.808792	-185.808792			40.090
				面積	92.9043960	92.9043960			
				坪数	28.10	28.10			

面積（座標法）計算書

地番： 4D-12

測点名	[1] X(i)	[2] X(i+1)-X(i-1)	[3] Y(i)	[4] Y(i+1)-Y(i-1)	[2]*[3]	[1]*[4]	方向角	夾角	距離
D4-54	62063.104	-13.914	-7094.271	1.176	98709.686694	72986.210304	174-33-48	89-37-02	13.964
D4-27	62049.203	-13.858	-7092.948	1.772	98294.073384	109951.187716	84-31-46	89-57-58	0.451
D4-28	62049.246	13.942	-7092.499	-0.880	-98883.621058	-54603.336480	354-32-17	90-00-31	13.962
D4-56	62063.145	13.871	-7093.828	-1.625	-98398.488188	-100852.610625	264-35-46	90-03-29	0.297
D4-55	62063.117	-0.041	-7094.124	-0.443	290.859084	-27493.960831	264-56-46	180-21-00	0.148
合計				倍面積	12.509916	-12.509916			28.822
				面積	6.2549580	6.2549580			
				坪数	1.89	1.89			

面積（座標法）計算書

地番：4D-13

測点名	[1] X(i)	[2] X(i+1)-X(i-1)	[3] Y(i)	[4] Y(i+1)-Y(i-1)	[2]*[3]	[1]*[4]	方向角	夾角	距離
D4-53	62062.889	-14.120	-7096.553	-0.959	100203.328360	-59518.310551	174-33-54	89-56-50	13.968
D4-26	62048.984	-13.686	-7095.230	3.605	97105.317780	223686.587320	84-31-06	89-57-12	2.292
D4-27	62049.203	14.120	-7092.948	0.959	-100152.425760	59505.185677	354-33-48	90-02-42	13.964
D4-54	62063.104	13.686	-7094.271	-3.605	-97092.192906	-223737.489920	264-37-04	90-03-16	2.292
合計				倍面積	64.027474	-64.027474			32.516
				面積	32.0137370	32.0137370			
				坪数	9.68	9.68			

面積（座標法）計算書

地番： 4D-14

測点名	[1] X(i)	[2] X(i+1)-X(i-1)	[3] Y(i)	[4] Y(i+1)-Y(i-1)	[2]*[3]	[1]*[4]	方向角	夾角	距離
D4-49	62061.599	-15.864	-7121.252	-8.461	112971.541728	-525103.189139	174-44-17	90-09-45	14.993
D4-25	62046.669	-12.615	-7119.877	26.022	89817.248355	1614578.420718	84-38-03	89-53-46	24.755
D4-26	62048.984	16.220	-7095.230	23.324	-115084.630600	1447230.502816	354-33-54	89-55-51	13.968
D4-53	62062.889	14.924	-7096.553	-1.424	-105908.956972	-88377.553936	354-20-22	179-46-28	1.024
D4-52	62063.908	-0.270	-7096.654	-13.898	1916.096580	-862564.193384	264-39-45	90-19-23	13.857
D4-51	62062.619	-1.375	-7110.451	-14.762	9776.870125	-916168.381678	264-54-26	180-14-41	0.969
D4-50	62062.533	-1.020	-7111.416	-10.801	7253.644320	-670337.418933	264-34-32	179-40-06	9.880
合計				倍面積	741.813536	-741.813536			79.446
				面積	370.9067680	370.9067680			
				坪数	112.19	112.19			

面積（座標法）計算書

地番： 4D-15

測点名	[1] X(i)	[2] X(i+1)-X(i-1)	[3] Y(i)	[4] Y(i+1)-Y(i-1)	[2]*[3]	[1]*[4]	方向角	夾角	距離
D4-47	62060.193	-15.102	-7136.371	-0.342	107773.474842	-21224.586006	174-37-39	89-55-31	15.006
D4-24	62045.253	-13.524	-7134.966	16.494	96493.280184	1023374.402982	84-38-20	90-00-41	15.155
D4-25	62046.669	16.346	-7119.877	13.714	-116381.509442	850908.018666	354-44-17	90-05-57	14.993
D4-49	62061.599	13.686	-7121.252	-14.747	-97461.454872	-915222.400453	264-41-06	89-56-49	13.430
D4-48	62060.355	-1.406	-7134.624	-15.119	10031.281344	-938290.507245	264-42-08	180-01-02	1.754
合計				倍面積	455.072056	-455.072056			60.338
				面積	227.5360280	227.5360280			
				坪数	68.82	68.82			

面積（座標法）計算書

地番：4D-16

測点名	[1] X(i)	[2] X(i+1)-X(i-1)	[3] Y(i)	[4] Y(i+1)-Y(i-1)	[2]*[3]	[1]*[4]	方向角	夾角	距離
D4-46	62059.963	-15.173	-7138.838	-1.062	108317.588974	-65907.680706	174-37-43	89-57-18	15.009
D4-23	62045.020	-14.710	-7137.433	3.872	104991.639430	240238.317440	84-36-17	89-58-34	2.478
D4-24	62045.253	15.173	-7134.966	1.062	-108258.839118	65892.058686	354-37-39	90-01-22	15.006
D4-47	62060.193	14.710	-7136.371	-3.872	-104976.017410	-240297.067296	264-40-25	90-02-46	2.478
合計				倍面積	74.371876	-74.371876			34.971
				面積	37.1859380	37.1859380			
				坪数	11.24	11.24			

面積（座標法）計算書

地番：4D-17

測点名	[1] X(i)	[2] X(i+1)-X(i-1)	[3] Y(i)	[4] Y(i+1)-Y(i-1)	[2]*[3]	[1]*[4]	方向角	夾角	距離
D4-44	62062.677	-19.572	-7149.395	-8.442	139927.958940	-523933.119234	174-35-54	89-58-06	18.696
D4-22	62044.064	-17.657	-7147.635	11.962	126205.791195	742171.093568	84-38-48	90-02-54	10.247
D4-23	62045.020	15.899	-7137.433	8.797	-113478.047267	545810.040940	354-37-43	89-58-55	15.009
D4-46	62059.963	18.616	-7138.838	-1.760	-132896.608208	-109225.534880	354-28-46	179-51-03	3.690
D4-45	62063.636	2.714	-7139.193	-10.557	-19375.769802	-655205.805252	264-37-48	90-09-02	10.247
合計				倍面積	383.324858	-383.324858			57.889
				面積	191.6624290	191.6624290			
				坪数	57.97	57.97			

面積（座標法）計算書

地 番： 4D-18

測点名	[1] X(i)	[2] X(i+1)-X(i-1)	[3] Y(i)	[4] Y(i+1)-Y(i-1)	[2]*[3]	[1]*[4]	方向角	夾 角	距 離
D4-43	62062.569	-18.721	-7150.548	0.607	133865.409108	37671.979383	174-35-54	89-56-58	18.696
D4-21	62043.956	-18.505	-7148.788	2.913	132288.321940	180734.043828	84-38-56	90-03-02	1.158
D4-22	62044.064	18.721	-7147.635	-0.607	-133810.874835	-37660.746848	354-35-54	89-56-58	18.696
D4-44	62062.677	18.505	-7149.395	-2.913	-132299.554475	-180788.578101	264-38-56	90-03-02	1.158
合計				倍面積	43.301738	-43.301738			39.708
				面 積	21.6508690	21.6508690			
				坪 数	6.54	6.54			

面積（座標法）計算書

地番： 4D-19

測点名	[1] X(i)	[2] X(i+1)-X(i-1)	[3] Y(i)	[4] Y(i+1)-Y(i-1)	[2]*[3]	[1]*[4]	方向角	夾角	距離
D4-39	62060.497	-20.148	-7172.606	-20.345	144513.665688	-1262620.811465	174-35-11	89-57-10	18.157
D4-20	62042.421	-18.559	-7170.893	2.313	133084.603187	143504.119773	128-50-03	134-14-52	0.770
D4-14	62041.938	1.535	-7170.293	22.105	-11006.399755	1371437.039490	84-38-21	135-48-18	21.599
D4-21	62043.956	20.631	-7148.788	19.745	-147486.645228	1225057.911220	354-35-54	89-57-33	18.696
D4-43	62062.569	16.541	-7150.548	-23.818	-118277.214468	-1478206.268442	264-38-01	90-02-07	22.155
合計				倍面積	828.009424	-828.009424			81.377
				面積	414.0047120	414.0047120			
				坪数	125.23	125.23			

面積（座標法）計算書

地番： 4D-S

測点名	[1] X(i)	[2] X(i+1)-X(i-1)	[3] Y(i)	[4] Y(i+1)-Y(i-1)	[2]*[3]	[1]*[4]	方向角	夾角	距離
D4-12	62086.945	-44.608	-7178.095	1.161	320200.461760	72082.943145	174-37-45	129-31-32	42.030
D4-13	62045.100	-44.524	-7174.161	7.202	319422.344364	446848.810200	129-20-38	134-42-53	4.226
D4-20	62042.421	15.397	-7170.893	1.555	-110410.239521	96475.964655	354-35-11	45-14-33	18.157
D4-39	62060.497	47.287	-7172.606	-4.429	-339171.019922	-274865.941213	354-41-17	180-06-06	29.337
D4-19	62089.708	26.448	-7175.322	-5.489	-189772.916256	-340810.407212	225-06-13	50-24-56	3.915
合計				倍面積	268.630425	-268.630425			97.665
				面積	134.3152125	134.3152125			
				坪数	40.63	40.63			

座 標 一 覽 表

測 点 名	X 座 標	Y 座 標
D4-11	62090.479	-7174.558
D4-12	62086.945	-7178.095
D4-13	62045.100	-7174.161
D4-14	62041.938	-7170.293
D4-15	62049.577	-7089.043
D4-16	62053.404	-7085.815
D4-17	62080.433	-7088.034
D4-18	62083.966	-7091.571
D4-19	62089.708	-7175.322
D4-20	62042.421	-7170.893
D4-21	62043.956	-7148.788
D4-22	62044.064	-7147.635
D4-23	62045.020	-7137.433
D4-24	62045.253	-7134.966
D4-25	62046.669	-7119.877
D4-26	62048.984	-7095.230
D4-27	62049.203	-7092.948
D4-28	62049.246	-7092.499
D4-29	62063.819	-7086.660
D4-30	62084.295	-7095.809
D4-31	62084.318	-7096.109
D4-32	62084.511	-7098.583
D4-33	62085.606	-7112.604
D4-34	62085.679	-7113.584
D4-35	62087.534	-7137.152
D4-39	62060.497	-7172.606
D4-43	62062.569	-7150.548
D4-44	62062.677	-7149.395
D4-45	62063.636	-7139.193
D4-46	62059.963	-7138.838
D4-47	62060.193	-7136.371
D4-48	62060.355	-7134.624
D4-49	62061.599	-7121.252
D4-50	62062.533	-7111.416
D4-51	62062.619	-7110.451
D4-52	62063.908	-7096.654
D4-53	62062.889	-7096.553
D4-54	62063.104	-7094.271
D4-55	62063.117	-7094.124
D4-56	62063.145	-7093.828