
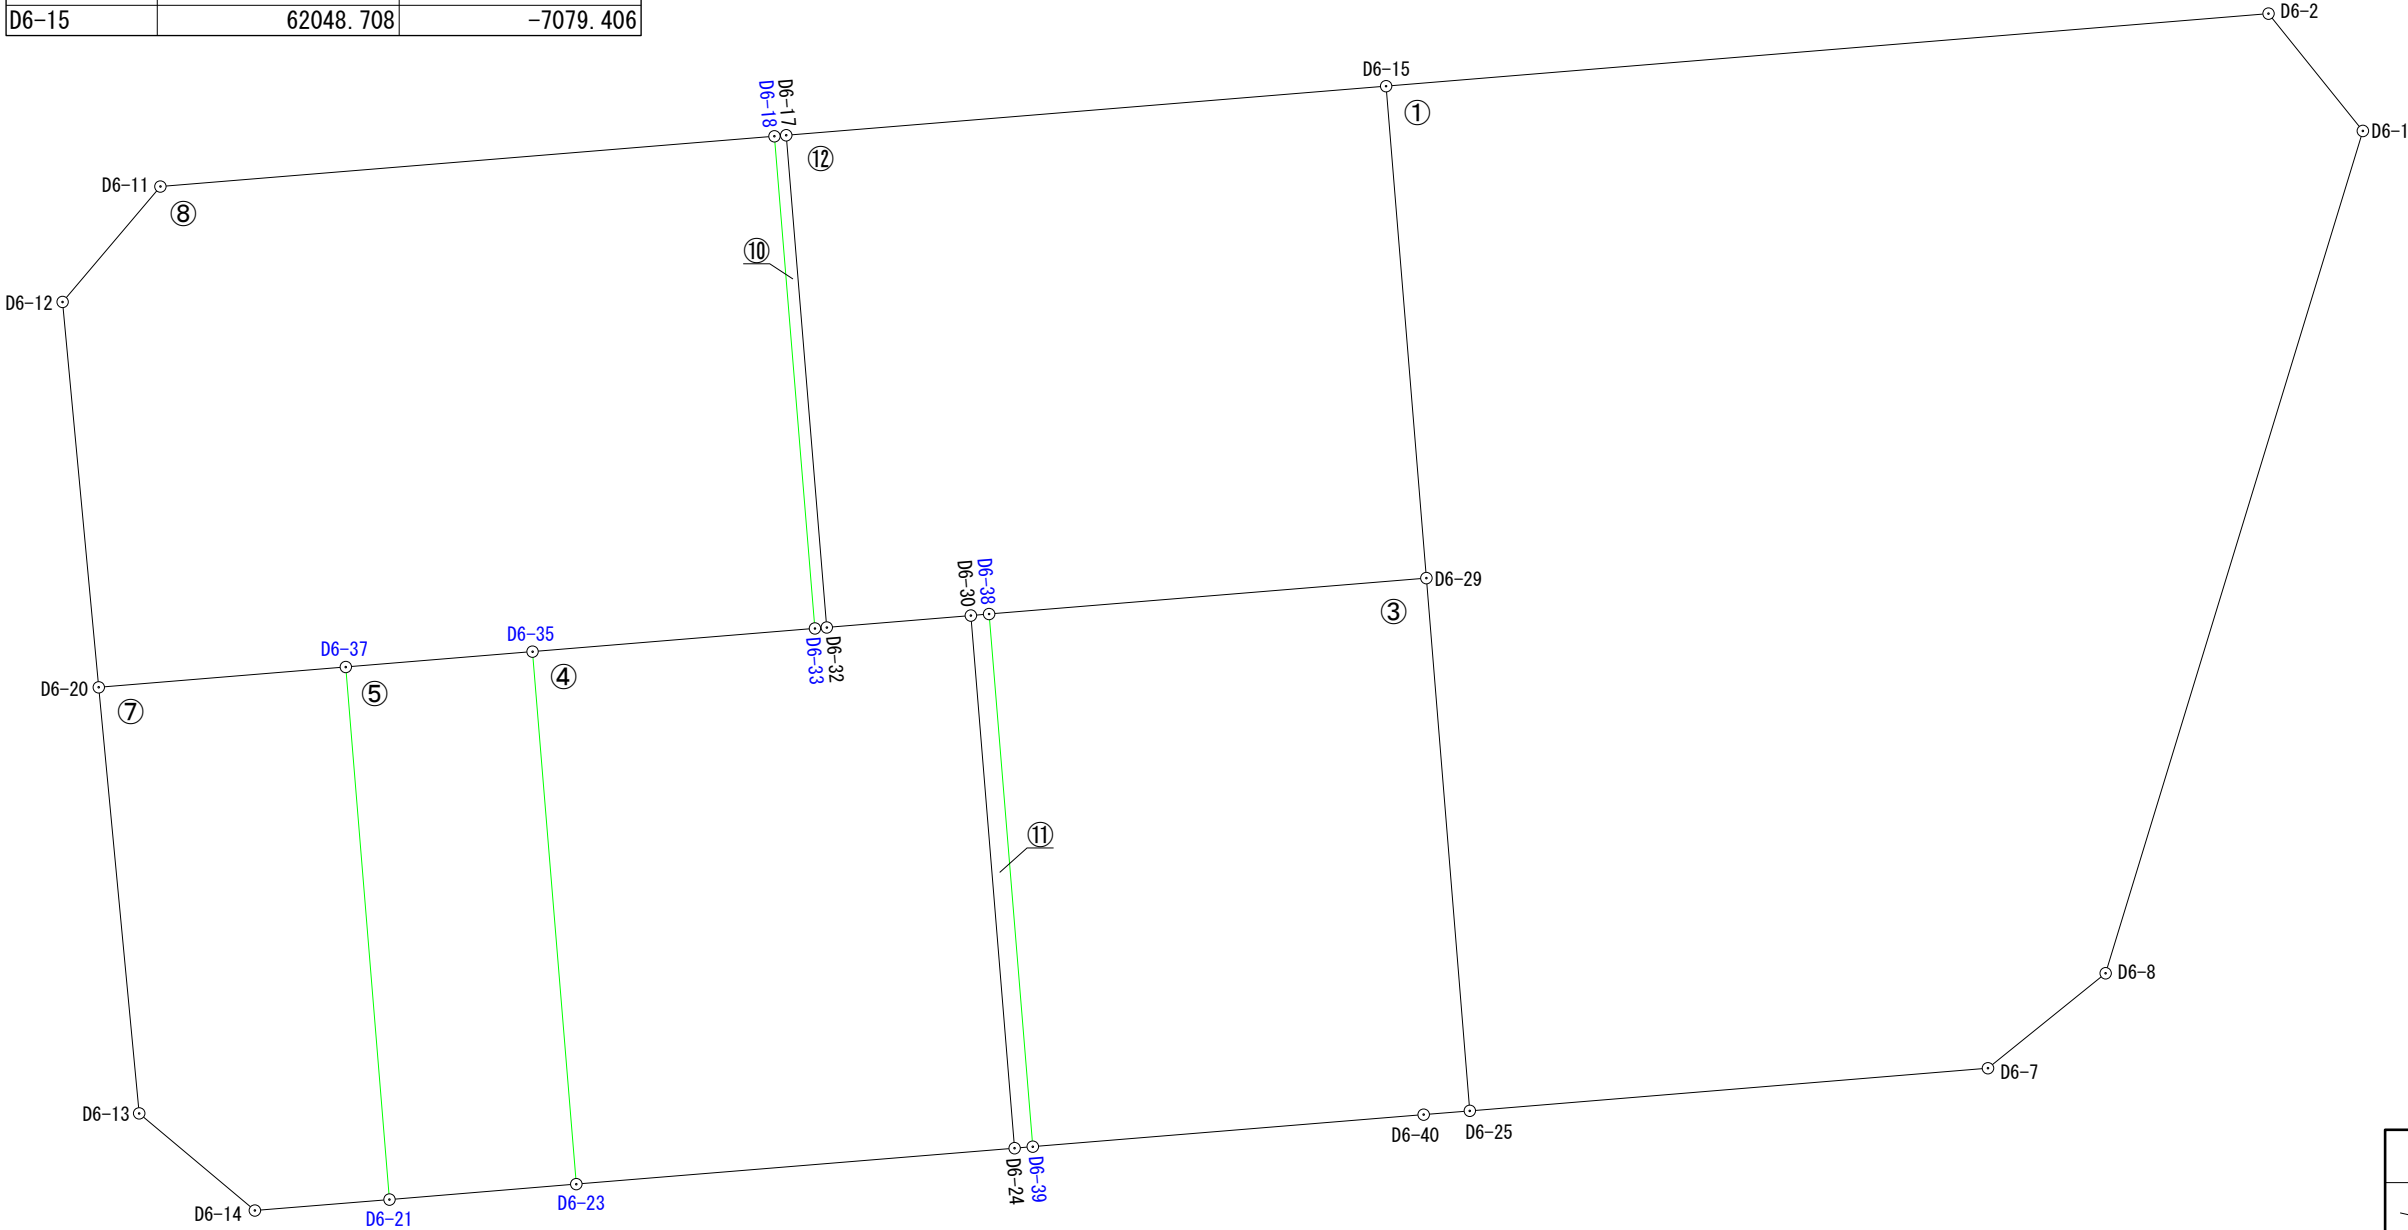


座 標 一 覧 表			
測 点 名	X	座 標	Y 座 標
D6-1		62081.014	-7077.926
D6-2		62077.893	-7081.806
D6-7		62068.616	-7046.935
D6-8		62072.505	-7050.076
D6-11		62008.171	-7076.088
D6-12		62004.935	-7072.270
D6-13		62007.468	-7045.440
D6-14		62011.294	-7042.231
D6-15		62048.708	-7079.406

出来形確認測量図（縮尺1：250）

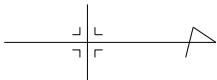

測 点 名	X	座 標	Y 座 標
D6-17		62028.869	-7077.782
D6-18		62028.477	-7077.750
D6-20		62006.132	-7059.531
D6-21		62015.746	-7042.593
D6-23		62021.926	-7043.102
D6-24		62036.421	-7044.290
D6-25		62051.477	-7045.527
D6-29		62050.042	-7063.141

測 点 名	X	座 標	Y 座 標
D6-30		62034.975	-7061.903
D6-32		62030.210	-7061.507
D6-33		62029.819	-7061.475
D6-35		62020.479	-7060.709
D6-37		62014.300	-7060.202
D6-38		62035.578	-7061.953
D6-39		62037.024	-7044.339
D6-40		62049.950	-7045.401

凡 例	
	施工地区界
	道 路
	街区番号
	画地番号
D14-1	計 算 点
D14-2	境界標あり

平成25年 3月22日測量
平成24年 1月19日測量
平成23年10月19日測量

面積（座標法）計算書

地番： 6D-1

測点名	[1] X(i)	[2] X(i+1)-X(i-1)	[3] Y(i)	[4] Y(i+1)-Y(i-1)	[2]*[3]	[1]*[4]	方向角	夾角	距離
D6-15	62048.708	-27.851	-7079.406	18.665	197168.536506	1158139.134820	85-18-41	90-00-45	16.320
D6-29	62050.042	2.769	-7063.141	33.879	-19557.837429	2102193.372918	85-20-33	180-01-52	17.672
D6-25	62051.477	18.574	-7045.527	16.206	-130863.618498	1005606.236262	355-18-13	89-57-40	17.197
D6-7	62068.616	21.028	-7046.935	-4.549	-148182.949180	-282350.134184	321-04-25	145-46-12	4.999
D6-8	62072.505	12.398	-7050.076	-30.991	-87406.842248	-1923689.002455	286-59-22	145-54-57	29.121
D6-1	62081.014	5.388	-7077.926	-31.730	-38135.865288	-1969830.574220	231-11-15	124-11-53	4.979
D6-2	62077.893	-32.306	-7081.806	-1.480	228784.824636	-91875.281640	175-17-56	124-06-41	29.284
合計				倍面積	1806.248499	-1806.248499			119.572
				面積	903.1242495	903.1242495			
				坪数	273.19	273.19			

面積（座標法）計算書

地番： 6D-3

測点名	[1] X(i)	[2] X(i+1)-X(i-1)	[3] Y(i)	[4] Y(i+1)-Y(i-1)	[2]*[3]	[1]*[4]	方向角	夾角	距離
D6-38	62035.578	-13.018	-7061.953	18.802	91932.504154	1166392.937556	85-18-25	90-00-09	17.673
D6-39	62037.024	14.372	-7044.339	16.552	-101241.240108	1026836.821248	355-18-11	89-59-46	12.970
D6-40	62049.950	14.453	-7045.401	-1.188	-101827.180653	-73715.340600	355-16-59	179-58-48	1.532
D6-25	62051.477	0.092	-7045.527	-17.740	-648.188484	-1100793.201980	265-20-33	90-03-34	17.672
D6-29	62050.042	-15.899	-7063.141	-16.426	112296.878759	-1019233.989892	175-18-16	89-57-43	14.513
合計				倍面積	512.773668	-512.773668			64.360
				面積	256.3868340	256.3868340			
				坪数	77.55	77.55			

面積（座標法）計算書

地番： 6D-4

測点名	[1] X(i)	[2] X(i+1)-X(i-1)	[3] Y(i)	[4] Y(i+1)-Y(i-1)	[2]*[3]	[1]*[4]	方向角	夾角	距離
D6-35	62020.479	-7.893	-7060.709	18.373	55730.176137	1139502.260667	85-18-07	89-59-26	17.666
D6-23	62021.926	15.942	-7043.102	16.419	-112281.132084	1018338.002994	355-18-52	90-00-45	14.544
D6-24	62036.421	13.049	-7044.290	-18.801	-91920.940210	-1166346.751221	265-18-24	89-59-32	17.672
D6-30	62034.975	-6.211	-7061.903	-17.217	43861.479533	-1068056.164575	175-14-57	89-56-33	4.781
D6-32	62030.210	-5.156	-7061.507	0.428	36409.130092	26548.929880	175-19-17	180-04-20	0.392
D6-33	62029.819	-9.731	-7061.475	0.798	68715.213225	49499.795562	175-18-41	179-59-24	9.371
合計				倍面積	513.926693	-513.926693			64.426
				面積	256.9633465	256.9633465			
				坪数	77.73	77.73			

面積（座標法）計算書

地番： 6D-5

測点名	[1] X(i)	[2] X(i+1)-X(i-1)	[3] Y(i)	[4] Y(i+1)-Y(i-1)	[2]*[3]	[1]*[4]	方向角	夾角	距離
D6-37	62014.300	-4.733	-7060.202	18.116	33415.936066	1123451.058800	85-18-20	89-59-47	17.668
D6-21	62015.746	7.626	-7042.593	17.100	-53706.814218	1060469.256600	355-17-30	89-59-10	6.201
D6-23	62021.926	4.733	-7043.102	-18.116	-33335.001766	-1123589.211416	265-18-07	90-00-37	17.666
D6-35	62020.479	-7.626	-7060.709	-17.100	53844.966834	-1060550.190900	175-18-33	90-00-26	6.200
合計				倍面積	219.086916	-219.086916			47.735
				面積	109.5434580	109.5434580			
				坪数	33.13	33.13			

面積（座標法）計算書

地番： 6D-7

測点名	[1] X(i)	[2] X(i+1)-X(i-1)	[3] Y(i)	[4] Y(i+1)-Y(i-1)	[2]*[3]	[1]*[4]	方向角	夾角	距離
D6-20	62006.132	-6.832	-7059.531	14.762	48230.715792	915334.520584	84-35-02	89-16-49	14.154
D6-13	62007.468	5.162	-7045.440	17.300	-36368.561280	1072729.196400	39-59-16	135-24-14	4.994
D6-14	62011.294	8.278	-7042.231	2.847	-58295.588218	176546.154018	355-21-05	135-21-49	4.467
D6-21	62015.746	3.006	-7042.593	-17.971	-21170.034558	-1114484.971366	265-18-20	89-57-15	17.668
D6-37	62014.300	-9.614	-7060.202	-16.938	67876.782028	-1050398.213400	175-18-13	89-59-53	8.196
合計				倍面積	273.313764	-273.313764			49.479
				面積	136.6568820	136.6568820			
				坪数	41.33	41.33			

面積（座標法）計算書

地番： 6D-8

測点名	[1] X(i)	[2] X(i+1)-X(i-1)	[3] Y(i)	[4] Y(i+1)-Y(i-1)	[2]*[3]	[1]*[4]	方向角	夾角	距離
D6-11	62008.171	-23.542	-7076.088	5.480	166585.263696	339804.777080	130-17-00	134-57-45	5.005
D6-12	62004.935	-2.039	-7072.270	16.557	14420.358530	1026615.708795	84-37-55	134-20-55	12.795
D6-20	62006.132	9.365	-7059.531	12.068	-66112.507815	748290.000976	355-18-13	90-40-18	8.196
D6-37	62014.300	14.347	-7060.202	-1.178	-101292.718094	-73052.845400	355-18-33	180-00-20	6.200
D6-35	62020.479	15.519	-7060.709	-1.273	-109575.142971	-78952.069767	355-18-41	180-00-08	9.371
D6-33	62029.819	7.998	-7061.475	-17.041	-56477.677050	-1057050.145579	265-17-10	89-58-29	16.330
D6-18	62028.477	-21.648	-7077.750	-14.613	153219.132000	-906422.134401	175-19-15	90-02-05	20.374
合計				倍面積	766.708296	-766.708296			78.271
				面積	383.3541480	383.3541480			
				坪数	115.96	115.96			

面積（座標法）計算書

地番： 6D-10

測点名	[1] X(i)	[2] X(i+1)-X(i-1)	[3] Y(i)	[4] Y(i+1)-Y(i-1)	[2]*[3]	[1]*[4]	方向角	夾角	距離
D6-18	62028.477	0.950	-7077.750	16.307	-6723.862500	1011498.374439	85-17-10	89-57-11	16.330
D6-33	62029.819	1.733	-7061.475	16.243	-12237.536175	1007550.350017	355-19-17	90-02-07	0.392
D6-32	62030.210	-0.950	-7061.507	-16.307	6708.431650	-1011526.634470	265-17-23	89-58-06	16.330
D6-17	62028.869	-1.733	-7077.782	-16.243	12265.796206	-1007534.919167	175-19-59	90-02-36	0.393
合計				倍面積	12.829181	-12.829181			33.445
				面積	6.4145905	6.4145905			
				坪数	1.94	1.94			

面積（座標法）計算書

地番： 6D-11

測点名	[1] X(i)	[2] X(i+1)-X(i-1)	[3] Y(i)	[4] Y(i+1)-Y(i-1)	[2]*[3]	[1]*[4]	方向角	夾角	距離
D6-30	62034.975	0.843	-7061.903	17.663	-5953.184229	1095723.763425	85-18-24	90-02-48	17.672
D6-24	62036.421	2.049	-7044.290	17.564	-14433.750210	1089607.698444	355-21-16	90-02-52	0.605
D6-39	62037.024	-0.843	-7044.339	-17.663	5938.377777	-1095759.954912	265-18-25	89-57-09	17.673
D6-38	62035.578	-2.049	-7061.953	-17.564	14469.941697	-1089592.891992	175-15-36	89-57-11	0.605
合計				倍面積	21.385035	-21.385035			36.555
				面積	10.6925175	10.6925175			
				坪数	3.23	3.23			

面積（座標法）計算書

地番： 6D-12

測点名	[1] X(i)	[2] X(i+1)-X(i-1)	[3] Y(i)	[4] Y(i+1)-Y(i-1)	[2]*[3]	[1]*[4]	方向角	夾角	距離
D6-17	62028.869	-18.498	-7077.782	17.899	130924.811436	1110254.726231	85-17-23	89-58-10	16.330
D6-32	62030.210	6.106	-7061.507	15.879	-43117.561742	984977.704590	355-14-57	89-57-34	4.781
D6-30	62034.975	5.368	-7061.903	-0.446	-37908.295304	-27667.598850	355-15-36	180-00-39	0.605
D6-38	62035.578	15.067	-7061.953	-1.238	-106402.445851	-76800.045564	355-18-16	180-02-40	14.513
D6-29	62050.042	13.130	-7063.141	-17.453	-92739.041330	-1082959.383026	265-18-41	90-00-25	16.320
D6-15	62048.708	-21.173	-7079.406	-14.641	149892.263238	-908455.133828	175-19-13	90-00-32	19.905
合計				倍面積	649.730447	-649.730447			72.454
				面積	324.8652235	324.8652235			
				坪数	98.27	98.27			