


出来形確認測量図（縮尺１：５００）

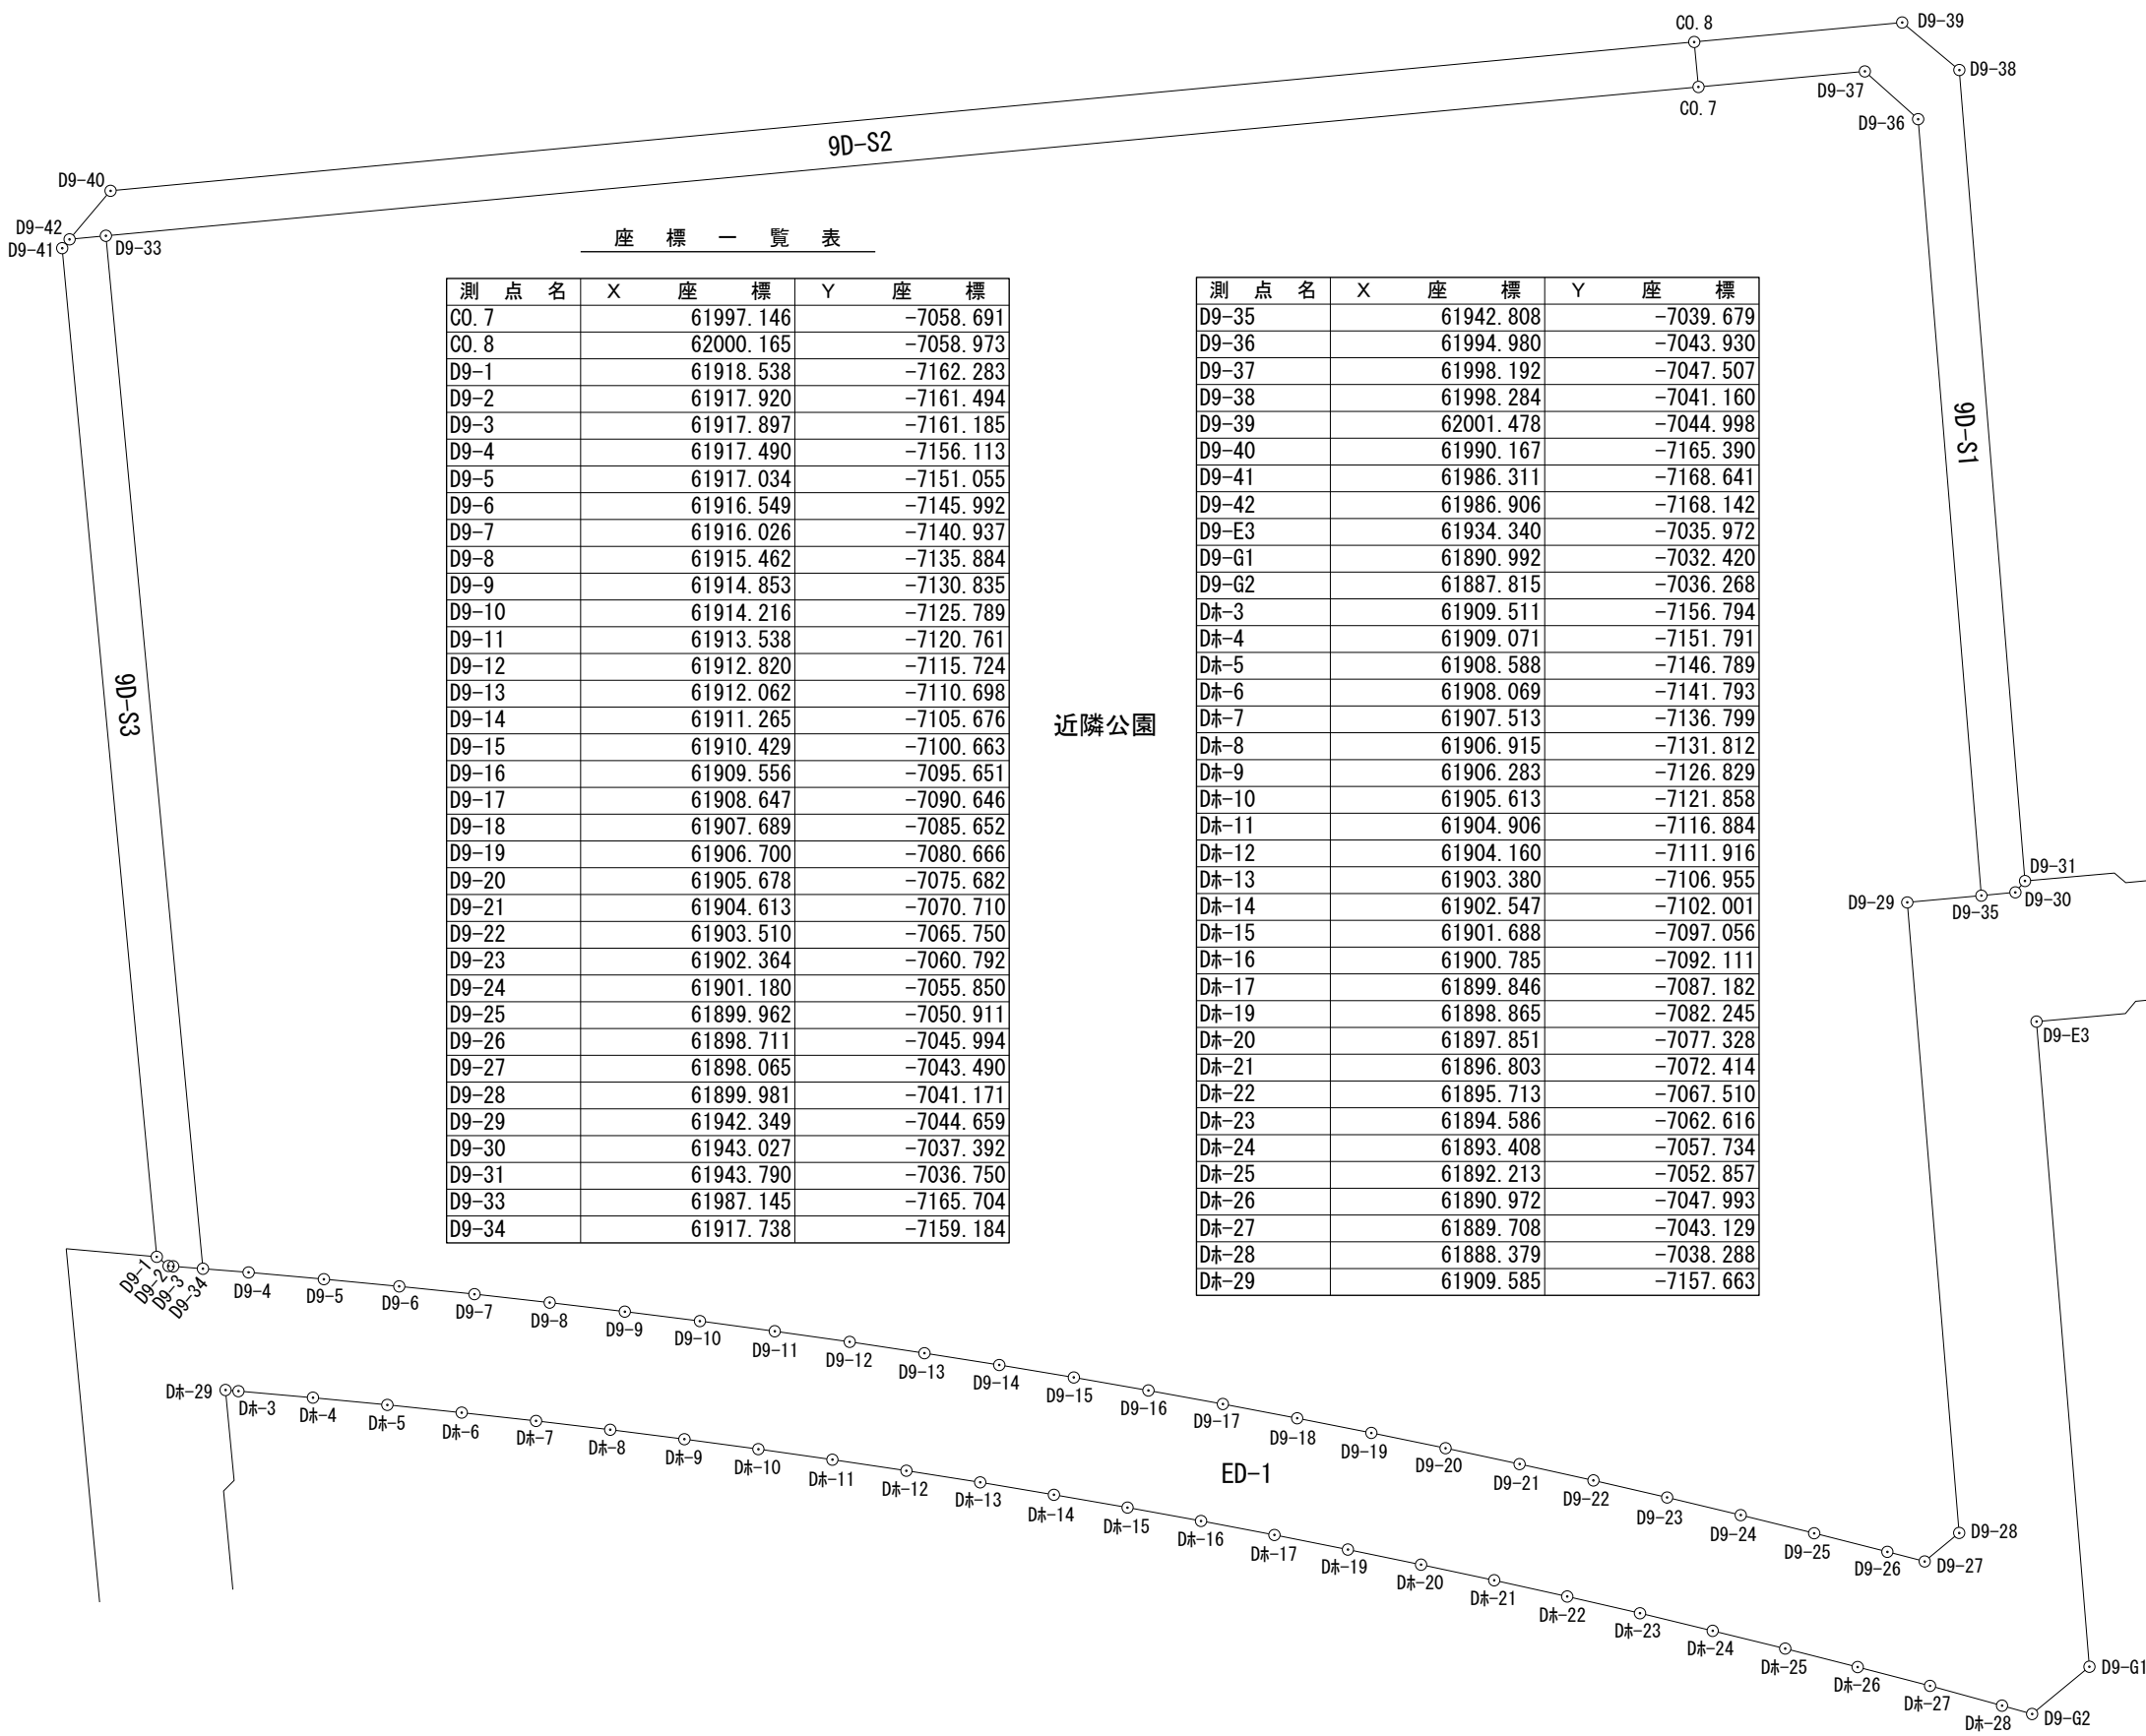

平成25年 3月11日測量
平成24年 9月27日測量
平成24年 9月25日測量
平成24年 9月24日測量
平成23年11月 8日測量
平成23年11月 2日測量
平成23年10月20日測量
平成23年10月18日測量

凡 例	
	施工地区界
	道 路
	街区番号
	画地番号
D14-1	計 算 点
D14-2	境界標あり

面積（座標法）計算書

地番： 9D-1

測点名	[1] X(i)	[2] X(i+1)-X(i-1)	[3] Y(i)	[4] Y(i+1)-Y(i-1)	[2]*[3]	[1]*[4]	方向角	夾角	距離
D9-33	61987.145	-79.408	-7165.704	-100.493	569014.223232	-6229274.162485	174-38-00	89-58-21	69.713
D9-34	61917.738	-69.655	-7159.184	9.591	498672.961520	593853.025158	94-37-01	99-59-01	3.081
D9-4	61917.490	-0.704	-7156.113	8.129	5037.903552	503327.276210	95-09-06	180-32-05	5.079
D9-5	61917.034	-0.941	-7151.055	10.121	6729.142755	626662.301114	95-28-19	180-19-13	5.086
D9-6	61916.549	-1.008	-7145.992	10.118	7203.159936	626471.642782	95-54-25	180-26-06	5.082
D9-7	61916.026	-1.087	-7140.937	10.108	7762.198519	625847.190808	96-22-08	180-27-43	5.084
D9-8	61915.462	-1.173	-7135.884	10.102	8370.391932	625469.997124	96-52-40	180-30-32	5.086
D9-9	61914.853	-1.246	-7130.835	10.095	8885.020410	625030.441035	97-11-42	180-19-02	5.086
D9-10	61914.216	-1.315	-7125.789	10.074	9370.412535	623723.811984	97-40-47	180-29-05	5.074
D9-11	61913.538	-1.396	-7120.761	10.065	9940.582356	623159.759970	98-06-45	180-25-58	5.088
D9-12	61912.820	-1.476	-7115.724	10.063	10502.808624	623028.707660	98-34-35	180-27-50	5.083
D9-13	61912.062	-1.555	-7110.698	10.048	11057.135390	622092.398976	99-01-04	180-26-29	5.085
D9-14	61911.265	-1.633	-7105.676	10.035	11603.568908	621279.544275	99-28-04	180-27-00	5.082
D9-15	61910.429	-1.709	-7100.663	10.025	12135.033067	620652.050725	99-52-51	180-24-47	5.087
D9-16	61909.556	-1.782	-7095.651	10.017	12644.450082	620148.022452	100-17-38	180-24-47	5.087
D9-17	61908.647	-1.867	-7090.646	9.999	13238.236082	619024.561353	100-51-33	180-33-55	5.085
D9-18	61907.689	-1.947	-7085.652	9.980	13795.764444	617838.736220	101-13-09	180-21-36	5.083
D9-19	61906.700	-2.011	-7080.666	9.970	14239.219326	617209.799000	101-35-18	180-22-09	5.088
D9-20	61905.678	-2.087	-7075.682	9.956	14766.948334	616332.930168	102-05-24	180-30-06	5.085
D9-21	61904.613	-2.168	-7070.710	9.932	15329.299280	614836.616316	102-32-15	180-26-51	5.081
D9-22	61903.510	-2.249	-7065.750	9.918	15890.871750	613959.012180	103-00-54	180-28-39	5.089
D9-23	61902.364	-2.330	-7060.792	9.900	16451.645360	612833.403600	103-28-23	180-27-29	5.082
D9-24	61901.180	-2.402	-7055.850	9.881	16948.151700	611645.559580	103-51-12	180-22-49	5.087
D9-25	61899.962	-2.469	-7050.911	9.856	17408.699259	610086.025472	104-16-28	180-25-16	5.074
D9-26	61898.711	-1.897	-7045.994	7.421	13366.250618	459350.334331	104-27-58	180-11-30	2.586
D9-27	61898.065	1.270	-7043.490	4.823	-8945.232300	298534.367495	50-26-09	125-58-11	3.008
D9-28	61899.981	44.284	-7041.171	-1.169	-311811.216564	-72361.077789	355-17-37	124-51-28	42.511
D9-29	61942.349	42.827	-7044.659	1.492	-301701.610993	92417.984708	84-44-02	269-26-25	5.001
D9-35	61942.808	52.631	-7039.679	0.729	-370505.345449	45156.307032	355-20-30	90-36-28	52.345
D9-36	61994.980	55.384	-7043.930	-7.828	-390121.019120	-485296.703440	311-55-21	136-34-51	4.807
D9-37	61998.192	2.166	-7047.507	-14.761	-15264.900162	-915155.312112	264-39-25	132-44-04	11.233

面積（座標法）計算書

地番： 9D-1

測点名	[1] X(i)	[2] X(i+1)-X(i-1)	[3] Y(i)	[4] Y(i+1)-Y(i-1)	[2]*[3]	[1]*[4]	方向角	夾角	距離
C0.7	61997.146	-11.047	-7058.691	-118.197	77977.359477	-7327876.665762	264-39-39	180-00-14	107.479
合計				倍面積	19992.113860	-19992.113860			413.607
				面積	9996.0569300	9996.0569300			
				坪数	3023.80	3023.80			

面積（座標法）計算書

地番： 9D-S1

測点名	[1] X(i)	[2] X(i+1)-X(i-1)	[3] Y(i)	[4] Y(i+1)-Y(i-1)	[2]*[3]	[1]*[4]	方向角	夾角	距離
C0.8	62000.165	-4.332	-7058.973	-13.693	30579.471036	-848968.259345	174-39-49	90-01-52	3.032
C0.7	61997.146	-1.973	-7058.691	11.466	13926.797343	710859.276036	84-39-25	89-59-36	11.233
D9-37	61998.192	-2.166	-7047.507	14.761	15264.900162	915155.312112	131-55-21	227-15-56	4.807
D9-36	61994.980	-55.384	-7043.930	7.828	390121.019120	485296.703440	175-20-30	223-25-09	52.345
D9-35	61942.808	-51.953	-7039.679	6.538	365732.443087	404982.078704	84-31-48	89-11-18	2.297
D9-30	61943.027	0.982	-7037.392	2.929	-6910.718944	181431.126083	40-04-40	135-32-52	0.997
D9-31	61943.790	55.257	-7036.750	-3.768	-388829.694750	-233404.200720	355-22-24	135-17-44	54.672
D9-38	61998.284	57.688	-7041.160	-8.248	-406190.438080	-511361.846432	309-46-03	134-23-39	4.993
D9-39	62001.478	1.881	-7044.998	-17.813	-13251.641238	-1104432.327614	264-37-57	134-51-54	14.037
合計				倍面積	442.137736	-442.137736			148.413
				面積	221.0688680	221.0688680			
				坪数	66.87	66.87			

面積（座標法）計算書

地 番： 9D-S2

測点名	[1] X(i)	[2] X(i+1)-X(i-1)	[3] Y(i)	[4] Y(i+1)-Y(i-1)	[2]*[3]	[1]*[4]	方向角	夾 角	距 離
D9-40	61990.167	-13.259	-7165.390	-109.169	95005.906010	-6767404.541223	220-09-41	135-31-43	4.267
D9-42	61986.906	-3.022	-7168.142	-0.314	21662.125124	-19463.888484	84-24-04	44-14-23	2.450
D9-33	61987.145	10.240	-7165.704	109.451	-73376.808960	6784555.007395	84-39-39	180-15-35	107.479
C0.7	61997.146	13.020	-7058.691	106.731	-91904.156820	6617017.389726	354-39-49	90-00-10	3.032
C0.8	62000.165	-6.979	-7058.973	-106.699	49264.572567	-6615355.605335	264-37-58	89-58-09	106.886
合計				倍面積	651.637921	-651.637921			224.114
				面 積	325.8189605	325.8189605			
				坪 数	98.56	98.56			

面積（座標法）計算書

地 番： 9D-S3

測点名	[1] X(i)	[2] X(i+1)-X(i-1)	[3] Y(i)	[4] Y(i+1)-Y(i-1)	[2]*[3]	[1]*[4]	方向角	夾 角	距 離
D9-33	61987.145	69.168	-7165.704	-8.958	-495637.414272	-555280.844910	264-24-04	89-46-04	2.450
D9-42	61986.906	-0.834	-7168.142	-2.937	5978.230428	-182055.542922	219-59-06	135-35-02	0.777
D9-41	61986.311	-68.368	-7168.641	5.859	490105.647888	363177.796149	174-38-26	134-39-20	68.071
D9-1	61918.538	-68.391	-7162.283	7.147	489835.696653	442531.791086	128-04-14	133-25-48	1.002
D9-2	61917.920	-0.641	-7161.494	1.098	4590.517654	67985.876160	94-15-25	146-11-11	0.310
D9-3	61917.897	-0.182	-7161.185	2.310	1303.335670	143030.342070	94-32-35	180-17-10	2.007
D9-34	61917.738	69.248	-7159.184	-4.519	-495759.173632	-279806.258022	354-38-00	80-05-25	69.713
合計				倍面積	416.840389	-416.840389			144.330
				面 積	208.4201945	208.4201945			
				坪 数	63.04	63.04			