


出来形確認測量図（縮尺１：５００）

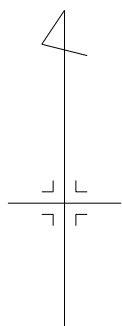


座 標 一 覧 表

測 点 名	X	座 標	Y	座 標
D10-1		61961.840	-7028.647	
D10-2		61958.009	-7031.841	
D10-4		61946.773	-6997.019	
D10-5		61947.518	-6996.375	
D10-6		61961.215	-6997.496	
D10-7		61964.415	-7001.357	
D10-8		61944.321	-7030.737	
D10-9		61943.669	-7029.980	
D10-10		61963.133	-7014.954	
D10-11		61945.225	-7013.485	

座 標 一 覧 表

測 点 名	X	座 標	Y	座 標
D11-2		61887.876	-7026.146	
D11-3		61883.971	-7023.002	
D11-4		61882.752	-7018.997	
D11-5		61881.266	-7014.197	
D11-6		61879.721	-7009.415	
D11-7		61878.156	-7004.645	
D11-8		61876.537	-6999.888	
D11-9		61875.276	-6996.209	
D11-10		61878.277	-6992.206	
D11-11		61884.513	-6992.707	
D11-12		61909.520	-6993.260	
D11-13		61938.130	-6995.600	
D11-14		61938.807	-6996.316	
D11-15		61935.703	-7029.310	
D11-16		61934.876	-7029.994	
D11-17		61920.861	-7028.839	
D11-18		61906.970	-7027.705	
D11-19		61909.796	-6993.282	
D11-20		61924.094	-6994.461	
D11-21		61922.483	-7011.569	
D11-22		61937.247	-7012.933	
D11-23		61878.073	-7004.400	
D11-24		61883.591	-7002.495	
D11-25		61880.082	-6992.351	

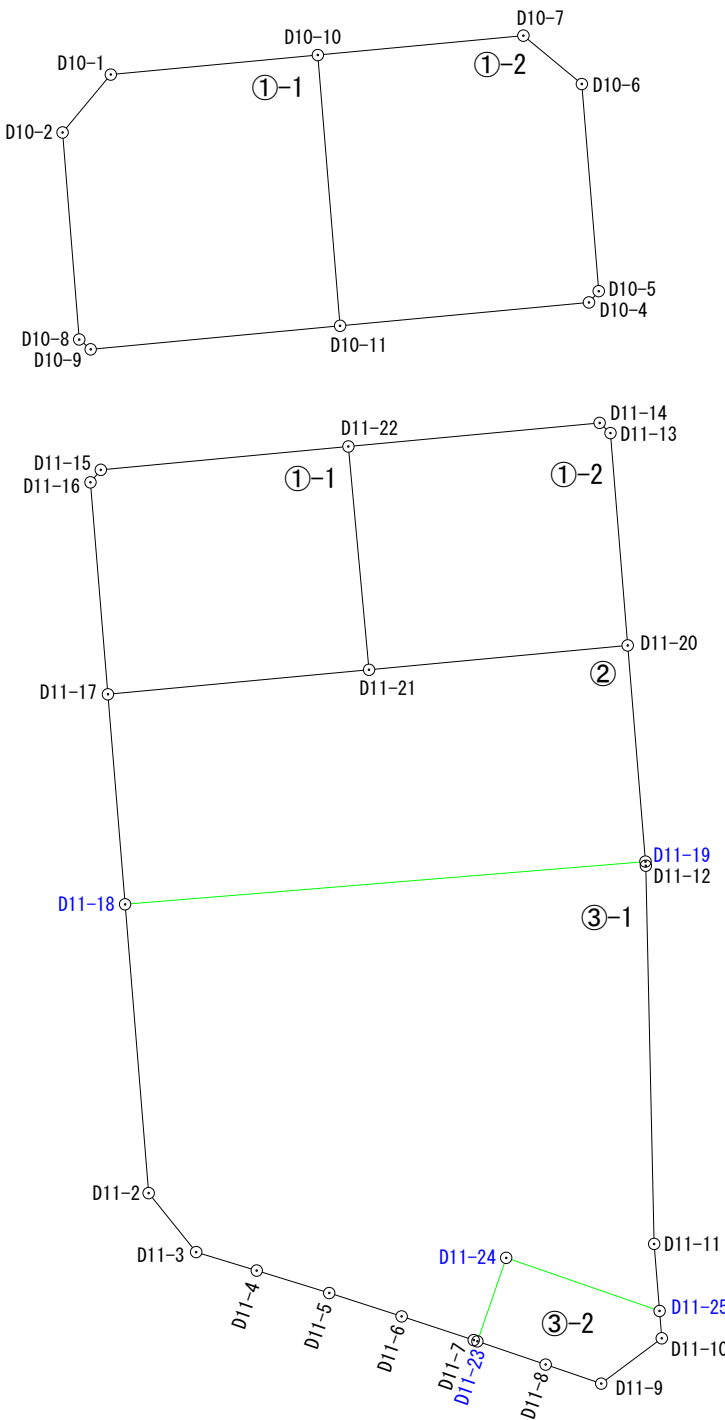

凡 例	
	施工地区界
	道 路
	街区番号
	画地番号
D14-1	計 算 点
D14-2	境界標あり

平成24年 9月27日測量
平成24年 1月19日測量
平成23年11月 8日測量
平成23年10月19日測量
平成23年10月18日測量

面積（座標法）計算書

地番：10D-1-1

測点名	[1] X(i)	[2] X(i+1)-X(i-1)	[3] Y(i)	[4] Y(i+1)-Y(i-1)	[2]*[3]	[1]*[4]	方向角	夾角	距離
D10-1	61961.840	-5.124	-7028.647	-16.887	36014.787228	-1046349.592080	219-49-08	135-12-48	4.988
D10-2	61958.009	-17.519	-7031.841	-2.090	123190.822479	-129492.238810	175-23-20	135-34-12	13.732
D10-8	61944.321	-14.340	-7030.737	1.861	100820.768580	115278.381381	130-44-17	135-20-57	0.999
D10-9	61943.669	0.904	-7029.980	17.252	-6355.101920	1068652.177588	84-36-40	133-52-23	16.568
D10-11	61945.225	19.464	-7013.485	15.026	-136510.472040	930788.950850	355-18-38	90-41-58	17.968
D10-10	61963.133	16.615	-7014.954	-15.162	-116553.460710	-939485.022546	264-36-20	89-17-42	13.754
合計				倍面積	607.343617	-607.343617			68.009
				面積	303.6718085	303.6718085			
				坪数	91.86	91.86			

面積（座標法）計算書

地 番： 10D-1-2

測点名	[1] X(i)	[2] X(i+1)-X(i-1)	[3] Y(i)	[4] Y(i+1)-Y(i-1)	[2]*[3]	[1]*[4]	方向角	夾 角	距 離
D10-10	61963.133	-19.190	-7014.954	-12.128	134616.967260	-751488.877024	175-18-38	90-41-48	17.968
D10-11	61945.225	-16.360	-7013.485	17.935	114740.614600	1110987.610375	84-37-45	89-19-07	16.539
D10-4	61946.773	2.293	-6997.019	17.110	-16044.164567	1059909.286030	40-50-28	136-12-43	0.985
D10-5	61947.518	14.442	-6996.375	-0.477	-101041.647750	-29548.966086	355-19-16	134-28-48	13.743
D10-6	61961.215	16.897	-6997.496	-4.982	-118236.689912	-308690.773130	309-39-07	134-19-51	5.015
D10-7	61964.415	1.918	-7001.357	-17.458	-13428.602726	-1081774.757070	264-36-50	134-57-43	13.657
合計				倍面積	606.476905	-606.476905			67.907
				面 積	303.2384525	303.2384525			
				坪 数	91.72	91.72			

面積（座標法）計算書

地番： 11D-1-1

測点名	[1] X(i)	[2] X(i+1)-X(i-1)	[3] Y(i)	[4] Y(i+1)-Y(i-1)	[2]*[3]	[1]*[4]	方向角	夾角	距離
D11-15	61935.703	-2.371	-7029.310	-17.061	16666.494010	-1056685.028883	219-35-37	134-58-46	1.073
D11-16	61934.876	-14.842	-7029.994	0.471	104339.170948	29171.326596	175-17-20	135-41-43	14.063
D11-17	61920.861	-12.393	-7028.839	18.425	87108.401727	1140891.863925	84-38-04	89-20-44	17.346
D11-21	61922.483	16.386	-7011.569	15.906	-114891.569634	984939.014598	354-43-18	90-05-14	14.827
D11-22	61937.247	13.220	-7012.933	-17.741	-92710.974260	-1098828.699027	264-36-51	89-53-33	16.450
合計				倍面積	511.522791	-511.522791			63.759
				面積	255.7613955	255.7613955			
				坪数	77.36	77.36			

面積（座標法）計算書

地番：11D-1-2

測点名	[1] X(i)	[2] X(i+1)-X(i-1)	[3] Y(i)	[4] Y(i+1)-Y(i-1)	[2]*[3]	[1]*[4]	方向角	夾角	距離
D11-22	61937.247	-16.324	-7012.933	-15.253	114479.118292	-944728.828491	174-43-18	90-05-06	14.827
D11-21	61922.483	-13.153	-7011.569	18.472	92223.167057	1143832.105976	84-37-14	89-53-56	17.184
D11-20	61924.094	15.647	-6994.461	15.969	-109442.331267	988865.857086	355-21-39	90-44-25	14.082
D11-13	61938.130	14.713	-6995.600	-1.855	-102926.262800	-114895.231150	313-23-47	138-02-08	0.985
D11-14	61938.807	-0.883	-6996.316	-17.333	6177.747028	-1073585.341731	264-38-12	131-14-25	16.690
合計				倍面積	511.438310	-511.438310			63.768
				面積	255.7191550	255.7191550			
				坪数	77.35	77.35			

面積（座標法）計算書

地番： 11D-2

測点名	[1] X(i)	[2] X(i+1)-X(i-1)	[3] Y(i)	[4] Y(i+1)-Y(i-1)	[2]*[3]	[1]*[4]	方向角	夾角	距離
D11-17	61920.861	-15.513	-7028.839	-16.136	109038.379407	-999155.013096	175-19-59	90-41-55	13.937
D11-18	61906.970	-11.065	-7027.705	35.557	77761.555825	2201226.132290	85-18-24	89-58-25	34.539
D11-19	61909.796	17.124	-6993.282	33.244	-119752.960968	2058129.258224	355-17-10	89-58-46	14.347
D11-20	61924.094	12.687	-6994.461	-18.287	-88738.726707	-1132405.906978	264-37-14	89-20-04	17.184
D11-21	61922.483	-3.233	-7011.569	-34.378	22668.402577	-2128771.120574	264-38-04	180-00-50	17.346
合計				倍面積	976.650134	-976.650134			97.353
				面積	488.3250670	488.3250670			
				坪数	147.71	147.71			

面積（座標法）計算書

地番：11D-3-1

測点名	[1] X(i)	[2] X(i+1)-X(i-1)	[3] Y(i)	[4] Y(i+1)-Y(i-1)	[2]*[3]	[1]*[4]	方向角	夾角	距離
D11-18	61906.970	-21.920	-7027.705	-32.864	154047.293600	-2034510.662080	175-19-56	90-01-32	19.158
D11-2	61887.876	-22.999	-7026.146	4.703	161594.331854	291058.680828	141-09-42	145-49-46	5.013
D11-3	61883.971	-5.124	-7023.002	7.149	35985.862248	442408.508679	106-55-43	145-46-01	4.186
D11-4	61882.752	-2.705	-7018.997	8.805	18986.386885	544877.631360	107-12-06	180-16-23	5.025
D11-5	61881.266	-3.031	-7014.197	9.582	21260.031107	592946.290812	107-54-18	180-42-12	5.025
D11-6	61879.721	-3.110	-7009.415	9.552	21799.280650	591075.094992	108-09-51	180-15-33	5.020
D11-7	61878.156	-1.648	-7004.645	5.015	11543.654960	310318.952340	108-42-54	180-33-03	0.259
D11-23	61878.073	5.435	-7004.400	2.150	-38068.914000	133037.856950	19-02-47	90-19-53	5.838
D11-24	61883.591	2.009	-7002.495	12.049	-14068.012455	745635.387959	109-04-53	270-02-06	10.734
D11-25	61880.082	0.922	-6992.351	9.788	-6446.947622	605682.242616	355-24-24	66-19-31	4.445
D11-11	61884.513	29.438	-6992.707	-0.909	-205851.308666	-56253.022317	358-43-59	183-19-35	25.013
D11-12	61909.520	25.283	-6993.260	-0.575	-176810.592580	-35597.974000	355-26-33	176-42-34	0.277
D11-19	61909.796	-2.550	-6993.282	-34.445	17832.869100	-2132482.923220	265-18-24	89-51-51	34.539
合計				倍面積	1803.935081	-1803.935081			124.532
				面積	901.9675405	901.9675405			
				坪数	272.84	272.84			

面積（座標法）計算書

地 番： 11D-3-2

測点名	[1] X(i)	[2] X(i+1)-X(i-1)	[3] Y(i)	[4] Y(i+1)-Y(i-1)	[2]*[3]	[1]*[4]	方向角	夾 角	距 離
D11-24	61883.591	-2.009	-7002.495	-12.049	14068.012455	-745635.387959	199-02-47	89-57-54	5.838
D11-23	61878.073	-7.054	-7004.400	2.607	49409.037600	161316.136311	108-48-00	89-45-13	4.766
D11-8	61876.537	-2.797	-6999.888	8.191	19578.686736	506830.714567	108-55-10	180-07-10	3.889
D11-9	61875.276	1.740	-6996.209	7.682	-12173.403660	475325.870232	53-08-30	124-13-20	5.003
D11-10	61878.277	4.806	-6992.206	3.858	-33604.542036	238726.392666	355-24-26	122-15-56	1.811
D11-25	61880.082	5.314	-6992.351	-10.289	-37157.353214	-636684.163698	289-04-53	113-40-27	10.734
合計				倍面積	120.437881	-120.437881			32.041
				面 積	60.2189405	60.2189405			
				坪 数	18.21	18.21			