
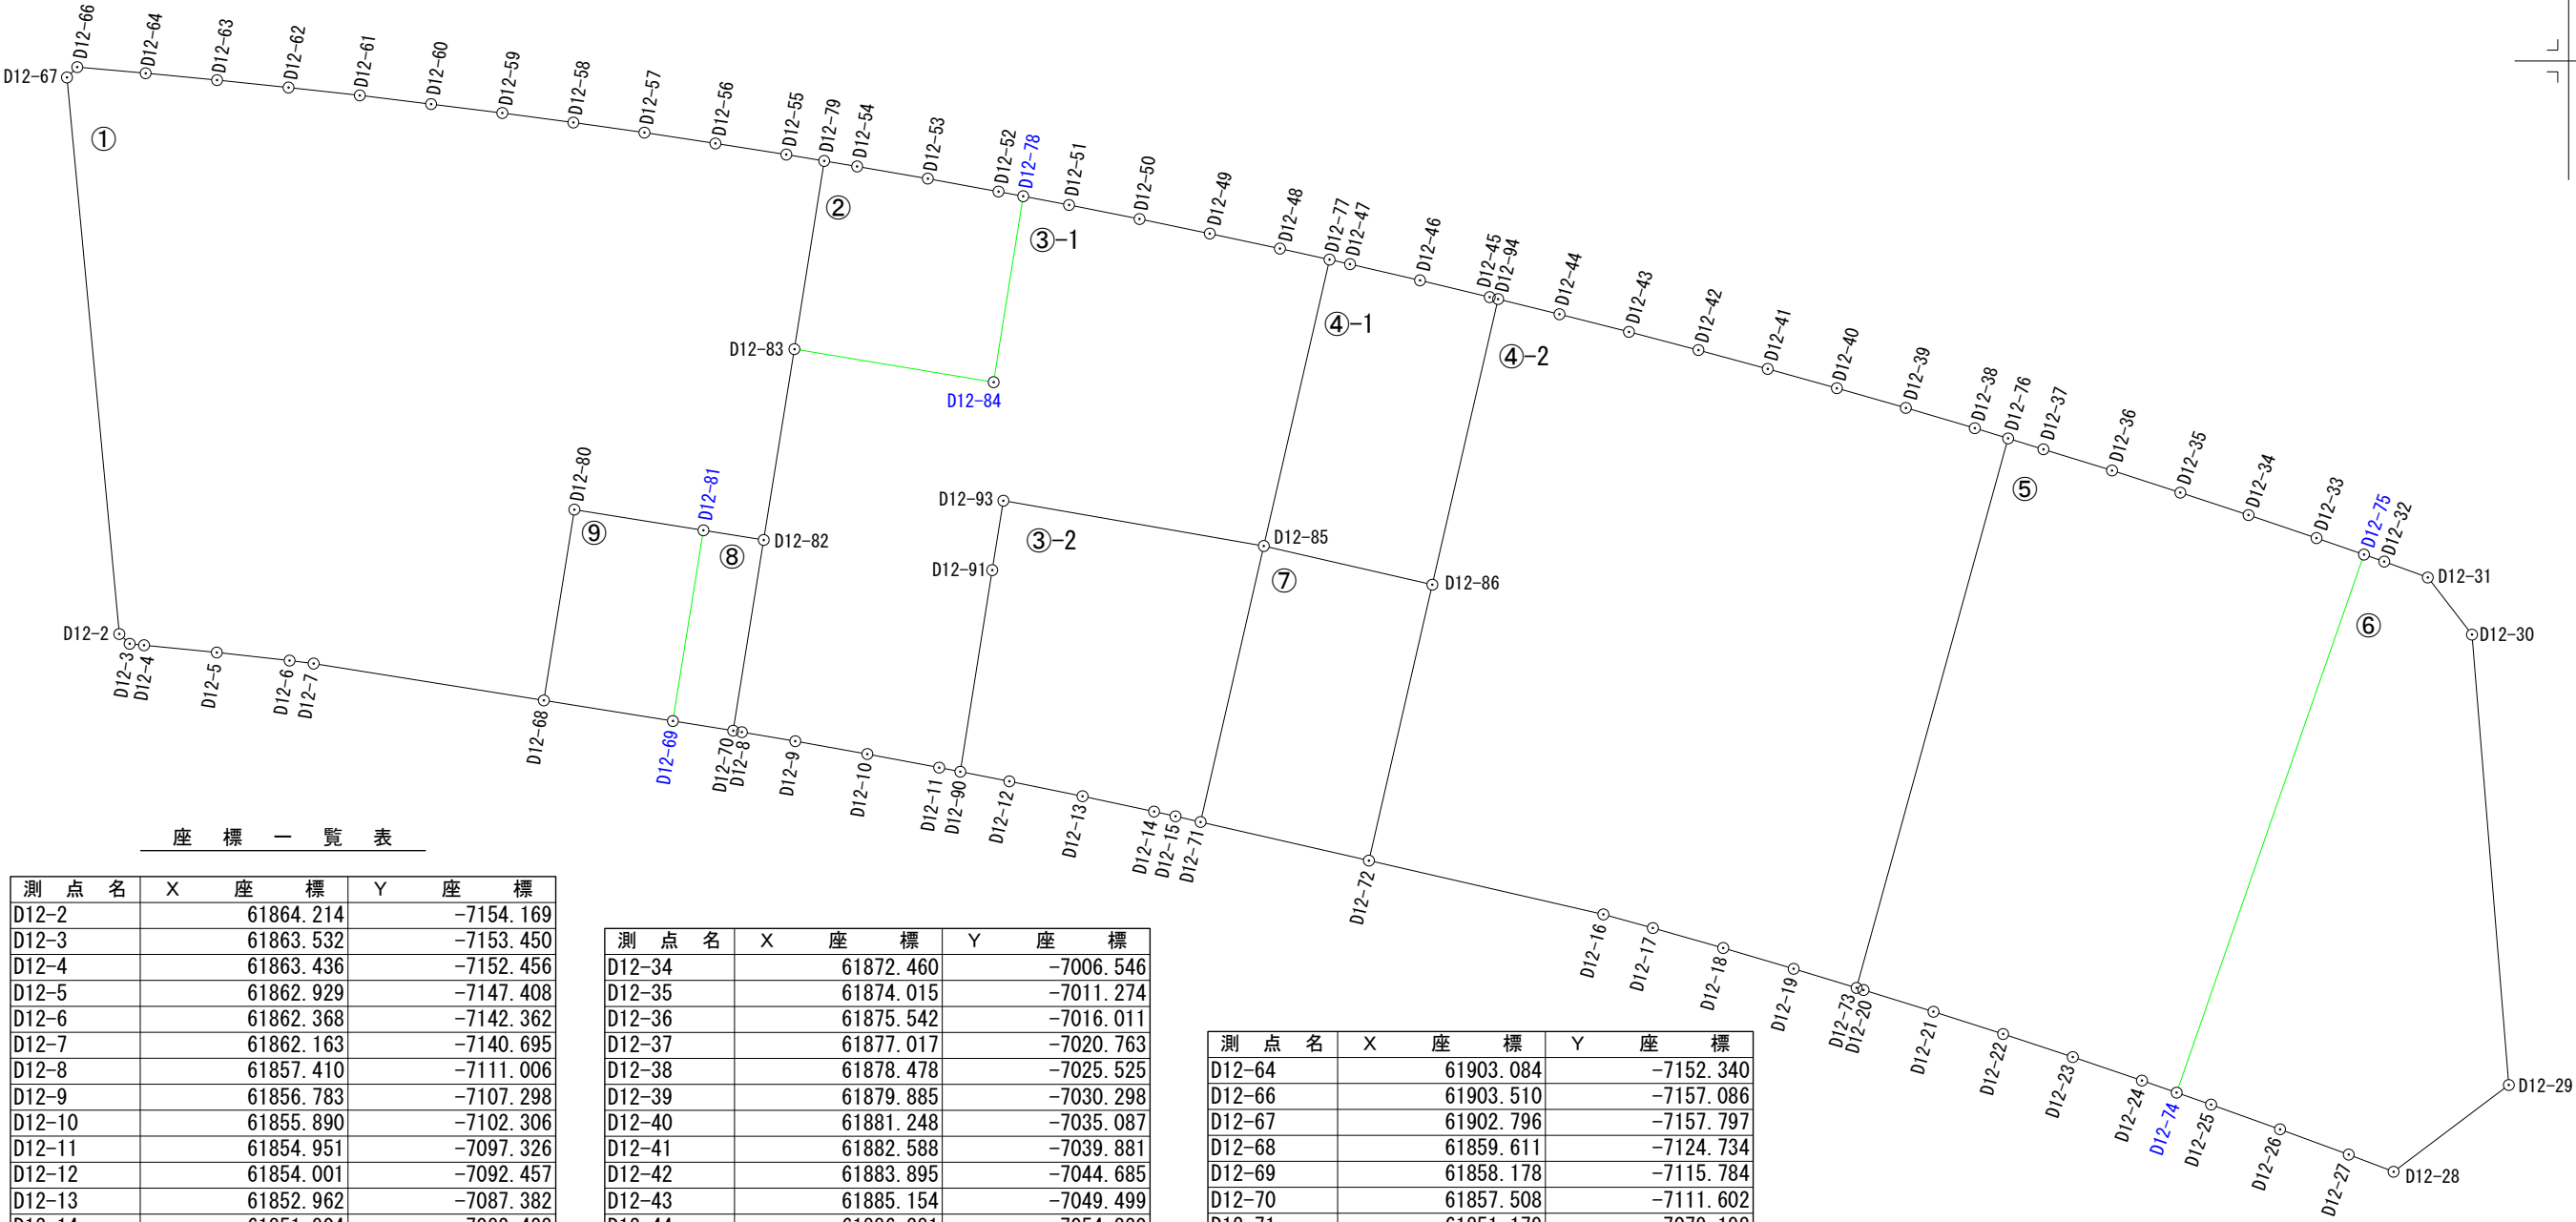


出来形確認測量図（縮尺1：500）

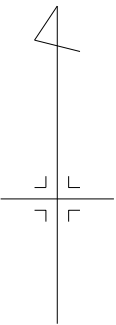

座 標 一 覧 表

測 点 名	X	座 標	Y	座 標
D12-2		61864.214		-7154.169
D12-3		61863.532		-7153.450
D12-4		61863.436		-7152.456
D12-5		61862.929		-7147.408
D12-6		61862.368		-7142.362
D12-7		61862.163		-7140.695
D12-8		61857.410		-7111.006
D12-9		61856.783		-7107.298
D12-10		61855.890		-7102.306
D12-11		61854.951		-7097.326
D12-12		61854.001		-7092.457
D12-13		61852.962		-7087.382
D12-14		61851.904		-7082.423
D12-15		61851.574		-7080.940
D12-16		61844.773		-7051.276
D12-17		61843.831		-7047.842
D12-18		61842.443		-7042.962
D12-19		61841.003		-7038.086
D12-20		61839.536		-7033.240
D12-21		61838.031		-7028.391
D12-22		61836.482		-7023.560
D12-23		61834.884		-7018.731
D12-24		61833.257		-7013.933
D12-25		61831.589		-7009.138
D12-26		61829.875		-7004.358
D12-27		61828.125		-6999.598
D12-28		61826.935		-6996.483
D12-29		61832.951		-6988.500
D12-30		61864.170		-6991.052
D12-31		61868.128		-6994.113
D12-32		61869.233		-6997.135
D12-33		61870.865		-7001.833

測 点 名	X	座 標	Y	座 標
D12-34		61872.460		-7006.546
D12-35		61874.015		-7011.274
D12-36		61875.542		-7016.011
D12-37		61877.017		-7020.763
D12-38		61878.478		-7025.525
D12-39		61879.885		-7030.298
D12-40		61881.248		-7035.087
D12-41		61882.588		-7039.881
D12-42		61883.895		-7044.685
D12-43		61885.154		-7049.499
D12-44		61886.381		-7054.320
D12-45		61887.564		-7059.152
D12-46		61888.729		-7063.990
D12-47		61889.851		-7068.837
D12-48		61890.928		-7073.697
D12-49		61891.969		-7078.565
D12-50		61892.980		-7083.436
D12-51		61893.954		-7088.319
D12-52		61894.880		-7093.211
D12-53		61895.778		-7098.108
D12-54		61896.622		-7103.013
D12-55		61897.449		-7107.923
D12-56		61898.218		-7112.837
D12-57		61898.969		-7117.759
D12-58		61899.668		-7122.686
D12-59		61900.331		-7127.615
D12-60		61900.945		-7132.551
D12-61		61901.552		-7137.492
D12-62		61902.096		-7142.436
D12-63		61902.612		-7147.388

測 点 名	X	座 標	Y	座 標
D12-64		61903.084		-7152.340
D12-66		61903.510		-7157.086
D12-67		61902.796		-7157.797
D12-68		61859.611		-7124.734
D12-69		61858.178		-7115.784
D12-70		61857.508		-7111.602
D12-71		61851.179		-7079.198
D12-72		61848.502		-7067.530
D12-73		61839.678		-7033.717
D12-74		61832.420		-7011.529
D12-75		61869.720		-6998.537
D12-76		61877.770		-7023.213
D12-77		61890.169		-7070.261
D12-78		61894.559		-7091.499
D12-79		61897.006		-7105.292
D12-80		61872.832		-7122.621
D12-81		61871.400		-7113.670
D12-82		61870.730		-7109.489
D12-83		61883.962		-7107.359
D12-84		61881.672		-7093.547
D12-85		61870.314		-7074.817
D12-86		61867.627		-7063.135
D12-90		61854.666		-7095.859
D12-91		61868.641		-7093.642
D12-93		61873.447		-7092.874
D12-94		61887.430		-7058.573

平成25年 5月15日測量
平成25年 2月25日測量
平成24年 9月28日測量
平成24年 9月27日測量
平成24年 1月26日測量
平成23年11月10日測量
平成23年11月 9日測量
平成23年11月 8日測量
平成23年11月 2日測量
平成23年11月 1日測量

凡 例	
	施工地区界
	道 路
	街区番号
	画地番号
D14-1	計 算 点
D14-2	境界標あり

面積（座標法）計算書

地 番： 12D-1

測点名	[1] X(i)	[2] X(i+1)-X(i-1)	[3] Y(i)	[4] Y(i+1)-Y(i-1)	[2]*[3]	[1]*[4]	方向角	夾 角	距 離
D12-2	61864.214	-39.264	-7154.169	4.347	280901.291616	268923.738258	133-29-14	138-51-33	0.991
D12-3	61863.532	-0.778	-7153.450	1.713	5565.384100	105972.230316	95-30-59	142-01-45	0.999
D12-4	61863.436	-0.603	-7152.456	6.042	4312.930968	373778.880312	95-44-07	180-13-08	5.073
D12-5	61862.929	-1.068	-7147.408	10.094	7633.431744	624444.405326	96-20-38	180-36-31	5.077
D12-6	61862.368	-0.766	-7142.362	6.713	5471.049292	415282.076384	97-00-39	180-40-01	1.680
D12-7	61862.163	-2.757	-7140.695	17.628	19686.896115	1090506.209364	99-05-03	182-04-24	16.164
D12-68	61859.611	10.669	-7124.734	18.074	-76013.787046	1118050.609214	9-04-49	89-59-46	13.389
D12-80	61872.832	11.789	-7122.621	11.064	-83968.578969	684561.013248	99-05-21	270-00-32	9.065
D12-81	61871.400	-2.102	-7113.670	13.132	14952.934340	812495.224800	99-06-15	180-00-54	4.234
D12-82	61870.730	12.562	-7109.489	6.311	-89309.400818	390466.177030	9-08-41	90-02-26	13.402
D12-83	61883.962	26.276	-7107.359	4.197	-186752.965084	259726.988514	9-00-16	179-51-35	13.207
D12-79	61897.006	13.487	-7105.292	-0.564	-95829.073204	-34909.911384	279-33-28	90-33-12	2.668
D12-55	61897.449	1.212	-7107.923	-7.545	-8614.802676	-467016.252705	278-53-39	179-20-11	4.974
D12-56	61898.218	1.520	-7112.837	-9.836	-10811.512240	-608830.872248	278-40-31	179-46-52	4.979
D12-57	61898.969	1.450	-7117.759	-9.849	-10320.750550	-609642.945681	278-04-29	179-23-58	4.976
D12-58	61899.668	1.362	-7122.686	-9.856	-9701.098332	-610083.127808	277-39-39	179-35-10	4.973
D12-59	61900.331	1.277	-7127.615	-9.865	-9101.964355	-610646.765315	277-05-27	179-25-48	4.974
D12-60	61900.945	1.221	-7132.551	-9.877	-8708.844771	-611395.633765	277-00-13	179-54-46	4.978
D12-61	61901.552	1.151	-7137.492	-9.885	-8215.253292	-611896.841520	276-16-45	179-16-32	4.974
D12-62	61902.096	1.060	-7142.436	-9.896	-7570.982160	-612583.142016	275-56-56	179-40-11	4.979
D12-63	61902.612	0.988	-7147.388	-9.904	-7061.619344	-613083.469248	275-26-41	179-29-45	4.974
D12-64	61903.084	0.898	-7152.340	-9.698	-6422.801320	-600336.108632	275-07-45	179-41-04	4.765
D12-66	61903.510	-0.288	-7157.086	-5.457	2061.240768	-337807.454070	224-52-46	129-45-01	1.008
D12-67	61902.796	-39.296	-7157.797	2.917	281272.790912	180570.455932	174-37-41	129-44-55	38.752
合計				倍面積	3454.515694	-3454.515694			175.255
				面 積	1727.2578470	1727.2578470			
				坪 数	522.49	522.49			

面積（座標法）計算書

地番：12D-2

測点名	[1] X(i)	[2] X(i+1)-X(i-1)	[3] Y(i)	[4] Y(i+1)-Y(i-1)	[2]*[3]	[1]*[4]	方向角	夾角	距離
D12-79	61897.006	-12.660	-7105.292	-4.346	89952.996720	-269004.388076	189-00-16	89-26-25	13.207
D12-83	61883.962	-15.334	-7107.359	11.745	108984.242906	726827.133690	99-24-50	90-24-34	14.001
D12-84	61881.672	10.597	-7093.547	15.860	-75170.317559	981443.317920	9-01-48	89-36-58	13.049
D12-78	61894.559	13.208	-7091.499	0.336	-93664.518792	20796.571824	280-37-11	91-35-23	1.742
D12-52	61894.880	1.219	-7093.211	-6.609	-8646.624209	-409063.261920	280-23-29	179-46-18	4.979
D12-53	61895.778	1.742	-7098.108	-9.802	-12364.904136	-606702.415956	279-45-48	179-22-19	4.977
D12-54	61896.622	1.228	-7103.013	-7.184	-8722.499964	-444665.332448	279-33-51	179-48-03	2.311
合計				倍面積	368.374966	-368.374966			54.266
				面積	184.1874830	184.1874830			
				坪数	55.71	55.71			

面積（座標法）計算書

地 番： 12D-3-1

測点名	[1] X(i)	[2] X(i+1)-X(i-1)	[3] Y(i)	[4] Y(i+1)-Y(i-1)	[2]*[3]	[1]*[4]	方向角	夾 角	距 離
D12-78	61894.559	-12.282	-7091.499	-5.228	87097.790718	-323584.754452	189-01-48	88-15-29	13.049
D12-84	61881.672	-10.597	-7093.547	-15.860	75170.317559	-981443.317920	279-24-50	270-23-02	14.001
D12-83	61883.962	-10.942	-7107.359	-15.942	77768.722178	-986554.122204	189-08-41	89-43-51	13.402
D12-82	61870.730	-26.454	-7109.489	-4.243	188074.422006	-262517.507390	189-04-47	179-56-06	13.390
D12-70	61857.508	-13.320	-7111.602	-1.517	94726.538640	-93837.839636	99-20-15	90-15-28	0.604
D12-8	61857.410	-0.725	-7111.006	4.304	5155.479350	266234.292640	99-35-51	180-15-36	3.761
D12-9	61856.783	-1.520	-7107.298	8.700	10803.092960	538154.012100	100-08-32	180-32-41	5.071
D12-10	61855.890	-1.832	-7102.306	9.972	13011.424592	616826.935080	100-40-41	180-32-09	5.068
D12-11	61854.951	-1.224	-7097.326	6.447	8687.127024	398778.869097	100-59-39	180-18-58	1.494
D12-90	61854.666	13.690	-7095.859	3.684	-97142.309710	227872.589544	9-00-52	88-01-13	14.150
D12-91	61868.641	18.781	-7093.642	2.985	-133225.690402	184677.893385	9-04-45	180-03-53	4.867
D12-93	61873.447	1.673	-7092.874	18.825	-11866.378202	1164767.639775	99-50-35	270-45-50	18.327
D12-85	61870.314	16.722	-7074.817	22.613	-118305.089874	1399073.410482	12-55-25	93-04-50	20.371
D12-77	61890.169	20.614	-7070.261	1.120	-145746.360254	69316.989280	282-27-23	89-31-58	3.519
D12-48	61890.928	1.800	-7073.697	-8.304	-12732.654600	-513942.266112	282-04-14	179-36-51	4.978
D12-49	61891.969	2.052	-7078.565	-9.739	-14525.215380	-602765.886091	281-43-32	179-39-18	4.975
D12-50	61892.980	1.985	-7083.436	-9.754	-14060.620460	-603704.126920	281-16-50	179-33-18	4.979
D12-51	61893.954	1.579	-7088.319	-8.063	-11192.455701	-499050.951102	280-46-19	179-29-29	3.237
合計				倍面積	1698.140444	-1698.140444			149.243
				面 積	849.0702220	849.0702220			
				坪 数	256.84	256.84			

面積（座標法）計算書

地番：12D-3-2

測点名	[1] X(i)	[2] X(i+1)-X(i-1)	[3] Y(i)	[4] Y(i+1)-Y(i-1)	[2]*[3]	[1]*[4]	方向角	夾角	距離
D12-93	61873.447	-1.673	-7092.874	-18.825	11866.378202	-1164767.639775	189-04-45	89-14-10	4.867
D12-91	61868.641	-18.781	-7093.642	-2.985	133225.690402	-184677.893385	189-00-52	179-56-07	14.150
D12-90	61854.666	-14.640	-7095.859	1.185	103883.375760	73297.779210	101-03-37	92-02-45	3.466
D12-12	61854.001	-1.704	-7092.457	8.477	12085.546728	524336.366477	101-34-13	180-30-36	5.180
D12-13	61852.962	-2.097	-7087.382	10.034	14862.240054	620632.620708	102-02-36	180-28-23	5.071
D12-14	61851.904	-1.388	-7082.423	6.442	9830.403124	398449.965568	102-32-43	180-30-07	1.519
D12-15	61851.574	-0.725	-7080.940	3.225	5133.681500	199471.326150	102-46-33	180-13-50	1.786
D12-71	61851.179	18.740	-7079.198	6.123	-132664.170520	378714.769017	12-53-45	90-07-12	19.630
D12-85	61870.314	22.268	-7074.817	-13.676	-157542.024956	-846138.414264	279-50-35	86-56-50	18.327
合計				倍面積	681.120294	-681.120294			73.996
				面積	340.5601470	340.5601470			
				坪数	103.01	103.01			

面積（座標法）計算書

地番：12D-4-1

測点名	[1] X(i)	[2] X(i+1)-X(i-1)	[3] Y(i)	[4] Y(i+1)-Y(i-1)	[2]*[3]	[1]*[4]	方向角	夾角	距離
D12-77	61890.169	-19.537	-7070.261	-5.980	138131.689157	-370103.210620	192-55-25	90-20-07	20.371
D12-85	61870.314	-22.542	-7074.817	7.126	159480.524814	440887.857564	102-57-12	90-01-47	11.987
D12-86	61867.627	17.116	-7063.135	16.244	-120892.618660	1004977.732988	12-58-22	90-01-10	20.322
D12-94	61887.430	19.937	-7058.573	3.983	-140726.769901	246497.633690	283-01-51	90-03-29	0.594
D12-45	61887.564	1.299	-7059.152	-5.417	-9169.838448	-335244.934188	283-32-21	180-30-30	4.976
D12-46	61888.729	2.287	-7063.990	-9.685	-16155.345130	-599392.340365	283-02-00	179-29-39	4.975
D12-47	61889.851	1.440	-7068.837	-6.271	-10179.125280	-388111.255621	282-35-18	179-33-18	1.459
合計				倍面積	488.516552	-488.516552			64.684
				面積	244.2582760	244.2582760			
				坪数	73.88	73.88			

面積（座標法）計算書

地番：12D-4-2

測点名	[1] X(i)	[2] X(i+1)-X(i-1)	[3] Y(i)	[4] Y(i+1)-Y(i-1)	[2]*[3]	[1]*[4]	方向角	夾角	距離
D12-94	61887.430	-18.754	-7058.573	-8.815	132376.478042	-545537.695450	192-58-22	89-07-02	20.322
D12-86	61867.627	-38.928	-7063.135	-8.957	274953.719280	-554148.335039	192-56-32	179-58-10	19.623
D12-72	61848.502	-22.854	-7067.530	11.859	161521.330620	733461.385218	102-55-16	89-58-44	16.676
D12-16	61844.773	-4.671	-7051.276	19.688	32936.510196	1217599.890824	105-20-23	182-25-07	3.561
D12-17	61843.831	-2.330	-7047.842	8.314	16421.471860	514169.610934	105-52-38	180-32-15	5.074
D12-18	61842.443	-2.828	-7042.962	9.756	19917.496536	603334.873908	106-27-11	180-34-33	5.084
D12-19	61841.003	-2.765	-7038.086	9.245	19460.307790	571720.072735	106-52-16	180-25-05	4.565
D12-73	61839.678	36.767	-7033.717	14.873	-258608.672939	919741.530894	15-24-59	88-32-43	39.514
D12-76	61877.770	38.800	-7023.213	8.192	-272500.664400	506902.691840	287-01-34	91-36-35	2.418
D12-38	61878.478	2.115	-7025.525	-7.085	-14858.985375	-438409.016630	286-25-29	179-23-55	4.976
D12-39	61879.885	2.770	-7030.298	-9.562	-19473.925460	-591695.460370	285-53-13	179-27-44	4.979
D12-40	61881.248	2.703	-7035.087	-9.583	-19015.840161	-593007.999584	285-37-00	179-43-47	4.978
D12-41	61882.588	2.647	-7039.881	-9.598	-18634.565007	-593949.079624	285-13-11	179-36-11	4.979
D12-42	61883.895	2.566	-7044.685	-9.618	-18076.661710	-595199.302110	284-39-22	179-26-11	4.976
D12-43	61885.154	2.486	-7049.499	-9.635	-17525.054514	-596263.458790	284-16-45	179-37-23	4.975
D12-44	61886.381	2.276	-7054.320	-9.074	-16055.632320	-561557.021194	283-51-20	179-34-35	4.380
合計				倍面積	2837.312438	-2837.312438			151.080
				面積	1418.6562190	1418.6562190			
				坪数	429.14	429.14			

面積（座標法）計算書

地 番： 12D-5

測点名	[1] X(i)	[2] X(i+1)-X(i-1)	[3] Y(i)	[4] Y(i+1)-Y(i-1)	[2]*[3]	[1]*[4]	方向角	夾 角	距 離
D12-76	61877.770	-37.339	-7023.213	-12.954	262239.750207	-801564.632580	195-24-59	88-19-54	39.514
D12-73	61839.678	-38.234	-7033.717	-10.027	268927.135778	-620066.451306	106-34-41	91-09-42	0.498
D12-20	61839.536	-1.647	-7033.240	5.326	11583.746280	329357.368736	107-14-35	180-39-54	5.077
D12-21	61838.031	-3.054	-7028.391	9.680	21464.706114	598592.140080	107-46-40	180-32-05	5.073
D12-22	61836.482	-3.147	-7023.560	9.660	22103.143320	597340.416120	108-18-37	180-31-57	5.087
D12-23	61834.884	-3.225	-7018.731	9.627	22635.407475	595284.428268	108-43-54	180-25-17	5.066
D12-24	61833.257	-2.464	-7013.933	7.202	17282.330912	445323.116914	109-11-48	180-27-54	2.546
D12-74	61832.420	36.463	-7011.529	15.396	-255661.381927	951971.938320	19-12-14	90-00-26	39.498
D12-75	61869.720	38.445	-6998.537	9.696	-269058.754965	599888.805120	289-09-24	89-57-10	3.489
D12-33	61870.865	2.740	-7001.833	-8.009	-19185.022420	-495523.757785	288-41-50	179-32-26	4.976
D12-34	61872.460	3.150	-7006.546	-9.441	-22070.619900	-584137.894860	288-12-20	179-30-30	4.977
D12-35	61874.015	3.082	-7011.274	-9.465	-21608.746468	-585637.551975	287-52-01	179-39-41	4.977
D12-36	61875.542	3.002	-7016.011	-9.489	-21062.065022	-587137.018038	287-14-39	179-22-38	4.976
D12-37	61877.017	2.228	-7020.763	-7.202	-15642.259964	-445638.276434	287-05-05	179-50-26	2.563
合計				倍面積	1947.369420	-1947.369420			128.317
				面 積	973.6847100	973.6847100			
				坪 数	294.53	294.53			

面積（座標法）計算書

地番：12D-6

測点名	[1] X(i)	[2] X(i+1)-X(i-1)	[3] Y(i)	[4] Y(i+1)-Y(i-1)	[2]*[3]	[1]*[4]	方向角	夾角	距離
D12-75	61869.720	-36.813	-6998.537	-14.394	257637.142581	-890552.749680	199-12-14	90-02-55	39.498
D12-74	61832.420	-38.131	-7011.529	-10.601	267356.612299	-655485.484420	109-09-54	89-57-40	2.531
D12-25	61831.589	-2.545	-7009.138	7.171	17838.256210	443394.324719	109-43-36	180-33-42	5.078
D12-26	61829.875	-3.464	-7004.358	9.540	24263.096112	589857.007500	110-11-09	180-27-33	5.071
D12-27	61828.125	-2.940	-6999.598	7.875	20578.818120	486896.484375	110-54-29	180-43-20	3.335
D12-28	61826.935	4.826	-6996.483	11.098	-33765.026958	686155.324630	52-59-54	122-05-25	9.996
D12-29	61832.951	37.235	-6988.500	5.431	-260216.797500	335814.756881	355-19-36	122-19-42	31.323
D12-30	61864.170	35.177	-6991.052	-5.613	-245924.236204	-347243.586210	322-16-58	146-57-22	5.004
D12-31	61868.128	5.063	-6994.113	-6.083	-35411.194119	-376343.822624	290-05-06	147-48-08	3.218
D12-32	61869.233	1.592	-6997.135	-4.424	-11139.438920	-273709.486792	289-09-19	179-04-13	1.484
合計				倍面積	1217.231621	-1217.231621			106.538
				面積	608.6158105	608.6158105			
				坪数	184.10	184.10			

面積（座標法）計算書

地番：12D-7

測点名	[1] X(i)	[2] X(i+1)-X(i-1)	[3] Y(i)	[4] Y(i+1)-Y(i-1)	[2]*[3]	[1]*[4]	方向角	夾角	距離
D12-85	61870.314	-16.448	-7074.817	-16.063	116366.590016	-993822.853782	192-53-45	89-56-33	19.630
D12-71	61851.179	-21.812	-7079.198	7.287	154411.466776	450709.541373	102-55-18	90-01-33	11.971
D12-72	61848.502	16.448	-7067.530	16.063	-116246.733440	993472.487626	12-56-32	90-01-14	19.623
D12-86	61867.627	21.812	-7063.135	-7.287	-154061.100620	-450829.397949	282-57-12	90-00-40	11.987
合計				倍面積	470.222732	-470.222732			63.211
				面積	235.1113660	235.1113660			
				坪数	71.12	71.12			

面積（座標法）計算書

地番：12D-8

測点名	[1] X(i)	[2] X(i+1)-X(i-1)	[3] Y(i)	[4] Y(i+1)-Y(i-1)	[2]*[3]	[1]*[4]	方向角	夾角	距離
D12-81	61871.400	-12.552	-7113.670	-6.295	89290.785840	-389480.463000	189-05-02	89-58-47	13.390
D12-69	61858.178	-13.892	-7115.784	2.068	98852.471328	127922.712104	99-06-07	90-01-05	4.235
D12-70	61857.508	12.552	-7111.602	6.295	-89264.828304	389393.012860	9-04-47	89-58-40	13.390
D12-82	61870.730	13.892	-7109.489	-2.068	-98765.021188	-127948.669640	279-06-15	90-01-28	4.234
合計				倍面積	113.407676	-113.407676			35.249
				面積	56.7038380	56.7038380			
				坪数	17.15	17.15			

面積（座標法）計算書

地番： 12D-9

測点名	[1] X(i)	[2] X(i+1)-X(i-1)	[3] Y(i)	[4] Y(i+1)-Y(i-1)	[2]*[3]	[1]*[4]	方向角	夾角	距離
D12-80	61872.832	-11.789	-7122.621	-11.064	83968.578969	-684561.013248	189-04-49	89-59-28	13.389
D12-68	61859.611	-14.654	-7124.734	6.837	104405.852036	422934.160407	99-05-47	90-00-58	9.064
D12-69	61858.178	11.789	-7115.784	11.064	-83887.977576	684398.881392	9-05-02	89-59-15	13.390
D12-81	61871.400	14.654	-7113.670	-6.837	-104243.720180	-423014.761800	279-05-21	90-00-19	9.065
合計				倍面積	242.733249	-242.733249			44.908
				面積	121.3666245	121.3666245			
				坪数	36.71	36.71			