



出来形確認測量図（縮尺1：500）

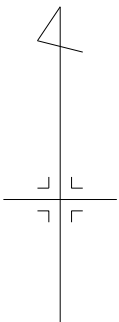

座 標 一 覧 表

測 点 名	X	座 標	Y	座 標
D13-1		62095.775		-6985.303
D13-2		62090.789		-6991.559
D13-3		62037.644		-6987.212
D13-4		62012.586		-6986.675
D13-5		61975.685		-6983.642
D13-6		61972.497		-6979.778
D13-7		61975.053		-6952.472
D13-8		61978.875		-6949.295
D13-9		62035.210		-6953.915
D13-10		62037.534		-6925.476
D13-11		62021.643		-6865.478
D13-12		62024.849		-6861.637
D13-13		62056.262		-6864.234
D13-14		62060.178		-6867.344
D13-15		62070.879		-6901.317
D13-16		62078.459		-6930.366
D13-17		62050.446		-6988.251
D13-18		62033.142		-6987.105
D13-20		62036.089		-6943.191
D13-21		62037.211		-6929.474
D13-22		62037.524		-6925.598
D13-23		62034.471		-6913.911
D13-25		62026.372		-6883.358
D13-26		62025.914		-6881.631
D13-27		62028.929		-6861.975
D13-28		62065.710		-6884.907
D13-29		62066.256		-6886.639
D13-32		62078.470		-6930.413
D13-33		62083.731		-6947.103
D13-34		62084.470		-6949.446
D13-35		62087.971		-6960.549
D13-38		62072.701		-6959.295
D13-39		62073.588		-6948.541
D13-40		62073.775		-6946.276
D13-41		62054.006		-6944.664
D13-43		62055.591		-6930.983
D13-44		62055.407		-6928.529
D13-45		62055.311		-6927.058
D13-47		62054.468		-6914.132
D13-48		62043.203		-6914.885
D13-49		62034.309		-6882.322
D13-50		62074.143		-6959.414
D13-51		62071.682		-6989.992
D13-52		62093.484		-6978.036
D13-53		62072.781		-6976.337

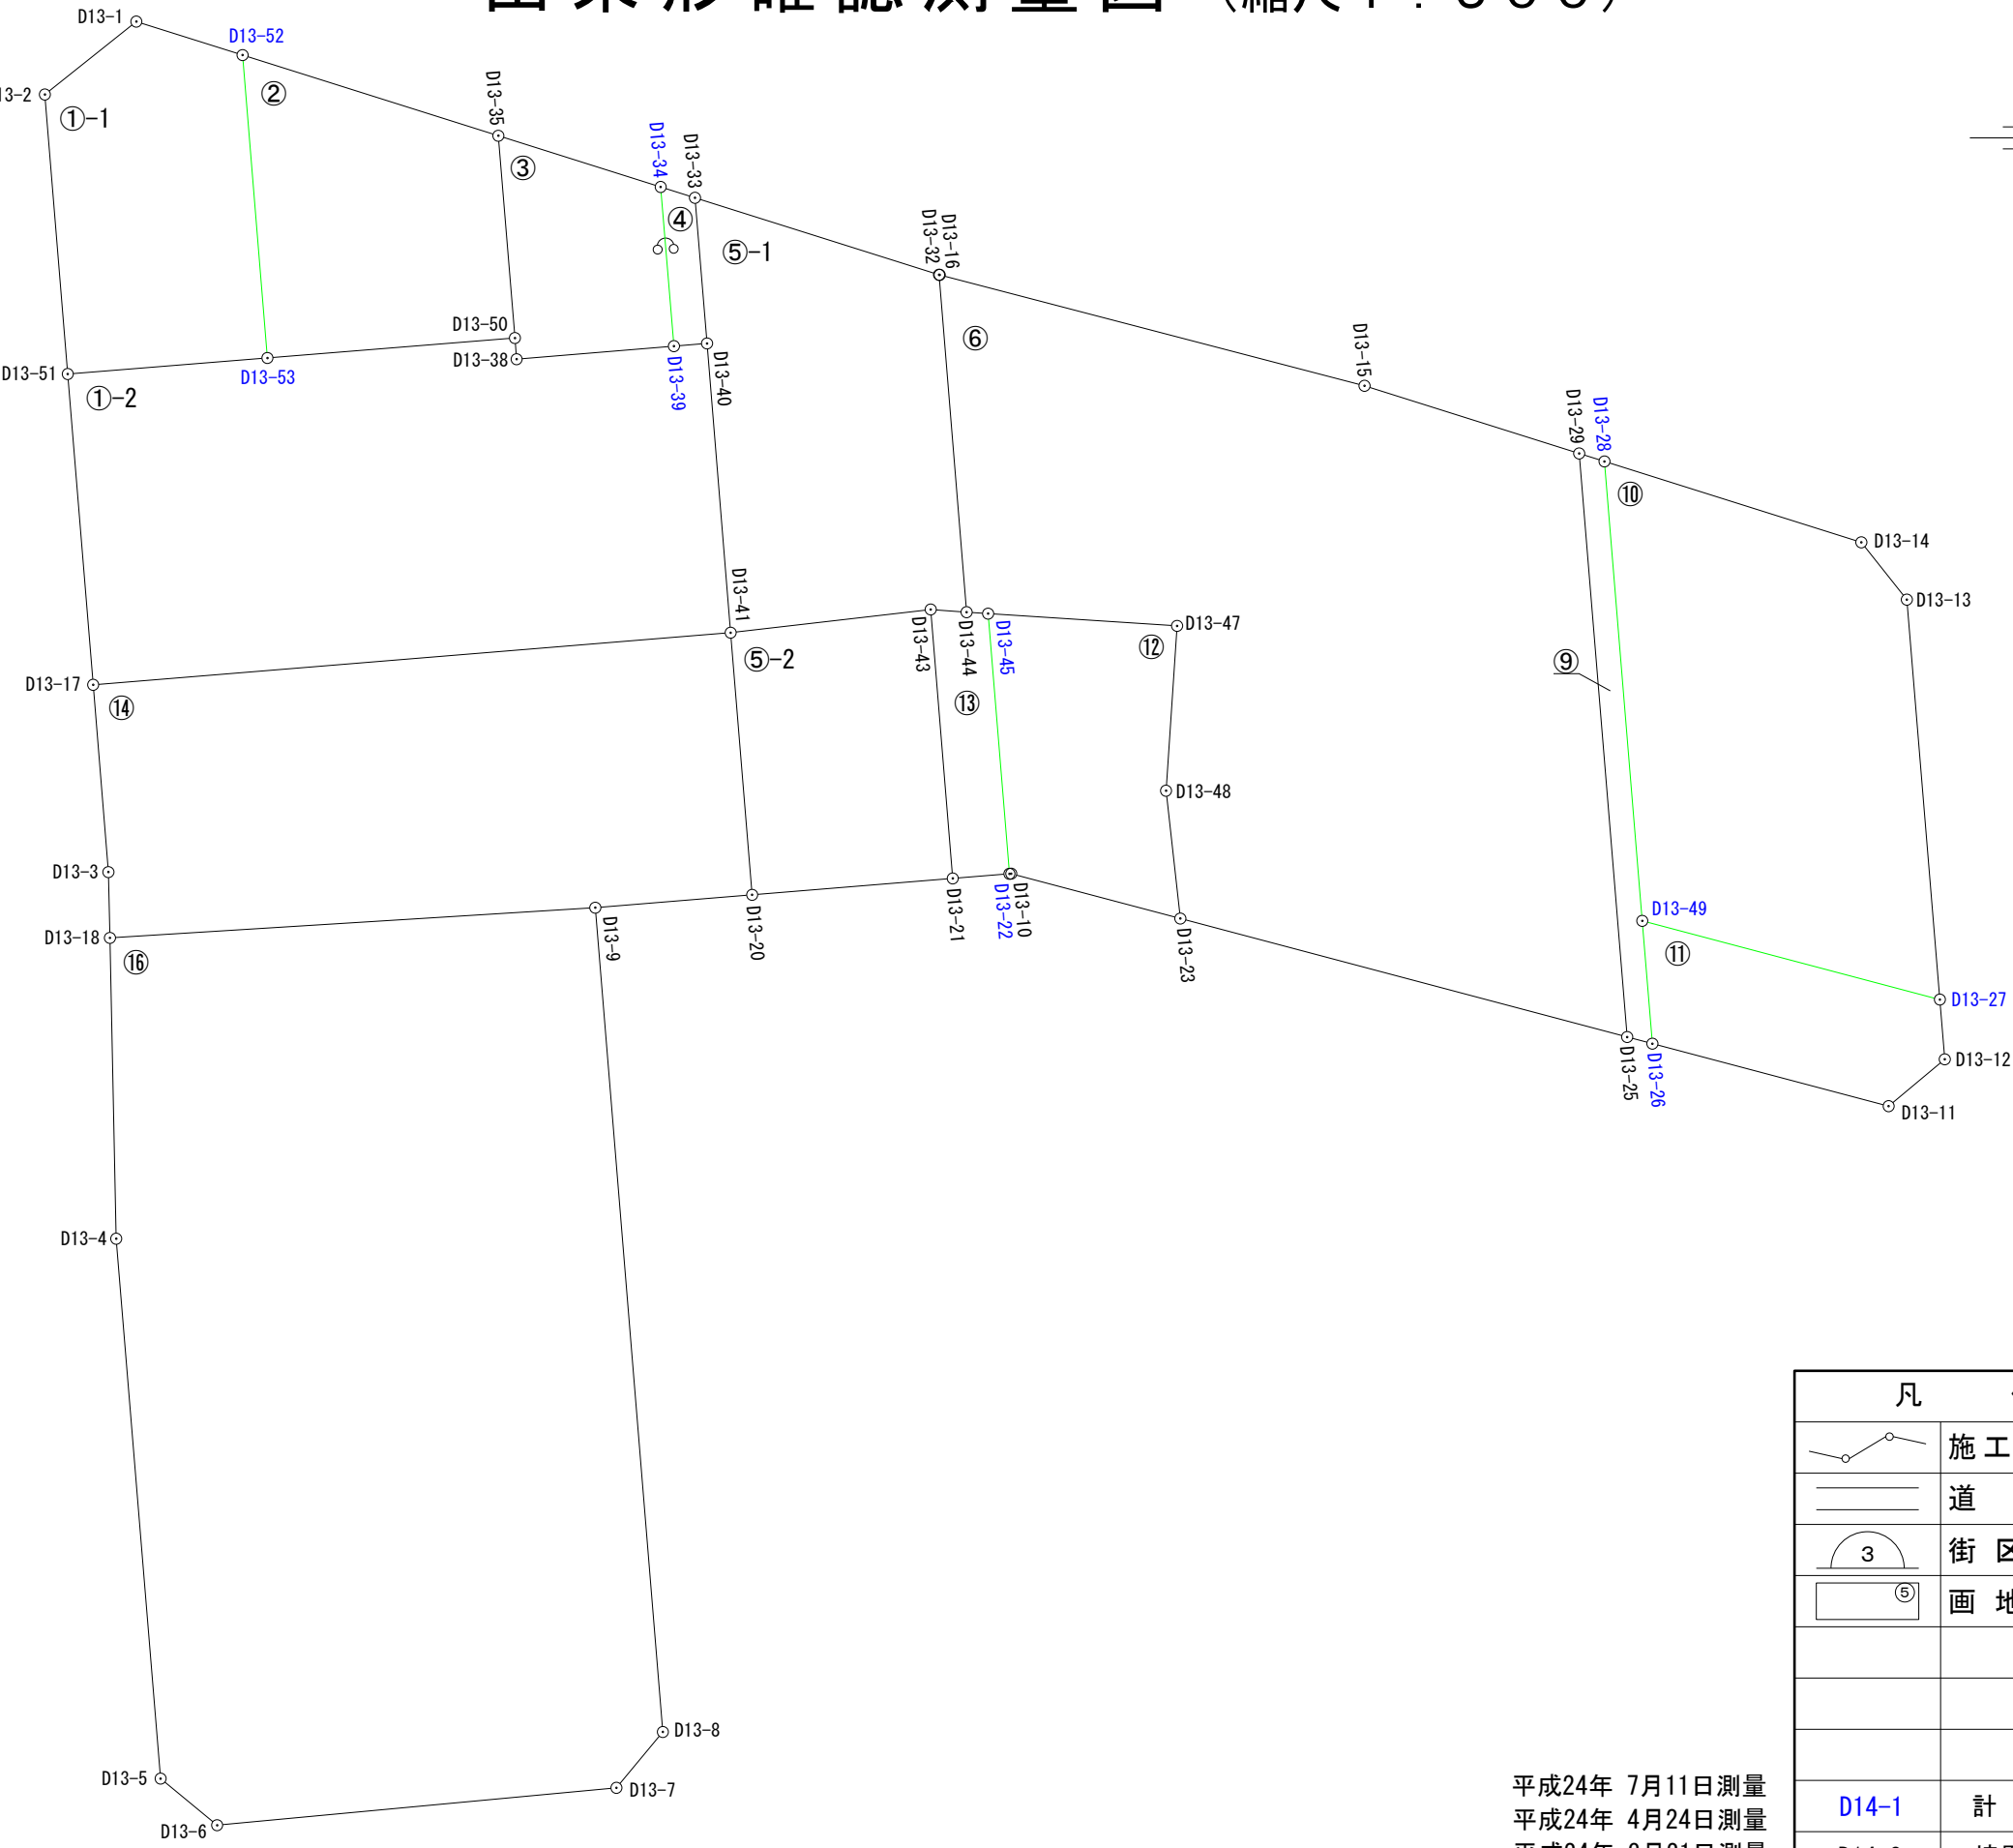

凡 例	
	施工地区界
	道 路
	街区番号
	画 地 番 号
D14-1	計 算 点
D14-2	境界標あり

平成24年 7月11日測量
平成24年 4月24日測量
平成24年 3月21日測量

面積（座標法）計算書

地番： 13D-1-1

測点名	[1] X(i)	[2] X(i+1)-X(i-1)	[3] Y(i)	[4] Y(i+1)-Y(i-1)	[2]*[3]	[1]*[4]	方向角	夾角	距離
D13-1	62095.775	-2.695	-6985.303	-13.523	18825.391585	-839721.165325	231-26-43	123-56-50	8.000
D13-2	62090.789	-24.093	-6991.559	-4.689	168447.630987	-291143.709621	175-18-42	123-51-59	19.171
D13-51	62071.682	-18.008	-6989.992	15.222	125875.775936	944855.143404	85-23-55	90-05-13	13.699
D13-53	62072.781	21.802	-6976.337	11.956	-152098.099274	742142.169636	355-18-31	89-54-36	20.773
D13-52	62093.484	22.994	-6978.036	-8.966	-160452.959784	-556730.177544	287-29-53	112-11-22	7.620
合計				倍面積	597.739450	-597.739450			69.263
				面積	298.8697250	298.8697250			
				坪数	90.40	90.40			

面積（座標法）計算書

地 番： 13D-1-2

測点名	[1] X(i)	[2] X(i+1)-X(i-1)	[3] Y(i)	[4] Y(i+1)-Y(i-1)	[2]*[3]	[1]*[4]	方向角	夾 角	距 離
D13-51	62071.682	-22.335	-6989.992	-11.914	156121.471320	-739522.019348	175-18-47	89-54-52	21.307
D13-17	62050.446	-17.676	-6988.251	45.328	123524.324676	2812622.616288	85-19-50	90-01-03	43.732
D13-41	62054.006	23.329	-6944.664	41.975	-162012.066456	2604716.901850	355-20-18	90-00-28	19.835
D13-40	62073.775	19.582	-6946.276	-3.877	-136021.976632	-240660.025675	265-16-49	89-56-31	2.273
D13-39	62073.588	-1.074	-6948.541	-13.019	7462.733034	-808136.042172	265-17-06	180-00-17	10.791
D13-38	62072.701	0.555	-6959.295	-10.873	-3862.408725	-674916.477973	355-16-57	269-59-51	1.447
D13-50	62074.143	0.080	-6959.414	-17.042	-556.753120	-1057867.545006	265-23-55	90-06-58	16.978
D13-53	62072.781	-2.461	-6976.337	-30.578	17168.765357	-1898061.497418	265-23-55	180-00-00	13.699
合計				倍面積	1824.089454	-1824.089454			130.062
				面 積	912.0447270	912.0447270			
				坪 数	275.89	275.89			

面積（座標法）計算書

地番：13D-2

測点名	[1] X(i)	[2] X(i+1)-X(i-1)	[3] Y(i)	[4] Y(i+1)-Y(i-1)	[2]*[3]	[1]*[4]	方向角	夾角	距離
D13-52	62093.484	-15.190	-6978.036	-15.788	105996.366840	-980331.925392	175-18-31	67-48-38	20.773
D13-53	62072.781	-19.341	-6976.337	18.622	134929.333917	1155919.327782	85-23-55	90-05-24	16.978
D13-50	62074.143	15.190	-6959.414	15.788	-105713.498660	980026.569684	355-18-28	89-54-33	13.875
D13-35	62087.971	19.341	-6960.549	-18.622	-134623.978209	-1156202.195962	287-29-53	112-11-25	18.335
合計				倍面積	588.223888	-588.223888			69.961
				面積	294.1119440	294.1119440			
				坪数	88.96	88.96			

面積（座標法）計算書

地番：13D-3

測点名	[1] X(i)	[2] X(i+1)-X(i-1)	[3] Y(i)	[4] Y(i+1)-Y(i-1)	[2]*[3]	[1]*[4]	方向角	夾角	距離
D13-35	62087.971	-10.327	-6960.549	-9.968	71881.589523	-618892.894928	175-18-28	67-48-24	13.875
D13-50	62074.143	-15.270	-6959.414	1.254	106270.251780	77840.975322	175-16-57	179-58-29	1.447
D13-38	62072.701	-0.555	-6959.295	10.873	3862.408725	674916.477973	85-17-06	90-00-09	10.791
D13-39	62073.588	11.769	-6948.541	9.849	-81777.379029	611362.768212	355-14-45	89-57-39	10.920
D13-34	62084.470	14.383	-6949.446	-12.008	-99953.881818	-745510.315760	287-30-04	112-15-19	11.642
合計				倍面積	282.989181	-282.989181			48.675
				面積	141.4945905	141.4945905			
				坪数	42.80	42.80			

面積（座標法）計算書

地番：13D-4

測点名	[1] X(i)	[2] X(i+1)-X(i-1)	[3] Y(i)	[4] Y(i+1)-Y(i-1)	[2]*[3]	[1]*[4]	方向角	夾角	距離
D13-34	62084.470	-10.143	-6949.446	-1.438	70488.230778	-89277.467860	175-14-45	67-44-25	10.920
D13-39	62073.588	-10.695	-6948.541	3.170	74314.645995	196773.273960	85-16-49	90-02-04	2.273
D13-40	62073.775	10.143	-6946.276	1.438	-70456.077468	89262.088450	355-15-06	89-58-17	9.990
D13-33	62083.731	10.695	-6947.103	-3.170	-74299.266585	-196805.427270	287-30-20	112-15-14	2.457
合計				倍面積	47.532720	-47.532720			25.640
				面積	23.7663600	23.7663600			
				坪数	7.18	7.18			

面積（座標法）計算書

地番：13D-5-1

測点名	[1] X(i)	[2] X(i+1)-X(i-1)	[3] Y(i)	[4] Y(i+1)-Y(i-1)	[2]*[3]	[1]*[4]	方向角	夾角	距離
D13-33	62083.731	-4.695	-6947.103	-15.863	32616.648585	-984834.224853	175-15-06	67-45-21	9.990
D13-40	62073.775	-29.725	-6946.276	2.439	206478.054100	151397.937225	175-20-18	180-05-12	19.835
D13-41	62054.006	-18.184	-6944.664	15.293	126281.770176	948991.913758	83-23-29	88-03-11	13.773
D13-43	62055.591	1.401	-6930.983	16.135	-9710.307183	1001266.960785	94-17-17	190-53-48	2.461
D13-44	62055.407	22.879	-6928.529	0.570	-158517.814991	35371.581990	355-19-48	81-02-31	23.140
D13-32	62078.470	28.324	-6930.413	-18.574	-196297.017812	-1153045.501780	287-29-45	112-09-57	17.500
合計				倍面積	851.332875	-851.332875			86.699
				面積	425.6664375	425.6664375			
				坪数	128.76	128.76			

面積（座標法）計算書

地番：13D-5-2

測点名	[1] X(i)	[2] X(i+1)-X(i-1)	[3] Y(i)	[4] Y(i+1)-Y(i-1)	[2]*[3]	[1]*[4]	方向角	夾角	距離
D13-41	62054.006	-19.502	-6944.664	-12.208	135434.837328	-757555.305248	175-18-01	91-54-32	17.977
D13-20	62036.089	-16.795	-6943.191	15.190	116610.892845	942328.191910	85-19-26	90-01-25	13.763
D13-21	62037.211	19.502	-6929.474	12.208	-135138.601948	757350.271888	355-18-24	89-58-58	18.442
D13-43	62055.591	16.795	-6930.983	-15.190	-116405.859485	-942624.427290	263-23-29	88-05-05	13.773
合計				倍面積	501.268740	-501.268740			63.955
				面積	250.6343700	250.6343700			
				坪数	75.81	75.81			

面積（座標法）計算書

地番：13D-6

測点名	[1] X(i)	[2] X(i+1)-X(i-1)	[3] Y(i)	[4] Y(i+1)-Y(i-1)	[2]*[3]	[1]*[4]	方向角	夾角	距離
D13-32	62078.470	-23.052	-6930.413	1.837	159759.880476	114038.149390	175-19-48	72-09-27	23.140
D13-44	62055.407	-23.159	-6928.529	3.355	160457.803111	208195.890485	93-44-02	98-24-14	1.474
D13-45	62055.311	-0.939	-6927.058	14.397	6504.507462	893410.312467	93-43-53	179-59-51	12.953
D13-47	62054.468	-12.108	-6914.132	12.173	83716.310256	755389.038964	183-49-27	270-05-34	11.290
D13-48	62043.203	-19.997	-6914.885	0.221	138276.955345	13711.547863	173-38-07	169-48-40	8.786
D13-23	62034.471	-16.831	-6913.911	31.527	116368.036041	1955760.767217	104-50-48	111-12-41	31.608
D13-25	62026.372	31.785	-6883.358	27.272	-218787.534030	1691583.217184	355-17-50	70-27-02	40.019
D13-29	62066.256	44.507	-6886.639	-17.959	-306503.641973	-1114647.891504	287-28-57	112-11-07	15.389
D13-15	62070.879	12.203	-6901.317	-43.727	-84216.771351	-2714173.326033	284-37-28	177-08-31	30.022
D13-16	62078.459	7.591	-6930.366	-29.096	-52608.408306	-1806234.843064	283-10-21	178-32-53	0.048
合計				倍面積	2967.137031	-2967.137031			174.729
				面積	1483.5685155	1483.5685155			
				坪数	448.77	448.77			

面積（座標法）計算書

地番：13D-9

測点名	[1] X(i)	[2] X(i+1)-X(i-1)	[3] Y(i)	[4] Y(i+1)-Y(i-1)	[2]*[3]	[1]*[4]	方向角	夾角	距離
D13-29	62066.256	-39.338	-6886.639	1.549	270906.604982	96140.630544	175-17-50	67-48-01	40.019
D13-25	62026.372	-40.342	-6883.358	5.008	277688.428436	310628.070976	104-51-11	109-33-21	1.787
D13-26	62025.914	7.937	-6881.631	1.036	-54619.505247	64258.846904	355-17-40	70-26-29	8.423
D13-49	62034.309	39.796	-6882.322	-3.276	-273888.886312	-203224.396284	355-17-38	179-59-58	31.507
D13-28	62065.710	31.947	-6884.907	-4.317	-219952.123929	-267937.670070	287-29-49	112-12-11	1.816
合計				倍面積	134.517930	-134.517930			83.552
				面積	67.2589650	67.2589650			
				坪数	20.34	20.34			

面積（座標法）計算書

地番：13D-10

測点名	[1] X(i)	[2] X(i+1)-X(i-1)	[3] Y(i)	[4] Y(i+1)-Y(i-1)	[2]*[3]	[1]*[4]	方向角	夾角	距離
D13-28	62065.710	-25.869	-6884.907	-14.978	178105.659183	-929620.204380	175-17-38	67-48-38	31.507
D13-49	62034.309	-36.781	-6882.322	22.932	253138.685482	1422570.773988	104-48-39	109-31-01	21.046
D13-27	62028.929	21.953	-6861.975	18.088	-150640.937175	1121979.267752	355-16-31	70-27-52	27.426
D13-13	62056.262	31.249	-6864.234	-5.369	-214500.448266	-333180.070678	321-32-39	146-16-08	5.001
D13-14	62060.178	9.448	-6867.344	-20.673	-64882.666112	-1282970.059794	287-29-00	145-56-21	18.414
合計				倍面積	1220.293112	-1220.293112			103.394
				面積	610.1465560	610.1465560			
				坪数	184.56	184.56			

面積（座標法）計算書

地番：13D-11

測点名	[1] X(i)	[2] X(i+1)-X(i-1)	[3] Y(i)	[4] Y(i+1)-Y(i-1)	[2]*[3]	[1]*[4]	方向角	夾角	距離
D13-49	62034.309	-3.015	-6882.322	-19.656	20750.200830	-1219346.377704	175-17-40	70-29-01	8.423
D13-26	62025.914	-12.666	-6881.631	16.844	87162.738246	1044764.495416	104-48-38	109-30-58	16.708
D13-11	62021.643	-1.065	-6865.478	19.994	7311.734070	1240060.730142	50-08-56	125-20-18	5.003
D13-12	62024.849	7.286	-6861.637	3.503	-49993.887182	217273.046047	355-15-51	125-06-55	4.094
D13-27	62028.929	9.460	-6861.975	-20.685	-64914.283500	-1283068.396365	284-48-39	109-32-48	21.046
合計				倍面積	316.502464	-316.502464			55.274
				面積	158.2512320	158.2512320			
				坪数	47.87	47.87			

面積（座標法）計算書

地番：13D-12

測点名	[1] X(i)	[2] X(i+1)-X(i-1)	[3] Y(i)	[4] Y(i+1)-Y(i-1)	[2]*[3]	[1]*[4]	方向角	夾角	距離
D13-45	62055.311	-16.944	-6927.058	-11.466	117372.070752	-711526.195926	175-18-27	81-34-34	17.847
D13-22	62037.524	-17.777	-6925.598	1.582	123116.355646	98143.362968	85-18-51	90-00-24	0.122
D13-10	62037.534	-3.053	-6925.476	11.687	21143.478228	725032.659858	104-50-03	199-31-12	11.964
D13-23	62034.471	5.669	-6913.911	10.591	-39194.961459	657007.082361	353-38-07	68-48-04	8.786
D13-48	62043.203	19.997	-6914.885	-0.221	-138276.955345	-13711.547863	3-49-27	190-11-20	11.290
D13-47	62054.468	12.108	-6914.132	-12.173	-83716.310256	-755389.038964	273-43-53	89-54-26	12.953
合計				倍面積	443.677566	-443.677566			62.962
				面積	221.8387830	221.8387830			
				坪数	67.10	67.10			

面積（座標法）計算書

地番：13D-13

測点名	[1] X(i)	[2] X(i+1)-X(i-1)	[3] Y(i)	[4] Y(i+1)-Y(i-1)	[2]*[3]	[1]*[4]	方向角	夾角	距離
D13-43	62055.591	-18.196	-6930.983	-0.945	126116.166668	-58642.533495	175-18-24	81-01-07	18.442
D13-21	62037.211	-18.067	-6929.474	5.385	125194.806758	334070.381235	85-22-59	90-04-35	3.889
D13-22	62037.524	18.100	-6925.598	2.416	-125353.323800	149882.657984	355-18-27	89-55-28	17.847
D13-45	62055.311	17.883	-6927.058	-2.931	-123876.578214	-181884.116541	273-44-02	98-25-35	1.474
D13-44	62055.407	0.280	-6928.529	-3.925	-1939.988120	-243567.472475	274-17-17	180-33-15	2.461
合計				倍面積	141.083292	-141.083292			44.113
				面積	70.5416460	70.5416460			
				坪数	21.33	21.33			

面積（座標法）計算書

地番：13D-14

測点名	[1] X(i)	[2] X(i+1)-X(i-1)	[3] Y(i)	[4] Y(i+1)-Y(i-1)	[2]*[3]	[1]*[4]	方向角	夾角	距離
D13-17	62050.446	-16.362	-6988.251	-42.548	114341.762862	-2640122.376408	175-21-36	90-01-46	12.844
D13-3	62037.644	-17.304	-6987.212	1.146	120906.716448	71095.140024	178-38-19	183-16-43	4.503
D13-18	62033.142	-2.434	-6987.105	33.297	17006.613570	2065517.529174	86-26-05	87-47-46	33.254
D13-9	62035.210	2.947	-6953.915	43.914	-20493.187505	2724214.211940	85-18-51	178-52-46	10.760
D13-20	62036.089	18.796	-6943.191	9.251	-130504.218036	573895.859339	355-18-01	89-59-10	17.977
D13-41	62054.006	14.357	-6944.664	-45.060	-99704.541048	-2796153.510360	265-19-50	90-01-49	43.732
合計				倍面積	1553.146291	-1553.146291			123.070
				面積	776.5731455	776.5731455			
				坪数	234.91	234.91			

面積（座標法）計算書

地番：13D-16

測点名	[1] X(i)	[2] X(i+1)-X(i-1)	[3] Y(i)	[4] Y(i+1)-Y(i-1)	[2]*[3]	[1]*[4]	方向角	夾角	距離
D13-18	62033.142	-22.624	-6987.105	-32.760	158076.263520	-2032205.731920	178-48-06	92-22-01	20.560
D13-4	62012.586	-57.457	-6986.675	3.463	401433.385475	214749.585318	175-18-05	176-29-59	37.025
D13-5	61975.685	-40.089	-6983.642	6.897	279967.224138	427446.299445	129-31-28	134-13-23	5.009
D13-6	61972.497	-0.632	-6979.778	31.170	4411.219696	1931682.731490	84-39-09	135-07-41	27.425
D13-7	61975.053	6.378	-6952.472	30.483	-44342.866416	1889185.540599	39-44-05	135-04-56	4.970
D13-8	61978.875	60.157	-6949.295	-1.443	-418048.739315	-89435.516625	355-18-42	135-34-37	56.524
D13-9	62035.210	54.267	-6953.915	-37.810	-377368.105305	-2345551.290100	266-26-05	91-07-23	33.254
合計				倍面積	4128.381793	-4128.381793			184.767
				面積	2064.1908965	2064.1908965			
				坪数	624.41	624.41			