
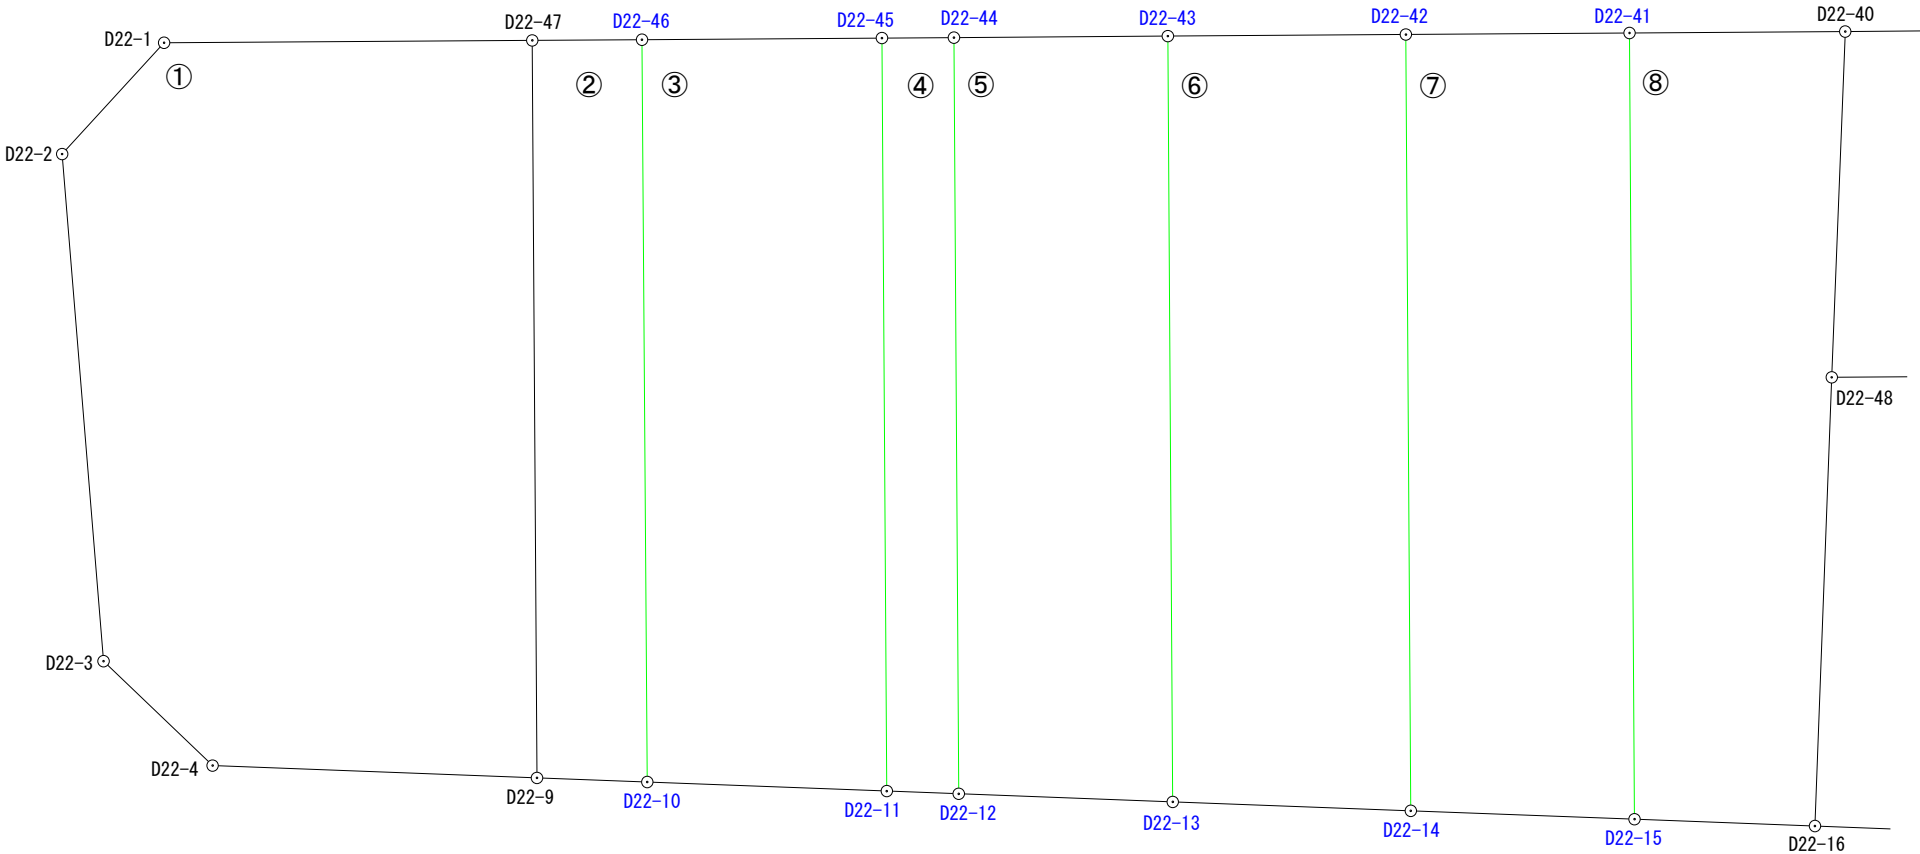


出来形確認測量図（縮尺１：２５０）

2-1

2-2

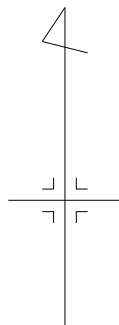



座 標 一 覧 表

| 測 点 名  | X 座 標     | Y 座 標     |
|--------|-----------|-----------|
| D22-1  | 61876.365 | -6891.046 |
| D22-2  | 61872.684 | -6894.419 |
| D22-3  | 61855.918 | -6893.050 |
| D22-4  | 61852.466 | -6889.443 |
| D22-9  | 61852.059 | -6878.713 |
| D22-10 | 61851.922 | -6875.067 |
| D22-11 | 61851.623 | -6867.145 |
| D22-12 | 61851.533 | -6864.766 |
| D22-13 | 61851.266 | -6857.688 |
| D22-14 | 61850.971 | -6849.815 |


| 測 点 名  | X 座 標     | Y 座 標     |
|--------|-----------|-----------|
| D22-15 | 61850.692 | -6842.415 |
| D22-16 | 61850.468 | -6836.447 |
| D22-40 | 61876.736 | -6835.444 |
| D22-41 | 61876.688 | -6842.579 |
| D22-42 | 61876.638 | -6849.977 |
| D22-43 | 61876.584 | -6857.849 |
| D22-44 | 61876.536 | -6864.925 |
| D22-45 | 61876.520 | -6867.304 |
| D22-46 | 61876.466 | -6875.242 |
| D22-47 | 61876.442 | -6878.868 |
| D22-48 | 61865.302 | -6835.893 |

| 凡 例   |       |
|-------|-------|
|       | 施工地区界 |
|       | 道 路   |
|       | 街区番号  |
|       | 画地番号  |
|       |       |
|       |       |
|       |       |
| D14-1 | 計 算 点 |
| D14-2 | 境界標あり |


出来形確認測量図（縮尺1：250）

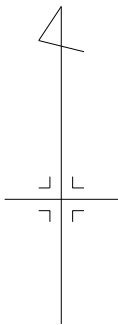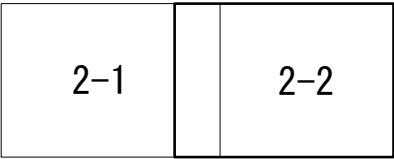

| 座 標 一 覧 表 |   |           |           |
|-----------|---|-----------|-----------|
| 測 点 名     | X | 座 標       | Y 座 標     |
| D22-5     |   | 61848.691 | -6789.792 |
| D22-6     |   | 61852.624 | -6786.713 |
| D22-7     |   | 61873.996 | -6792.912 |
| D22-8     |   | 61876.992 | -6796.918 |
| D22-16    |   | 61850.468 | -6836.447 |
| D22-17    |   | 61850.185 | -6829.077 |
| D22-19    |   | 61849.986 | -6823.878 |
| D22-21    |   | 61849.792 | -6818.752 |
| D22-23    |   | 61849.561 | -6812.701 |
| D22-25    |   | 61849.439 | -6809.499 |
| D22-26    |   | 61849.424 | -6809.099 |
| D22-27    |   | 61849.210 | -6803.479 |
| D22-28    |   | 61854.519 | -6787.260 |
| D22-30    |   | 61857.393 | -6788.089 |
| D22-31    |   | 61864.087 | -6790.035 |
| D22-33    |   | 61866.366 | -6790.698 |
| D22-34    |   | 61876.955 | -6803.324 |
| D22-36    |   | 61876.934 | -6807.187 |
| D22-37    |   | 61876.911 | -6810.519 |
| D22-38    |   | 61876.820 | -6823.901 |
| D22-39    |   | 61876.802 | -6826.381 |
| D22-40    |   | 61876.736 | -6835.444 |
| D22-48    |   | 61865.302 | -6835.893 |
| D22-49    |   | 61865.356 | -6828.519 |
| D22-51    |   | 61865.372 | -6826.326 |
| D22-52    |   | 61865.390 | -6823.845 |
| D22-53    |   | 61865.392 | -6823.312 |
| D22-54    |   | 61865.393 | -6821.189 |
| D22-55    |   | 61867.789 | -6820.958 |
| D22-56    |   | 61868.655 | -6819.868 |
| D22-58    |   | 61868.450 | -6817.203 |
| D22-60    |   | 61867.991 | -6811.236 |
| D22-61    |   | 61867.986 | -6811.171 |
| D22-63    |   | 61867.711 | -6807.982 |
| D22-64    |   | 61867.706 | -6807.927 |
| D22-66    |   | 61867.407 | -6804.081 |
| D22-67    |   | 61867.235 | -6801.848 |
| D22-69    |   | 61865.023 | -6802.034 |
| D22-70    |   | 61859.360 | -6802.510 |
| D22-72    |   | 61856.634 | -6802.771 |
| D22-73    |   | 61849.813 | -6809.468 |
| D22-74    |   | 61849.780 | -6809.069 |

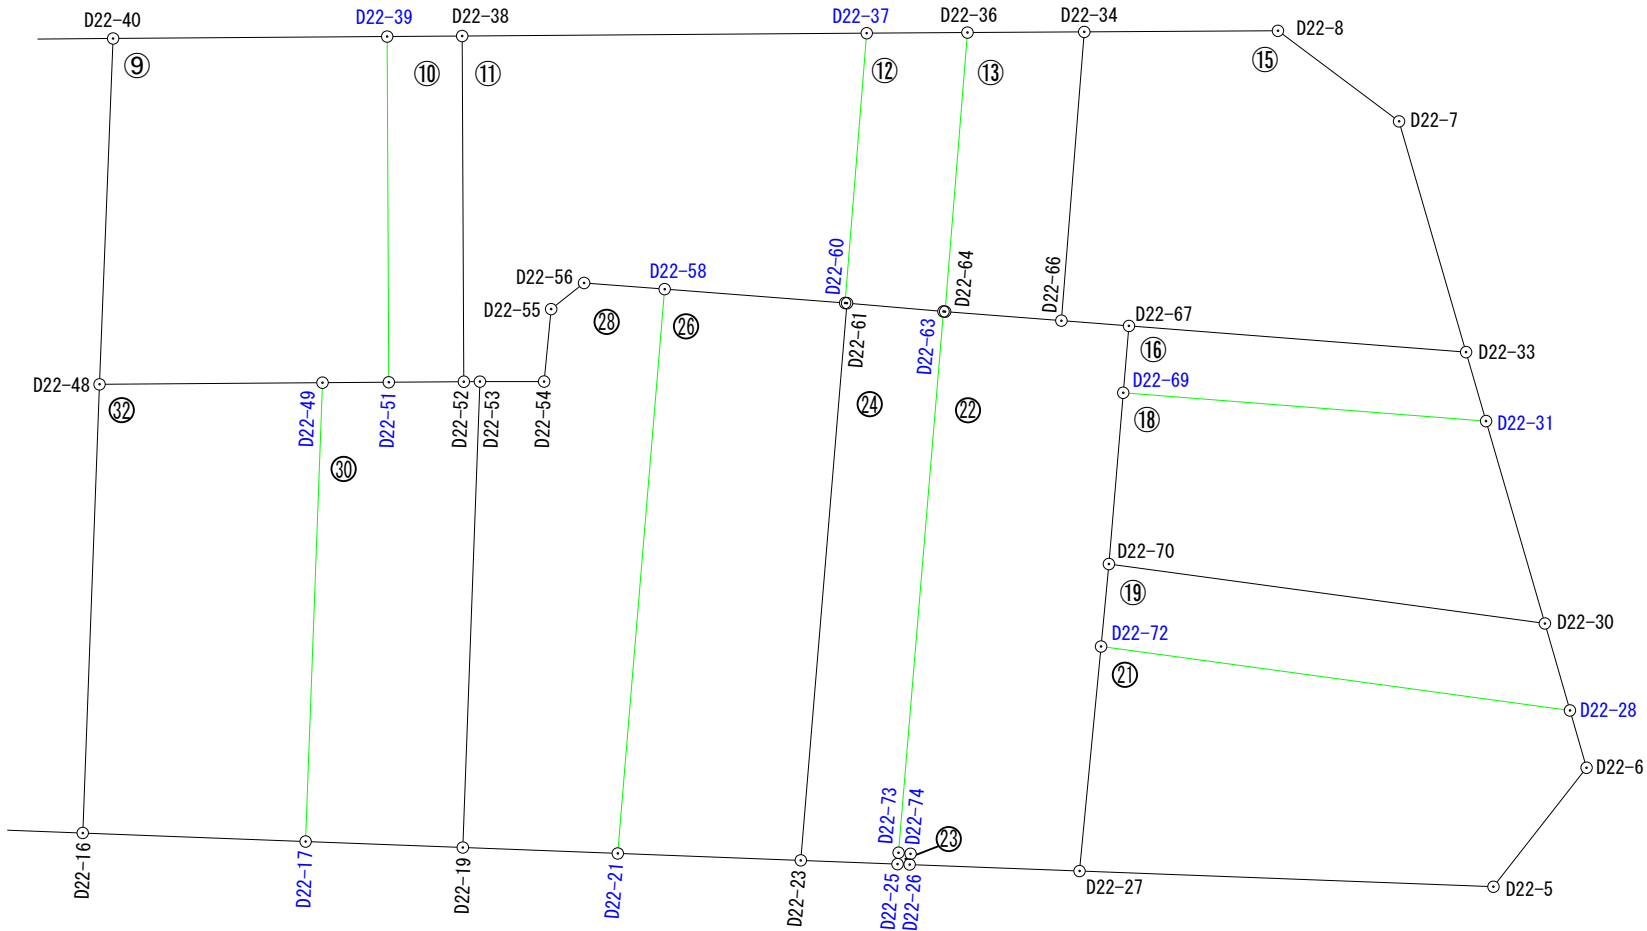

拡大図 S=1：50

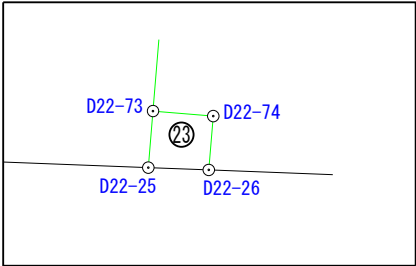

| 凡 例   |       |
|-------|-------|
|       | 施工地区界 |
|       | 道 路   |
|       | 街区番号  |
|       | 画地番号  |
|       |       |
|       |       |
|       |       |
|       |       |
| D14-1 | 計 算 点 |
| D14-2 | 境界標あり |

# 面積（座標法）計算書

地番： 22D-1

| 測点名    | [1]<br>X(i) | [2]<br>X(i+1)-X(i-1) | [3]<br>Y(i) | [4]<br>Y(i+1)-Y(i-1) | [2]*[3]        | [1]*[4]        | 方向角       | 夾角        | 距離     |
|--------|-------------|----------------------|-------------|----------------------|----------------|----------------|-----------|-----------|--------|
| D22-1  | 61876.365   | -3.758               | -6891.046   | -15.551              | 25896.550868   | -962239.352115 | 222-30-00 | 132-51-44 | 4.993  |
| D22-2  | 61872.684   | -20.447              | -6894.419   | -2.004               | 140970.185293  | -123992.858736 | 175-19-55 | 132-49-55 | 16.822 |
| D22-3  | 61855.918   | -20.218              | -6893.050   | 4.976                | 139363.684900  | 307795.047968  | 133-44-32 | 138-24-37 | 4.993  |
| D22-4  | 61852.466   | -3.859               | -6889.443   | 14.337               | 26586.360537   | 886778.805042  | 92-10-20  | 138-25-48 | 10.738 |
| D22-9  | 61852.059   | 23.976               | -6878.713   | 10.575               | -164924.022888 | 654085.523925  | 359-38-09 | 87-27-49  | 24.383 |
| D22-47 | 61876.442   | 24.306               | -6878.868   | -12.333              | -167197.765608 | -763122.159186 | 269-38-16 | 90-00-07  | 12.178 |
| 合計     |             |                      |             | 倍面積                  | 694.993102     | -694.993102    |           |           | 74.107 |
|        |             |                      |             | 面積                   | 347.4965510    | 347.4965510    |           |           |        |
|        |             |                      |             | 坪数                   | 105.11         | 105.11         |           |           |        |

# 面積（座標法）計算書

地番：22D-2

| 測点名    | [1]<br>X(i) | [2]<br>X(i+1)-X(i-1) | [3]<br>Y(i) | [4]<br>Y(i+1)-Y(i-1) | [2]*[3]        | [1]*[4]        | 方向角       | 夾角       | 距離     |
|--------|-------------|----------------------|-------------|----------------------|----------------|----------------|-----------|----------|--------|
| D22-47 | 61876.442   | -24.407              | -6878.868   | -3.471               | 167892.531276  | -214773.130182 | 179-38-09 | 90-00-54 | 24.383 |
| D22-9  | 61852.059   | -24.520              | -6878.713   | 3.801                | 168666.042760  | 235099.676259  | 92-09-07  | 92-30-58 | 3.649  |
| D22-10 | 61851.922   | 24.407               | -6875.067   | 3.471                | -167799.760269 | 214688.021262  | 359-35-29 | 87-26-22 | 24.545 |
| D22-46 | 61876.466   | 24.520               | -6875.242   | -3.801               | -168580.933840 | -235192.447266 | 269-37-15 | 90-01-46 | 3.626  |
| 合計     |             |                      |             | 倍面積                  | 177.879927     | -177.879927    |           |          | 56.203 |
|        |             |                      |             | 面積                   | 88.9399635     | 88.9399635     |           |          |        |
|        |             |                      |             | 坪数                   | 26.90          | 26.90          |           |          |        |

# 面積（座標法）計算書

地番：22D-3

| 測点名    | [1]<br>X(i) | [2]<br>X(i+1)-X(i-1) | [3]<br>Y(i) | [4]<br>Y(i+1)-Y(i-1) | [2]*[3]        | [1]*[4]        | 方向角       | 夾角       | 距離     |
|--------|-------------|----------------------|-------------|----------------------|----------------|----------------|-----------|----------|--------|
| D22-46 | 61876.466   | -24.598              | -6875.242   | -7.763               | 169117.202716  | -480347.005558 | 179-35-29 | 89-58-52 | 24.545 |
| D22-10 | 61851.922   | -24.843              | -6875.067   | 8.097                | 170797.289481  | 500815.012434  | 92-09-41  | 92-34-12 | 7.928  |
| D22-11 | 61851.623   | 24.598               | -6867.145   | 7.763                | -168918.032710 | 480154.149349  | 359-38-03 | 87-28-22 | 24.898 |
| D22-45 | 61876.520   | 24.843               | -6867.304   | -8.097               | -170604.433272 | -501014.182440 | 269-36-37 | 89-58-34 | 7.938  |
| 合計     |             |                      |             | 倍面積                  | 392.026215     | -392.026215    |           |          | 65.309 |
|        |             |                      |             | 面積                   | 196.0131075    | 196.0131075    |           |          |        |
|        |             |                      |             | 坪数                   | 59.29          | 59.29          |           |          |        |

# 面積（座標法）計算書

地番：22D-4

| 測点名    | [1]<br>X(i) | [2]<br>X(i+1)-X(i-1) | [3]<br>Y(i) | [4]<br>Y(i+1)-Y(i-1) | [2]*[3]        | [1]*[4]        | 方向角       | 夾角       | 距離     |
|--------|-------------|----------------------|-------------|----------------------|----------------|----------------|-----------|----------|--------|
| D22-45 | 61876.520   | -24.913              | -6867.304   | -2.220               | 171085.144552  | -137365.874400 | 179-38-03 | 90-01-10 | 24.898 |
| D22-11 | 61851.623   | -24.987              | -6867.145   | 2.538                | 171589.352115  | 156979.419174  | 92-09-59  | 92-31-56 | 2.381  |
| D22-12 | 61851.533   | 24.913               | -6864.766   | 2.220                | -171021.915358 | 137310.403260  | 359-38-08 | 87-28-09 | 25.004 |
| D22-44 | 61876.536   | 24.987               | -6864.925   | -2.538               | -171533.880975 | -157042.648368 | 269-36-53 | 89-58-45 | 2.379  |
| 合計     |             |                      |             | 倍面積                  | 118.700334     | -118.700334    |           |          | 54.662 |
|        |             |                      |             | 面積                   | 59.3501670     | 59.3501670     |           |          |        |
|        |             |                      |             | 坪数                   | 17.95          | 17.95          |           |          |        |

# 面積（座標法）計算書

地番：22D-5

| 測点名    | [1]<br>X(i) | [2]<br>X(i+1)-X(i-1) | [3]<br>Y(i) | [4]<br>Y(i+1)-Y(i-1) | [2]*[3]        | [1]*[4]        | 方向角       | 夾角       | 距離     |
|--------|-------------|----------------------|-------------|----------------------|----------------|----------------|-----------|----------|--------|
| D22-44 | 61876.536   | -25.051              | -6864.925   | -6.917               | 171973.236175  | -427999.999512 | 179-38-08 | 90-01-27 | 25.004 |
| D22-12 | 61851.533   | -25.270              | -6864.766   | 7.237                | 173472.636820  | 447619.544321  | 92-09-37  | 92-31-29 | 7.083  |
| D22-13 | 61851.266   | 25.051               | -6857.688   | 6.917                | -171791.942088 | 427825.206922  | 359-38-08 | 87-28-31 | 25.319 |
| D22-43 | 61876.584   | 25.270               | -6857.849   | -7.237               | -173297.844230 | -447800.838408 | 269-36-41 | 89-58-33 | 7.076  |
| 合計     |             |                      |             | 倍面積                  | 356.086677     | -356.086677    |           |          | 64.482 |
|        |             |                      |             | 面積                   | 178.0433385    | 178.0433385    |           |          |        |
|        |             |                      |             | 坪数                   | 53.85          | 53.85          |           |          |        |

# 面積（座標法）計算書

地番：22D-6

| 測点名    | [1]<br>X(i) | [2]<br>X(i+1)-X(i-1) | [3]<br>Y(i) | [4]<br>Y(i+1)-Y(i-1) | [2]*[3]        | [1]*[4]        | 方向角       | 夾角       | 距離     |
|--------|-------------|----------------------|-------------|----------------------|----------------|----------------|-----------|----------|--------|
| D22-43 | 61876.584   | -25.372              | -6857.849   | -7.711               | 173997.344828  | -477130.339224 | 179-38-08 | 90-01-43 | 25.319 |
| D22-13 | 61851.266   | -25.613              | -6857.688   | 8.034                | 175645.962744  | 496913.071044  | 92-08-45  | 92-30-37 | 7.879  |
| D22-14 | 61850.971   | 25.372               | -6849.815   | 7.711                | -173793.506180 | 476932.837381  | 359-38-18 | 87-29-33 | 25.668 |
| D22-42 | 61876.638   | 25.613               | -6849.977   | -8.034               | -175448.460901 | -497116.909692 | 269-36-25 | 89-58-07 | 7.872  |
| 合計     |             |                      |             | 倍面積                  | 401.340491     | -401.340491    |           |          | 66.738 |
|        |             |                      |             | 面積                   | 200.6702455    | 200.6702455    |           |          |        |
|        |             |                      |             | 坪数                   | 60.70          | 60.70          |           |          |        |

# 面積（座標法）計算書

地番：22D-7

| 測点名    | [1]<br>X(i) | [2]<br>X(i+1)-X(i-1) | [3]<br>Y(i) | [4]<br>Y(i+1)-Y(i-1) | [2]*[3]        | [1]*[4]        | 方向角       | 夾角       | 距離     |
|--------|-------------|----------------------|-------------|----------------------|----------------|----------------|-----------|----------|--------|
| D22-42 | 61876.638   | -25.717              | -6849.977   | -7.236               | 176160.858509  | -447739.352568 | 179-38-18 | 90-01-32 | 25.668 |
| D22-14 | 61850.971   | -25.946              | -6849.815   | 7.562                | 177725.299990  | 467717.042702  | 92-09-33  | 92-31-15 | 7.405  |
| D22-15 | 61850.692   | 25.717               | -6842.415   | 7.236                | -175966.386555 | 447551.607312  | 359-38-19 | 87-28-46 | 25.997 |
| D22-41 | 61876.688   | 25.946               | -6842.579   | -7.562               | -177537.554734 | -467911.514656 | 269-36-46 | 89-58-27 | 7.398  |
| 合計     |             |                      |             | 倍面積                  | 382.217210     | -382.217210    |           |          | 66.468 |
|        |             |                      |             | 面積                   | 191.1086050    | 191.1086050    |           |          |        |
|        |             |                      |             | 坪数                   | 57.81          | 57.81          |           |          |        |

# 面積（座標法）計算書

地番：22D-8

| 測点名    | [1]<br>X(i) | [2]<br>X(i+1)-X(i-1) | [3]<br>Y(i) | [4]<br>Y(i+1)-Y(i-1) | [2]*[3]        | [1]*[4]        | 方向角       | 夾角        | 距離     |
|--------|-------------|----------------------|-------------|----------------------|----------------|----------------|-----------|-----------|--------|
| D22-41 | 61876.688   | -26.044              | -6842.579   | -6.971               | 178208.127476  | -431342.392048 | 179-38-19 | 90-01-27  | 25.997 |
| D22-15 | 61850.692   | -26.220              | -6842.415   | 6.132                | 179408.121300  | 379268.443344  | 92-08-58  | 92-30-39  | 5.972  |
| D22-16 | 61850.468   | 14.610               | -6836.447   | 6.522                | -99880.490670  | 403388.752296  | 2-08-20   | 89-59-22  | 14.844 |
| D22-48 | 61865.302   | 26.268               | -6835.893   | 1.003                | -179565.237324 | 62050.897906   | 2-14-56   | 180-06-36 | 11.443 |
| D22-40 | 61876.736   | 11.386               | -6835.444   | -6.686               | -77828.365384  | -413707.856896 | 269-36-52 | 87-21-56  | 7.135  |
| 合計     |             |                      |             | 倍面積                  | 342.155398     | -342.155398    |           |           | 65.391 |
|        |             |                      |             | 面積                   | 171.0776990    | 171.0776990    |           |           |        |
|        |             |                      |             | 坪数                   | 51.75          | 51.75          |           |           |        |

# 面積（座標法）計算書

地番： 22D-9

| 測点名    | [1]<br>X(i) | [2]<br>X(i+1)-X(i-1) | [3]<br>Y(i) | [4]<br>Y(i+1)-Y(i-1) | [2]*[3]       | [1]*[4]        | 方向角       | 夾角        | 距離     |
|--------|-------------|----------------------|-------------|----------------------|---------------|----------------|-----------|-----------|--------|
| D22-40 | 61876.736   | -11.500              | -6835.444   | -9.512               | 78607.606000  | -588571.512832 | 182-14-56 | 92-39-58  | 11.443 |
| D22-48 | 61865.302   | -11.380              | -6835.893   | 6.925                | 77792.462340  | 428417.216350  | 89-34-50  | 87-19-54  | 7.374  |
| D22-49 | 61865.356   | 0.070                | -6828.519   | 9.567                | -477.996330   | 591865.860852  | 89-34-55  | 180-00-05 | 2.193  |
| D22-51 | 61865.372   | 11.446               | -6826.326   | 2.138                | -78134.127396 | 132268.165336  | 359-43-27 | 90-08-32  | 11.430 |
| D22-39 | 61876.802   | 11.364               | -6826.381   | -9.118               | -77574.993684 | -564192.680636 | 269-34-58 | 89-51-31  | 9.063  |
| 合計     |             |                      |             | 倍面積                  | 212.950930    | -212.950930    |           |           | 41.503 |
|        |             |                      |             | 面積                   | 106.4754650   | 106.4754650    |           |           |        |
|        |             |                      |             | 坪数                   | 32.20         | 32.20          |           |           |        |

# 面積（座標法）計算書

地番：22D-10

| 測点名    | [1]<br>X(i) | [2]<br>X(i+1)-X(i-1) | [3]<br>Y(i) | [4]<br>Y(i+1)-Y(i-1) | [2]*[3]       | [1]*[4]        | 方向角       | 夾角       | 距離     |
|--------|-------------|----------------------|-------------|----------------------|---------------|----------------|-----------|----------|--------|
| D22-39 | 61876.802   | -11.448              | -6826.381   | -2.425               | 78148.409688  | -150051.244850 | 179-43-27 | 90-08-24 | 11.430 |
| D22-51 | 61865.372   | -11.412              | -6826.326   | 2.536                | 77902.032312  | 156890.583392  | 89-35-04  | 89-51-37 | 2.481  |
| D22-52 | 61865.390   | 11.448               | -6823.845   | 2.425                | -78119.377560 | 150023.570750  | 359-43-09 | 90-08-05 | 11.430 |
| D22-38 | 61876.820   | 11.412               | -6823.901   | -2.536               | -77874.358212 | -156919.615520 | 269-35-03 | 89-51-54 | 2.480  |
| 合計     |             |                      |             | 倍面積                  | 56.706228     | -56.706228     |           |          | 27.821 |
|        |             |                      |             | 面積                   | 28.3531140    | 28.3531140     |           |          |        |
|        |             |                      |             | 坪数                   | 8.57          | 8.57           |           |          |        |

# 面積（座標法）計算書

地番：22D-11

| 測点名    | [1]<br>X(i) | [2]<br>X(i+1)-X(i-1) | [3]<br>Y(i) | [4]<br>Y(i+1)-Y(i-1) | [2]*[3]       | [1]*[4]        | 方向角       | 夾角        | 距離     |
|--------|-------------|----------------------|-------------|----------------------|---------------|----------------|-----------|-----------|--------|
| D22-38 | 61876.820   | -11.521              | -6823.901   | -13.326              | 78618.163421  | -824570.503320 | 179-43-09 | 90-06-32  | 11.430 |
| D22-52 | 61865.390   | -11.428              | -6823.845   | 0.589                | 77982.900660  | 36438.714710   | 89-47-06  | 90-03-57  | 0.533  |
| D22-53 | 61865.392   | 0.003                | -6823.312   | 2.656                | -20.469936    | 164314.481152  | 89-58-23  | 180-11-17 | 2.123  |
| D22-54 | 61865.393   | 2.397                | -6821.189   | 2.354                | -16350.390033 | 145631.135122  | 5-30-25   | 95-32-02  | 2.407  |
| D22-55 | 61867.789   | 3.262                | -6820.958   | 1.321                | -22249.964996 | 81727.349269   | 51-31-59  | 226-01-34 | 1.392  |
| D22-56 | 61868.655   | 0.661                | -6819.868   | 3.755                | -4507.932748  | 232316.799525  | 94-23-55  | 222-51-56 | 2.673  |
| D22-58 | 61868.450   | -0.664               | -6817.203   | 8.632                | 4526.622792   | 534048.460400  | 94-23-55  | 180-00-00 | 5.985  |
| D22-60 | 61867.991   | 8.461                | -6811.236   | 6.684                | -57629.867796 | 413525.651844  | 4-35-44   | 90-11-49  | 8.949  |
| D22-37 | 61876.911   | 8.829                | -6810.519   | -12.665              | -60130.072251 | -783671.077815 | 269-36-37 | 85-00-53  | 13.382 |
| 合計     |             |                      |             | 倍面積                  | 238.989113    | -238.989113    |           |           | 48.874 |
|        |             |                      |             | 面積                   | 119.4945565   | 119.4945565    |           |           |        |
|        |             |                      |             | 坪数                   | 36.14         | 36.14          |           |           |        |

# 面積（座標法）計算書

地番：22D-12

| 測点名    | [1]<br>X(i) | [2]<br>X(i+1)-X(i-1) | [3]<br>Y(i) | [4]<br>Y(i+1)-Y(i-1) | [2]*[3]       | [1]*[4]        | 方向角       | 夾角        | 距離     |
|--------|-------------|----------------------|-------------|----------------------|---------------|----------------|-----------|-----------|--------|
| D22-37 | 61876.911   | -8.943               | -6810.519   | -4.049               | 60906.471417  | -250539.612639 | 184-35-44 | 94-59-28  | 8.949  |
| D22-60 | 61867.991   | -8.925               | -6811.236   | -0.652               | 60790.281300  | -40337.930132  | 94-23-55  | 89-48-11  | 0.065  |
| D22-61 | 61867.986   | -0.280               | -6811.171   | 3.254                | 1907.127880   | 201318.426444  | 94-55-43  | 180-31-48 | 3.201  |
| D22-63 | 61867.711   | -0.280               | -6807.982   | 3.244                | 1906.234960   | 200698.854484  | 95-11-40  | 180-15-57 | 0.055  |
| D22-64 | 61867.706   | 9.223                | -6807.927   | 0.795                | -62789.510721 | 49184.826270   | 4-35-05   | 89-23-25  | 9.258  |
| D22-36 | 61876.934   | 9.205                | -6807.187   | -2.592               | -62660.156335 | -160385.012928 | 269-36-16 | 85-01-11  | 3.332  |
| 合計     |             |                      |             | 倍面積                  | 60.448501     | -60.448501     |           |           | 24.860 |
|        |             |                      |             | 面積                   | 30.2242505    | 30.2242505     |           |           |        |
|        |             |                      |             | 坪数                   | 9.14          | 9.14           |           |           |        |

# 面積（座標法）計算書

地番：22D-13

| 測点名    | [1]<br>X(i) | [2]<br>X(i+1)-X(i-1) | [3]<br>Y(i) | [4]<br>Y(i+1)-Y(i-1) | [2]*[3]       | [1]*[4]        | 方向角       | 夾角       | 距離     |
|--------|-------------|----------------------|-------------|----------------------|---------------|----------------|-----------|----------|--------|
| D22-36 | 61876.934   | -9.249               | -6807.187   | -4.603               | 62959.672563  | -284819.527202 | 184-35-05 | 94-53-46 | 9.258  |
| D22-64 | 61867.706   | -9.527               | -6807.927   | 3.106                | 64859.120529  | 192161.094836  | 94-26-43  | 89-51-38 | 3.858  |
| D22-66 | 61867.407   | 9.249                | -6804.081   | 4.603                | -62930.945169 | 284775.674421  | 4-31-59   | 90-05-16 | 9.578  |
| D22-34 | 61876.955   | 9.527                | -6803.324   | -3.106               | -64815.267748 | -192189.822230 | 269-41-19 | 85-09-20 | 3.863  |
| 合計     |             |                      |             | 倍面積                  | 72.580175     | -72.580175     |           |          | 26.557 |
|        |             |                      |             | 面積                   | 36.2900875    | 36.2900875     |           |          |        |
|        |             |                      |             | 坪数                   | 10.97         | 10.97          |           |          |        |

# 面積（座標法）計算書

地番：22D-15

| 測点名    | [1]<br>X(i) | [2]<br>X(i+1)-X(i-1) | [3]<br>Y(i) | [4]<br>Y(i+1)-Y(i-1) | [2]*[3]       | [1]*[4]        | 方向角       | 夾角        | 距離     |
|--------|-------------|----------------------|-------------|----------------------|---------------|----------------|-----------|-----------|--------|
| D22-34 | 61876.955   | -9.585               | -6803.324   | -7.163               | 65209.860540  | -443224.628665 | 184-31-59 | 94-51-50  | 9.578  |
| D22-66 | 61867.407   | -9.720               | -6804.081   | 1.476                | 66135.667320  | 91316.292732   | 94-24-17  | 89-52-18  | 2.240  |
| D22-67 | 61867.235   | -1.041               | -6801.848   | 13.383               | 7080.723768   | 827969.206005  | 94-27-23  | 180-03-06 | 11.184 |
| D22-33 | 61866.366   | 6.761                | -6790.698   | 8.936                | -45911.909178 | 552837.846576  | 343-49-08 | 69-21-45  | 7.945  |
| D22-7  | 61873.996   | 10.626               | -6792.912   | -6.220               | -72181.482912 | -384856.255120 | 306-47-31 | 142-58-23 | 5.002  |
| D22-8  | 61876.992   | 2.959                | -6796.918   | -10.412              | -20112.080362 | -644263.240704 | 269-40-09 | 142-52-38 | 6.406  |
| 合計     |             |                      |             | 倍面積                  | 220.779176    | -220.779176    |           |           | 42.355 |
|        |             |                      |             | 面積                   | 110.3895880   | 110.3895880    |           |           |        |
|        |             |                      |             | 坪数                   | 33.39         | 33.39          |           |           |        |

# 面積（座標法）計算書

地番：22D-16

| 測点名    | [1]<br>X(i) | [2]<br>X(i+1)-X(i-1) | [3]<br>Y(i) | [4]<br>Y(i+1)-Y(i-1) | [2]*[3]       | [1]*[4]        | 方向角       | 夾角        | 距離     |
|--------|-------------|----------------------|-------------|----------------------|---------------|----------------|-----------|-----------|--------|
| D22-67 | 61867.235   | -1.343               | -6801.848   | -11.336              | 9134.881864   | -701326.975960 | 184-48-23 | 90-21-00  | 2.220  |
| D22-69 | 61865.023   | -3.148               | -6802.034   | 11.813               | 21412.803032  | 730811.516699  | 94-27-37  | 89-39-14  | 12.035 |
| D22-31 | 61864.087   | 1.343                | -6790.035   | 11.336               | -9119.017005  | 701291.290232  | 343-46-46 | 69-19-09  | 2.373  |
| D22-33 | 61866.366   | 3.148                | -6790.698   | -11.813              | -21377.117304 | -730827.381558 | 274-27-23 | 110-40-37 | 11.184 |
| 合計     |             |                      |             | 倍面積                  | 51.550587     | -51.550587     |           |           | 27.812 |
|        |             |                      |             | 面積                   | 25.7752935    | 25.7752935     |           |           |        |
|        |             |                      |             | 坪数                   | 7.79          | 7.79           |           |           |        |

# 面積（座標法）計算書

地番：22D-18

| 測点名    | [1]<br>X(i) | [2]<br>X(i+1)-X(i-1) | [3]<br>Y(i) | [4]<br>Y(i+1)-Y(i-1) | [2]*[3]       | [1]*[4]        | 方向角       | 夾角        | 距離     |
|--------|-------------|----------------------|-------------|----------------------|---------------|----------------|-----------|-----------|--------|
| D22-69 | 61865.023   | -4.727               | -6802.034   | -12.475              | 32153.214718  | -771766.161925 | 184-48-17 | 90-20-40  | 5.683  |
| D22-70 | 61859.360   | -7.630               | -6802.510   | 13.945               | 51903.151300  | 862628.775200  | 97-46-02  | 92-57-45  | 14.555 |
| D22-30 | 61857.393   | 4.727                | -6788.089   | 12.475               | -32087.296703 | 771670.977675  | 343-47-26 | 66-01-24  | 6.971  |
| D22-31 | 61864.087   | 7.630                | -6790.035   | -13.945              | -51807.967050 | -862694.693215 | 274-27-37 | 110-40-11 | 12.035 |
| 合計     |             |                      |             | 倍面積                  | 161.102265    | -161.102265    |           |           | 39.244 |
|        |             |                      |             | 面積                   | 80.5511325    | 80.5511325     |           |           |        |
|        |             |                      |             | 坪数                   | 24.36         | 24.36          |           |           |        |

# 面積（座標法）計算書

地番： 22D-19

| 測点名    | [1]<br>X(i) | [2]<br>X(i+1)-X(i-1) | [3]<br>Y(i) | [4]<br>Y(i+1)-Y(i-1) | [2]*[3]       | [1]*[4]        | 方向角       | 夾角        | 距離     |
|--------|-------------|----------------------|-------------|----------------------|---------------|----------------|-----------|-----------|--------|
| D22-70 | 61859.360   | -0.759               | -6802.510   | -14.682              | 5163.105090   | -908219.123520 | 185-28-09 | 87-42-07  | 2.738  |
| D22-72 | 61856.634   | -4.841               | -6802.771   | 15.250               | 32932.214411  | 943313.668500  | 97-45-53  | 92-17-44  | 15.655 |
| D22-28 | 61854.519   | 0.759                | -6787.260   | 14.682               | -5151.530340  | 908148.047958  | 343-54-36 | 66-08-43  | 2.991  |
| D22-30 | 61857.393   | 4.841                | -6788.089   | -15.250              | -32861.138849 | -943325.243250 | 277-46-02 | 113-51-26 | 14.555 |
| 合計     |             |                      |             | 倍面積                  | 82.650312     | -82.650312     |           |           | 35.939 |
|        |             |                      |             | 面積                   | 41.3251560    | 41.3251560     |           |           |        |
|        |             |                      |             | 坪数                   | 12.50         | 12.50          |           |           |        |

# 面積（座標法）計算書

地番：22D-21

| 測点名    | [1]<br>X(i) | [2]<br>X(i+1)-X(i-1) | [3]<br>Y(i) | [4]<br>Y(i+1)-Y(i-1) | [2]*[3]       | [1]*[4]         | 方向角       | 夾角        | 距離     |
|--------|-------------|----------------------|-------------|----------------------|---------------|-----------------|-----------|-----------|--------|
| D22-72 | 61856.634   | -5.309               | -6802.771   | -16.219              | 36115.911239  | -1003252.746846 | 185-26-51 | 87-40-58  | 7.458  |
| D22-27 | 61849.210   | -7.943               | -6803.479   | 12.979               | 54040.033697  | 802740.896590   | 92-10-18  | 86-43-27  | 13.697 |
| D22-5  | 61848.691   | 3.414                | -6789.792   | 16.766               | -23180.349888 | 1036955.153306  | 38-03-22  | 125-53-04 | 4.995  |
| D22-6  | 61852.624   | 5.828                | -6786.713   | 2.532                | -39552.963364 | 156610.843968   | 343-53-56 | 125-50-34 | 1.972  |
| D22-28 | 61854.519   | 4.010                | -6787.260   | -16.058              | -27216.912600 | -993259.866102  | 277-45-53 | 113-51-57 | 15.655 |
| 合計     |             |                      |             | 倍面積                  | 205.719084    | -205.719084     |           |           | 43.777 |
|        |             |                      |             | 面積                   | 102.8595420   | 102.8595420     |           |           |        |
|        |             |                      |             | 坪数                   | 31.11         | 31.11           |           |           |        |

# 面積（座標法）計算書

地番：22D-22

| 測点名    | [1]<br>X(i) | [2]<br>X(i+1)-X(i-1) | [3]<br>Y(i) | [4]<br>Y(i+1)-Y(i-1) | [2]*[3]       | [1]*[4]        | 方向角       | 夾角        | 距離     |
|--------|-------------|----------------------|-------------|----------------------|---------------|----------------|-----------|-----------|--------|
| D22-67 | 61867.235   | 2.384                | -6801.848   | -2.047               | -16215.605632 | -126642.230045 | 274-24-17 | 89-35-54  | 2.240  |
| D22-66 | 61867.407   | 0.471                | -6804.081   | -6.079               | -3204.722151  | -376091.967153 | 274-26-43 | 180-02-26 | 3.858  |
| D22-64 | 61867.706   | 0.304                | -6807.927   | -3.901               | -2069.609808  | -241345.921106 | 275-11-40 | 180-44-57 | 0.055  |
| D22-63 | 61867.711   | -17.893              | -6807.982   | -1.541               | 121815.221926 | -95338.142651  | 184-44-46 | 89-33-06  | 17.960 |
| D22-73 | 61849.813   | -17.931              | -6809.468   | -1.087               | 122100.570708 | -67230.746731  | 94-43-41  | 89-58-55  | 0.400  |
| D22-74 | 61849.780   | -0.389               | -6809.069   | 0.369                | 2648.727841   | 22822.568820   | 184-49-01 | 270-05-20 | 0.357  |
| D22-26 | 61849.424   | -0.570               | -6809.099   | 5.590                | 3881.186430   | 345738.280160  | 92-10-50  | 87-21-49  | 5.624  |
| D22-27 | 61849.210   | 7.210                | -6803.479   | 6.328                | -49053.083590 | 391381.800880  | 5-26-51   | 93-16-01  | 7.458  |
| D22-72 | 61856.634   | 10.150               | -6802.771   | 0.969                | -69048.125650 | 59939.078346   | 5-28-09   | 180-01-18 | 2.738  |
| D22-70 | 61859.360   | 8.389                | -6802.510   | 0.737                | -57066.256390 | 45590.348320   | 4-48-17   | 179-20-08 | 5.683  |
| D22-69 | 61865.023   | 7.875                | -6802.034   | 0.662                | -53566.017750 | 40954.645226   | 4-48-23   | 180-00-06 | 2.220  |
| 合計     |             |                      |             | 倍面積                  | 222.285934    | -222.285934    |           |           | 48.593 |
|        |             |                      |             | 面積                   | 111.1429670   | 111.1429670    |           |           |        |
|        |             |                      |             | 坪数                   | 33.62         | 33.62          |           |           |        |

# 面積（座標法）計算書

地番：22D-23

| 測点名    | [1]<br>X(i) | [2]<br>X(i+1)-X(i-1) | [3]<br>Y(i) | [4]<br>Y(i+1)-Y(i-1) | [2]*[3]      | [1]*[4]       | 方向角       | 夾角       | 距離    |
|--------|-------------|----------------------|-------------|----------------------|--------------|---------------|-----------|----------|-------|
| D22-73 | 61849.813   | -0.341               | -6809.468   | -0.430               | 2322.028588  | -26595.419590 | 184-44-18 | 90-00-37 | 0.375 |
| D22-25 | 61849.439   | -0.389               | -6809.499   | 0.369                | 2648.895111  | 22822.442991  | 92-08-51  | 87-24-33 | 0.400 |
| D22-26 | 61849.424   | 0.341                | -6809.099   | 0.430                | -2321.902759 | 26595.252320  | 4-49-01   | 92-40-10 | 0.357 |
| D22-74 | 61849.780   | 0.389                | -6809.069   | -0.369               | -2648.727841 | -22822.568820 | 274-43-41 | 89-54-40 | 0.400 |
| 合計     |             |                      |             | 倍面積                  | 0.293099     | -0.293099     |           |          | 1.532 |
|        |             |                      |             | 面積                   | 0.1465495    | 0.1465495     |           |          |       |
|        |             |                      |             | 坪数                   | 0.04         | 0.04          |           |          |       |

# 面積（座標法）計算書

地番：22D-24

| 測点名    | [1]<br>X(i) | [2]<br>X(i+1)-X(i-1) | [3]<br>Y(i) | [4]<br>Y(i+1)-Y(i-1) | [2]*[3]        | [1]*[4]        | 方向角       | 夾角        | 距離     |
|--------|-------------|----------------------|-------------|----------------------|----------------|----------------|-----------|-----------|--------|
| D22-61 | 61867.986   | -18.150              | -6811.171   | -4.719               | 123622.753650  | -291955.025934 | 184-44-49 | 89-49-06  | 18.488 |
| D22-23 | 61849.561   | -18.547              | -6812.701   | 1.672                | 126355.165447  | 103412.465992  | 92-10-55  | 87-26-06  | 3.204  |
| D22-25 | 61849.439   | 0.252                | -6809.499   | 3.233                | -1715.993748   | 199959.236287  | 4-44-18   | 92-33-23  | 0.375  |
| D22-73 | 61849.813   | 18.272               | -6809.468   | 1.517                | -124422.599296 | 93826.166321   | 4-44-46   | 180-00-28 | 17.960 |
| D22-63 | 61867.711   | 18.173               | -6807.982   | -1.703               | -123721.456886 | -105360.711833 | 274-55-43 | 90-10-57  | 3.201  |
| 合計     |             |                      |             | 倍面積                  | 117.869167     | -117.869167    |           |           | 43.228 |
|        |             |                      |             | 面積                   | 58.9345835     | 58.9345835     |           |           |        |
|        |             |                      |             | 坪数                   | 17.82          | 17.82          |           |           |        |

# 面積（座標法）計算書

地番：22D-26

| 測点名    | [1]<br>X(i) | [2]<br>X(i+1)-X(i-1) | [3]<br>Y(i) | [4]<br>Y(i+1)-Y(i-1) | [2]*[3]        | [1]*[4]        | 方向角       | 夾角        | 距離     |
|--------|-------------|----------------------|-------------|----------------------|----------------|----------------|-----------|-----------|--------|
| D22-58 | 61868.450   | -18.199              | -6817.203   | -7.516               | 124066.277397  | -465003.270200 | 184-44-45 | 90-20-50  | 18.722 |
| D22-21 | 61849.792   | -18.889              | -6818.752   | 4.502                | 128799.406528  | 278447.763584  | 92-11-10  | 87-26-25  | 6.055  |
| D22-23 | 61849.561   | 18.194               | -6812.701   | 7.581                | -123950.281994 | 468881.521941  | 4-44-49   | 92-33-39  | 18.488 |
| D22-61 | 61867.986   | 18.430               | -6811.171   | 1.465                | -125529.881530 | 90636.599490   | 274-23-55 | 89-39-06  | 0.065  |
| D22-60 | 61867.991   | 0.464                | -6811.236   | -6.032               | -3160.413504   | -373187.721712 | 274-23-55 | 180-00-00 | 5.985  |
| 合計     |             |                      |             | 倍面積                  | 225.106897     | -225.106897    |           |           | 49.315 |
|        |             |                      |             | 面積                   | 112.5534485    | 112.5534485    |           |           |        |
|        |             |                      |             | 坪数                   | 34.04          | 34.04          |           |           |        |

# 面積（座標法）計算書

地番：22D-28

| 測点名    | [1]<br>X(i) | [2]<br>X(i+1)-X(i-1) | [3]<br>Y(i) | [4]<br>Y(i+1)-Y(i-1) | [2]*[3]        | [1]*[4]        | 方向角       | 夾角        | 距離     |
|--------|-------------|----------------------|-------------|----------------------|----------------|----------------|-----------|-----------|--------|
| D22-58 | 61868.450   | 18.863               | -6817.203   | -1.116               | -128592.900189 | -69045.190200  | 274-23-55 | 89-39-10  | 2.673  |
| D22-56 | 61868.655   | -0.661               | -6819.868   | -3.755               | 4507.932748    | -232316.799525 | 231-31-59 | 137-08-04 | 1.392  |
| D22-55 | 61867.789   | -3.262               | -6820.958   | -1.321               | 22249.964996   | -81727.349269  | 185-30-25 | 133-58-26 | 2.407  |
| D22-54 | 61865.393   | -2.397               | -6821.189   | -2.354               | 16350.390033   | -145631.135122 | 269-58-23 | 264-27-58 | 2.123  |
| D22-53 | 61865.392   | -15.407              | -6823.312   | -2.689               | 105126.767984  | -166356.039088 | 182-06-15 | 92-07-52  | 15.416 |
| D22-19 | 61849.986   | -15.600              | -6823.878   | 4.560                | 106452.496800  | 282035.936160  | 92-10-03  | 90-03-48  | 5.130  |
| D22-21 | 61849.792   | 18.464               | -6818.752   | 6.675                | -125901.436928 | 412847.361600  | 4-44-45   | 92-34-42  | 18.722 |
| 合計     |             |                      |             | 倍面積                  | 193.215444     | -193.215444    |           |           | 47.863 |
|        |             |                      |             | 面積                   | 96.6077220     | 96.6077220     |           |           |        |
|        |             |                      |             | 坪数                   | 29.22          | 29.22          |           |           |        |

# 面積（座標法）計算書

地番：22D-30

| 測点名    | [1]<br>X(i) | [2]<br>X(i+1)-X(i-1) | [3]<br>Y(i) | [4]<br>Y(i+1)-Y(i-1) | [2]*[3]        | [1]*[4]        | 方向角       | 夾角        | 距離     |
|--------|-------------|----------------------|-------------|----------------------|----------------|----------------|-----------|-----------|--------|
| D22-49 | 61865.356   | -15.187              | -6828.519   | -2.751               | 103704.718053  | -170191.594356 | 182-06-23 | 92-31-28  | 15.181 |
| D22-17 | 61850.185   | -15.370              | -6829.077   | 4.641                | 104962.913490  | 287046.708585  | 92-11-31  | 90-05-08  | 5.203  |
| D22-19 | 61849.986   | 15.207               | -6823.878   | 5.765                | -103770.712746 | 356565.169290  | 2-06-15   | 89-54-44  | 15.416 |
| D22-53 | 61865.392   | 15.404               | -6823.312   | 0.033                | -105106.298048 | 2041.557936    | 269-47-06 | 87-40-51  | 0.533  |
| D22-52 | 61865.390   | -0.020               | -6823.845   | -3.014               | 136.476900     | -186462.285460 | 269-35-04 | 179-47-58 | 2.481  |
| D22-51 | 61865.372   | -0.034               | -6826.326   | -4.674               | 232.095084     | -289158.748728 | 269-34-55 | 179-59-51 | 2.193  |
| 合計     |             |                      |             | 倍面積                  | 159.192733     | -159.192733    |           |           | 41.007 |
|        |             |                      |             | 面積                   | 79.5963665     | 79.5963665     |           |           |        |
|        |             |                      |             | 坪数                   | 24.07          | 24.07          |           |           |        |

# 面積（座標法）計算書

地番：22D-32

| 測点名    | [1]<br>X(i) | [2]<br>X(i+1)-X(i-1) | [3]<br>Y(i) | [4]<br>Y(i+1)-Y(i-1) | [2]*[3]        | [1]*[4]        | 方向角       | 夾角       | 距離     |
|--------|-------------|----------------------|-------------|----------------------|----------------|----------------|-----------|----------|--------|
| D22-48 | 61865.302   | -14.888              | -6835.893   | -7.928               | 101772.774984  | -490468.114256 | 182-08-20 | 92-33-30 | 14.844 |
| D22-16 | 61850.468   | -15.117              | -6836.447   | 6.816                | 103346.569299  | 421572.789888  | 92-11-56  | 90-03-36 | 7.375  |
| D22-17 | 61850.185   | 14.888               | -6829.077   | 7.928                | -101671.298376 | 490348.266680  | 2-06-23   | 89-54-27 | 15.181 |
| D22-49 | 61865.356   | 15.117               | -6828.519   | -6.816               | -103226.721723 | -421674.266496 | 269-34-50 | 87-28-27 | 7.374  |
| 合計     |             |                      |             | 倍面積                  | 221.324184     | -221.324184    |           |          | 44.774 |
|        |             |                      |             | 面積                   | 110.6620920    | 110.6620920    |           |          |        |
|        |             |                      |             | 坪数                   | 33.47          | 33.47          |           |          |        |