



出来形確認測量図（縮尺１：５００）

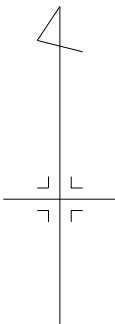

座 標 一 覧 表

測 点 名	X	座 標	Y	座 標
D23-1		61846.417	-6888.533	
D23-2		61842.808	-6891.977	
D23-3		61832.743	-6891.137	
D23-4		61828.662	-6888.295	
D23-5		61822.301	-6874.589	
D23-6		61820.826	-6871.415	
D23-7		61818.791	-6866.882	
D23-8		61816.784	-6862.334	
D23-9		61814.834	-6857.765	
D23-10		61812.910	-6853.184	
D23-11		61811.042	-6848.577	
D23-12		61809.200	-6843.957	
D23-13		61807.402	-6839.325	
D23-14		61805.645	-6834.670	
D23-15		61803.942	-6830.001	
D23-16		61802.268	-6825.303	
D23-17		61800.654	-6820.623	
D23-18		61799.075	-6815.911	
D23-19		61797.536	-6811.161	
D23-20		61796.045	-6806.423	
D23-21		61794.595	-6801.666	
D23-22		61793.177	-6796.902	
D23-23		61791.819	-6792.122	
D23-24		61790.491	-6787.336	
D23-25		61789.713	-6784.422	
D23-26		61792.928	-6780.590	
D23-27		61839.124	-6784.018	
D23-28		61842.611	-6787.608	
D23-29		61826.924	-6884.549	
D23-31		61813.719	-6855.113	
D23-32		61798.559	-6814.331	
D23-33		61824.188	-6782.910	
D23-34		61843.550	-6812.645	
D23-35		61845.086	-6853.939	
D23-38		61846.227	-6883.632	
D23-41		61825.329	-6813.325	
D23-42		61825.899	-6854.657	
D23-43		61825.386	-6840.892	
D23-44		61844.574	-6840.174	
D23-45		61824.874	-6827.127	
D23-46		61844.062	-6826.410	
D23-47		61824.362	-6813.361	
D23-48		61806.906	-6838.012	
D23-49		61825.253	-6837.320	
D23-50		61802.232	-6825.199	
D23-51		61824.771	-6824.356	

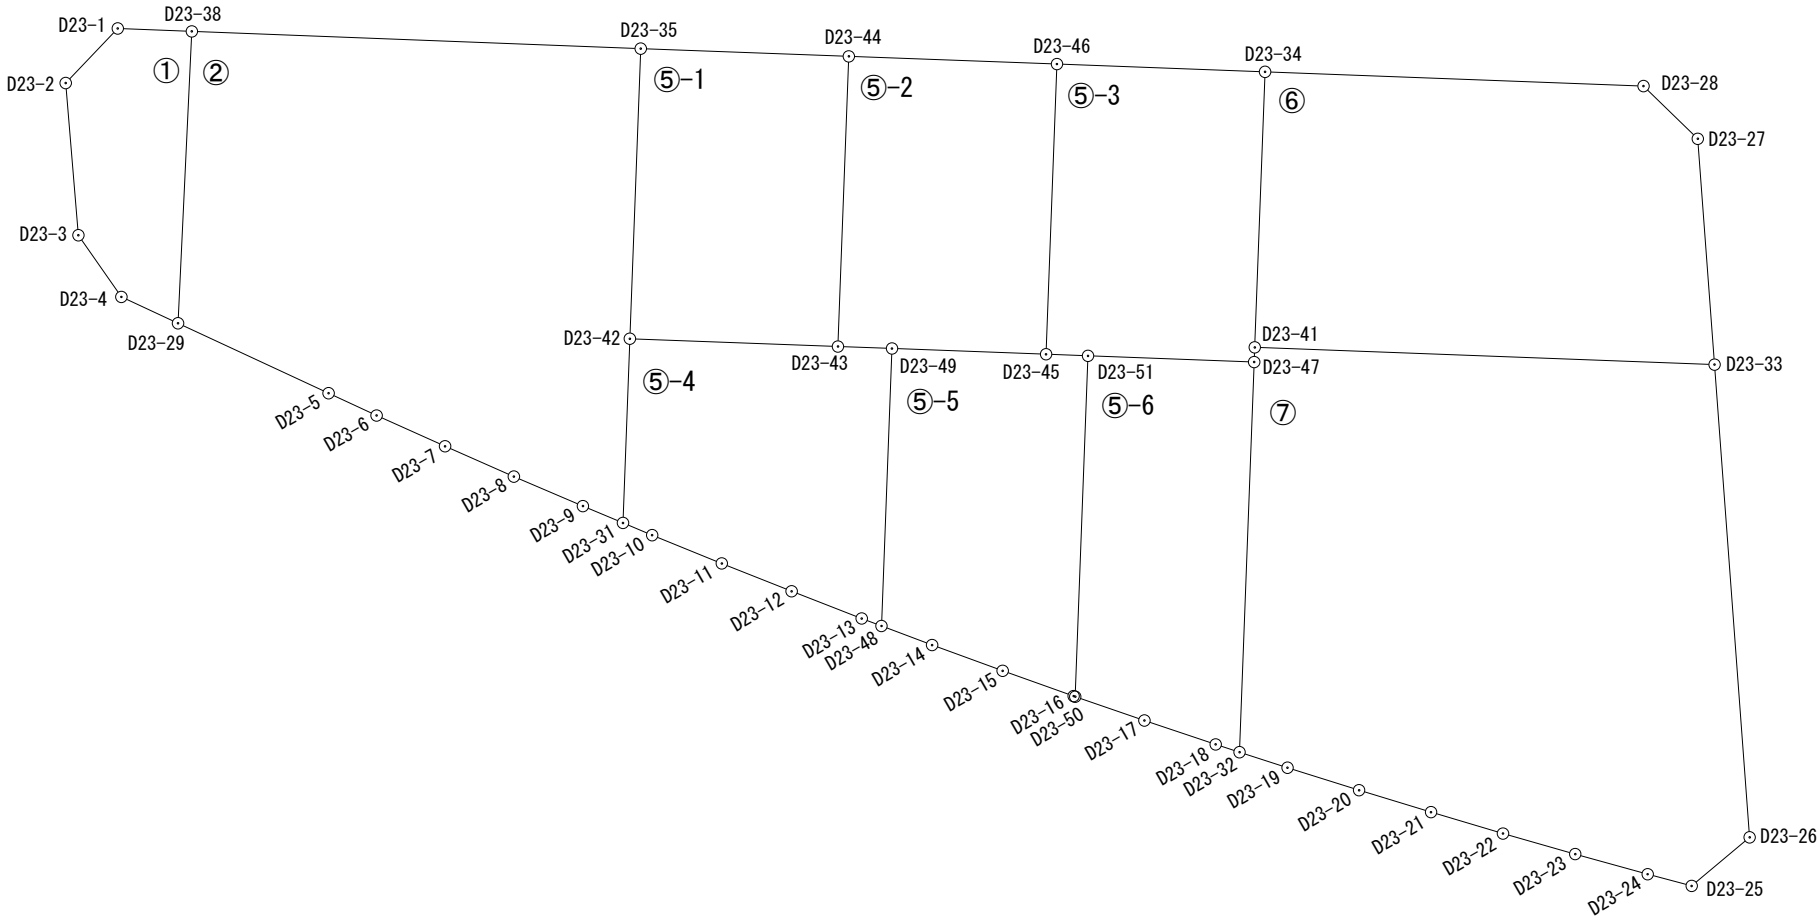

凡 例	
	施工地区界
	道 路
	街区番号
	画地番号
D14-1	計 算 点
D14-2	境界標あり

平成25年 5月23日測量
平成24年11月21日測量
平成24年 3月22日測量

面積（座標法）計算書

地 番： 23D-1

測点名	[1] X(i)	[2] X(i+1)-X(i-1)	[3] Y(i)	[4] Y(i+1)-Y(i-1)	[2]*[3]	[1]*[4]	方向角	夾 角	距 離
D23-1	61846.417	-3.419	-6888.533	-8.345	23551.894327	-516108.349865	223-39-35	131-26-23	4.989
D23-2	61842.808	-13.674	-6891.977	-2.604	94240.893498	-161038.672032	175-13-45	131-34-10	10.100
D23-3	61832.743	-14.146	-6891.137	3.682	97482.024002	227668.159726	145-08-48	149-55-03	4.973
D23-4	61828.662	-5.819	-6888.295	6.588	40082.988605	407327.225256	114-53-22	149-44-34	4.130
D23-29	61826.924	17.565	-6884.549	4.663	-120927.103185	288298.946612	2-43-11	67-49-49	19.325
D23-38	61846.227	19.493	-6883.632	-3.984	-134182.638576	-246395.368368	272-13-12	89-30-01	4.905
合計				倍面積	248.058671	-248.058671			48.422
				面 積	124.0293355	124.0293355			
				坪 数	37.51	37.51			

面積（座標法）計算書

地番：23D-2

測点名	[1] X(i)	[2] X(i+1)-X(i-1)	[3] Y(i)	[4] Y(i+1)-Y(i-1)	[2]*[3]	[1]*[4]	方向角	夾角	距離
D23-38	61846.227	-18.162	-6883.632	-30.610	125020.524384	-1893113.008470	182-43-11	90-31-09	19.325
D23-29	61826.924	-23.926	-6884.549	9.043	164719.719374	559100.873732	114-53-55	112-10-44	10.981
D23-5	61822.301	-6.098	-6874.589	13.134	41921.243722	811974.101334	114-55-30	180-01-35	3.500
D23-6	61820.826	-3.510	-6871.415	7.707	24118.666650	476453.105982	114-10-36	179-15-06	4.969
D23-7	61818.791	-4.042	-6866.882	9.081	27755.937044	561376.441071	113-48-41	179-38-05	4.971
D23-8	61816.784	-3.957	-6862.334	9.117	27154.255638	563583.619728	113-06-44	179-18-03	4.968
D23-9	61814.834	-3.065	-6857.765	7.221	21019.049725	446364.916314	112-48-13	179-41-29	2.877
D23-31	61813.719	11.065	-6855.113	3.108	-75851.825345	192117.038652	2-08-39	69-20-26	12.189
D23-42	61825.899	31.367	-6854.657	1.174	-215010.026119	72583.605426	2-08-35	179-59-56	19.200
D23-35	61845.086	20.328	-6853.939	-28.975	-139326.871992	-1791961.366850	272-12-02	90-03-27	29.715
合計				倍面積	1520.673081	-1520.673081			112.695
				面積	760.3365405	760.3365405			
				坪数	230.00	230.00			

面積（座標法）計算書

地番：23D-5-1

測点名	[1] X(i)	[2] X(i+1)-X(i-1)	[3] Y(i)	[4] Y(i+1)-Y(i-1)	[2]*[3]	[1]*[4]	方向角	夾角	距離
D23-35	61845.086	-18.675	-6853.939	-14.483	127997.310825	-895702.380538	182-08-35	90-00-46	19.200
D23-42	61825.899	-19.700	-6854.657	13.047	135036.742900	806642.504253	92-08-04	89-59-29	13.775
D23-43	61825.386	18.675	-6840.892	14.483	-127753.658100	895417.065438	2-08-35	90-00-31	19.201
D23-44	61844.574	19.700	-6840.174	-13.047	-134751.427800	-806886.156978	272-07-49	89-59-14	13.775
合計				倍面積	528.967825	-528.967825			65.951
				面積	264.4839125	264.4839125			
				坪数	80.00	80.00			

面積（座標法）計算書

地番：23D-5-2

測点名	[1] X(i)	[2] X(i+1)-X(i-1)	[3] Y(i)	[4] Y(i+1)-Y(i-1)	[2]*[3]	[1]*[4]	方向角	夾角	距離
D23-44	61844.574	-18.676	-6840.174	-14.482	127747.089624	-895633.120668	182-08-35	90-00-46	19.201
D23-43	61825.386	-19.321	-6840.892	2.854	132172.874332	176449.651644	92-07-57	89-59-22	3.574
D23-49	61825.253	-0.512	-6837.320	13.765	3500.707840	851024.607545	92-07-46	179-59-49	10.200
D23-45	61824.874	18.809	-6827.127	10.910	-128411.431743	674509.375340	2-08-24	90-00-38	19.201
D23-46	61844.062	19.700	-6826.410	-13.047	-134480.277000	-806879.476914	272-07-49	89-59-25	13.774
合計				倍面積	528.963053	-528.963053			65.950
				面積	264.4815265	264.4815265			
				坪数	80.00	80.00			

面積（座標法）計算書

地番：23D-5-3

測点名	[1] X(i)	[2] X(i+1)-X(i-1)	[3] Y(i)	[4] Y(i+1)-Y(i-1)	[2]*[3]	[1]*[4]	方向角	夾角	距離
D23-46	61844.062	-18.676	-6826.410	-14.482	127490.033160	-895625.705884	182-08-24	90-00-35	19.201
D23-45	61824.874	-19.291	-6827.127	2.054	131702.106957	126988.291196	92-07-43	89-59-19	2.773
D23-51	61824.771	-0.512	-6824.356	13.766	3494.070272	851079.797586	92-07-49	180-00-06	11.003
D23-47	61824.362	0.558	-6813.361	11.031	-3801.855438	681984.537222	2-07-55	90-00-06	0.968
D23-41	61825.329	19.188	-6813.325	0.716	-130734.080100	44266.935564	2-08-14	180-00-19	18.234
D23-34	61843.550	18.733	-6812.645	-13.085	-127621.278785	-809222.851750	272-07-49	89-59-35	13.775
合計				倍面積	528.996066	-528.996066			65.954
				面積	264.4980330	264.4980330			
				坪数	80.01	80.01			

面積（座標法）計算書

地番：23D-5-4

測点名	[1] X(i)	[2] X(i+1)-X(i-1)	[3] Y(i)	[4] Y(i+1)-Y(i-1)	[2]*[3]	[1]*[4]	方向角	夾角	距離
D23-42	61825.899	-11.667	-6854.657	-14.221	79973.283219	-879226.109679	182-08-39	90-00-35	12.189
D23-31	61813.719	-12.989	-6855.113	1.473	89041.062757	91051.608087	112-45-09	110-36-30	2.092
D23-10	61812.910	-2.677	-6853.184	6.536	18345.973568	404009.179760	112-04-16	179-19-07	4.971
D23-11	61811.042	-3.710	-6848.577	9.227	25408.220670	570330.484534	111-44-14	179-39-58	4.974
D23-12	61809.200	-3.640	-6843.957	9.252	24912.003480	571858.718400	111-12-53	179-28-39	4.969
D23-13	61807.402	-2.294	-6839.325	5.945	15689.411550	367445.004890	110-41-41	179-28-48	1.404
D23-48	61806.906	17.851	-6838.012	2.005	-122065.352212	123922.846530	2-09-36	71-27-55	18.360
D23-49	61825.253	18.480	-6837.320	-2.880	-126353.673600	-178056.728640	272-07-57	89-58-21	3.574
D23-43	61825.386	0.646	-6840.892	-17.337	-4419.216232	-1071866.717082	272-08-04	180-00-07	13.775
合計				倍面積	531.713200	-531.713200			66.308
				面積	265.8566000	265.8566000			
				坪数	80.42	80.42			

面積（座標法）計算書

地番：23D-5-5

測点名	[1] X(i)	[2] X(i+1)-X(i-1)	[3] Y(i)	[4] Y(i+1)-Y(i-1)	[2]*[3]	[1]*[4]	方向角	夾角	距離
D23-49	61825.253	-17.968	-6837.320	-10.885	122852.965760	-672967.878905	182-09-36	90-01-50	18.360
D23-48	61806.906	-19.608	-6838.012	2.650	134079.739296	163788.300900	110-40-21	108-30-45	3.572
D23-14	61805.645	-2.964	-6834.670	8.011	20257.961880	495125.022095	110-02-21	179-22-00	4.970
D23-15	61803.942	-3.377	-6830.001	9.367	23064.913377	578917.524714	109-36-44	179-34-23	4.987
D23-16	61802.268	-1.710	-6825.303	4.802	11671.268130	296774.490936	109-05-37	179-28-53	0.110
D23-50	61802.232	22.503	-6825.199	0.947	-153587.453097	58526.713704	2-08-31	73-02-54	22.555
D23-51	61824.771	22.642	-6824.356	-1.928	-154517.068552	-119198.158488	272-07-43	89-59-12	2.773
D23-45	61824.874	0.482	-6827.127	-12.964	-3290.675214	-801497.666536	272-07-46	180-00-03	10.200
合計				倍面積	531.651580	-531.651580			67.527
				面積	265.8257900	265.8257900			
				坪数	80.41	80.41			

面積（座標法）計算書

地番：23D-5-6

測点名	[1] X(i)	[2] X(i+1)-X(i-1)	[3] Y(i)	[4] Y(i+1)-Y(i-1)	[2]*[3]	[1]*[4]	方向角	夾角	距離
D23-51	61824.771	-22.130	-6824.356	-11.838	151022.998280	-731881.639098	182-08-31	90-00-42	22.555
D23-50	61802.232	-24.117	-6825.199	3.733	164603.324283	230707.732056	109-01-35	106-53-04	4.840
D23-17	61800.654	-3.157	-6820.623	9.288	21532.706811	574004.474352	108-31-34	179-29-59	4.970
D23-18	61799.075	-2.095	-6815.911	6.292	14279.333545	388839.779900	108-05-10	179-33-36	1.662
D23-32	61798.559	25.287	-6814.331	2.550	-172313.987997	157586.325450	2-09-10	74-04-00	25.821
D23-47	61824.362	26.212	-6813.361	-10.025	-178591.818532	-619789.229050	272-07-49	89-58-39	11.003
合計				倍面積	532.556390	-532.556390			70.851
				面積	266.2781950	266.2781950			
				坪数	80.54	80.54			

面積（座標法）計算書

地番：23D-6

測点名	[1] X(i)	[2] X(i+1)-X(i-1)	[3] Y(i)	[4] Y(i+1)-Y(i-1)	[2]*[3]	[1]*[4]	方向角	夾角	距離
D23-34	61843.550	-17.282	-6812.645	-25.717	117736.130890	-1590430.575350	182-08-14	89-59-22	18.234
D23-41	61825.329	-19.362	-6813.325	29.735	131919.598650	1838376.157815	92-08-54	90-00-40	30.436
D23-33	61824.188	13.795	-6782.910	29.307	-93570.243450	1811881.477716	355-45-27	83-36-33	14.977
D23-27	61839.124	18.423	-6784.018	-4.698	-124981.963614	-290520.204552	314-09-58	138-24-31	5.005
D23-28	61842.611	4.426	-6787.608	-28.627	-30041.953008	-1770368.425097	272-08-52	137-58-54	25.055
合計				倍面積	1061.569468	-1061.569468			93.707
				面積	530.7847340	530.7847340			
				坪数	160.56	160.56			

面積（座標法）計算書

地 番： 23D-7

測点名	[1] X(i)	[2] X(i+1)-X(i-1)	[3] Y(i)	[4] Y(i+1)-Y(i-1)	[2]*[3]	[1]*[4]	方向角	夾 角	距 離
D23-41	61825.329	0.174	-6813.325	-30.451	-1185.518550	-1882643.093379	182-07-55	89-59-01	0.968
D23-47	61824.362	-26.770	-6813.361	-1.006	182393.673970	-62195.308172	182-09-10	180-01-15	25.821
D23-32	61798.559	-26.826	-6814.331	2.200	182801.243406	135956.829800	107-53-08	105-43-58	3.331
D23-19	61797.536	-2.514	-6811.161	7.908	17123.258754	488694.914688	107-28-06	179-34-58	4.967
D23-20	61796.045	-2.941	-6806.423	9.495	20017.690043	586753.447275	106-57-07	179-29-01	4.973
D23-21	61794.595	-2.868	-6801.666	9.521	19507.178088	588346.338995	106-34-32	179-37-25	4.971
D23-22	61793.177	-2.776	-6796.902	9.544	18868.199952	589754.081288	105-51-36	179-17-04	4.969
D23-23	61791.819	-2.686	-6792.122	9.566	18243.639692	591100.540554	105-30-29	179-38-53	4.967
D23-24	61790.491	-2.106	-6787.336	7.700	14294.129616	475786.780700	104-56-55	179-26-26	3.016
D23-25	61789.713	2.437	-6784.422	6.746	-16533.636414	416833.403898	50-00-14	125-03-19	5.002
D23-26	61792.928	34.475	-6780.590	1.512	-233760.840250	93430.907136	355-45-20	125-45-06	31.346
D23-33	61824.188	32.401	-6782.910	-32.735	-219773.066910	-2023814.794180	272-08-54	96-23-34	30.436
合計				倍面積	1995.951397	-1995.951397			124.767
				面 積	997.9756985	997.9756985			
				坪 数	301.88	301.88			