
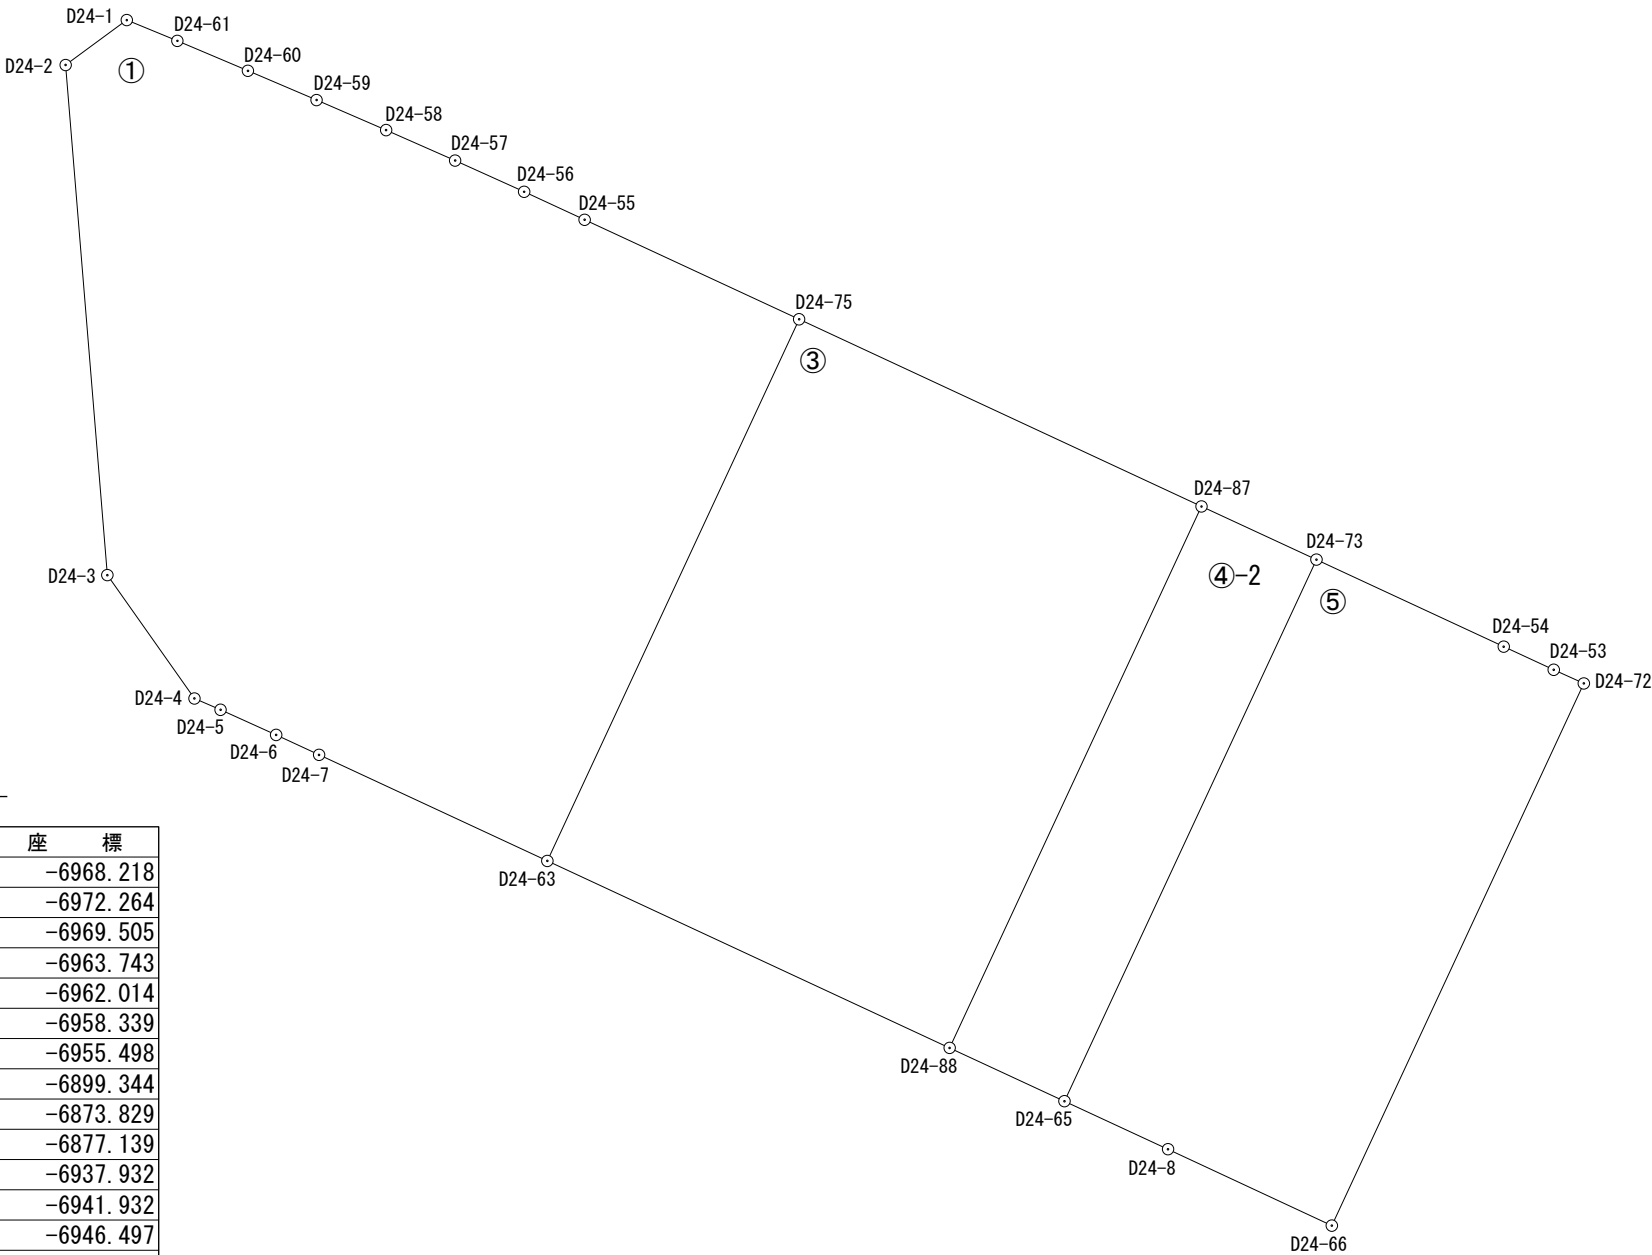


出来形確認測量図（縮尺１：５００）

2-1

2-2

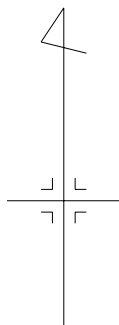


座 標 一 覧 表




測 点 名	X	座 標	Y	座 標
D24-1		61858.296		-6968.218
D24-2		61855.327		-6972.264
D24-3		61821.591		-6969.505
D24-4		61813.436		-6963.743
D24-5		61812.689		-6962.014
D24-6		61811.027		-6958.339
D24-7		61809.704		-6955.498
D24-8		61783.626		-6899.344
D24-53		61815.333		-6873.829
D24-54		61816.862		-6877.139
D24-55		61845.090		-6937.932
D24-56		61846.943		-6941.932
D24-57		61849.007		-6946.497
D24-58		61851.019		-6951.061
D24-59		61853.008		-6955.662
D24-60		61854.943		-6960.205
D24-61		61856.921		-6964.872
D24-63		61802.689		-6940.396
D24-65		61786.804		-6906.192
D24-66		61778.575		-6888.507
D24-72		61814.429		-6871.840
D24-73		61822.615		-6889.524
D24-75		61838.511		-6923.742
D24-87		61826.133		-6897.127
D24-88		61790.326		-6913.788

凡 例	
	施工地区界
	道 路
	街区番号
	画地番号
D14-1	計 算 点
D14-2	境界標あり

平成25年 2月 2日測量
平成24年 3月27日測量
平成24年 3月22日測量

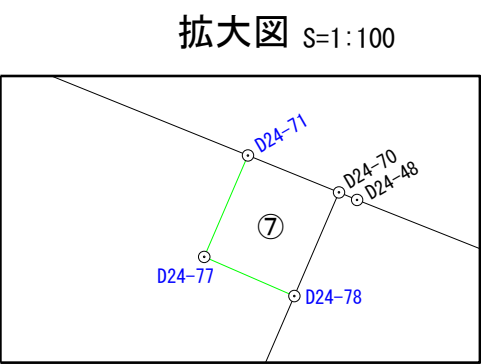

出来形確認測量図（縮尺1：500）

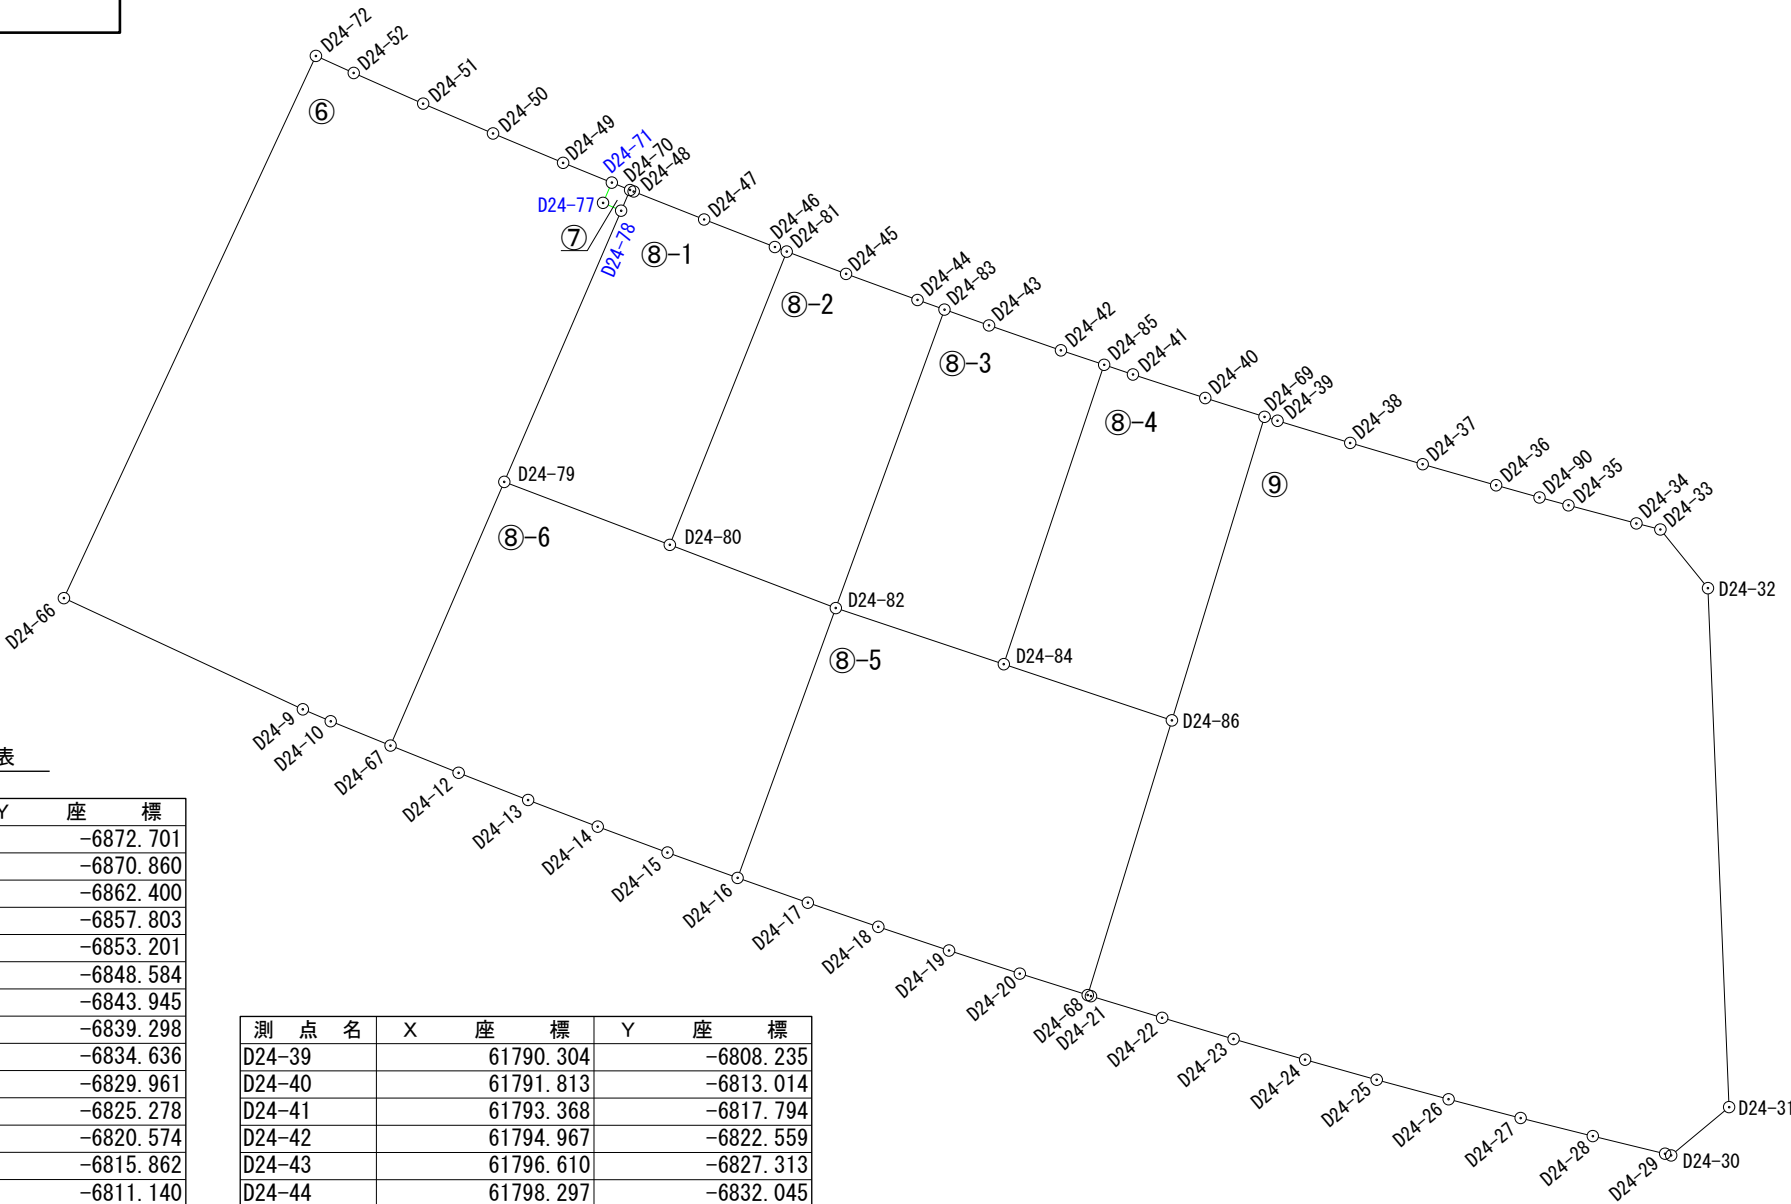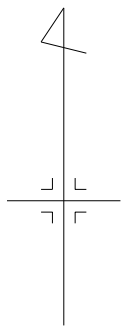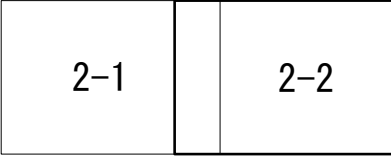

座 標 一 覧 表

測 点 名	X	座 標	Y	座 標
D24-9	61771.228		-6872.701	
D24-10	61770.438		-6870.860	
D24-12	61767.025		-6862.400	
D24-13	61765.224		-6857.803	
D24-14	61763.465		-6853.201	
D24-15	61761.753		-6848.584	
D24-16	61760.077		-6843.945	
D24-17	61758.438		-6839.298	
D24-18	61756.839		-6834.636	
D24-19	61755.275		-6829.961	
D24-20	61753.745		-6825.278	
D24-21	61752.258		-6820.574	
D24-22	61750.826		-6815.862	
D24-23	61749.420		-6811.140	
D24-24	61748.056		-6806.408	
D24-25	61746.728		-6801.667	
D24-26	61745.443		-6796.911	
D24-27	61744.196		-6792.149	
D24-28	61743.000		-6787.375	
D24-29	61741.836		-6782.593	
D24-30	61741.729		-6782.196	
D24-31	61744.918		-6778.359	
D24-32	61779.235		-6779.757	
D24-33	61783.118		-6782.905	
D24-34	61783.519		-6784.495	
D24-35	61784.715		-6788.985	
D24-36	61786.041		-6793.771	
D24-37	61787.430		-6798.627	
D24-38	61788.843		-6803.425	

測 点 名	X	座 標	Y	座 標
D24-39	61790.304		-6808.235	
D24-40	61791.813		-6813.014	
D24-41	61793.368		-6817.794	
D24-42	61794.967		-6822.559	
D24-43	61796.610		-6827.313	
D24-44	61798.297		-6832.045	
D24-45	61800.021		-6836.768	
D24-46	61801.795		-6841.478	
D24-47	61803.617		-6846.160	
D24-48	61805.468		-6850.821	
D24-49	61807.360		-6855.487	
D24-50	61809.306		-6860.122	
D24-51	61811.276		-6864.742	
D24-52	61813.305		-6869.337	
D24-66	61778.575		-6888.507	
D24-67	61768.825		-6866.906	
D24-68	61752.331		-6820.785	
D24-69	61790.566		-6809.087	
D24-70	61805.567		-6851.060	
D24-71	61806.055		-6852.265	
D24-72	61814.429		-6871.840	

測 点 名	X	座 標	Y	座 標
D24-77	61804.714		-6852.843	
D24-78	61804.196		-6851.651	
D24-79	61786.268		-6859.381	
D24-80	61782.099		-6848.427	
D24-81	61801.496		-6840.692	
D24-82	61777.920		-6837.446	
D24-83	61797.657		-6830.259	
D24-84	61774.210		-6826.340	
D24-85	61794.007		-6819.700	
D24-86	61770.494		-6815.219	
D24-90	61785.238		-6790.904	

凡 例	
	施工地区界
	道 路
	街区番号
	画地番号
D14-1	計 算 点
D14-2	境界標あり

平成25年 2月 2日測量
平成24年11月21日測量
平成24年 3月27日測量
平成24年 3月22日測量

面積（座標法）計算書

地番：24D-1

測点名	[1] X(i)	[2] X(i+1)-X(i-1)	[3] Y(i)	[4] Y(i+1)-Y(i-1)	[2]*[3]	[1]*[4]	方向角	夾角	距離
D24-1	61858.296	-1.594	-6968.218	-7.392	11107.339492	-457256.524032	233-43-42	121-23-19	5.018
D24-2	61855.327	-36.705	-6972.264	-1.287	255916.950120	-79607.805849	175-19-29	121-35-47	33.849
D24-3	61821.591	-41.891	-6969.505	8.521	291959.533955	526781.776911	144-45-23	149-25-54	9.985
D24-4	61813.436	-8.902	-6963.743	7.491	61991.240186	463044.449076	113-21-59	148-36-36	1.883
D24-5	61812.689	-2.409	-6962.014	5.404	16771.491726	334035.771356	114-20-05	180-58-06	4.033
D24-6	61811.027	-2.985	-6958.339	6.516	20770.641915	402760.651932	114-58-14	180-38-09	3.134
D24-7	61809.704	-8.338	-6955.498	17.943	57994.942324	1109051.518872	114-54-55	179-56-41	16.652
D24-63	61802.689	28.807	-6940.396	31.756	-199931.987572	1962606.191884	24-56-03	90-01-08	39.504
D24-75	61838.511	42.401	-6923.742	2.464	-293573.584542	152370.091104	294-52-27	89-56-24	15.641
D24-55	61845.090	8.432	-6937.932	-18.190	-58500.642624	-1124962.187100	294-51-21	179-58-54	4.408
D24-56	61846.943	3.917	-6941.932	-8.565	-27191.547644	-529719.066795	294-19-46	179-28-25	5.010
D24-57	61849.007	4.076	-6946.497	-9.129	-28313.921772	-564619.584903	293-47-24	179-27-38	4.988
D24-58	61851.019	4.001	-6951.061	-9.165	-27811.195061	-566864.589135	293-22-43	179-35-19	5.013
D24-59	61853.008	3.924	-6955.662	-9.144	-27294.017688	-565583.905152	293-04-14	179-41-31	4.938
D24-60	61854.943	3.913	-6960.205	-9.210	-27235.282165	-569684.025030	292-58-07	179-53-53	5.069
D24-61	61856.921	3.353	-6964.872	-8.013	-23353.215816	-495659.507973	292-20-23	179-22-16	3.618
合計				倍面積	3306.744834	-3306.744834			162.743
				面積	1653.3724170	1653.3724170			
				坪数	500.14	500.14			

面積（座標法）計算書

地番：24D-3

測点名	[1] X(i)	[2] X(i+1)-X(i-1)	[3] Y(i)	[4] Y(i+1)-Y(i-1)	[2]*[3]	[1]*[4]	方向角	夾角	距離
D24-75	61838.511	-23.444	-6923.742	-43.269	162320.207448	-2675690.532459	204-56-03	89-59-32	39.504
D24-63	61802.689	-48.185	-6940.396	9.954	334422.981260	615183.966306	114-55-16	89-59-13	29.340
D24-88	61790.326	23.444	-6913.788	43.269	-162086.845872	2673605.615694	24-57-09	90-01-53	39.493
D24-87	61826.133	48.185	-6897.127	-9.954	-332338.064495	-615417.327882	294-56-31	89-59-22	29.353
合計				倍面積	2318.278341	-2318.278341			137.690
				面積	1159.1391705	1159.1391705			
				坪数	350.63	350.63			

面積（座標法）計算書

地番：24D-4-2

測点名	[1] X(i)	[2] X(i+1)-X(i-1)	[3] Y(i)	[4] Y(i+1)-Y(i-1)	[2]*[3]	[1]*[4]	方向角	夾角	距離
D24-87	61826.133	-32.289	-6897.127	-24.264	222701.333703	-1500149.291112	204-57-09	90-07-19	39.493
D24-88	61790.326	-39.329	-6913.788	-9.065	271912.368252	-560129.305190	114-52-32	89-55-23	8.373
D24-65	61786.804	32.289	-6906.192	24.264	-222994.033488	1499195.012256	24-57-34	90-05-02	39.500
D24-73	61822.615	39.329	-6889.524	9.065	-270958.089396	560422.004975	294-49-50	89-52-16	8.377
合計				倍面積	661.579071	-661.579071			95.743
				面積	330.7895355	330.7895355			
				坪数	100.06	100.06			

面積（座標法）計算書

地番：24D-5

測点名	[1] X(i)	[2] X(i+1)-X(i-1)	[3] Y(i)	[4] Y(i+1)-Y(i-1)	[2]*[3]	[1]*[4]	方向角	夾角	距離
D24-73	61822.615	-30.058	-6889.524	-29.053	207085.312392	-1796132.433595	204-57-34	90-02-38	39.500
D24-65	61786.804	-38.989	-6906.192	-9.820	269265.519888	-606746.415280	114-53-42	89-56-08	7.549
D24-8	61783.626	-8.229	-6899.344	17.685	56774.701776	1092643.425810	114-59-23	180-05-41	11.956
D24-66	61778.575	30.803	-6888.507	27.504	-212186.681121	1699157.926800	24-55-54	89-56-31	39.539
D24-72	61814.429	36.758	-6871.840	14.678	-252595.094720	907312.188862	294-26-30	89-30-36	2.185
D24-53	61815.333	2.433	-6873.829	-5.299	-16724.025957	-327559.449567	294-47-38	180-21-08	3.646
D24-54	61816.862	7.282	-6877.139	-15.695	-50079.326198	-970215.649090	294-54-56	180-07-18	13.656
合計				倍面積	1540.406060	-1540.406060			118.031
				面積	770.2030300	770.2030300			
				坪数	232.98	232.98			

面積（座標法）計算書

地 番： 24D-6

測点名	[1] X(i)	[2] X(i+1)-X(i-1)	[3] Y(i)	[4] Y(i+1)-Y(i-1)	[2]*[3]	[1]*[4]	方向角	夾 角	距 離
D24-72	61814.429	-34.730	-6871.840	-19.170	238659.003200	-1184982.603930	204-55-54	90-44-55	39.539
D24-66	61778.575	-43.201	-6888.507	-0.861	297590.390907	-53191.353075	114-55-48	89-59-54	17.430
D24-9	61771.228	-8.137	-6872.701	17.647	55923.168037	1090076.860516	113-13-30	178-17-42	2.003
D24-10	61770.438	-2.403	-6870.860	5.795	16510.676580	357959.688210	112-11-33	178-58-03	4.270
D24-67	61768.825	15.830	-6866.906	11.479	-108703.121980	709044.342175	23-20-08	91-08-35	18.997
D24-79	61786.268	35.371	-6859.381	15.255	-242623.165351	942549.518340	23-19-27	179-59-19	19.523
D24-78	61804.196	18.446	-6851.651	6.538	-126385.554346	404075.833448	293-29-17	90-09-50	1.300
D24-77	61804.714	1.859	-6852.843	-0.614	-12739.435137	-37948.094396	23-19-02	269-49-45	1.460
D24-71	61806.055	2.646	-6852.265	-2.644	-18131.093190	-163415.209420	292-02-58	88-43-56	3.476
D24-49	61807.360	3.251	-6855.487	-7.857	-22287.188237	-485620.427520	292-46-30	180-43-32	5.027
D24-50	61809.306	3.916	-6860.122	-9.255	-26864.237752	-572045.127030	293-05-37	180-19-07	5.022
D24-51	61811.276	3.999	-6864.742	-9.215	-27452.103258	-569590.908340	293-49-29	180-43-52	5.023
D24-52	61813.305	3.153	-6869.337	-7.098	-21659.019561	-438750.838890	294-10-59	180-21-30	2.744
合計				倍面積	1838.319912	-1838.319912			125.814
				面 積	919.1599560	919.1599560			
				坪 数	278.04	278.04			

面積（座標法）計算書

地番：24D-7

測点名	[1] X(i)	[2] X(i+1)-X(i-1)	[3] Y(i)	[4] Y(i+1)-Y(i-1)	[2]*[3]	[1]*[4]	方向角	夾角	距離
D24-71	61806.055	-0.853	-6852.265	-1.783	5844.982045	-110200.196065	203-19-02	91-16-13	1.460
D24-77	61804.714	-1.859	-6852.843	0.614	12739.435137	37948.094396	113-29-17	90-10-15	1.300
D24-78	61804.196	0.853	-6851.651	1.783	-5844.458303	110196.881468	23-19-10	89-49-53	1.493
D24-70	61805.567	1.859	-6851.060	-0.614	-12736.120540	-37948.618138	292-02-49	88-43-39	1.300
合計				倍面積	3.838339	-3.838339			5.553
				面積	1.9191695	1.9191695			
				坪数	0.58	0.58			

面積（座標法）計算書

地番：24D-8-1

測点名	[1] X(i)	[2] X(i+1)-X(i-1)	[3] Y(i)	[4] Y(i+1)-Y(i-1)	[2]*[3]	[1]*[4]	方向角	夾角	距離
D24-70	61805.567	-1.272	-6851.060	-0.830	8714.548320	-51298.620610	203-19-10	90-49-08	1.493
D24-78	61804.196	-19.299	-6851.651	-8.321	132230.012649	-514272.714916	203-19-27	180-00-17	19.523
D24-79	61786.268	-22.097	-6859.381	3.224	151571.741957	199198.928032	110-50-11	87-30-44	11.721
D24-80	61782.099	15.228	-6848.427	18.689	-104287.846356	1154645.648211	21-44-27	90-54-16	20.882
D24-81	61801.496	19.696	-6840.692	6.949	-134734.269632	429458.595704	290-49-38	89-05-11	0.841
D24-46	61801.795	2.121	-6841.478	-5.468	-14510.774838	-337932.215060	291-15-49	180-26-11	5.024
D24-47	61803.617	3.673	-6846.160	-9.343	-25145.945680	-577431.193631	291-39-33	180-23-44	5.015
D24-48	61805.468	1.950	-6850.821	-4.900	-13359.100950	-302846.793200	292-30-02	180-50-29	0.259
合計				倍面積	478.365470	-478.365470			64.758
				面積	239.1827350	239.1827350			
				坪数	72.35	72.35			

面積（座標法）計算書

地 番： 24D-8-2

測点名	[1] X(i)	[2] X(i+1)-X(i-1)	[3] Y(i)	[4] Y(i+1)-Y(i-1)	[2]*[3]	[1]*[4]	方向角	夾 角	距 離
D24-81	61801.496	-17.922	-6840.692	-11.659	122598.882024	-720543.641864	201-44-27	91-08-24	20.882
D24-80	61782.099	-23.576	-6848.427	3.246	161458.514952	200544.693354	110-50-07	89-05-40	11.749
D24-82	61777.920	15.558	-6837.446	18.168	-106376.984868	1122381.250560	20-00-31	89-10-24	21.005
D24-83	61797.657	20.377	-6830.259	5.401	-139180.187643	333769.145457	289-42-53	89-42-22	1.897
D24-44	61798.297	2.364	-6832.045	-6.509	-16150.954380	-402245.115173	290-03-12	180-20-19	5.028
D24-45	61800.021	3.199	-6836.768	-8.647	-21870.820832	-534384.781587	290-36-03	180-32-51	4.192
合計				倍面積	478.449253	-478.449253			64.753
				面 積	239.2246265	239.2246265			
				坪 数	72.36	72.36			

面積（座標法）計算書

地番：24D-8-3

測点名	[1] X(i)	[2] X(i+1)-X(i-1)	[3] Y(i)	[4] Y(i+1)-Y(i-1)	[2]*[3]	[1]*[4]	方向角	夾角	距離
D24-83	61797.657	-18.690	-6830.259	-10.133	127657.540710	-626195.658381	200-00-31	90-26-37	21.005
D24-82	61777.920	-23.447	-6837.446	3.919	160317.596362	242107.668480	108-28-20	88-27-49	11.709
D24-84	61774.210	16.087	-6826.340	17.746	-109815.331580	1096245.130660	18-32-30	90-04-10	20.881
D24-85	61794.007	20.757	-6819.700	3.781	-141556.512900	233643.140467	288-33-40	90-01-10	3.016
D24-42	61794.967	2.603	-6822.559	-7.613	-17759.121077	-470445.083771	289-03-55	180-30-15	5.030
D24-43	61796.610	2.690	-6827.313	-7.700	-18365.471970	-475833.897000	289-33-54	180-29-59	3.127
合計				倍面積	478.699545	-478.699545			64.768
				面積	239.3497725	239.3497725			
				坪数	72.40	72.40			

面積（座標法）計算書

地番：24D-8-4

測点名	[1] X(i)	[2] X(i+1)-X(i-1)	[3] Y(i)	[4] Y(i+1)-Y(i-1)	[2]*[3]	[1]*[4]	方向角	夾角	距離
D24-85	61794.007	-19.158	-6819.700	-8.546	130651.812600	-528091.583822	198-32-30	90-00-27	20.881
D24-84	61774.210	-23.513	-6826.340	4.481	160507.732420	276810.235010	108-28-36	89-56-06	11.725
D24-86	61770.494	16.356	-6815.219	17.253	-111469.721964	1065726.332982	16-59-17	88-30-41	20.988
D24-69	61790.566	21.319	-6809.087	2.205	-145162.925753	136248.198030	287-37-01	90-37-44	4.120
D24-40	61791.813	2.802	-6813.014	-8.707	-19090.065228	-538021.315791	288-01-14	180-24-13	5.027
D24-41	61793.368	2.194	-6817.794	-6.686	-14958.240036	-413150.458448	288-32-03	180-30-49	2.010
合計				倍面積	478.592039	-478.592039			64.751
				面積	239.2960195	239.2960195			
				坪数	72.38	72.38			

面積（座標法）計算書

地番：24D-8-5

測点名	[1] X(i)	[2] X(i+1)-X(i-1)	[3] Y(i)	[4] Y(i+1)-Y(i-1)	[2]*[3]	[1]*[4]	方向角	夾角	距離
D24-82	61777.920	-14.133	-6837.446	-17.605	96633.624318	-1087600.281600	200-00-48	91-32-28	18.990
D24-16	61760.077	-19.482	-6843.945	-1.852	133333.736490	-114379.662604	109-25-40	89-24-52	4.928
D24-17	61758.438	-3.238	-6839.298	9.309	22145.646924	574909.299342	108-55-52	179-30-12	4.929
D24-18	61756.839	-3.163	-6834.636	9.337	21617.953668	576623.605743	108-29-51	179-33-59	4.930
D24-19	61755.275	-3.094	-6829.961	9.358	21131.899334	577905.863450	108-05-35	179-35-44	4.927
D24-20	61753.745	-2.944	-6825.278	9.176	20093.618432	566652.364120	107-28-10	179-22-35	4.710
D24-68	61752.331	16.749	-6820.785	10.059	-114241.327965	621166.697529	17-02-15	89-34-05	18.997
D24-86	61770.494	21.879	-6815.219	-5.555	-149110.176501	-343135.094170	288-28-36	91-26-21	11.725
D24-84	61774.210	7.426	-6826.340	-22.227	-50692.400840	-1373055.365670	288-28-20	179-59-44	11.709
合計				倍面積	912.573860	-912.573860			85.845
				面積	456.2869300	456.2869300			
				坪数	138.02	138.02			

面積（座標法）計算書

地番：24D-8-6

測点名	[1] X(i)	[2] X(i+1)-X(i-1)	[3] Y(i)	[4] Y(i+1)-Y(i-1)	[2]*[3]	[1]*[4]	方向角	夾角	距離
D24-79	61786.268	-13.274	-6859.381	-18.479	91051.423394	-1141748.446372	203-20-08	92-29-57	18.997
D24-67	61768.825	-19.243	-6866.906	-3.019	132139.872158	-186480.082675	111-46-30	88-26-22	4.852
D24-12	61767.025	-3.601	-6862.400	9.103	24711.502400	562265.228575	111-23-39	179-37-09	4.937
D24-13	61765.224	-3.560	-6857.803	9.199	24413.778680	568178.295576	110-55-05	179-31-26	4.927
D24-14	61763.465	-3.471	-6853.201	9.219	23787.460671	569397.383835	110-20-42	179-25-37	4.924
D24-15	61761.753	-3.388	-6848.584	9.256	23203.002592	571666.785768	109-51-50	179-31-08	4.932
D24-16	61760.077	16.167	-6843.945	11.138	-110646.058815	687883.737626	20-00-48	90-08-58	18.990
D24-82	61777.920	22.022	-6837.446	-4.482	-150574.235812	-276888.637440	290-50-07	90-49-19	11.749
D24-80	61782.099	8.348	-6848.427	-21.935	-57170.668596	-1355190.341565	290-50-11	180-00-04	11.721
合計				倍面積	916.076672	-916.076672			86.029
				面積	458.0383360	458.0383360			
				坪数	138.55	138.55			

面積（座標法）計算書

地 番： 24D-9

測点名	[1] X(i)	[2] X(i+1)-X(i-1)	[3] Y(i)	[4] Y(i+1)-Y(i-1)	[2]*[3]	[1]*[4]	方向角	夾 角	距 離
D24-69	61790.566	-19.810	-6809.087	-6.984	134888.013470	-431545.312944	196-59-17	89-53-41	20.988
D24-86	61770.494	-38.235	-6815.219	-11.698	260579.898465	-722591.238812	197-02-15	180-02-58	18.997
D24-68	61752.331	-18.236	-6820.785	-5.355	124383.835260	-330683.732505	109-05-03	92-02-48	0.223
D24-21	61752.258	-1.505	-6820.574	4.923	10264.963870	304006.366134	106-54-15	177-49-12	4.925
D24-22	61750.826	-2.838	-6815.862	9.434	19343.416356	582557.292484	106-34-52	179-40-37	4.927
D24-23	61749.420	-2.770	-6811.140	9.454	18866.857800	583779.016680	106-04-47	179-29-55	4.925
D24-24	61748.056	-2.692	-6806.408	9.473	18322.850336	584939.334488	105-38-53	179-34-06	4.923
D24-25	61746.728	-2.613	-6801.667	9.497	17772.755871	586408.675816	105-07-10	179-28-17	4.927
D24-26	61745.443	-2.532	-6796.911	9.518	17209.778652	587693.126474	104-40-27	179-33-17	4.923
D24-27	61744.196	-2.443	-6792.149	9.536	16593.220007	588792.653056	104-03-52	179-23-25	4.922
D24-28	61743.000	-2.360	-6787.375	9.556	16018.205000	590016.108000	103-40-50	179-36-58	4.922
D24-29	61741.836	-1.271	-6782.593	5.179	8620.675703	319760.968644	105-05-02	181-24-12	0.411
D24-30	61741.729	3.082	-6782.196	4.234	-20902.728072	261414.480586	50-16-10	125-11-08	4.989
D24-31	61744.918	37.506	-6778.359	2.439	-254229.132654	150595.855002	357-40-02	127-23-52	34.345
D24-32	61779.235	38.200	-6779.757	-4.546	-258986.717400	-280848.402310	320-58-04	143-18-02	4.999
D24-33	61783.118	4.284	-6782.905	-4.738	-29057.965020	-292728.413084	284-09-18	143-11-14	1.640
D24-34	61783.519	1.597	-6784.495	-6.080	-10834.838515	-375643.795520	284-54-56	180-45-38	4.647
D24-35	61784.715	1.719	-6788.985	-6.409	-11670.265215	-395978.238435	285-14-42	180-19-46	1.989
D24-90	61785.238	1.326	-6790.904	-4.786	-9004.738704	-295704.149068	285-38-48	180-24-06	2.977
D24-36	61786.041	2.192	-6793.771	-7.723	-14891.946032	-477173.594643	285-57-45	180-18-57	5.051
D24-37	61787.430	2.802	-6798.627	-9.654	-19049.752854	-596495.849220	286-24-34	180-26-49	5.002
D24-38	61788.843	2.874	-6803.425	-9.608	-19553.043450	-593667.203544	286-53-45	180-29-11	5.027
D24-39	61790.304	1.723	-6808.235	-5.662	-11730.588905	-349856.701248	287-05-36	180-11-51	0.891
合計				倍面積	2952.753969	-2952.753969			151.570
				面 積	1476.3769845	1476.3769845			
				坪 数	446.60	446.60			