



出来形確認測量図（縮尺1：500）

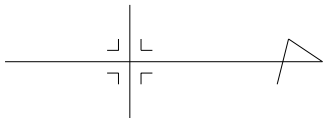

座 標 一 覧 表

測 点 名	X 座 標	Y 座 標
D25-1	61950.734	-6804.937
D25-2	61946.601	-6807.754
D25-3	61851.256	-6780.054
D25-4	61848.176	-6776.115
D25-5	61847.492	-6758.213
D25-6	61851.176	-6754.838
D25-7	61920.922	-6763.487
D25-9	61934.750	-6734.847
D25-10	61953.613	-6741.592
D25-11	61956.304	-6745.828
D25-12	61956.202	-6746.781
D25-13	61930.096	-6737.430
D25-15	61935.264	-6804.453
D25-16	61924.856	-6801.432
D25-17	61921.554	-6800.474
D25-18	61906.494	-6796.096
D25-19	61902.511	-6794.938
D25-20	61891.165	-6791.640
D25-21	61888.285	-6790.803
D25-22	61884.546	-6789.718
D25-23	61864.006	-6783.756
D25-24	61847.896	-6768.747
D25-25	61860.863	-6756.038
D25-26	61863.393	-6756.352
D25-27	61874.249	-6757.700
D25-28	61876.714	-6758.006
D25-29	61888.775	-6759.503
D25-30	61891.513	-6759.842
D25-31	61900.965	-6761.014
D25-32	61903.124	-6761.281
D25-33	61915.200	-6762.778
D25-34	61917.942	-6763.118
D25-35	61919.931	-6763.364
D25-36	61921.730	-6761.181
D25-37	61923.312	-6756.666
D25-38	61923.693	-6755.580
D25-40	61941.383	-6741.456
D25-41	61955.170	-6757.716
D25-42	61954.780	-6761.848
D25-43	61952.330	-6787.948
D25-44	61951.633	-6795.363
D25-45	61937.412	-6792.753
D25-47	61938.752	-6785.456
D25-48	61932.596	-6784.328
D25-49	61928.154	-6783.512
D25-50	61924.791	-6782.894
D25-51	61914.642	-6781.029
D25-52	61911.930	-6780.529
D25-53	61909.432	-6780.069
D25-54	61905.373	-6779.320
D25-55	61899.984	-6778.326
D25-56	61897.849	-6777.935
D25-57	61893.812	-6777.194
D25-58	61890.879	-6776.656
D25-59	61888.510	-6776.221
D25-60	61887.069	-6775.955
D25-61	61885.803	-6775.722
D25-62	61873.853	-6773.517

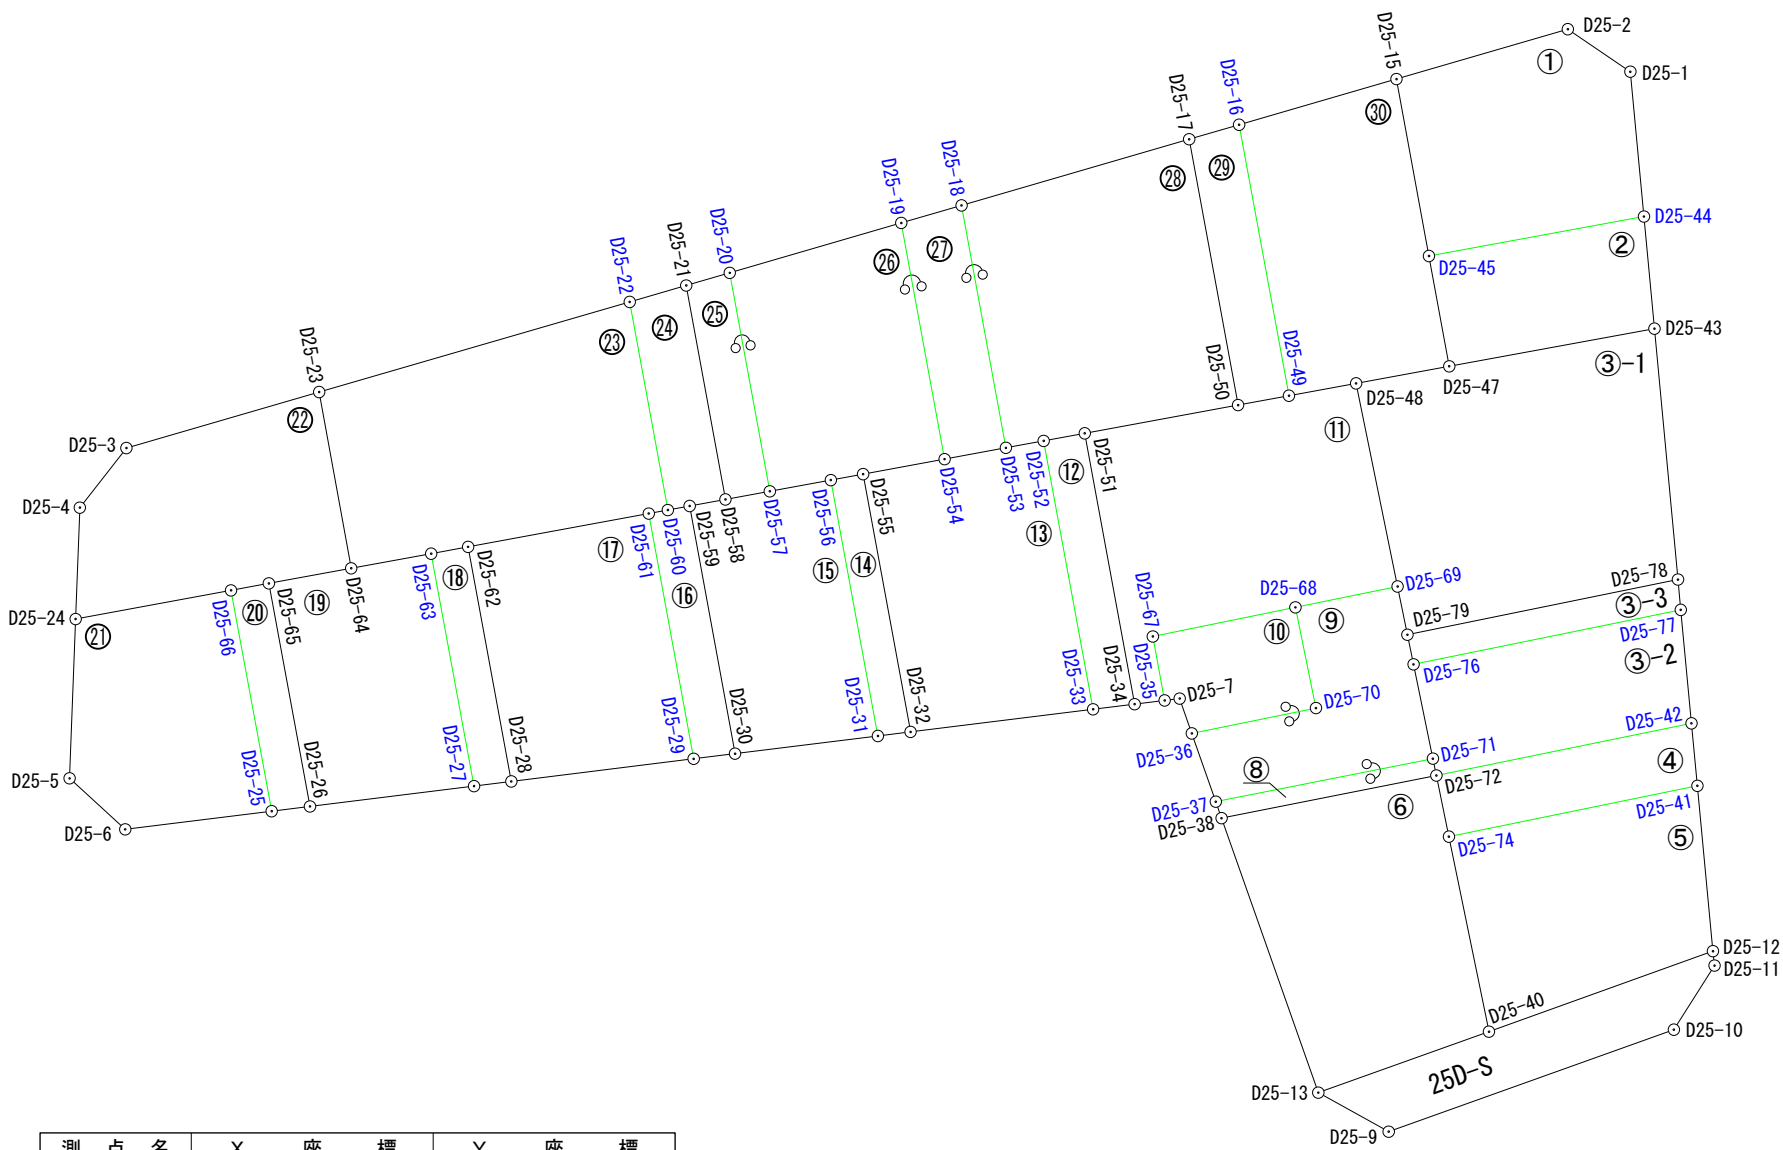

測 点 名	X 座 標	Y 座 標
D25-63	61871.413	-6773.070
D25-64	61866.127	-6772.101
D25-65	61860.676	-6771.102
D25-66	61858.173	-6770.641
D25-67	61919.151	-6767.595
D25-68	61928.579	-6769.519
D25-69	61935.339	-6770.898
D25-70	61929.939	-6762.856
D25-71	61937.675	-6759.513
D25-72	61937.904	-6758.398
D25-74	61938.734	-6754.356
D25-76	61936.394	-6765.748
D25-77	61954.072	-6769.354
D25-78	61953.883	-6771.357
D25-79	61935.991	-6767.707

凡 例	
	施工地区界
	道 路
	街区番号
	画地番号
D14-1	計 算 点
D14-2	境界標あり

平成24年 7月11日測量
平成24年 4月24日測量
平成24年 4月 4日測量

面積（座標法）計算書

地番： 25D-1

測点名	[1] X(i)	[2] X(i+1)-X(i-1)	[3] Y(i)	[4] Y(i+1)-Y(i-1)	[2]*[3]	[1]*[4]	方向角	夾角	距離
D25-15	61935.264	-9.189	-6804.453	15.001	62526.118617	929090.895264	79-35-49	95-49-51	11.896
D25-45	61937.412	16.369	-6792.753	9.090	-111190.573857	563011.075080	349-36-01	90-00-12	14.459
D25-44	61951.633	13.322	-6795.363	-12.184	-90527.825886	-754818.696472	264-38-08	95-02-07	9.616
D25-1	61950.734	-5.032	-6804.937	-12.391	34242.442984	-767631.544994	214-16-40	129-38-32	5.002
D25-2	61946.601	-15.470	-6807.754	0.484	105315.954380	29982.154884	163-45-58	129-29-18	11.808
合計				倍面積	366.116238	-366.116238			52.781
				面積	183.0581190	183.0581190			
				坪数	55.37	55.37			

面積（座標法）計算書

地番：25D-2

測点名	[1] X(i)	[2] X(i+1)-X(i-1)	[3] Y(i)	[4] Y(i+1)-Y(i-1)	[2]*[3]	[1]*[4]	方向角	夾角	距離
D25-45	61937.412	-12.881	-6792.753	9.907	87497.451393	613613.940684	79-35-39	89-59-38	7.419
D25-47	61938.752	14.918	-6785.456	4.805	-101225.432608	297615.703360	349-36-00	90-00-21	13.805
D25-43	61952.330	12.881	-6787.948	-9.907	-87435.558188	-613761.733310	264-37-48	95-01-48	7.448
D25-44	61951.633	-14.918	-6795.363	-4.805	101373.225234	-297677.596565	169-36-01	84-58-13	14.459
合計				倍面積	209.685831	-209.685831			43.131
				面積	104.8429155	104.8429155			
				坪数	31.71	31.71			

面積（座標法）計算書

地 番： 25D-3-1

測点名	[1] X(i)	[2] X(i+1)-X(i-1)	[3] Y(i)	[4] Y(i+1)-Y(i-1)	[2]*[3]	[1]*[4]	方向角	夾 角	距 離
D25-48	61932.596	-3.413	-6784.328	14.558	23154.911464	901614.732568	78-27-23	88-50-23	13.707
D25-69	61935.339	3.395	-6770.898	16.621	-22987.198710	1029427.269519	78-27-07	179-59-44	3.257
D25-79	61935.991	18.544	-6767.707	-0.459	-125500.358608	-28428.619869	348-28-11	90-01-04	18.261
D25-78	61953.883	16.339	-6771.357	-20.241	-110637.202023	-1254008.545803	264-39-09	96-10-58	16.664
D25-43	61952.330	-15.131	-6787.948	-14.099	102708.441188	-873465.900670	169-36-00	84-56-51	13.805
D25-47	61938.752	-19.734	-6785.456	3.620	133904.188704	224218.282240	169-37-00	180-01-00	6.258
合計				倍面積	642.782015	-642.782015			71.952
				面 積	321.3910075	321.3910075			
				坪 数	97.22	97.22			

面積（座標法）計算書

地番：25D-3-2

測点名	[1] X(i)	[2] X(i+1)-X(i-1)	[3] Y(i)	[4] Y(i+1)-Y(i-1)	[2]*[3]	[1]*[4]	方向角	夾角	距離
D25-76	61936.394	-16.397	-6765.748	9.841	110937.969956	609516.053354	78-23-24	89-55-09	6.365
D25-71	61937.675	1.510	-6759.513	7.350	-10206.864630	455241.911250	78-23-38	180-00-14	1.138
D25-72	61937.904	17.105	-6758.398	-2.335	-115602.397790	-144625.005840	348-26-46	90-03-08	17.225
D25-42	61954.780	16.168	-6761.848	-10.956	-109325.558464	-678776.569680	264-36-42	96-09-56	7.539
D25-77	61954.072	-18.386	-6769.354	-3.900	124461.342644	-241620.880800	168-28-15	83-51-33	18.042
合計				倍面積	264.491716	-264.491716			50.309
				面積	132.2458580	132.2458580			
				坪数	40.00	40.00			

面積（座標法）計算書

地番：25D-3-3

測点名	[1] X(i)	[2] X(i+1)-X(i-1)	[3] Y(i)	[4] Y(i+1)-Y(i-1)	[2]*[3]	[1]*[4]	方向角	夾角	距離
D25-79	61935.991	-17.489	-6767.707	5.609	118360.427723	347398.973519	78-22-32	89-54-21	2.000
D25-76	61936.394	18.081	-6765.748	-1.647	-122331.489588	-102009.240918	348-28-15	90-05-43	18.042
D25-77	61954.072	17.489	-6769.354	-5.609	-118389.232106	-347500.389848	264-36-35	96-08-20	2.012
D25-78	61953.883	-18.081	-6771.357	1.647	122432.905917	102038.045301	168-28-11	83-51-36	18.261
合計				倍面積	72.611946	-72.611946			40.315
				面積	36.3059730	36.3059730			
				坪数	10.98	10.98			

面積（座標法）計算書

地番： 25D-4

測点名	[1] X(i)	[2] X(i+1)-X(i-1)	[3] Y(i)	[4] Y(i+1)-Y(i-1)	[2]*[3]	[1]*[4]	方向角	夾角	距離
D25-72	61937.904	-16.046	-6758.398	7.492	108445.254308	464038.776768	78-23-45	89-56-59	4.126
D25-74	61938.734	17.266	-6754.356	0.682	-116620.710696	42242.216588	348-26-47	90-03-02	16.776
D25-41	61955.170	16.046	-6757.716	-7.492	-108434.310936	-464168.133640	264-36-29	96-09-42	4.150
D25-42	61954.780	-17.266	-6761.848	-0.682	116750.067568	-42253.159960	168-26-46	83-50-17	17.225
合計				倍面積	140.300244	-140.300244			42.277
				面積	70.1501220	70.1501220			
				坪数	21.22	21.22			

面積（座標法）計算書

地番：25D-5

測点名	[1] X(i)	[2] X(i+1)-X(i-1)	[3] Y(i)	[4] Y(i+1)-Y(i-1)	[2]*[3]	[1]*[4]	方向角	夾角	距離
D25-74	61938.734	-13.787	-6754.356	16.260	93122.306172	1007123.814840	78-23-44	89-56-57	13.169
D25-40	61941.383	17.468	-6741.456	7.575	-117759.753408	469205.976225	340-14-05	81-50-21	15.747
D25-12	61956.202	13.787	-6746.781	-16.260	-93017.869647	-1007407.844520	264-36-31	104-22-26	10.984
D25-41	61955.170	-17.468	-6757.716	-7.575	118043.783088	-469310.412750	168-26-47	83-50-16	16.776
合計				倍面積	388.466205	-388.466205			56.676
				面積	194.2331025	194.2331025			
				坪数	58.75	58.75			

面積（座標法）計算書

地番：25D-6

測点名	[1] X(i)	[2] X(i+1)-X(i-1)	[3] Y(i)	[4] Y(i+1)-Y(i-1)	[2]*[3]	[1]*[4]	方向角	夾角	距離
D25-38	61923.693	-7.808	-6755.580	20.968	52747.568640	1298415.994824	70-34-05	81-47-03	19.246
D25-13	61930.096	17.690	-6737.430	14.124	-119185.136700	874700.675904	340-22-08	89-48-03	11.984
D25-40	61941.383	8.638	-6741.456	-16.926	-58232.696928	-1048419.848658	258-23-44	98-01-36	13.169
D25-74	61938.734	-3.479	-6754.356	-16.942	23498.404524	-1049366.031428	258-23-45	180-00-01	4.126
D25-72	61937.904	-15.041	-6758.398	-1.224	101653.064318	-75811.994496	168-47-02	90-23-17	14.488
合計				倍面積	481.203854	-481.203854			63.013
				面積	240.6019270	240.6019270			
				坪数	72.78	72.78			

面積（座標法）計算書

地番：25D-8

測点名	[1] X(i)	[2] X(i+1)-X(i-1)	[3] Y(i)	[4] Y(i+1)-Y(i-1)	[2]*[3]	[1]*[4]	方向角	夾角	距離
D25-37	61923.312	-13.982	-6756.666	3.933	94471.704012	243544.386096	70-40-04	81-52-46	1.151
D25-38	61923.693	14.592	-6755.580	-1.732	-98577.423360	-107251.836276	348-47-02	98-06-58	14.488
D25-72	61937.904	13.982	-6758.398	-3.933	-94495.920836	-243601.776432	258-23-38	89-36-36	1.138
D25-71	61937.675	-14.592	-6759.513	1.732	98634.813696	107276.053100	168-47-18	90-23-40	14.642
合計				倍面積	33.173512	-33.173512			31.419
				面積	16.5867560	16.5867560			
				坪数	5.01	5.01			

面積（座標法）計算書

地番：25D-9

測点名	[1] X(i)	[2] X(i+1)-X(i-1)	[3] Y(i)	[4] Y(i+1)-Y(i-1)	[2]*[3]	[1]*[4]	方向角	夾角	距離
D25-68	61928.579	-5.400	-6769.519	8.042	36555.402600	498029.632318	78-27-49	89-59-36	6.800
D25-70	61929.939	-6.849	-6762.856	8.338	46318.800744	516371.831382	168-28-03	270-00-14	8.378
D25-36	61921.730	-6.627	-6761.181	6.190	44806.346487	383295.508700	70-41-25	82-13-22	4.784
D25-37	61923.312	15.945	-6756.666	1.668	-107735.039370	103288.084416	348-47-18	98-05-53	14.642
D25-71	61937.675	13.082	-6759.513	-9.082	-88427.949066	-562517.964350	258-23-24	89-36-06	6.365
D25-76	61936.394	-1.684	-6765.748	-8.194	11393.519632	-507506.812436	258-22-32	179-59-08	2.000
D25-79	61935.991	-1.055	-6767.707	-5.150	7139.930885	-318970.353650	258-27-07	180-04-35	3.257
D25-69	61935.339	-7.412	-6770.898	-1.812	50185.895976	-112226.834268	168-28-13	90-01-06	6.899
合計				倍面積	236.907888	-236.907888			53.125
				面積	118.4539440	118.4539440			
				坪数	35.83	35.83			

面積（座標法）計算書

地 番： 25D-10

測点名	[1] X(i)	[2] X(i+1)-X(i-1)	[3] Y(i)	[4] Y(i+1)-Y(i-1)	[2]*[3]	[1]*[4]	方向角	夾 角	距 離
D25-67	61919.151	-8.648	-6767.595	6.155	58526.161560	381112.374405	79-33-17	91-05-20	4.302
D25-35	61919.931	1.771	-6763.364	4.108	-11977.917644	254367.076548	352-55-29	93-22-12	0.999
D25-7	61920.922	1.799	-6763.487	2.183	-12167.513113	135173.372726	70-41-24	257-45-55	2.443
D25-36	61921.730	9.017	-6761.181	0.631	-60965.569077	39072.611630	348-28-03	97-46-39	8.378
D25-70	61929.939	6.849	-6762.856	-8.338	-46318.800744	-516371.831382	258-27-49	89-59-46	6.800
D25-68	61928.579	-10.788	-6769.519	-4.739	73029.570972	-293479.535881	168-27-57	90-00-08	9.622
合計				倍面積	125.931954	-125.931954			32.544
				面 積	62.9659770	62.9659770			
				坪 数	19.04	19.04			

面積（座標法）計算書

地番：25D-11

測点名	[1] X(i)	[2] X(i+1)-X(i-1)	[3] Y(i)	[4] Y(i+1)-Y(i-1)	[2]*[3]	[1]*[4]	方向角	夾角	距離
D25-51	61914.642	-6.849	-6781.029	19.776	46443.267621	1224423.960192	79-33-38	89-58-23	18.212
D25-34	61917.942	5.289	-6763.118	17.665	-35770.131102	1093780.445430	352-56-58	93-23-20	2.004
D25-35	61919.931	1.209	-6763.364	-4.477	-8176.907076	-277215.531087	259-33-17	86-36-19	4.302
D25-67	61919.151	8.648	-6767.595	-6.155	-58526.161560	-381112.374405	348-27-57	268-54-40	9.622
D25-68	61928.579	16.188	-6769.519	-3.303	-109584.973572	-204550.096437	348-28-13	180-00-16	6.899
D25-69	61935.339	4.017	-6770.898	-14.809	-27198.697266	-917200.435251	258-27-23	89-59-10	13.707
D25-48	61932.596	-7.185	-6784.328	-12.614	48745.396680	-781217.765944	169-35-27	91-08-04	4.516
D25-49	61928.154	-7.805	-6783.512	1.434	52945.311160	88804.972836	169-35-14	179-59-47	3.419
D25-50	61924.791	-13.512	-6782.894	2.483	91650.463728	153759.256053	169-35-15	180-00-01	10.319
合計				倍面積	527.568613	-527.568613			73.000
				面積	263.7843065	263.7843065			
				坪数	79.79	79.79			

面積（座標法）計算書

地番：25D-12

測点名	[1] X(i)	[2] X(i+1)-X(i-1)	[3] Y(i)	[4] Y(i+1)-Y(i-1)	[2]*[3]	[1]*[4]	方向角	夾角	距離
D25-52	61911.930	0.558	-6780.529	18.251	-3783.535182	1129954.634430	79-33-44	90-00-30	18.050
D25-33	61915.200	6.012	-6762.778	17.411	-40657.821336	1078005.547200	352-55-54	93-22-10	2.763
D25-34	61917.942	-0.558	-6763.118	-18.251	3773.819844	-1130064.359442	259-33-38	86-37-44	18.212
D25-51	61914.642	-6.012	-6781.029	-17.411	40767.546348	-1077995.831862	169-33-14	89-59-36	2.758
合計				倍面積	100.009674	-100.009674			41.783
				面積	50.0048370	50.0048370			
				坪数	15.12	15.12			

面積（座標法）計算書

地 番： 25D-13

測点名	[1] X(i)	[2] X(i+1)-X(i-1)	[3] Y(i)	[4] Y(i+1)-Y(i-1)	[2]*[3]	[1]*[4]	方向角	夾 角	距 離
D25-55	61899.984	-2.249	-6778.326	18.039	15244.455174	1116613.811376	79-33-44	90-00-47	17.332
D25-32	61903.124	15.216	-6761.281	15.548	-102879.651696	962469.771952	352-56-00	93-22-16	12.168
D25-33	61915.200	8.806	-6762.778	-19.248	-59553.023068	-1191743.769600	259-33-44	86-37-44	18.050
D25-52	61911.930	-5.768	-6780.529	-17.291	39110.091272	-1070519.181630	169-33-58	90-00-14	2.540
D25-53	61909.432	-6.557	-6780.069	1.209	44456.912433	74848.503288	169-32-42	179-58-44	4.128
D25-54	61905.373	-9.448	-6779.320	1.743	64051.015360	107901.065139	169-32-57	180-00-15	5.480
合計				倍面積	429.799475	-429.799475			59.698
				面 積	214.8997375	214.8997375			
				坪 数	65.00	65.00			

面積（座標法）計算書

地番：25D-14

測点名	[1] X(i)	[2] X(i+1)-X(i-1)	[3] Y(i)	[4] Y(i+1)-Y(i-1)	[2]*[3]	[1]*[4]	方向角	夾角	距離
D25-56	61897.849	0.981	-6777.935	17.312	-6649.154235	1071575.561888	79-33-57	89-56-38	17.206
D25-31	61900.965	5.275	-6761.014	16.654	-35664.348850	1030898.671110	352-57-00	93-23-03	2.175
D25-32	61903.124	-0.981	-6761.281	-17.312	6632.816661	-1071666.882688	259-33-44	86-36-44	17.332
D25-55	61899.984	-5.275	-6778.326	-16.654	35755.669650	-1030882.333536	169-37-19	90-03-35	2.171
合計				倍面積	74.983226	-74.983226			38.884
				面積	37.4916130	37.4916130			
				坪数	11.34	11.34			

面積（座標法）計算書

地番：25D-15

測点名	[1] X(i)	[2] X(i+1)-X(i-1)	[3] Y(i)	[4] Y(i+1)-Y(i-1)	[2]*[3]	[1]*[4]	方向角	夾角	距離
D25-59	61888.510	0.634	-6776.221	16.814	-4296.124114	1040593.407140	79-36-38	90-00-55	16.652
D25-30	61891.513	12.455	-6759.842	15.207	-84193.832110	941184.238191	352-55-54	93-19-16	9.524
D25-31	61900.965	6.336	-6761.014	-18.093	-42837.784704	-1119974.159745	259-33-57	86-38-03	17.206
D25-56	61897.849	-7.153	-6777.935	-16.180	48482.569055	-1001507.196820	169-35-56	90-01-59	4.104
D25-57	61893.812	-6.970	-6777.194	1.279	47237.042180	79162.185548	169-36-21	180-00-25	2.982
D25-58	61890.879	-5.302	-6776.656	0.973	35929.830112	60219.825267	169-35-43	179-59-22	2.409
合計				倍面積	321.700419	-321.700419			52.877
				面積	160.8502095	160.8502095			
				坪数	48.65	48.65			

面積（座標法）計算書

地番：25D-16

測点名	[1] X(i)	[2] X(i+1)-X(i-1)	[3] Y(i)	[4] Y(i+1)-Y(i-1)	[2]*[3]	[1]*[4]	方向角	夾角	距離
D25-61	61885.803	1.706	-6775.722	16.452	-11559.381732	1018145.230956	79-36-58	90-02-40	16.489
D25-29	61888.775	5.710	-6759.503	15.880	-38596.762130	982793.747000	352-56-31	93-19-33	2.759
D25-30	61891.513	-0.265	-6759.842	-16.718	1791.358130	-1034702.314334	259-36-38	86-40-07	16.652
D25-59	61888.510	-4.444	-6776.221	-16.113	30113.526124	-997209.561630	169-32-29	89-55-51	1.465
D25-60	61887.069	-2.707	-6775.955	0.499	18342.510185	30881.647431	169-34-18	180-01-49	1.287
合計				倍面積	91.250577	-91.250577			38.652
				面積	45.6252885	45.6252885			
				坪数	13.80	13.80			

面積（座標法）計算書

地番：25D-17

測点名	[1] X(i)	[2] X(i+1)-X(i-1)	[3] Y(i)	[4] Y(i+1)-Y(i-1)	[2]*[3]	[1]*[4]	方向角	夾角	距離
D25-62	61873.853	-9.089	-6773.517	17.716	61564.496013	1096157.179748	79-32-57	90-00-13	15.773
D25-28	61876.714	14.922	-6758.006	14.014	-100842.965532	867140.269996	352-55-29	93-22-32	12.154
D25-29	61888.775	9.089	-6759.503	-17.716	-61437.122767	-1096421.537900	259-36-58	86-41-29	16.489
D25-61	61885.803	-14.922	-6775.722	-14.014	101107.323684	-867267.643242	169-32-44	89-55-46	12.152
合計				倍面積	391.731398	-391.731398			56.568
				面積	195.8656990	195.8656990			
				坪数	59.24	59.24			

面積（座標法）計算書

地番： 25D-18

測点名	[1] X(i)	[2] X(i+1)-X(i-1)	[3] Y(i)	[4] Y(i+1)-Y(i-1)	[2]*[3]	[1]*[4]	方向角	夾角	距離
D25-63	61871.413	0.396	-6773.070	15.817	-2682.135720	978620.139421	79-32-44	89-55-37	15.629
D25-27	61874.249	5.301	-6757.700	15.064	-35822.567700	932073.686936	352-55-25	93-22-41	2.484
D25-28	61876.714	-0.396	-6758.006	-15.817	2676.170376	-978703.985338	259-32-57	86-37-32	15.773
D25-62	61873.853	-5.301	-6773.517	-15.064	35906.413617	-932067.721592	169-37-07	90-04-10	2.481
合計				倍面積	77.880573	-77.880573			36.367
				面積	38.9402865	38.9402865			
				坪数	11.77	11.77			

面積（座標法）計算書

地番：25D-19

測点名	[1] X(i)	[2] X(i+1)-X(i-1)	[3] Y(i)	[4] Y(i+1)-Y(i-1)	[2]*[3]	[1]*[4]	方向角	夾角	距離
D25-65	61860.676	-2.734	-6771.102	15.749	18512.192868	974243.786324	79-33-47	89-56-54	14.998
D25-26	61863.393	13.573	-6756.352	13.402	-91703.965696	829093.192986	352-55-18	93-21-31	10.939
D25-27	61874.249	8.020	-6757.700	-16.718	-54196.754000	-1034413.694782	259-32-44	86-37-26	15.629
D25-63	61871.413	-8.122	-6773.070	-14.401	55010.874540	-891010.218613	169-36-44	90-04-00	5.374
D25-64	61866.127	-10.737	-6772.101	1.968	72712.048437	121752.537936	169-36-53	180-00-09	5.542
合計				倍面積	334.396149	-334.396149			52.482
				面積	167.1980745	167.1980745			
				坪数	50.57	50.57			

面積（座標法）計算書

地番：25D-20

測点名	[1] X(i)	[2] X(i+1)-X(i-1)	[3] Y(i)	[4] Y(i+1)-Y(i-1)	[2]*[3]	[1]*[4]	方向角	夾角	距離
D25-66	61858.173	0.187	-6770.641	15.064	-1266.109867	931831.518072	79-33-45	89-59-54	14.849
D25-25	61860.863	5.220	-6756.038	14.289	-35266.518360	883929.871407	352-55-31	93-21-46	2.549
D25-26	61863.393	-0.187	-6756.352	-15.064	1263.437824	-931910.152152	259-33-47	86-38-16	14.998
D25-65	61860.676	-5.220	-6771.102	-14.289	35345.152440	-883927.199364	169-33-51	90-00-04	2.545
合計				倍面積	75.962037	-75.962037			34.941
				面積	37.9810185	37.9810185			
				坪数	11.48	11.48			

面積（座標法）計算書

地番：25D-21

測点名	[1] X(i)	[2] X(i+1)-X(i-1)	[3] Y(i)	[4] Y(i+1)-Y(i-1)	[2]*[3]	[1]*[4]	方向角	夾角	距離
D25-24	61847.896	-10.681	-6768.747	12.428	72296.986707	768645.651488	92-11-47	102-38-19	10.542
D25-5	61847.492	3.280	-6758.213	13.909	-22166.938640	860236.766228	42-29-37	130-17-50	4.996
D25-6	61851.176	13.371	-6754.838	2.175	-90318.938898	134526.307800	352-56-18	130-26-41	9.761
D25-25	61860.863	6.997	-6756.038	-15.803	-47271.997886	-977587.217989	259-33-45	86-37-27	14.849
D25-66	61858.173	-12.967	-6770.641	-12.709	87794.901847	-786155.520657	169-33-28	89-59-43	10.450
合計				倍面積	334.013130	-334.013130			50.598
				面積	167.0065650	167.0065650			
				坪数	50.51	50.51			

面積（座標法）計算書

地 番： 25D-22

測点名	[1] X(i)	[2] X(i+1)-X(i-1)	[3] Y(i)	[4] Y(i+1)-Y(i-1)	[2]*[3]	[1]*[4]	方向角	夾 角	距 離
D25-3	61851.256	-15.830	-6780.054	7.641	107328.254820	472605.447096	128-01-22	144-12-49	5.000
D25-4	61848.176	-3.360	-6776.115	11.307	22767.746400	699317.326032	92-10-35	144-09-13	7.373
D25-24	61847.896	9.997	-6768.747	5.474	-67667.163759	338555.382704	349-33-28	77-22-53	10.450
D25-66	61858.173	12.780	-6770.641	-2.355	-86528.791980	-145675.997415	349-33-51	180-00-23	2.545
D25-65	61860.676	7.954	-6771.102	-1.460	-53857.345308	-90316.586960	349-36-53	180-03-02	5.542
D25-64	61866.127	3.330	-6772.101	-12.654	-22551.096330	-782853.971058	259-41-10	90-04-17	11.846
D25-23	61864.006	-14.871	-6783.756	-7.953	100881.235476	-492004.439718	163-48-33	84-07-23	13.277
合計				倍面積	372.839319	-372.839319			56.033
				面 積	186.4196595	186.4196595			
				坪 数	56.39	56.39			

面積（座標法）計算書

地番：25D-23

測点名	[1] X(i)	[2] X(i+1)-X(i-1)	[3] Y(i)	[4] Y(i+1)-Y(i-1)	[2]*[3]	[1]*[4]	方向角	夾角	距離
D25-23	61864.006	-18.419	-6783.756	17.617	124950.001764	1089858.193702	79-41-10	95-52-20	11.846
D25-64	61866.127	7.407	-6772.101	10.686	-50160.952107	661101.433122	349-36-44	89-55-34	5.374
D25-63	61871.413	7.726	-6773.070	-1.416	-52328.738820	-87609.920808	349-37-07	180-00-23	2.481
D25-62	61873.853	14.390	-6773.517	-2.652	-97470.909630	-164089.458156	349-32-44	179-55-37	12.152
D25-61	61885.803	13.216	-6775.722	-2.438	-89547.941952	-150877.587714	349-34-18	180-01-34	1.287
D25-60	61887.069	-1.257	-6775.955	-13.996	8517.375435	-866171.417724	259-36-43	90-02-25	13.992
D25-22	61884.546	-23.063	-6789.718	-7.801	156591.266234	-482761.343346	163-48-50	84-12-07	21.388
合計				倍面積	550.100924	-550.100924			68.520
				面積	275.0504620	275.0504620			
				坪数	83.20	83.20			

面積（座標法）計算書

地番：25D-24

測点名	[1] X(i)	[2] X(i+1)-X(i-1)	[3] Y(i)	[4] Y(i+1)-Y(i-1)	[2]*[3]	[1]*[4]	方向角	夾角	距離
D25-22	61884.546	-1.216	-6789.718	14.848	8256.297088	918861.739008	79-36-43	95-47-38	13.992
D25-60	61887.069	3.964	-6775.955	13.497	-26859.885620	835289.770293	349-32-29	89-55-46	1.465
D25-59	61888.510	3.810	-6776.221	-0.701	-25817.402010	-43383.845510	349-35-43	180-03-14	2.409
D25-58	61890.879	-0.225	-6776.656	-14.582	1524.747600	-902492.797578	259-36-35	90-00-52	14.383
D25-21	61888.285	-6.333	-6790.803	-13.062	43006.155399	-808384.778670	163-49-05	84-12-30	3.893
合計				倍面積	109.912457	-109.912457			36.142
				面積	54.9562285	54.9562285			
				坪数	16.62	16.62			

面積（座標法）計算書

地番：25D-25

測点名	[1] X(i)	[2] X(i+1)-X(i-1)	[3] Y(i)	[4] Y(i+1)-Y(i-1)	[2]*[3]	[1]*[4]	方向角	夾角	距離
D25-21	61888.285	-0.286	-6790.803	14.984	1942.169658	927334.062440	79-36-35	95-48-54	14.383
D25-58	61890.879	5.527	-6776.656	13.609	-37454.577712	842272.972311	349-36-21	89-59-46	2.982
D25-57	61893.812	0.286	-6777.194	-14.984	-1938.277484	-927416.879008	259-37-00	90-00-39	14.687
D25-20	61891.165	-5.527	-6791.640	-13.609	37537.394280	-842276.864485	163-47-41	84-10-41	2.999
合計				倍面積	86.708742	-86.708742			35.051
				面積	43.3543710	43.3543710			
				坪数	13.11	13.11			

面積（座標法）計算書

地番：25D-26

測点名	[1] X(i)	[2] X(i+1)-X(i-1)	[3] Y(i)	[4] Y(i+1)-Y(i-1)	[2]*[3]	[1]*[4]	方向角	夾角	距離
D25-20	61891.165	-8.699	-6791.640	17.744	59080.476360	1098196.831760	79-37-00	95-49-28	14.687
D25-57	61893.812	6.684	-6777.194	13.705	-45298.764696	848254.693460	349-35-56	89-58-56	4.104
D25-56	61897.849	6.172	-6777.935	-1.132	-41833.414820	-70068.365068	349-37-19	180-01-23	2.171
D25-55	61899.984	7.524	-6778.326	-1.385	-51000.124824	-85731.477840	349-32-57	179-55-38	5.480
D25-54	61905.373	2.527	-6779.320	-16.612	-17131.341640	-1028372.056276	259-36-57	90-04-00	15.878
D25-19	61902.511	-14.208	-6794.938	-12.320	96542.479104	-762638.935520	163-47-32	84-10-35	11.816
合計				倍面積	359.309484	-359.309484			54.136
				面積	179.6547420	179.6547420			
				坪数	54.34	54.34			

面積（座標法）計算書

地番：25D-27

測点名	[1] X(i)	[2] X(i+1)-X(i-1)	[3] Y(i)	[4] Y(i+1)-Y(i-1)	[2]*[3]	[1]*[4]	方向角	夾角	距離
D25-54	61905.373	6.921	-6779.320	14.869	-46919.673720	920470.991137	349-32-42	89-55-45	4.128
D25-53	61909.432	1.121	-6780.069	-16.776	-7600.457349	-1038592.631232	259-36-44	90-04-02	16.294
D25-18	61906.494	-6.921	-6796.096	-14.869	47035.780416	-920487.659286	163-47-20	84-10-36	4.148
D25-19	61902.511	-1.121	-6794.938	16.776	7617.125498	1038476.524536	79-36-57	95-49-37	15.878
合計				倍面積	132.774845	-132.774845			40.448
				面積	66.3874225	66.3874225			
				坪数	20.08	20.08			

面積（座標法）計算書

地 番： 25D-28

測点名	[1] X(i)	[2] X(i+1)-X(i-1)	[3] Y(i)	[4] Y(i+1)-Y(i-1)	[2]*[3]	[1]*[4]	方向角	夾 角	距 離
D25-18	61906.494	-12.122	-6796.096	20.405	82382.275712	1263202.010070	79-36-44	95-49-18	16.294
D25-53	61909.432	5.436	-6780.069	15.567	-36856.455084	963744.127944	349-33-58	89-57-14	2.540
D25-52	61911.930	5.210	-6780.529	-0.960	-35326.556090	-59435.452800	349-33-14	179-59-16	2.758
D25-51	61914.642	12.861	-6781.029	-2.365	-87210.813969	-146428.128330	349-35-15	180-02-01	10.319
D25-50	61924.791	6.912	-6782.894	-19.445	-46883.363328	-1204127.560995	259-34-01	89-58-46	17.876
D25-17	61921.554	-18.297	-6800.474	-13.202	124428.272778	-817488.355908	163-47-26	84-13-25	15.683
合計				倍面積	533.360019	-533.360019			65.470
				面 積	266.6800095	266.6800095			
				坪 数	80.67	80.67			

面積（座標法）計算書

地番： 25D-29

測点名	[1] X(i)	[2] X(i+1)-X(i-1)	[3] Y(i)	[4] Y(i+1)-Y(i-1)	[2]*[3]	[1]*[4]	方向角	夾角	距離
D25-17	61921.554	-0.065	-6800.474	18.538	442.030810	1147901.768052	79-34-01	95-44-45	17.876
D25-50	61924.791	6.600	-6782.894	16.962	-44767.100400	1050368.304942	349-35-14	90-01-13	3.419
D25-49	61928.154	0.065	-6783.512	-18.538	-440.928280	-1148024.118852	259-34-19	89-59-05	18.221
D25-16	61924.856	-6.600	-6801.432	-16.962	44889.451200	-1050369.407472	163-49-16	84-14-57	3.438
合計				倍面積	123.453330	-123.453330			42.954
				面積	61.7266650	61.7266650			
				坪数	18.67	18.67			

面積（座標法）計算書

地番：25D-30

測点名	[1] X(i)	[2] X(i+1)-X(i-1)	[3] Y(i)	[4] Y(i+1)-Y(i-1)	[2]*[3]	[1]*[4]	方向角	夾角	距離
D25-16	61924.856	-7.110	-6801.432	20.941	48358.181520	1296768.409496	79-34-19	95-45-28	18.221
D25-49	61928.154	7.740	-6783.512	17.104	-52504.382880	1059219.146016	349-35-27	90-01-08	4.516
D25-48	61932.596	10.598	-6784.328	-1.944	-71900.308144	-120396.966624	349-37-00	180-01-33	6.258
D25-47	61938.752	4.816	-6785.456	-8.425	-32678.756096	-521833.985600	259-35-39	89-58-39	7.419
D25-45	61937.412	-3.488	-6792.753	-18.997	23693.122464	-1176625.015764	259-35-49	180-00-10	11.896
D25-15	61935.264	-12.556	-6804.453	-8.679	85436.711868	-537536.156256	163-48-51	84-13-02	10.838
合計				倍面積	404.568732	-404.568732			59.148
				面積	202.2843660	202.2843660			
				坪数	61.19	61.19			

面積（座標法）計算書

地番：25D-S

測点名	[1] X(i)	[2] X(i+1)-X(i-1)	[3] Y(i)	[4] Y(i+1)-Y(i-1)	[2]*[3]	[1]*[4]	方向角	夾角	距離
D25-9	61934.750	23.517	-6734.847	-4.162	-158383.396899	-257772.429500	340-19-27	131-17-37	20.033
D25-10	61953.613	21.554	-6741.592	-10.981	-145308.273968	-680312.624353	302-25-36	142-06-09	5.018
D25-11	61956.304	2.589	-6745.828	-5.189	-17464.948692	-321491.261456	263-53-27	141-27-51	0.958
D25-12	61956.202	-14.921	-6746.781	4.372	100668.719301	270872.515144	160-14-05	76-20-38	15.747
D25-40	61941.383	-26.106	-6741.456	9.351	175992.450336	579213.872433	160-22-08	180-08-03	11.984
D25-13	61930.096	-6.633	-6737.430	6.609	44689.373190	409296.004464	29-01-50	48-39-42	5.323
合計				倍面積	193.923268	-193.923268			59.063
				面積	96.9616340	96.9616340			
				坪数	29.33	29.33			