
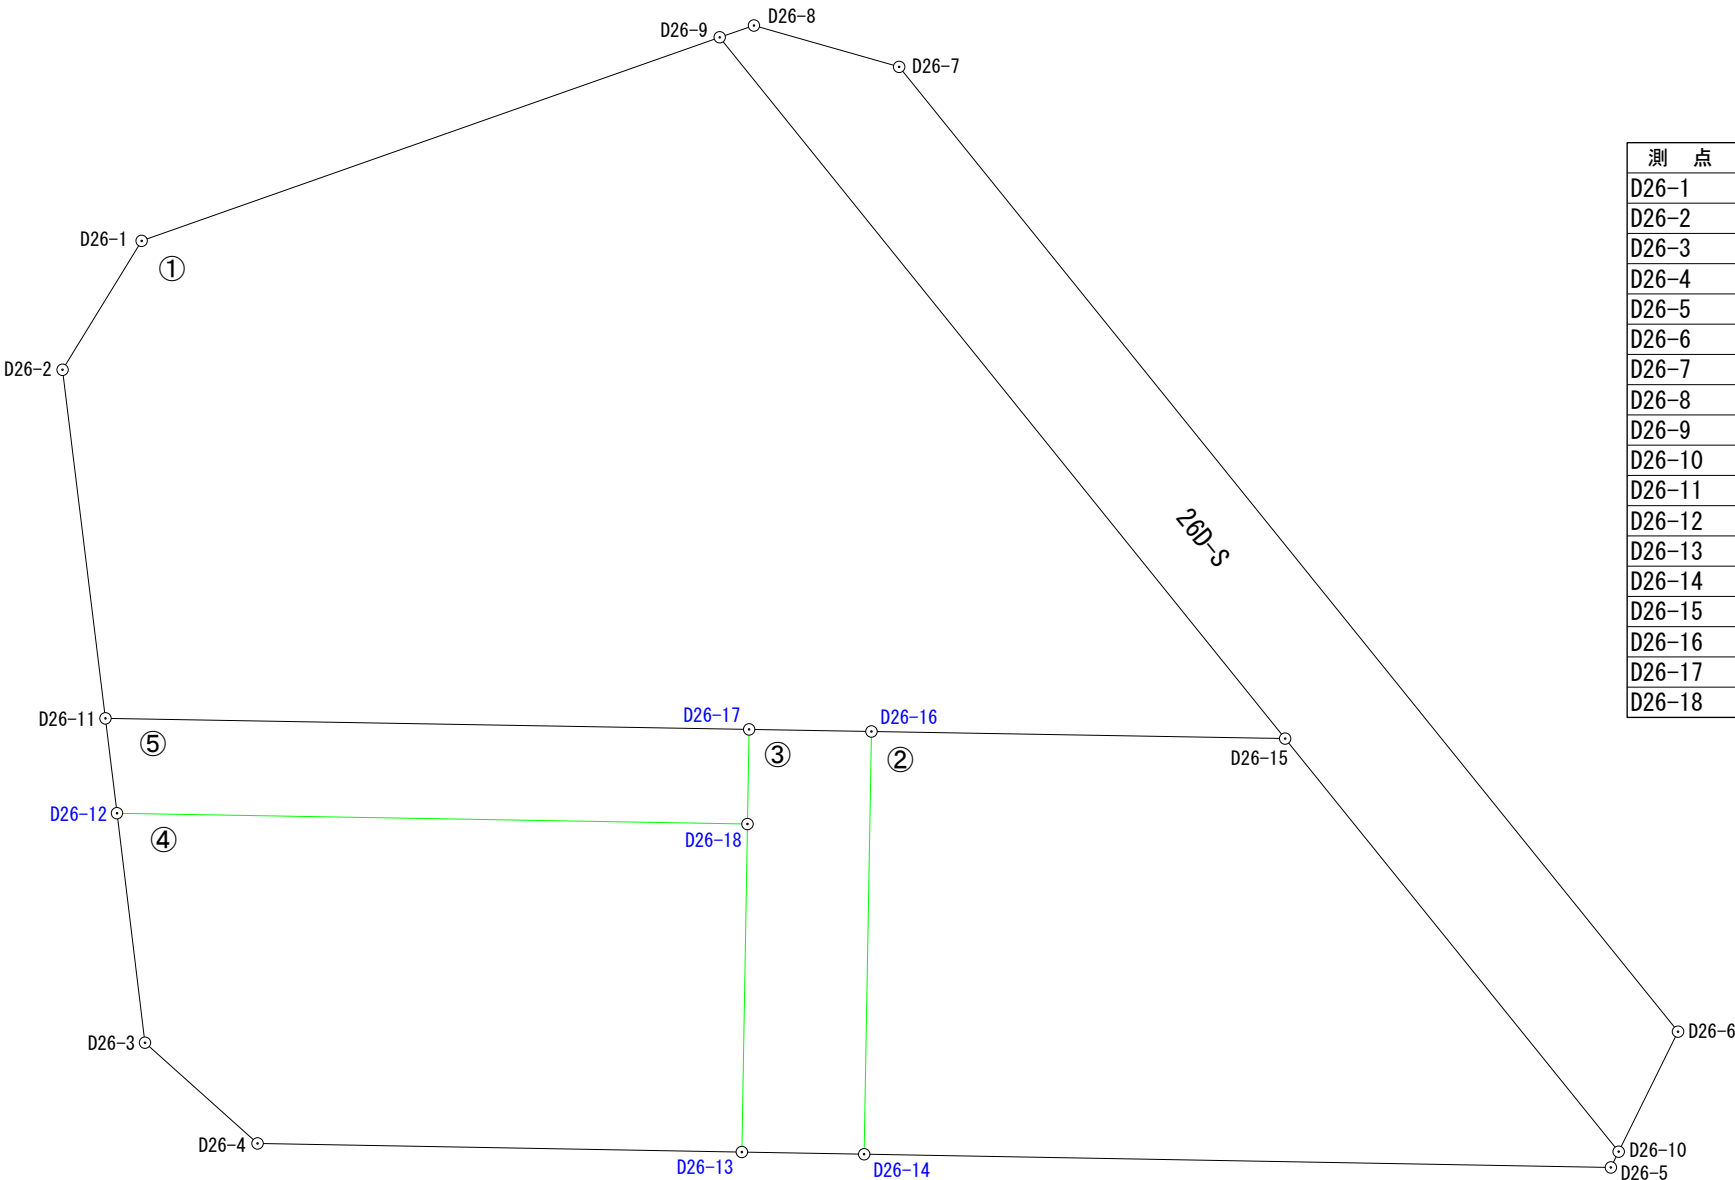


出来形確認測量図（縮尺１：２５０）

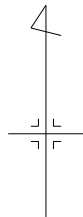

座 標 一 覧 表		
測 点 名	X 座 標	Y 座 標
D26-1	61917.904	-6753.908
D26-2	61913.642	-6756.525
D26-3	61891.391	-6753.797
D26-4	61888.060	-6750.073
D26-5	61887.265	-6705.315
D26-6	61891.755	-6703.095
D26-7	61923.655	-6728.854
D26-8	61925.022	-6733.657
D26-9	61924.633	-6734.789
D26-10	61887.788	-6705.056
D26-11	61902.115	-6755.105
D26-12	61898.979	-6754.722
D26-13	61887.776	-6734.057
D26-14	61887.704	-6730.011
D26-15	61901.445	-6716.087
D26-16	61901.680	-6729.770
D26-17	61901.749	-6733.817
D26-18	61898.620	-6733.871

凡 例	
	施工地区界
	道 路
	街区番号
	画地番号
D14-1	計 算 点
D14-2	境界標あり

平成25年 2月 8日測量
平成25年 2月 7日測量
平成24年 4月10日測量
平成24年 4月 9日測量

面積（座標法）計算書

地番：26D-1

測点名	[1] X(i)	[2] X(i+1)-X(i-1)	[3] Y(i)	[4] Y(i+1)-Y(i-1)	[2]*[3]	[1]*[4]	方向角	夾角	距離
D26-1	61917.904	-10.991	-6753.908	-21.736	74232.202828	-1345847.561344	211-33-04	140-56-27	5.001
D26-2	61913.642	-15.789	-6756.525	-1.197	106678.773225	-74110.629474	172-58-38	141-25-34	11.614
D26-11	61902.115	-11.893	-6755.105	22.708	80338.463765	1405673.227420	90-59-06	98-00-28	21.291
D26-17	61901.749	-0.435	-6733.817	25.335	2929.210395	1568280.810915	90-58-36	179-59-30	4.048
D26-16	61901.680	-0.304	-6729.770	17.730	2045.850080	1097516.786400	90-59-02	180-00-26	13.685
D26-15	61901.445	22.953	-6716.087	-5.019	-154154.344911	-310683.352455	321-06-45	50-07-43	29.790
D26-9	61924.633	16.459	-6734.789	-37.821	-110847.892151	-2342051.544693	250-36-37	109-29-52	20.269
合計				倍面積	1222.263231	-1222.263231			105.698
				面積	611.1316155	611.1316155			
				坪数	184.86	184.86			

面積（座標法）計算書

地番：26D-2

測点名	[1] X(i)	[2] X(i+1)-X(i-1)	[3] Y(i)	[4] Y(i+1)-Y(i-1)	[2]*[3]	[1]*[4]	方向角	夾角	距離
D26-16	61901.680	-13.741	-6729.770	-13.924	92473.769570	-861918.992320	180-59-16	90-00-14	13.978
D26-14	61887.704	-14.415	-6730.011	24.455	97013.108565	1513463.801320	91-01-06	90-01-50	24.700
D26-5	61887.265	0.084	-6705.315	24.955	-563.246460	1544396.698075	26-20-44	115-19-38	0.584
D26-10	61887.788	14.180	-6705.056	-10.772	-95077.694080	-666655.252336	321-04-18	114-43-34	17.556
D26-15	61901.445	13.892	-6716.087	-24.714	-93299.880604	-1529832.311730	270-59-02	129-54-44	13.685
合計				倍面積	546.056991	-546.056991			70.503
				面積	273.0284955	273.0284955			
				坪数	82.59	82.59			

面積（座標法）計算書

地番：26D-3

測点名	[1] X(i)	[2] X(i+1)-X(i-1)	[3] Y(i)	[4] Y(i+1)-Y(i-1)	[2]*[3]	[1]*[4]	方向角	夾角	距離
D26-17	61901.749	-3.060	-6733.817	-4.101	20605.480020	-253859.072649	180-59-19	90-00-43	3.129
D26-18	61898.620	-13.973	-6733.871	-0.240	94092.379483	-14855.668800	180-58-58	179-59-39	10.846
D26-13	61887.776	-10.916	-6734.057	3.860	73508.966212	238886.815360	91-01-10	90-02-12	4.047
D26-14	61887.704	13.904	-6730.011	4.287	-93574.072944	265312.587048	0-59-16	89-58-06	13.978
D26-16	61901.680	14.045	-6729.770	-3.806	-94519.619650	-235597.794080	270-58-36	89-59-20	4.048
合計				倍面積	113.133121	-113.133121			36.048
				面積	56.5665605	56.5665605			
				坪数	17.11	17.11			

面積（座標法）計算書

地番： 26D-4

測点名	[1] X(i)	[2] X(i+1)-X(i-1)	[3] Y(i)	[4] Y(i+1)-Y(i-1)	[2]*[3]	[1]*[4]	方向角	夾角	距離
D26-12	61898.979	-7.229	-6754.722	-19.926	48829.885338	-1233399.055554	173-02-59	82-03-48	7.644
D26-3	61891.391	-10.919	-6753.797	4.649	73744.709443	287733.076759	131-48-42	138-45-43	4.996
D26-4	61888.060	-3.615	-6750.073	19.740	24401.513895	1221670.304400	91-00-57	139-12-15	16.019
D26-13	61887.776	10.560	-6734.057	16.202	-71111.641920	1002705.746752	0-58-58	89-58-01	10.846
D26-18	61898.620	11.203	-6733.871	-20.665	-75439.556813	-1279134.982300	270-59-11	90-00-13	20.854
合計				倍面積	424.909943	-424.909943			60.359
				面積	212.4549715	212.4549715			
				坪数	64.26	64.26			

面積（座標法）計算書

地番： 26D-5

測点名	[1] X(i)	[2] X(i+1)-X(i-1)	[3] Y(i)	[4] Y(i+1)-Y(i-1)	[2]*[3]	[1]*[4]	方向角	夾角	距離
D26-11	61902.115	-2.770	-6755.105	-20.905	18711.640850	-1294063.714075	173-02-13	82-03-07	3.159
D26-12	61898.979	-3.495	-6754.722	21.234	23607.753390	1314362.920086	90-59-11	97-56-58	20.854
D26-18	61898.620	2.770	-6733.871	20.905	-18652.822670	1293990.651100	0-59-19	90-00-08	3.129
D26-17	61901.749	3.495	-6733.817	-21.234	-23534.690415	-1314421.738266	270-59-06	89-59-47	21.291
合計				倍面積	131.881155	-131.881155			48.433
				面積	65.9405775	65.9405775			
				坪数	19.94	19.94			

面積（座標法）計算書

地番：26D-S

測点名	[1] X(i)	[2] X(i+1)-X(i-1)	[3] Y(i)	[4] Y(i+1)-Y(i-1)	[2]*[3]	[1]*[4]	方向角	夾角	距離
D26-7	61923.655	33.267	-6728.854	-30.562	-223848.786018	-1892510.744110	285-53-14	144-48-28	4.994
D26-8	61925.022	0.978	-6733.657	-5.935	-6585.516546	-367525.005570	251-02-07	145-08-53	1.197
D26-9	61924.633	-23.577	-6734.789	17.570	158786.120253	1088015.801810	141-06-45	70-04-38	29.790
D26-15	61901.445	-36.845	-6716.087	29.733	247454.225515	1840515.664185	141-04-18	179-57-33	17.556
D26-10	61887.788	-9.690	-6705.056	12.992	64971.992640	804046.141696	26-18-16	65-13-58	4.425
D26-6	61891.755	35.867	-6703.095	-23.798	-240419.908365	-1472899.985490	321-04-46	114-46-30	41.002
合計				倍面積	358.127479	-358.127479			98.964
				面積	179.0637395	179.0637395			
				坪数	54.16	54.16			