
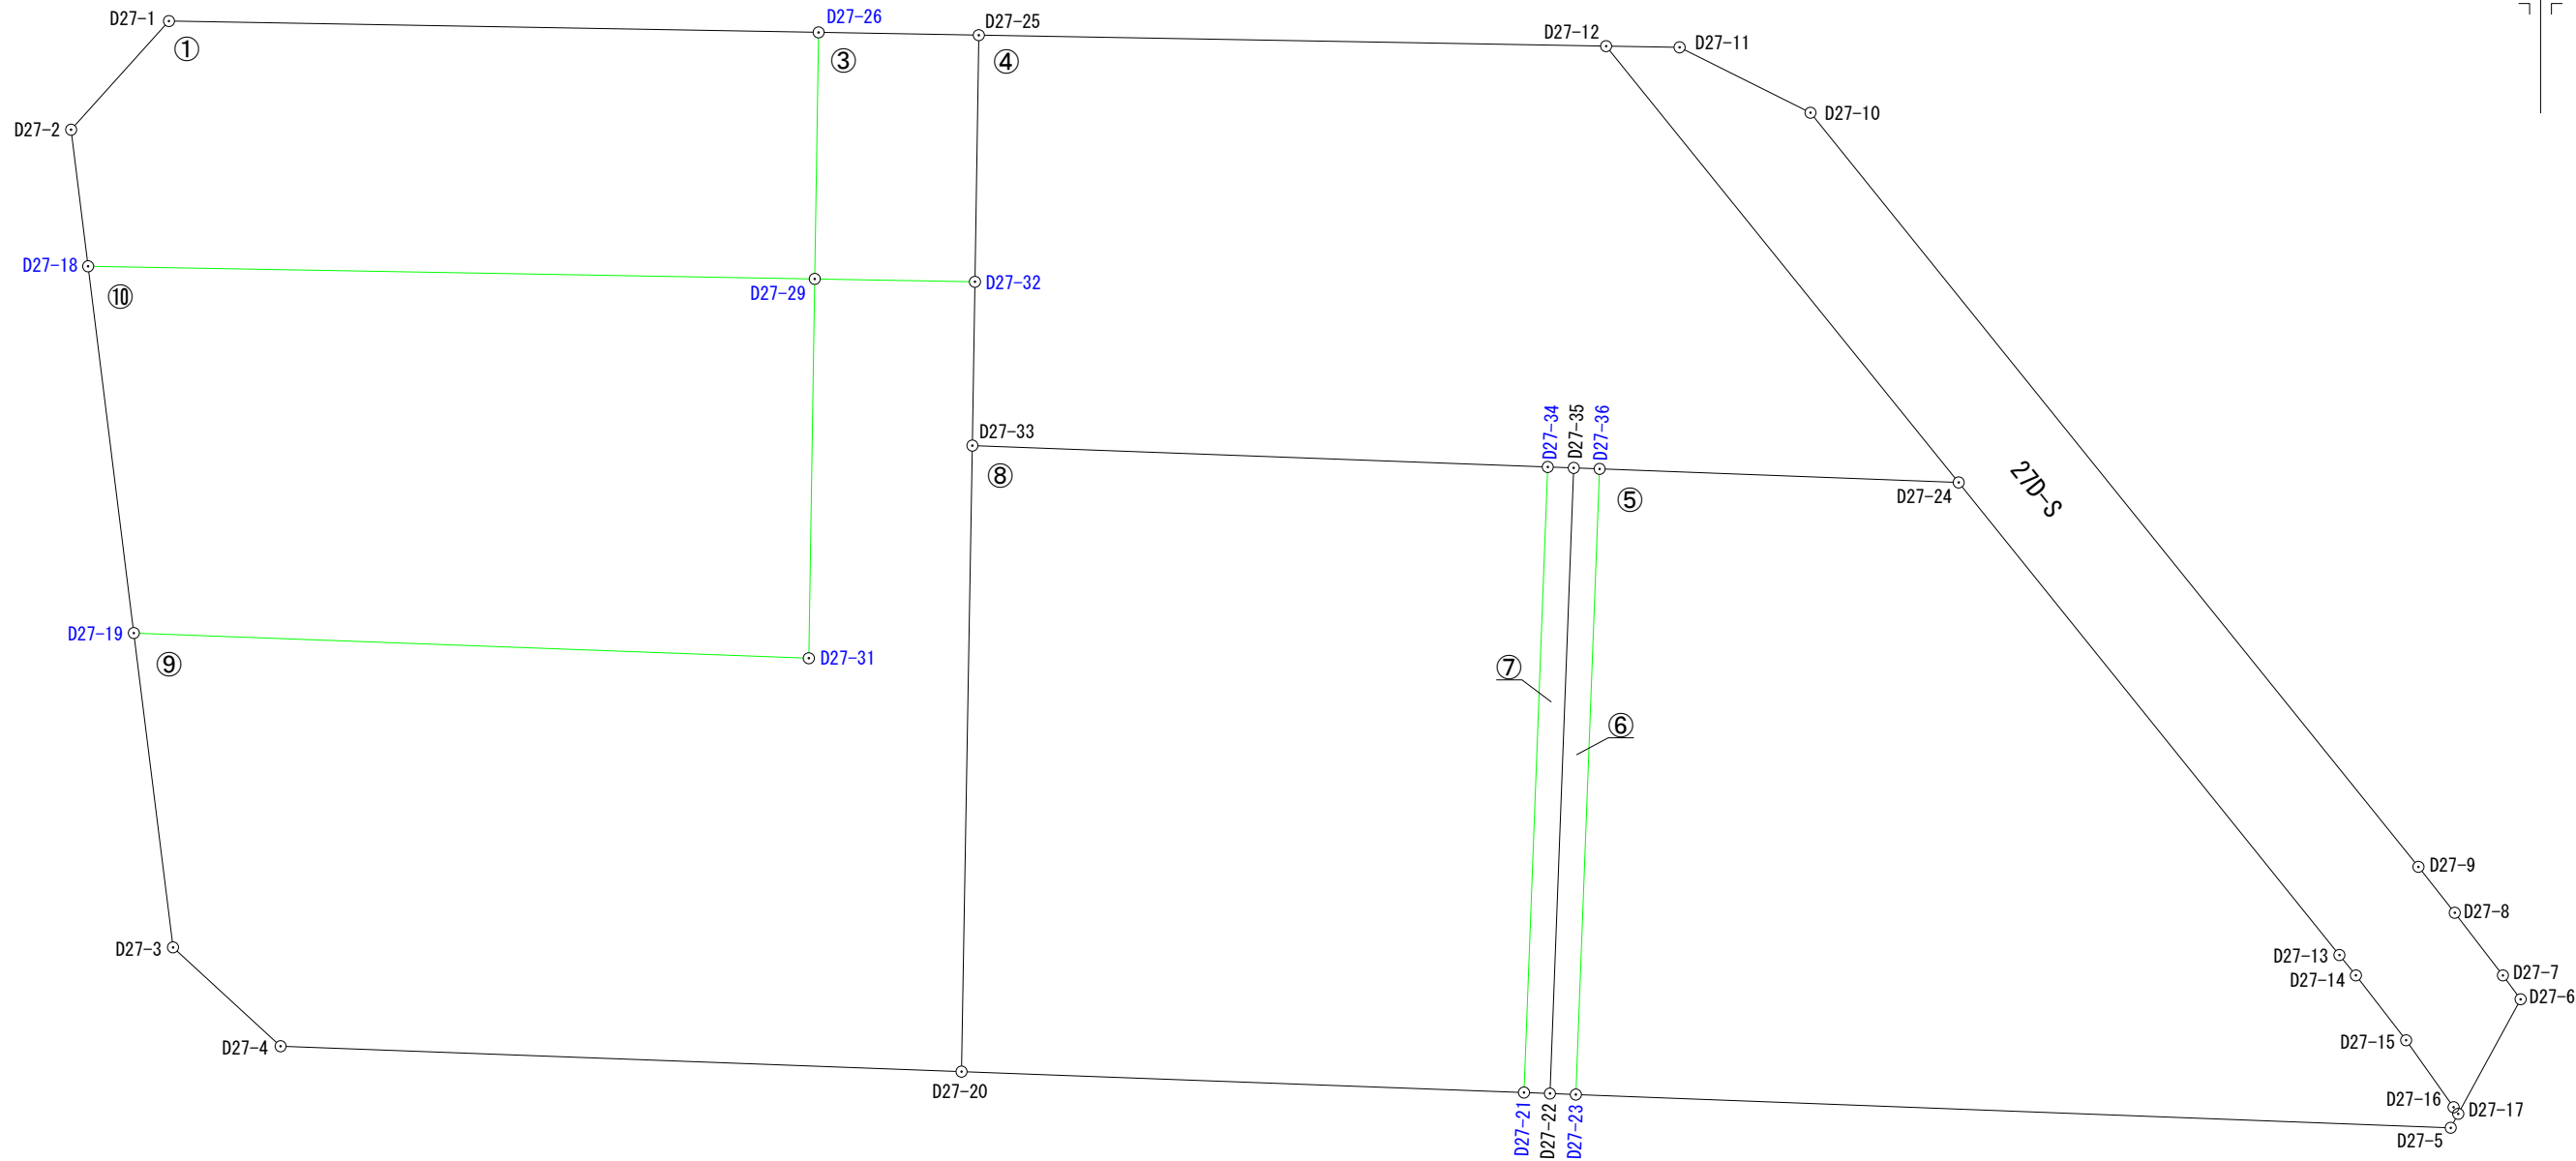


出来形確認測量図（縮尺１：２５０）

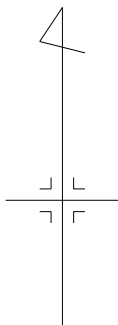

座 標 一 覧 表

測 点 名	X	座 標	Y	座 標
D27-1		61882.023		-6748.823
D27-2		61878.310		-6752.167
D27-3		61850.365		-6748.683
D27-4		61846.987		-6745.007
D27-5		61844.200		-6670.834
D27-6		61848.592		-6668.446
D27-7		61849.408		-6669.052
D27-8		61851.550		-6670.698
D27-9		61853.117		-6671.940
D27-10		61878.889		-6692.718
D27-11		61881.124		-6697.192
D27-12		61881.165		-6699.703
D27-13		61850.105		-6674.638

測 点 名	X	座 標	Y	座 標
D27-14		61849.410		-6674.077
D27-15		61847.194		-6672.359
D27-16		61844.902		-6670.737
D27-17		61844.676		-6670.579
D27-18		61873.643		-6751.585
D27-19		61861.107		-6750.022
D27-20		61846.119		-6721.732
D27-21		61845.405		-6702.509
D27-22		61845.372		-6701.622
D27-23		61845.338		-6700.736
D27-24		61866.255		-6687.653
D27-25		61881.540		-6721.143
D27-26		61881.635		-6726.618

測 点 名	X	座 標	Y	座 標
D27-29		61873.209		-6726.749
D27-31		61860.247		-6726.951
D27-32		61873.113		-6721.274
D27-33		61867.515		-6721.361
D27-34		61866.785		-6701.696
D27-35		61866.752		-6700.810
D27-36		61866.718		-6699.923

平成25年 2月 8日測量
平成25年 2月 7日測量
平成24年 4月 9日測量

凡 例	
	施工地区界
	道 路
	街区番号
	画地番号
D14-1	計 算 点
D14-2	境界標あり

面積（座標法）計算書

地番： 27D-1

測点名	[1] X(i)	[2] X(i+1)-X(i-1)	[3] Y(i)	[4] Y(i+1)-Y(i-1)	[2]*[3]	[1]*[4]	方向角	夾角	距離
D27-1	61882.023	-3.325	-6748.823	-25.549	22439.836475	-1581023.805627	222-00-25	131-00-21	4.997
D27-2	61878.310	-8.380	-6752.167	-2.762	56583.159460	-170907.892220	172-53-30	130-53-05	4.703
D27-18	61873.643	-5.101	-6751.585	25.418	34439.835085	1572704.257774	91-00-04	98-06-34	24.840
D27-29	61873.209	7.992	-6726.749	24.967	-53760.178008	1544788.409103	0-53-27	89-53-23	8.427
D27-26	61881.635	8.814	-6726.618	-22.074	-59288.411052	-1365975.210990	271-00-04	90-06-37	22.208
合計				倍面積	414.241960	-414.241960			65.175
				面積	207.1209800	207.1209800			
				坪数	62.65	62.65			

面積（座標法）計算書

地番：27D-3

測点名	[1] X(i)	[2] X(i+1)-X(i-1)	[3] Y(i)	[4] Y(i+1)-Y(i-1)	[2]*[3]	[1]*[4]	方向角	夾角	距離
D27-26	61881.635	-8.331	-6726.618	-5.606	56039.454558	-346908.445810	180-53-27	89-53-48	8.427
D27-29	61873.209	-8.522	-6726.749	5.344	57325.354978	330650.428896	91-00-16	90-06-49	5.476
D27-32	61873.113	8.331	-6721.274	5.606	-55994.933694	346860.671478	0-53-26	89-53-10	8.428
D27-25	61881.540	8.522	-6721.143	-5.344	-57277.580646	-330694.949760	270-59-39	90-06-13	5.476
合計				倍面積	92.295196	-92.295196			27.807
				面積	46.1475980	46.1475980			
				坪数	13.95	13.95			

面積（座標法）計算書

地番： 27D-4

測点名	[1] X(i)	[2] X(i+1)-X(i-1)	[3] Y(i)	[4] Y(i+1)-Y(i-1)	[2]*[3]	[1]*[4]	方向角	夾角	距離
D27-25	61881.540	-8.052	-6721.143	-21.571	54118.643436	-1334846.699340	180-53-26	89-53-19	8.428
D27-32	61873.113	-14.025	-6721.274	-0.218	94265.867850	-13488.338634	180-53-25	179-59-59	5.599
D27-33	61867.515	-6.328	-6721.361	19.578	42532.772408	1211242.208670	92-07-33	91-14-08	19.679
D27-34	61866.785	-0.763	-6701.696	20.551	5113.394048	1271424.298535	92-07-59	180-00-26	0.887
D27-35	61866.752	-0.067	-6700.810	1.773	448.954270	109689.751296	92-11-43	180-03-44	0.888
D27-36	61866.718	-0.497	-6699.923	13.157	3329.861731	813980.408726	92-09-40	179-57-57	12.279
D27-24	61866.255	14.447	-6687.653	0.220	-96616.522891	13610.576100	321-03-20	48-53-40	19.171
D27-12	61881.165	15.285	-6699.703	-33.490	-102404.960355	-2072400.215850	271-00-07	129-56-47	21.443
合計				倍面積	788.010497	-788.010497			88.374
				面積	394.0052485	394.0052485			
				坪数	119.18	119.18			

面積（座標法）計算書

地 番： 27D-5

測点名	[1] X(i)	[2] X(i+1)-X(i-1)	[3] Y(i)	[4] Y(i+1)-Y(i-1)	[2]*[3]	[1]*[4]	方向角	夾 角	距 離
D27-36	61866.718	-20.917	-6699.923	-13.083	140142.289391	-809402.271594	182-10-40	90-01-00	21.395
D27-23	61845.338	-22.518	-6700.736	29.089	150887.173248	1799019.037082	92-10-46	90-00-06	29.924
D27-5	61844.200	-0.662	-6670.834	30.157	4416.092108	1865035.539400	28-10-43	115-59-57	0.540
D27-17	61844.676	0.702	-6670.579	0.097	-4682.746458	5998.933572	325-02-31	116-51-48	0.276
D27-16	61844.902	2.518	-6670.737	-1.780	-16796.915766	-110083.925560	324-42-50	179-40-19	2.808
D27-15	61847.194	4.508	-6672.359	-3.340	-30078.994372	-206569.627960	322-12-53	177-30-03	2.804
D27-14	61849.410	2.911	-6674.077	-2.279	-19428.238147	-140954.805390	321-05-23	178-52-30	0.893
D27-13	61850.105	16.845	-6674.638	-13.576	-112434.277110	-839677.025480	321-08-07	180-02-44	20.742
D27-24	61866.255	16.613	-6687.653	-25.285	-111101.979289	-1564288.257675	272-09-40	131-01-33	12.279
合計				倍面積	922.403605	-922.403605			91.661
				面 積	461.2018025	461.2018025			
				坪 数	139.51	139.51			

面積（座標法）計算書

地番：27D-6

測点名	[1] X(i)	[2] X(i+1)-X(i-1)	[3] Y(i)	[4] Y(i+1)-Y(i-1)	[2]*[3]	[1]*[4]	方向角	夾角	距離
D27-35	61866.752	-21.346	-6700.810	-1.699	143035.490260	-105111.611648	182-10-30	89-58-47	21.395
D27-22	61845.372	-21.414	-6701.622	0.074	143508.533508	4576.557528	92-11-51	90-01-21	0.887
D27-23	61845.338	21.346	-6700.736	1.699	-143033.910656	105075.229262	2-10-40	89-58-49	21.395
D27-36	61866.718	21.414	-6699.923	-0.074	-143472.151122	-4578.137132	272-11-43	90-01-03	0.888
合計				倍面積	37.961990	-37.961990			44.565
				面積	18.9809950	18.9809950			
				坪数	5.74	5.74			

面積（座標法）計算書

地 番： 27D-7

測点名	[1] X(i)	[2] X(i+1)-X(i-1)	[3] Y(i)	[4] Y(i+1)-Y(i-1)	[2]*[3]	[1]*[4]	方向角	夾 角	距 離
D27-34	61866.785	-21.347	-6701.696	-1.699	143061.104512	-105111.667715	182-10-40	90-02-41	21.395
D27-21	61845.405	-21.413	-6702.509	0.074	143520.825217	4576.559970	92-07-50	89-57-10	0.888
D27-22	61845.372	21.347	-6701.622	1.699	-143059.524834	105075.287028	2-10-30	90-02-40	21.395
D27-35	61866.752	21.413	-6700.810	-0.074	-143484.444530	-4578.139648	272-07-59	89-57-29	0.887
合計				倍面積	37.960365	-37.960365			44.565
				面 積	18.9801825	18.9801825			
				坪 数	5.74	5.74			

面積（座標法）計算書

地番： 27D-8

測点名	[1] X(i)	[2] X(i+1)-X(i-1)	[3] Y(i)	[4] Y(i+1)-Y(i-1)	[2]*[3]	[1]*[4]	方向角	夾角	距離
D27-33	61867.515	-20.666	-6721.361	-20.036	138903.646426	-1239577.530540	180-59-36	88-52-03	21.399
D27-20	61846.119	-22.110	-6721.732	18.852	148617.494520	1165923.035388	92-07-38	91-08-02	19.236
D27-21	61845.405	20.666	-6702.509	20.036	-138514.050994	1239134.534580	2-10-40	90-03-02	21.395
D27-34	61866.785	22.110	-6701.696	-18.852	-148174.498560	-1166312.630820	272-07-33	89-56-53	19.679
合計				倍面積	832.591392	-832.591392			81.709
				面積	416.2956960	416.2956960			
				坪数	125.92	125.92			

面積（座標法）計算書

地番：27D-9

測点名	[1] X(i)	[2] X(i+1)-X(i-1)	[3] Y(i)	[4] Y(i+1)-Y(i-1)	[2]*[3]	[1]*[4]	方向角	夾角	距離
D27-19	61861.107	-9.882	-6750.022	-21.732	66703.717404	-1344365.577324	172-53-41	80-45-36	10.825
D27-3	61850.365	-14.120	-6748.683	5.015	95291.403960	310179.580475	132-34-51	139-41-10	4.992
D27-4	61846.987	-4.246	-6745.007	26.951	28639.299722	1666838.146637	92-08-09	139-33-18	23.291
D27-20	61846.119	20.528	-6721.732	23.646	-137983.714496	1462413.329874	0-59-36	88-51-27	21.399
D27-33	61867.515	26.994	-6721.361	0.458	-181436.418834	28335.321870	0-53-25	179-53-49	5.599
D27-32	61873.113	5.694	-6721.274	-5.388	-38270.934156	-333372.332844	271-00-16	90-06-51	5.476
D27-29	61873.209	-12.866	-6726.749	-5.677	86546.352634	-351254.207493	180-53-34	89-53-18	12.964
D27-31	61860.247	-12.102	-6726.951	-23.273	81409.561002	-1439673.528431	272-08-05	271-14-31	23.087
合計				倍面積	899.267236	-899.267236			107.633
				面積	449.6336180	449.6336180			
				坪数	136.01	136.01			

面積（座標法）計算書

地番：27D-10

測点名	[1] X(i)	[2] X(i+1)-X(i-1)	[3] Y(i)	[4] Y(i+1)-Y(i-1)	[2]*[3]	[1]*[4]	方向角	夾角	距離
D27-18	61873.643	-12.102	-6751.585	-23.273	81707.681670	-1439985.293539	172-53-35	81-53-31	12.633
D27-19	61861.107	-13.396	-6750.022	24.634	90423.294712	1523886.509838	92-08-05	99-14-30	23.087
D27-31	61860.247	12.102	-6726.951	23.273	-81409.561002	1439673.528431	0-53-34	88-45-29	12.964
D27-29	61873.209	13.396	-6726.749	-24.634	-90111.529604	-1524184.630506	271-00-04	90-06-30	24.840
合計				倍面積	609.885776	-609.885776			73.524
				面積	304.9428880	304.9428880			
				坪数	92.24	92.24			

面積（座標法）計算書

地番：27D-S

測点名	[1] X(i)	[2] X(i+1)-X(i-1)	[3] Y(i)	[4] Y(i+1)-Y(i-1)	[2]*[3]	[1]*[4]	方向角	夾角	距離
D27-10	61878.889	28.007	-6692.718	-25.252	-187442.953026	-1562565.705028	296-32-40	155-25-16	5.001
D27-11	61881.124	2.276	-6697.192	-6.985	-15242.808992	-432239.651140	270-56-08	154-23-28	2.511
D27-12	61881.165	-14.869	-6699.703	9.539	99617.883907	590284.432935	141-03-20	50-07-12	19.171
D27-24	61866.255	-31.060	-6687.653	25.065	207718.502180	1550677.681575	141-08-07	180-04-47	20.742
D27-13	61850.105	-16.845	-6674.638	13.576	112434.277110	839677.025480	141-05-23	179-57-16	0.893
D27-14	61849.410	-2.911	-6674.077	2.279	19428.238147	140954.805390	142-12-53	181-07-30	2.804
D27-15	61847.194	-4.508	-6672.359	3.340	30078.994372	206569.627960	144-42-50	182-29-57	2.808
D27-16	61844.902	-2.518	-6670.737	1.780	16796.915766	110083.925560	145-02-31	180-19-41	0.276
D27-17	61844.676	3.690	-6670.579	2.291	-24614.436510	141686.152716	28-34-36	63-32-05	4.459
D27-6	61848.592	4.732	-6668.446	1.527	-31555.086472	94442.799984	323-24-02	114-49-26	1.016
D27-7	61849.408	2.958	-6669.052	-2.252	-19727.055816	-139284.866816	322-27-35	179-03-33	2.701
D27-8	61851.550	3.709	-6670.698	-2.888	-24741.618882	-178627.276400	321-35-59	179-08-24	2.000
D27-9	61853.117	27.339	-6671.940	-22.020	-182404.167660	-1362005.636340	321-07-24	179-31-25	33.105
合計				倍面積	346.684124	-346.684124			97.487
				面積	173.3420620	173.3420620			
				坪数	52.43	52.43			