
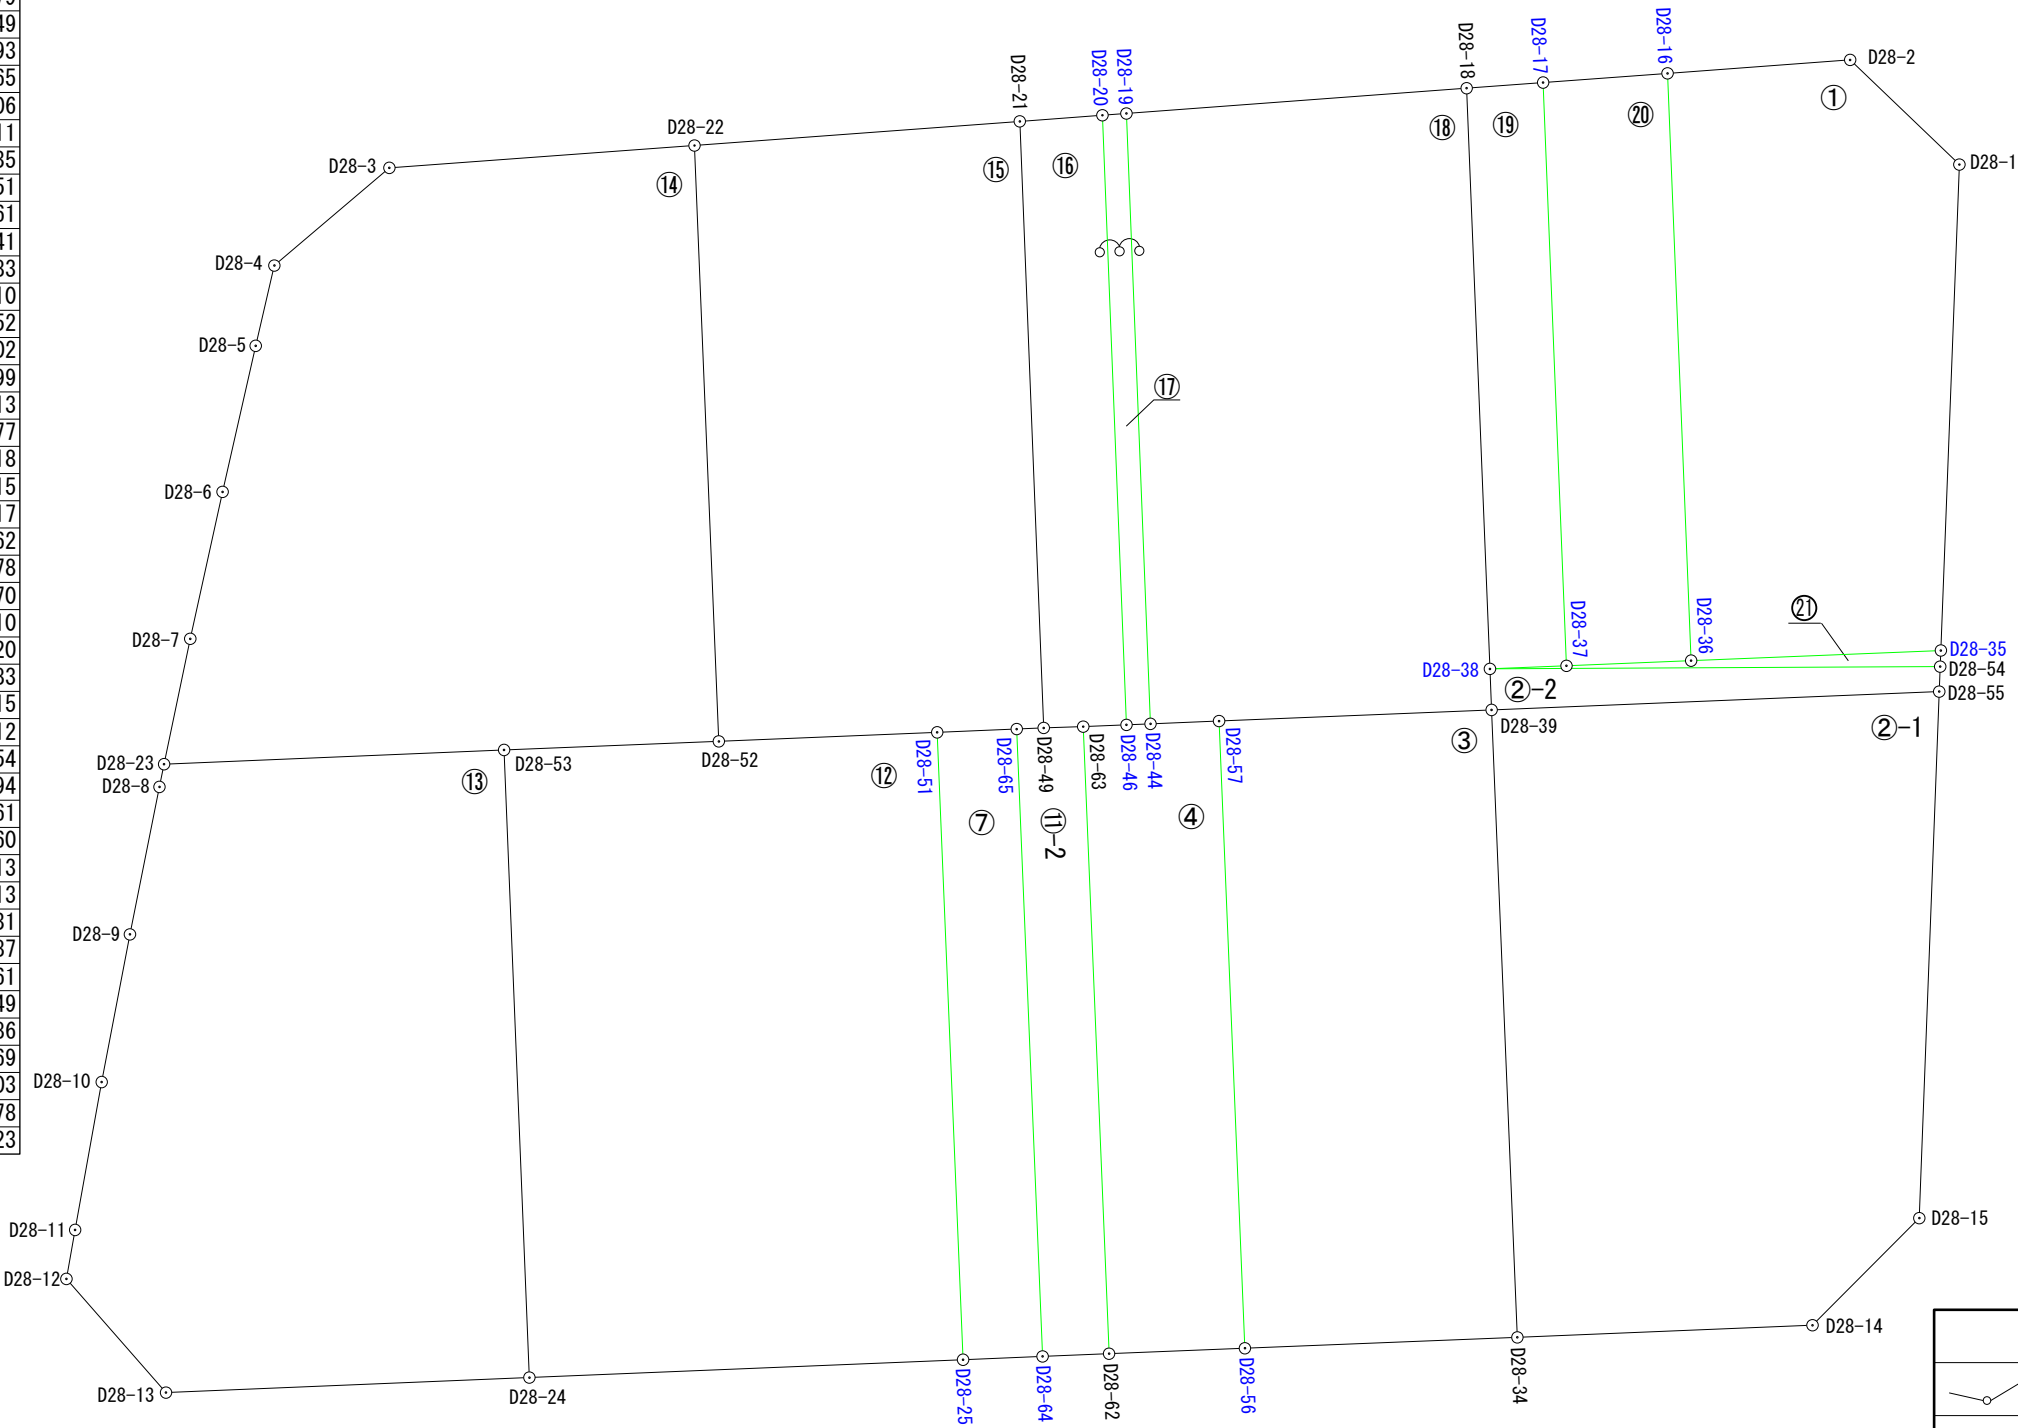


座 標 一 覧 表

測 点 名	X	座 標	Y	座 標
D28-1		61842.111		-6774.486
D28-2		61838.501		-6777.946
D28-3		61790.185		-6774.379
D28-4		61786.381		-6771.149
D28-5		61785.765		-6768.493
D28-6		61784.671		-6763.665
D28-7		61783.599		-6758.806
D28-8		61782.583		-6753.911
D28-9		61781.606		-6749.035
D28-10		61780.670		-6744.151
D28-11		61779.791		-6739.261
D28-12		61779.505		-6737.641
D28-13		61782.797		-6733.883
D28-14		61837.256		-6736.110
D28-15		61840.788		-6739.652
D28-16		61832.460		-6777.502
D28-17		61828.344		-6777.199
D28-18		61825.814		-6777.013
D28-19		61814.562		-6776.177
D28-20		61813.770		-6776.118
D28-21		61811.036		-6775.915
D28-22		61800.277		-6775.117
D28-23		61782.734		-6754.662
D28-24		61794.818		-6734.378
D28-25		61809.159		-6734.970
D28-34		61827.491		-6735.710
D28-35		61841.499		-6758.420
D28-36		61833.241		-6758.083
D28-37		61829.118		-6757.915
D28-38		61826.585		-6757.812
D28-39		61826.640		-6756.454
D28-44		61815.359		-6755.994
D28-46		61814.565		-6755.961
D28-49		61811.826		-6755.860
D28-51		61808.305		-6755.713
D28-52		61801.083		-6755.413
D28-53		61793.980		-6755.131
D28-54		61841.478		-6757.887
D28-55		61841.445		-6757.061
D28-56		61818.483		-6735.349
D28-57		61817.628		-6756.086
D28-62		61813.990		-6735.169
D28-63		61813.135		-6755.903
D28-64		61811.790		-6735.078
D28-65		61810.935		-6755.823

出来形確認測量図（縮尺1：250）

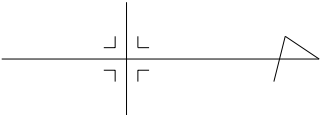

凡 例	
	施工地区界
	道 路
	街区番号
	画地番号
D14-1	計 算 点
D14-2	境界標あり

平成25年 2月 4日測量
平成24年 7月11日測量
平成24年 4月10日測量

面積（座標法）計算書

地番：28D-1

測点名	[1] X(i)	[2] X(i+1)-X(i-1)	[3] Y(i)	[4] Y(i+1)-Y(i-1)	[2]*[3]	[1]*[4]	方向角	夾角	距離
D28-16	61832.460	-5.260	-6777.502	19.863	35649.660520	1228178.152980	87-41-49	91-54-02	19.435
D28-36	61833.241	9.039	-6758.083	19.082	-61086.312237	1179901.904762	357-39-47	89-57-58	8.265
D28-35	61841.499	8.870	-6758.420	-16.403	-59947.185400	-1014386.108097	272-10-53	94-31-06	16.078
D28-1	61842.111	-2.998	-6774.486	-19.526	20309.909028	-1207529.059386	223-47-04	131-36-11	5.000
D28-2	61838.501	-9.651	-6777.946	-3.016	65413.956846	-186504.919016	175-47-47	132-00-43	6.057
合計				倍面積	340.028757	-340.028757			54.835
				面積	170.0143785	170.0143785			
				坪数	51.42	51.42			

面積（座標法）計算書

地番：28D-2-1

測点名	[1] X(i)	[2] X(i+1)-X(i-1)	[3] Y(i)	[4] Y(i+1)-Y(i-1)	[2]*[3]	[1]*[4]	方向角	夾角	距離
D28-39	61826.640	-13.954	-6756.454	21.351	94279.559116	1320060.590640	87-39-03	89-59-55	20.761
D28-34	61827.491	10.616	-6735.710	20.344	-71506.297360	1257818.476904	357-39-16	90-00-13	9.773
D28-14	61837.256	13.297	-6736.110	-3.942	-89570.054670	-243762.463152	314-55-08	137-15-52	5.002
D28-15	61840.788	4.189	-6739.652	-20.951	-28232.402228	-1295626.349388	272-09-41	137-14-33	17.421
D28-55	61841.445	-14.148	-6757.061	-16.802	95598.899028	-1039059.958890	177-39-08	85-29-27	14.817
合計				倍面積	569.703886	-569.703886			67.774
				面積	284.8519430	284.8519430			
				坪数	86.16	86.16			

面積（座標法）計算書

地番：28D-2-2

測点名	[1] X(i)	[2] X(i+1)-X(i-1)	[3] Y(i)	[4] Y(i+1)-Y(i-1)	[2]*[3]	[1]*[4]	方向角	夾角	距離
D28-38	61826.585	-14.838	-6757.812	1.433	100272.414456	88597.496305	87-40-51	87-58-10	1.359
D28-39	61826.640	14.860	-6756.454	0.751	-100400.906440	46431.806640	357-39-08	89-58-17	14.817
D28-55	61841.445	14.838	-6757.061	-1.433	-100261.271118	-88618.790685	272-17-16	94-38-08	0.827
D28-54	61841.478	-14.860	-6757.887	-0.751	100422.200820	-46442.949978	179-42-41	87-25-25	14.893
合計				倍面積	32.437718	-32.437718			31.896
				面積	16.2188590	16.2188590			
				坪数	4.90	4.90			

面積（座標法）計算書

地番： 28D-3

測点名	[1] X(i)	[2] X(i+1)-X(i-1)	[3] Y(i)	[4] Y(i+1)-Y(i-1)	[2]*[3]	[1]*[4]	方向角	夾角	距離
D28-57	61817.628	-8.157	-6756.086	21.105	55109.393502	1304661.038940	87-38-20	89-58-38	20.755
D28-56	61818.483	9.863	-6735.349	20.376	-66430.747187	1259613.409608	357-42-18	90-03-58	9.015
D28-34	61827.491	8.157	-6735.710	-21.105	-54943.186470	-1304869.197555	267-39-03	89-56-45	20.761
D28-39	61826.640	-9.863	-6756.454	-20.376	66638.905802	-1259779.616640	177-39-42	90-00-39	9.020
合計				倍面積	374.365647	-374.365647			59.551
				面積	187.1828235	187.1828235			
				坪数	56.62	56.62			

面積（座標法）計算書

地番：28D-4

測点名	[1] X(i)	[2] X(i+1)-X(i-1)	[3] Y(i)	[4] Y(i+1)-Y(i-1)	[2]*[3]	[1]*[4]	方向角	夾角	距離
D28-63	61813.135	-0.575	-6755.903	20.792	3884.644225	1285218.702920	87-38-19	89-57-40	20.752
D28-62	61813.990	5.348	-6735.169	20.554	-36019.683812	1270524.750460	357-42-21	90-04-02	4.497
D28-56	61818.483	3.638	-6735.349	-20.917	-24503.199662	-1293057.208911	267-38-20	89-55-59	20.755
D28-57	61817.628	-3.124	-6756.086	-20.645	21106.012664	-1276224.930060	177-40-41	90-02-21	2.271
D28-44	61815.359	-3.063	-6755.994	0.125	20693.609622	7726.919875	177-37-12	179-56-31	0.795
D28-46	61814.565	-2.224	-6755.961	0.091	15025.257264	5625.125415	177-40-39	180-03-27	1.431
合計				倍面積	186.640301	-186.640301			50.501
				面積	93.3201505	93.3201505			
				坪数	28.22	28.22			

面積（座標法）計算書

地番： 28D-7

測点名	[1] X(i)	[2] X(i+1)-X(i-1)	[3] Y(i)	[4] Y(i+1)-Y(i-1)	[2]*[3]	[1]*[4]	方向角	夾角	距離
D28-51	61808.305	-1.776	-6755.713	20.853	11998.146288	1288888.584165	87-38-33	90-02-15	20.761
D28-25	61809.159	3.485	-6734.970	20.635	-23471.370450	1275431.995965	357-38-58	90-00-25	2.633
D28-64	61811.790	1.776	-6735.078	-20.853	-11961.498528	-1288961.256870	267-38-24	89-59-26	20.763
D28-65	61810.935	-3.485	-6755.823	-20.635	23544.043155	-1275468.643725	177-36-18	89-57-54	2.632
合計				倍面積	109.320465	-109.320465			46.789
				面積	54.6602325	54.6602325			
				坪数	16.53	16.53			

面積（座標法）計算書

地番：28D-11-2

測点名	[1] X(i)	[2] X(i+1)-X(i-1)	[3] Y(i)	[4] Y(i+1)-Y(i-1)	[2]*[3]	[1]*[4]	方向角	夾角	距離
D28-65	61810.935	-0.036	-6755.823	20.782	243.209628	1284554.851170	87-38-24	90-01-05	20.763
D28-64	61811.790	3.055	-6735.078	20.654	-20575.663290	1276660.710660	357-37-53	89-59-29	2.202
D28-62	61813.990	1.345	-6735.169	-20.825	-9058.802305	-1287276.341750	267-38-19	90-00-26	20.752
D28-63	61813.135	-2.164	-6755.903	-20.691	14619.774092	-1278975.576285	178-07-07	90-28-48	1.310
D28-49	61811.826	-2.200	-6755.860	0.080	14862.892000	4944.946080	177-37-19	179-30-12	0.892
合計				倍面積	91.410125	-91.410125			45.919
				面積	45.7050625	45.7050625			
				坪数	13.82	13.82			

面積（座標法）計算書

地番：28D-12

測点名	[1] X(i)	[2] X(i+1)-X(i-1)	[3] Y(i)	[4] Y(i+1)-Y(i-1)	[2]*[3]	[1]*[4]	方向角	夾角	距離
D28-53	61793.980	-6.265	-6755.131	21.035	42320.895715	1299836.369300	87-41-16	89-57-41	20.770
D28-24	61794.818	15.179	-6734.378	20.161	-102221.123662	1245845.325698	357-38-10	89-56-54	14.353
D28-25	61809.159	13.487	-6734.970	-21.335	-90834.540390	-1318698.407265	267-38-33	90-00-23	20.761
D28-51	61808.305	-8.076	-6755.713	-20.443	54559.138188	-1263547.179115	177-37-17	89-58-44	7.228
D28-52	61801.083	-14.325	-6755.413	0.582	96771.291225	35968.230306	177-43-35	180-06-18	7.109
合計				倍面積	595.661076	-595.661076			70.221
				面積	297.8305380	297.8305380			
				坪数	90.09	90.09			

面積（座標法）計算書

地番：28D-13

測点名	[1] X(i)	[2] X(i+1)-X(i-1)	[3] Y(i)	[4] Y(i+1)-Y(i-1)	[2]*[3]	[1]*[4]	方向角	夾角	距離
D28-23	61782.734	-11.397	-6754.662	1.220	76982.882814	75374.935480	101-22-07	103-45-24	0.766
D28-8	61782.583	-1.128	-6753.911	5.627	7618.411608	347650.594541	101-19-49	179-57-42	4.973
D28-9	61781.606	-1.913	-6749.035	9.760	12910.903955	602988.474560	100-50-56	179-31-07	4.973
D28-10	61780.670	-1.815	-6744.151	9.774	12240.634065	603844.268580	100-11-25	179-20-29	4.968
D28-11	61779.791	-1.165	-6739.261	6.510	7851.239065	402186.439410	100-00-43	179-49-18	1.645
D28-12	61779.505	3.006	-6737.641	5.378	-20253.348846	332250.177890	48-46-54	128-46-11	4.996
D28-13	61782.797	15.313	-6733.883	3.263	-103115.950379	201597.266611	357-38-31	128-51-37	12.031
D28-24	61794.818	11.183	-6734.378	-21.248	-75310.549174	-1313016.292864	267-41-16	90-02-45	20.770
D28-53	61793.980	-12.084	-6755.131	-20.284	81629.003004	-1253429.090320	177-36-43	89-55-27	11.256
合計				倍面積	553.226112	-553.226112			66.378
				面積	276.6130560	276.6130560			
				坪数	83.67	83.67			

面積（座標法）計算書

地番：28D-14

測点名	[1] X(i)	[2] X(i+1)-X(i-1)	[3] Y(i)	[4] Y(i+1)-Y(i-1)	[2]*[3]	[1]*[4]	方向角	夾角	距離
D28-3	61790.185	-13.896	-6774.379	3.968	94136.770584	245183.454080	139-39-55	143-50-52	4.990
D28-4	61786.381	-4.420	-6771.149	5.886	29928.478580	363674.638566	103-03-27	143-23-32	2.726
D28-5	61785.765	-1.710	-6768.493	7.484	11574.123030	462404.665260	102-46-02	179-42-35	4.950
D28-6	61784.671	-2.166	-6763.665	9.687	14650.098390	598508.107977	102-26-29	179-40-27	4.976
D28-7	61783.599	-1.937	-6758.806	9.003	13091.807222	556237.741797	101-47-25	179-20-56	4.233
D28-23	61782.734	10.381	-6754.662	3.675	-70120.146222	227051.547450	357-36-43	75-49-18	11.256
D28-53	61793.980	18.349	-6755.131	-0.751	-123949.898719	-46407.278980	357-43-35	180-06-52	7.109
D28-52	61801.083	6.297	-6755.413	-19.986	-42538.835661	-1235156.444838	267-39-27	89-55-52	19.720
D28-22	61800.277	-10.898	-6775.117	-18.966	73835.225066	-1172104.053582	175-49-03	88-09-36	10.119
合計				倍面積	607.622270	-607.622270			70.079
				面積	303.8111350	303.8111350			
				坪数	91.90	91.90			

面積（座標法）計算書

地番：28D-15

測点名	[1] X(i)	[2] X(i+1)-X(i-1)	[3] Y(i)	[4] Y(i+1)-Y(i-1)	[2]*[3]	[1]*[4]	方向角	夾角	距離
D28-22	61800.277	-9.953	-6775.117	20.502	67432.739501	1267029.279054	87-39-27	91-53-58	19.720
D28-52	61801.083	8.028	-6755.413	19.404	-54232.455564	1199188.214532	357-37-17	89-57-50	7.228
D28-51	61808.305	9.852	-6755.713	-0.410	-66557.284476	-25341.405050	357-36-18	179-59-01	2.632
D28-65	61810.935	3.521	-6755.823	-0.147	-23787.252783	-9086.207445	357-37-19	180-01-01	0.892
D28-49	61811.826	0.101	-6755.860	-20.092	-682.341860	-1241923.207992	267-44-39	90-07-20	20.071
D28-21	61811.036	-11.549	-6775.915	-19.257	78255.042335	-1190295.120252	175-45-29	88-00-50	10.789
合計				倍面積	428.447153	-428.447153			61.332
				面積	214.2235765	214.2235765			
				坪数	64.80	64.80			

面積（座標法）計算書

地番：28D-16

測点名	[1] X(i)	[2] X(i+1)-X(i-1)	[3] Y(i)	[4] Y(i+1)-Y(i-1)	[2]*[3]	[1]*[4]	方向角	夾角	距離
D28-21	61811.036	-1.944	-6775.915	20.258	13172.378760	1252167.967288	87-44-39	91-59-26	20.071
D28-49	61811.826	2.099	-6755.860	20.012	-14180.550140	1236978.261912	358-07-07	90-22-28	1.310
D28-63	61813.135	2.739	-6755.903	-0.101	-18504.418317	-6243.126635	357-40-39	179-33-32	1.431
D28-46	61814.565	0.635	-6755.961	-20.215	-4290.035235	-1249581.431475	267-44-29	90-03-50	20.173
D28-20	61813.770	-3.529	-6776.118	-19.954	23912.920422	-1233431.966580	175-45-13	88-00-44	2.742
合計				倍面積	110.295490	-110.295490			45.727
				面積	55.1477450	55.1477450			
				坪数	16.68	16.68			

面積（座標法）計算書

地番：28D-17

測点名	[1] X(i)	[2] X(i+1)-X(i-1)	[3] Y(i)	[4] Y(i+1)-Y(i-1)	[2]*[3]	[1]*[4]	方向角	夾角	距離
D28-20	61813.770	0.003	-6776.118	20.216	-20.328354	1249627.174320	87-44-29	92-00-06	20.173
D28-46	61814.565	1.589	-6755.961	20.124	-10735.222029	1243956.306060	357-37-12	89-52-43	0.795
D28-44	61815.359	-0.003	-6755.994	-20.216	20.267982	-1249659.297544	267-44-19	90-07-07	20.199
D28-19	61814.562	-1.589	-6776.177	-20.124	10767.345253	-1243956.245688	175-44-23	88-00-04	0.794
合計				倍面積	32.062852	-32.062852			41.961
				面積	16.0314260	16.0314260			
				坪数	4.84	4.84			

面積（座標法）計算書

地番：28D-18

測点名	[1] X(i)	[2] X(i+1)-X(i-1)	[3] Y(i)	[4] Y(i+1)-Y(i-1)	[2]*[3]	[1]*[4]	方向角	夾角	距離
D28-19	61814.562	-10.455	-6776.177	21.019	70844.930535	1299280.278678	87-44-19	91-59-16	20.199
D28-44	61815.359	3.066	-6755.994	20.091	-20713.877604	1241932.377669	357-40-41	89-56-22	2.271
D28-57	61817.628	11.281	-6756.086	-0.460	-76215.406166	-28436.108880	357-39-42	179-59-01	9.020
D28-39	61826.640	8.957	-6756.454	-1.726	-60517.558478	-106712.780640	267-40-51	90-01-09	1.359
D28-38	61826.585	-0.826	-6757.812	-20.559	5581.952712	-1271092.761015	267-42-02	180-01-11	19.216
D28-18	61825.814	-12.023	-6777.013	-18.365	81480.027299	-1135431.074110	175-45-03	88-03-01	11.283
合計				倍面積	460.068298	-460.068298			63.348
				面積	230.0341490	230.0341490			
				坪数	69.58	69.58			

面積（座標法）計算書

地番：28D-19

測点名	[1] X(i)	[2] X(i+1)-X(i-1)	[3] Y(i)	[4] Y(i+1)-Y(i-1)	[2]*[3]	[1]*[4]	方向角	夾角	距離
D28-18	61825.814	-1.759	-6777.013	19.387	11920.765867	1198617.056018	87-42-02	91-54-19	19.216
D28-38	61826.585	3.304	-6757.812	19.098	-22327.810848	1180764.120330	357-40-17	89-58-15	2.535
D28-37	61829.118	1.759	-6757.915	-19.387	-11887.172485	-1198681.110666	267-42-06	90-01-49	19.300
D28-17	61828.344	-3.304	-6777.199	-19.098	22391.865496	-1180797.713712	175-47-43	88-05-37	2.537
合計				倍面積	97.648030	-97.648030			43.588
				面積	48.8240150	48.8240150			
				坪数	14.76	14.76			

面積（座標法）計算書

地番：28D-20

測点名	[1] X(i)	[2] X(i+1)-X(i-1)	[3] Y(i)	[4] Y(i+1)-Y(i-1)	[2]*[3]	[1]*[4]	方向角	夾角	距離
D28-17	61828.344	-3.342	-6777.199	19.587	22649.399058	1211031.773928	87-42-06	91-54-43	19.300
D28-37	61829.118	4.897	-6757.915	19.116	-33093.509755	1181925.419688	357-40-00	89-57-54	4.126
D28-36	61833.241	3.342	-6758.083	-19.587	-22585.513386	-1211127.691467	267-41-49	90-01-49	19.435
D28-16	61832.460	-4.897	-6777.502	-19.116	33189.427294	-1181989.305360	175-47-23	88-05-34	4.127
合計				倍面積	159.803211	-159.803211			46.988
				面積	79.9016055	79.9016055			
				坪数	24.17	24.17			

面積（座標法）計算書

地番：28D-21

測点名	[1] X(i)	[2] X(i+1)-X(i-1)	[3] Y(i)	[4] Y(i+1)-Y(i-1)	[2]*[3]	[1]*[4]	方向角	夾角	距離
D28-38	61826.585	12.360	-6757.812	0.028	-83526.556320	1731.144380	359-42-41	2-02-24	14.893
D28-54	61841.478	14.914	-6757.887	-0.608	-100787.126718	-37599.618624	272-15-23	92-32-42	0.533
D28-35	61841.499	-8.237	-6758.420	-0.196	55669.105540	-12120.933804	177-39-47	85-24-24	8.265
D28-36	61833.241	-12.381	-6758.083	0.505	83671.825623	31225.786705	177-40-00	180-00-13	4.126
D28-37	61829.118	-6.656	-6757.915	0.271	44980.682240	16755.690978	177-40-17	180-00-17	2.535
合計				倍面積	7.930365	-7.930365			30.352
				面積	3.9651825	3.9651825			
				坪数	1.19	1.19			