
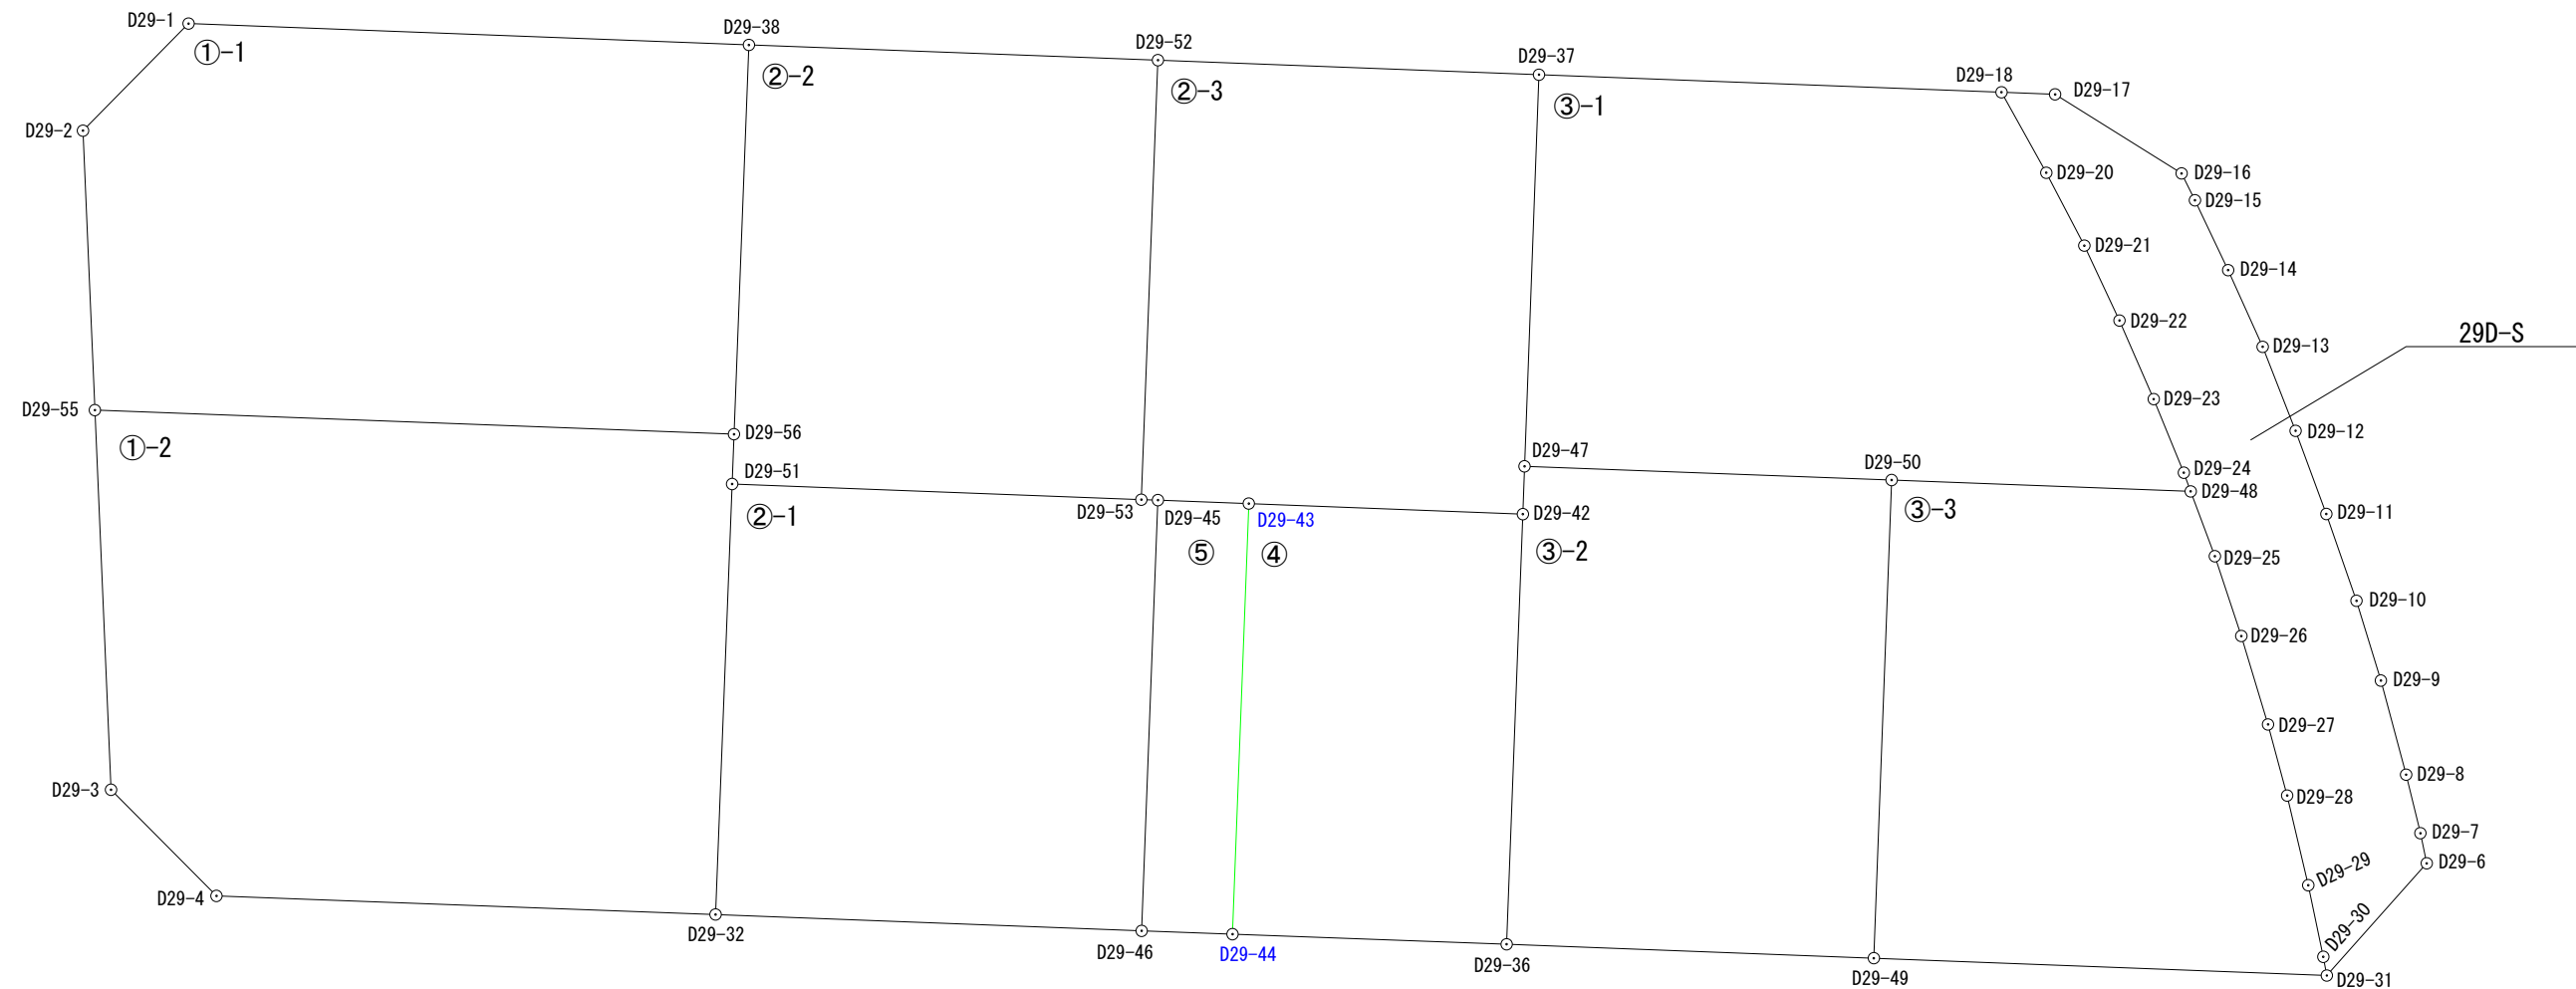


出来形確認測量図（縮尺１：２５０）

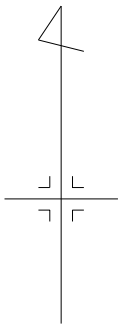

座 標 一 覧 表

測 点 名	X 座 標	Y 座 標
D29-1	61840.304	-6726.565
D29-2	61836.748	-6730.070
D29-3	61814.869	-6729.140
D29-4	61811.344	-6725.637
D29-6	61812.426	-6652.253
D29-7	61813.425	-6652.463
D29-8	61815.369	-6652.938
D29-9	61818.493	-6653.776
D29-10	61821.142	-6654.585
D29-11	61824.023	-6655.588
D29-12	61826.783	-6656.608
D29-13	61829.575	-6657.700
D29-14	61832.118	-6658.848
D29-15	61834.440	-6659.949
D29-16	61835.329	-6660.394
D29-17	61837.953	-6664.592
D29-18	61838.023	-6666.373
D29-20	61835.350	-6664.886

測 点 名	X 座 標	Y 座 標
D29-21	61832.932	-6663.622
D29-22	61830.446	-6662.455
D29-23	61827.837	-6661.318
D29-24	61825.394	-6660.318
D29-25	61822.621	-6659.288
D29-26	61819.970	-6658.409
D29-27	61817.037	-6657.523
D29-28	61814.676	-6656.889
D29-29	61811.700	-6656.189
D29-30	61809.323	-6655.689
D29-31	61808.701	-6655.569
D29-32	61810.726	-6709.067
D29-36	61809.740	-6682.803
D29-37	61838.607	-6681.727
D29-38	61839.595	-6707.959
D29-42	61824.019	-6682.262
D29-43	61824.368	-6691.364
D29-44	61810.073	-6691.903

測 点 名	X 座 標	Y 座 標
D29-45	61824.484	-6694.381
D29-46	61810.183	-6694.919
D29-47	61825.607	-6682.209
D29-48	61824.774	-6660.092
D29-49	61809.277	-6670.610
D29-50	61825.151	-6670.020
D29-51	61825.018	-6708.518
D29-52	61839.088	-6694.380
D29-53	61824.497	-6694.930
D29-55	61827.471	-6729.676
D29-56	61826.672	-6708.455

平成26年 1月10日測量
平成25年 3月 2日測量
平成25年 2月 8日測量
平成24年 7月11日測量
平成24年 4月12日測量
平成24年 4月10日測量

凡 例	
	施工地区界
	道 路
	街区番号
	画地番号
D14-1	計 算 点
D14-2	境界標あり

面積（座標法）計算書

地番：29D-1-1

測点名	[1] X(i)	[2] X(i+1)-X(i-1)	[3] Y(i)	[4] Y(i+1)-Y(i-1)	[2]*[3]	[1]*[4]	方向角	夾角	距離
D29-1	61840.304	-2.847	-6726.565	-22.111	19150.530555	-1367350.961744	224-35-10	132-24-14	4.993
D29-2	61836.748	-12.833	-6730.070	-3.111	86366.988310	-192374.123028	177-34-05	132-58-55	9.285
D29-55	61827.471	-10.076	-6729.676	21.615	67808.215376	1336400.785665	92-09-22	94-35-17	21.236
D29-56	61826.672	12.124	-6708.455	21.717	-81333.308420	1342689.835824	2-11-53	90-02-31	12.933
D29-38	61839.595	13.632	-6707.959	-18.110	-91442.897088	-1119915.065450	272-10-56	89-59-03	18.620
合計				倍面積	549.528733	-549.528733			67.067
				面積	274.7643665	274.7643665			
				坪数	83.11	83.11			

面積（座標法）計算書

地番：29D-1-2

測点名	[1] X(i)	[2] X(i+1)-X(i-1)	[3] Y(i)	[4] Y(i+1)-Y(i-1)	[2]*[3]	[1]*[4]	方向角	夾角	距離
D29-55	61827.471	-11.803	-6729.676	-20.685	79430.365828	-1278901.237635	177-33-52	85-24-30	12.613
D29-3	61814.869	-16.127	-6729.140	4.039	108520.840780	249670.255891	135-10-46	137-36-54	4.970
D29-4	61811.344	-4.143	-6725.637	20.073	27864.314091	1240739.108112	92-08-09	136-57-23	16.582
D29-32	61810.726	13.674	-6709.067	17.119	-91739.782158	1058137.818394	2-11-59	90-03-50	14.303
D29-51	61825.018	15.946	-6708.518	0.612	-106974.028028	37836.911016	2-10-53	179-58-54	1.655
D29-56	61826.672	2.453	-6708.455	-21.158	-16455.840115	-1308128.726176	272-09-22	89-58-29	21.236
合計				倍面積	645.870398	-645.870398			71.359
				面積	322.9351990	322.9351990			
				坪数	97.68	97.68			

面積（座標法）計算書

地番：29D-2-1

測点名	[1] X(i)	[2] X(i+1)-X(i-1)	[3] Y(i)	[4] Y(i+1)-Y(i-1)	[2]*[3]	[1]*[4]	方向角	夾角	距離
D29-51	61825.018	-13.771	-6708.518	-14.137	92383.001378	-874020.279466	182-11-59	90-00-14	14.303
D29-32	61810.726	-14.835	-6709.067	13.599	99529.008945	840564.062874	92-11-53	89-59-54	14.158
D29-46	61810.183	13.758	-6694.919	14.686	-92108.695602	907744.347538	2-09-16	89-57-23	14.311
D29-45	61824.484	14.314	-6694.381	-0.011	-95823.369634	-680.069324	271-21-23	89-12-07	0.549
D29-53	61824.497	0.534	-6694.930	-14.137	-3575.092620	-874012.914089	272-11-45	180-50-22	13.598
合計				倍面積	404.852467	-404.852467			56.919
				面積	202.4262335	202.4262335			
				坪数	61.23	61.23			

面積（座標法）計算書

地番：29D-2-2

測点名	[1] X(i)	[2] X(i+1)-X(i-1)	[3] Y(i)	[4] Y(i+1)-Y(i-1)	[2]*[3]	[1]*[4]	方向角	夾角	距離
D29-38	61839.595	-12.416	-6707.959	-14.075	83286.018944	-870392.299625	182-11-53	90-03-35	12.933
D29-56	61826.672	-14.577	-6708.455	-0.559	97789.148535	-34561.109648	182-10-53	179-59-00	1.655
D29-51	61825.018	-2.175	-6708.518	13.525	14591.026650	836183.368450	92-11-45	90-00-52	13.598
D29-53	61824.497	14.070	-6694.930	14.138	-94197.665100	874074.738586	2-09-31	89-57-46	14.601
D29-52	61839.088	15.098	-6694.380	-13.029	-101071.749240	-805701.477552	272-08-18	89-58-47	13.588
合計				倍面積	396.779789	-396.779789			56.375
				面積	198.3898945	198.3898945			
				坪数	60.01	60.01			

面積（座標法）計算書

地番：29D-2-3

測点名	[1] X(i)	[2] X(i+1)-X(i-1)	[3] Y(i)	[4] Y(i+1)-Y(i-1)	[2]*[3]	[1]*[4]	方向角	夾角	距離
D29-52	61839.088	-14.110	-6694.380	-13.203	94457.701800	-816461.478864	182-09-31	89-58-54	14.601
D29-53	61824.497	-14.604	-6694.930	-0.001	97772.757720	-61.824497	91-21-23	89-11-52	0.549
D29-45	61824.484	-0.129	-6694.381	3.566	863.575149	220466.109944	92-12-07	180-50-44	3.019
D29-43	61824.368	-0.465	-6691.364	12.119	3111.484260	749249.515792	92-11-45	179-59-38	9.109
D29-42	61824.019	1.239	-6682.262	9.155	-8279.322618	565998.893945	1-54-42	89-42-57	1.589
D29-47	61825.607	14.588	-6682.209	0.535	-97480.064892	33076.699745	2-07-24	180-12-42	13.009
D29-37	61838.607	13.481	-6681.727	-12.171	-90076.361687	-752637.685797	272-10-37	90-03-13	12.662
合計				倍面積	369.769732	-369.769732			54.538
				面積	184.8848660	184.8848660			
				坪数	55.92	55.92			

面積（座標法）計算書

地番：29D-3-1

測点名	[1] X(i)	[2] X(i+1)-X(i-1)	[3] Y(i)	[4] Y(i+1)-Y(i-1)	[2]*[3]	[1]*[4]	方向角	夾角	距離
D29-37	61838.607	-12.416	-6681.727	-15.836	82960.322432	-979276.180452	182-07-24	89-56-42	13.009
D29-47	61825.607	-13.456	-6682.209	11.707	89915.804304	723792.381149	92-08-33	90-01-09	12.198
D29-50	61825.151	-0.833	-6670.020	22.117	5556.126660	1367386.864667	92-10-29	180-01-56	9.935
D29-48	61824.774	0.243	-6660.092	9.702	-1618.402356	599823.957348	339-58-21	67-47-52	0.660
D29-24	61825.394	3.063	-6660.318	-1.226	-20400.554034	-75797.933044	337-44-21	177-46-00	2.640
D29-23	61827.837	5.052	-6661.318	-2.137	-33652.978536	-132126.087669	336-27-09	178-42-48	2.846
D29-22	61830.446	5.095	-6662.455	-2.304	-33945.208225	-142457.347584	334-51-12	178-24-03	2.746
D29-21	61832.932	4.904	-6663.622	-2.431	-32678.402288	-150315.857692	332-24-07	177-32-55	2.728
D29-20	61835.350	5.091	-6664.886	-2.751	-33930.934626	-170109.047850	330-54-46	178-30-39	3.059
D29-18	61838.023	3.257	-6666.373	-16.841	-21712.376861	-1041414.145343	272-10-42	121-15-56	15.365
合計				倍面積	493.396470	-493.396470			65.186
				面積	246.6982350	246.6982350			
				坪数	74.62	74.62			

面積（座標法）計算書

地番：29D-3-2

測点名	[1] X(i)	[2] X(i+1)-X(i-1)	[3] Y(i)	[4] Y(i+1)-Y(i-1)	[2]*[3]	[1]*[4]	方向角	夾角	距離
D29-47	61825.607	-1.132	-6682.209	-12.242	7564.260588	-756869.080894	181-54-42	89-46-09	1.589
D29-42	61824.019	-15.867	-6682.262	-0.594	106027.451154	-36723.467286	182-10-11	180-15-29	14.289
D29-36	61809.740	-14.742	-6682.803	11.652	98517.881826	720207.090480	92-10-29	90-00-18	12.202
D29-49	61809.277	15.411	-6670.610	12.783	-102800.770710	790107.987891	2-07-43	89-57-14	15.885
D29-50	61825.151	16.330	-6670.020	-11.599	-108921.426600	-717109.926449	272-08-33	90-00-50	12.198
合計				倍面積	387.396258	-387.396258			56.163
				面積	193.6981290	193.6981290			
				坪数	58.59	58.59			

面積（座標法）計算書

地番：29D-3-3

測点名	[1] X(i)	[2] X(i+1)-X(i-1)	[3] Y(i)	[4] Y(i+1)-Y(i-1)	[2]*[3]	[1]*[4]	方向角	夾角	距離
D29-50	61825.151	-15.497	-6670.020	-10.518	103365.299940	-650276.938218	182-07-43	89-57-14	15.885
D29-49	61809.277	-16.450	-6670.610	14.451	109731.534500	893205.861927	92-11-35	90-03-52	15.052
D29-31	61808.701	0.046	-6655.569	14.921	-306.156174	922247.627621	349-04-49	76-53-14	0.633
D29-30	61809.323	2.999	-6655.689	-0.620	-19960.411311	-38321.780260	348-07-16	179-02-27	2.429
D29-29	61811.700	5.353	-6656.189	-1.200	-35630.579717	-74174.040000	346-45-50	178-38-34	3.057
D29-28	61814.676	5.337	-6656.889	-1.334	-35527.816593	-82460.777784	344-58-08	178-12-18	2.445
D29-27	61817.037	5.294	-6657.523	-1.520	-35244.926762	-93961.896240	343-11-29	178-13-21	3.064
D29-26	61819.970	5.584	-6658.409	-1.765	-37180.555856	-109112.247050	341-39-21	178-27-52	2.793
D29-25	61822.621	4.804	-6659.288	-1.683	-31991.219552	-104047.471143	339-31-22	177-52-01	2.298
D29-48	61824.774	2.530	-6660.092	-10.732	-16850.032760	-663503.474568	272-10-29	112-39-07	9.935
合計				倍面積	405.135715	-405.135715			57.591
				面積	202.5678575	202.5678575			
				坪数	61.27	61.27			

面積（座標法）計算書

地番： 29D-4

測点名	[1] X(i)	[2] X(i+1)-X(i-1)	[3] Y(i)	[4] Y(i+1)-Y(i-1)	[2]*[3]	[1]*[4]	方向角	夾角	距離
D29-43	61824.368	-13.946	-6691.364	-9.641	93317.762344	-596048.731888	182-09-34	89-57-49	14.305
D29-44	61810.073	-14.628	-6691.903	8.561	97889.157084	529156.034953	92-05-45	89-56-11	9.106
D29-36	61809.740	13.946	-6682.803	9.641	-93198.370638	595907.703340	2-10-11	90-04-26	14.289
D29-42	61824.019	14.628	-6682.262	-8.561	-97748.128536	-529275.426659	272-11-45	90-01-34	9.109
合計				倍面積	260.420254	-260.420254			46.809
				面積	130.2101270	130.2101270			
				坪数	39.38	39.38			

面積（座標法）計算書

地番：29D-5

測点名	[1] X(i)	[2] X(i+1)-X(i-1)	[3] Y(i)	[4] Y(i+1)-Y(i-1)	[2]*[3]	[1]*[4]	方向角	夾角	距離
D29-45	61824.484	-14.185	-6694.381	-3.555	94959.794485	-219786.040620	182-09-16	89-57-09	14.311
D29-46	61810.183	-14.411	-6694.919	2.478	96480.477709	153165.633474	92-05-20	89-56-04	3.018
D29-44	61810.073	14.185	-6691.903	3.555	-94924.644055	219734.809515	2-09-34	90-04-14	14.305
D29-43	61824.368	14.411	-6691.364	-2.478	-96429.246604	-153200.783904	272-12-07	90-02-33	3.019
合計				倍面積	86.381535	-86.381535			34.653
				面積	43.1907675	43.1907675			
				坪数	13.06	13.06			

面積（座標法）計算書

地番：29D-S

測点名	[1] X(i)	[2] X(i+1)-X(i-1)	[3] Y(i)	[4] Y(i+1)-Y(i-1)	[2]*[3]	[1]*[4]	方向角	夾角	距離
D29-18	61838.023	-2.603	-6666.373	-0.294	17352.568919	-18180.378762	150-54-46	58-39-43	3.059
D29-20	61835.350	-5.091	-6664.886	2.751	33930.934626	170109.047850	152-24-07	181-29-21	2.728
D29-21	61832.932	-4.904	-6663.622	2.431	32678.402288	150315.857692	154-51-12	182-27-05	2.746
D29-22	61830.446	-5.095	-6662.455	2.304	33945.208225	142457.347584	156-27-09	181-35-57	2.846
D29-23	61827.837	-5.052	-6661.318	2.137	33652.978536	132126.087669	157-44-21	181-17-12	2.640
D29-24	61825.394	-3.063	-6660.318	1.226	20400.554034	75797.933044	159-58-21	182-14-00	0.660
D29-48	61824.774	-2.773	-6660.092	1.030	18468.435116	63679.517220	159-31-22	179-33-01	2.298
D29-25	61822.621	-4.804	-6659.288	1.683	31991.219552	104047.471143	161-39-21	182-07-59	2.793
D29-26	61819.970	-5.584	-6658.409	1.765	37180.555856	109112.247050	163-11-29	181-32-08	3.064
D29-27	61817.037	-5.294	-6657.523	1.520	35244.926762	93961.896240	164-58-08	181-46-39	2.445
D29-28	61814.676	-5.337	-6656.889	1.334	35527.816593	82460.777784	166-45-50	181-47-42	3.057
D29-29	61811.700	-5.353	-6656.189	1.200	35630.579717	74174.040000	168-07-16	181-21-26	2.429
D29-30	61809.323	-2.999	-6655.689	0.620	19960.411311	38321.780260	169-04-49	180-57-33	0.633
D29-31	61808.701	3.103	-6655.569	3.436	-20652.230607	212374.696636	41-40-32	52-35-43	4.987
D29-6	61812.426	4.724	-6652.253	3.106	-31425.243172	191989.395156	348-07-43	126-27-11	1.021
D29-7	61813.425	2.943	-6652.463	-0.685	-19578.198609	-42342.196125	346-16-09	178-08-26	2.001
D29-8	61815.369	5.068	-6652.938	-1.313	-33717.089784	-81163.579497	344-59-03	178-42-54	3.234
D29-9	61818.493	5.773	-6653.776	-1.647	-38412.248848	-101815.057971	343-01-03	178-02-00	2.770
D29-10	61821.142	5.530	-6654.585	-1.812	-36799.855050	-112019.909304	340-48-17	177-47-14	3.051
D29-11	61824.023	5.641	-6655.588	-2.023	-37544.171908	-125069.998529	339-43-03	178-54-46	2.942
D29-12	61826.783	5.552	-6656.608	-2.112	-36957.487616	-130578.165696	338-38-19	178-55-16	2.998
D29-13	61829.575	5.335	-6657.700	-2.240	-35518.829500	-138498.248000	335-42-14	177-03-55	2.790
D29-14	61832.118	4.865	-6658.848	-2.249	-32395.295520	-139060.433382	334-37-54	178-55-40	2.570
D29-15	61834.440	3.211	-6659.949	-1.546	-21385.096239	-95596.044240	333-24-33	178-46-39	0.994
D29-16	61835.329	3.513	-6660.394	-4.643	-23397.964122	-287101.432547	302-00-28	148-35-55	4.951
D29-17	61837.953	2.694	-6664.592	-5.979	-17954.410848	-369729.120987	272-15-03	150-14-35	1.782
合計				倍面積	226.469712	-226.469712			67.489
				面積	113.2348560	113.2348560			
				坪数	34.25	34.25			