
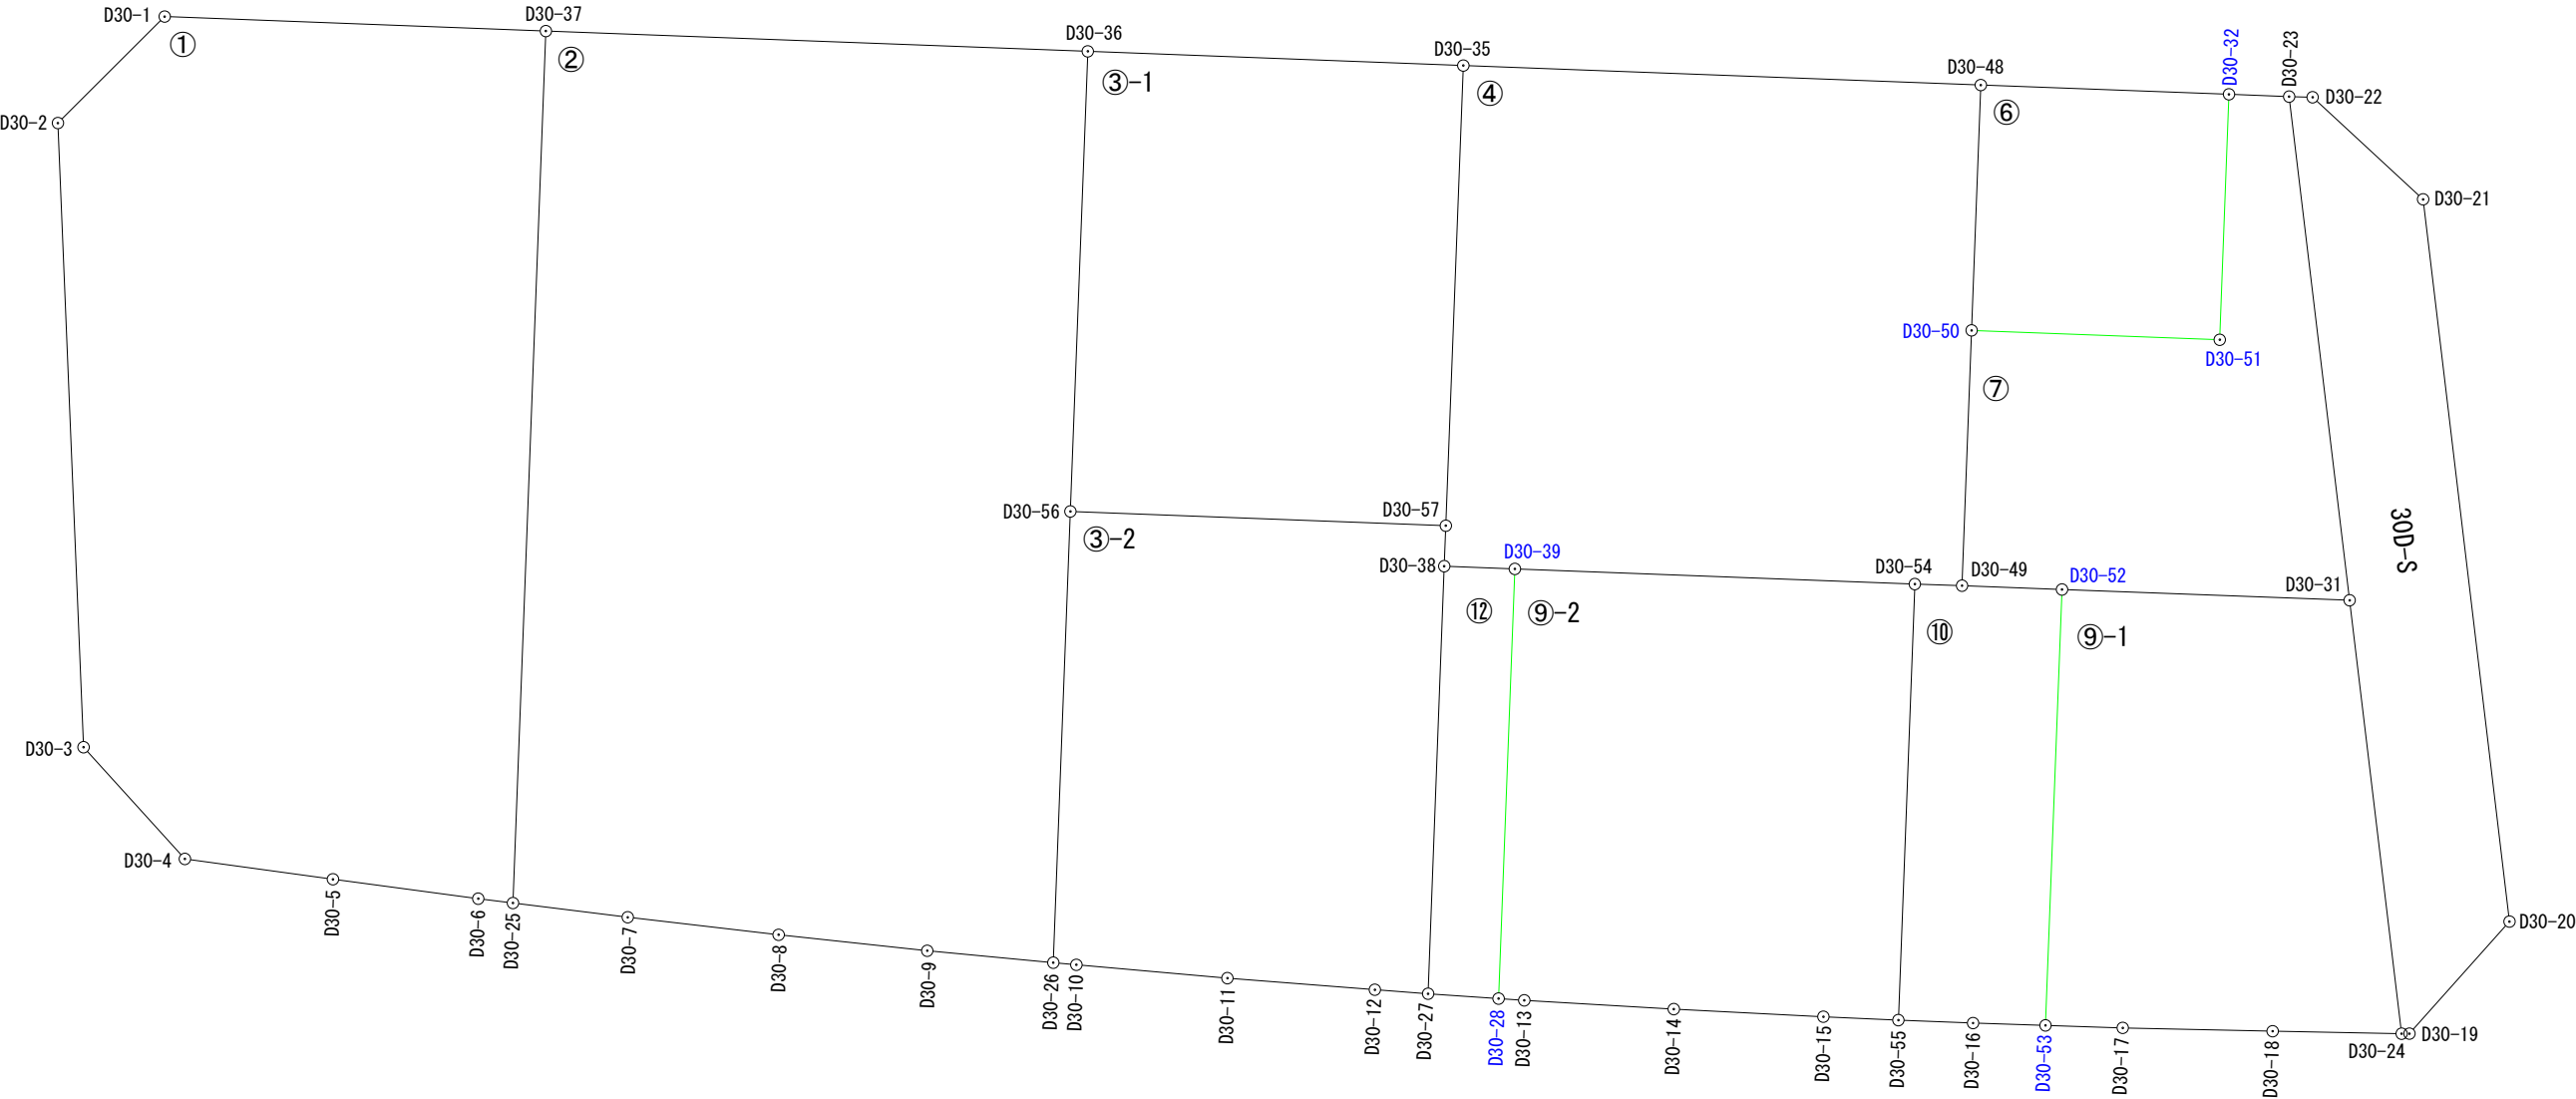


出来形確認測量図（縮尺１：２５０）

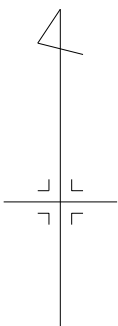

座 標 一 覧 表

測 点 名	X 座 標	Y 座 標
D30-1	61805.317	-6725.107
D30-2	61801.789	-6728.649
D30-3	61781.096	-6727.797
D30-4	61777.391	-6724.439
D30-5	61776.715	-6719.528
D30-6	61776.074	-6714.708
D30-7	61775.454	-6709.749
D30-8	61774.876	-6704.747
D30-9	61774.346	-6699.818
D30-10	61773.881	-6694.874
D30-11	61773.438	-6689.863
D30-12	61773.052	-6684.973
D30-13	61772.703	-6680.017
D30-14	61772.410	-6675.061
D30-15	61772.157	-6670.097
D30-16	61771.947	-6665.136

測 点 名	X 座 標	Y 座 標
D30-17	61771.787	-6660.169
D30-18	61771.678	-6655.201
D30-19	61771.597	-6650.662
D30-20	61775.313	-6647.346
D30-21	61799.257	-6650.211
D30-22	61802.644	-6653.872
D30-23	61802.666	-6654.652
D30-24	61771.595	-6650.924
D30-25	61775.927	-6713.559
D30-26	61773.950	-6695.637
D30-27	61772.921	-6683.207
D30-28	61772.761	-6680.870
D30-31	61785.964	-6652.646
D30-32	61802.740	-6656.647
D30-35	61803.695	-6682.039
D30-36	61804.165	-6694.493

測 点 名	X 座 標	Y 座 標
D30-37	61804.838	-6712.465
D30-38	61787.094	-6682.672
D30-39	61787.006	-6680.331
D30-48	61803.048	-6664.877
D30-49	61786.449	-6665.501
D30-50	61794.912	-6665.183
D30-51	61794.603	-6656.953
D30-52	61786.324	-6662.185
D30-53	61771.870	-6662.732
D30-54	61786.503	-6667.065
D30-55	61772.044	-6667.611
D30-56	61788.911	-6695.071
D30-57	61788.438	-6682.621

平成25年 2月 8日測量
平成25年 2月 4日測量
平成24年 9月 5日測量
平成24年 7月11日測量
平成24年 4月12日測量

凡 例	
	施工地区界
	道 路
	街区番号
	画 地 番 号
D14-1	計 算 点
D14-2	境界標あり

面積（座標法）計算書

地 番： 30D-1

測点名	[1] X(i)	[2] X(i+1)-X(i-1)	[3] Y(i)	[4] Y(i+1)-Y(i-1)	[2]*[3]	[1]*[4]	方向角	夾 角	距 離
D30-1	61805.317	-3.049	-6725.107	-16.184	20504.851243	-1000257.250328	225-06-48	132-56-36	4.999
D30-2	61801.789	-24.221	-6728.649	-2.690	162974.607429	-166246.812410	177-38-32	132-31-44	20.711
D30-3	61781.096	-24.398	-6727.797	4.210	164144.791206	260098.414160	137-48-45	140-10-13	5.000
D30-4	61777.391	-4.381	-6724.439	8.269	29459.767259	510837.246179	97-50-15	140-01-30	4.957
D30-5	61776.715	-1.317	-6719.528	9.731	8849.618376	601149.213665	97-34-31	179-44-16	4.862
D30-6	61776.074	-0.788	-6714.708	5.969	5291.189904	368741.385706	97-17-26	179-42-55	1.158
D30-25	61775.927	28.764	-6713.559	2.243	-193108.811076	138563.404261	2-10-01	84-52-35	28.932
D30-37	61804.838	29.390	-6712.465	-11.548	-197279.346350	-713722.269224	272-10-12	90-00-11	12.651
合計				倍面積	836.667991	-836.667991			83.270
				面 積	418.3339955	418.3339955			
				坪 数	126.54	126.54			

面積（座標法）計算書

地 番： 30D-2

測点名	[1] X(i)	[2] X(i+1)-X(i-1)	[3] Y(i)	[4] Y(i+1)-Y(i-1)	[2]*[3]	[1]*[4]	方向角	夾 角	距 離
D30-37	61804.838	-28.238	-6712.465	-19.066	189546.586670	-1178371.041308	182-10-01	90-01-21	28.932
D30-25	61775.927	-29.384	-6713.559	2.716	197271.217656	167783.417732	97-04-37	94-54-36	3.839
D30-7	61775.454	-1.051	-6709.749	8.812	7051.946199	544365.300648	96-35-29	179-30-52	5.035
D30-8	61774.876	-1.108	-6704.747	9.931	7428.859676	613486.293556	96-08-14	179-32-45	4.957
D30-9	61774.346	-0.926	-6699.818	9.110	6204.031468	562764.292060	95-24-38	179-16-24	4.200
D30-26	61773.950	14.565	-6695.637	4.747	-97521.952905	293240.940650	2-10-00	86-45-22	14.972
D30-56	61788.911	30.215	-6695.071	1.144	-202291.570265	70686.514184	2-10-12	180-00-12	15.265
D30-36	61804.165	15.927	-6694.493	-17.394	-106623.190011	-1075021.646010	272-08-40	89-58-28	17.985
合計				倍面積	1065.928488	-1065.928488			95.185
				面 積	532.9642440	532.9642440			
				坪 数	161.22	161.22			

面積（座標法）計算書

地番：30D-3-1

測点名	[1] X(i)	[2] X(i+1)-X(i-1)	[3] Y(i)	[4] Y(i+1)-Y(i-1)	[2]*[3]	[1]*[4]	方向角	夾角	距離
D30-36	61804.165	-14.784	-6694.493	-13.032	98971.384512	-805431.878280	182-10-12	90-00-31	15.265
D30-56	61788.911	-15.727	-6695.071	11.872	105293.381617	733557.951392	92-10-33	90-00-21	12.459
D30-57	61788.438	14.784	-6682.621	13.032	-98795.868864	805226.924016	2-11-04	90-00-31	15.268
D30-35	61803.695	15.727	-6682.039	-11.872	-105088.427353	-733733.467040	272-09-41	89-58-37	12.463
合計				倍面積	380.469912	-380.469912			55.455
				面積	190.2349560	190.2349560			
				坪数	57.54	57.54			

面積（座標法）計算書

地 番： 30D-3-2

測点名	[1] X(i)	[2] X(i+1)-X(i-1)	[3] Y(i)	[4] Y(i+1)-Y(i-1)	[2]*[3]	[1]*[4]	方向角	夾 角	距 離
D30-56	61788.911	-14.488	-6695.071	-13.016	96998.188648	-804244.465576	182-10-00	89-59-27	14.972
D30-26	61773.950	-15.030	-6695.637	0.197	100635.424110	12169.468150	95-10-02	93-00-02	0.766
D30-10	61773.881	-0.512	-6694.874	5.774	3427.775488	356682.388894	95-03-08	179-53-06	5.031
D30-11	61773.438	-0.829	-6689.863	9.901	5545.896427	611618.809638	94-30-48	179-27-40	4.905
D30-12	61773.052	-0.517	-6684.973	6.656	3456.131041	411161.434112	94-14-33	179-43-45	1.771
D30-27	61772.921	14.042	-6683.207	2.301	-93845.592694	142139.491221	2-09-42	87-55-09	14.183
D30-38	61787.094	15.517	-6682.672	0.586	-103695.021424	36207.237084	2-10-23	180-00-41	1.345
D30-57	61788.438	1.817	-6682.621	-12.399	-12142.322357	-766114.842762	272-10-33	90-00-10	12.459
合計				倍面積	380.479239	-380.479239			55.432
				面 積	190.2396195	190.2396195			
				坪 数	57.54	57.54			

面積（座標法）計算書

地 番： 30D-4

測点名	[1] X(i)	[2] X(i+1)-X(i-1)	[3] Y(i)	[4] Y(i+1)-Y(i-1)	[2]*[3]	[1]*[4]	方向角	夾 角	距 離
D30-35	61803.695	-14.610	-6682.039	-17.744	97624.589790	-1096644.764080	182-11-04	90-01-32	15.268
D30-57	61788.438	-16.601	-6682.621	-0.633	110938.191221	-39112.081254	182-10-23	179-59-19	1.345
D30-38	61787.094	-1.432	-6682.672	2.290	9569.586304	141492.445260	92-09-10	89-58-47	2.343
D30-39	61787.006	-0.591	-6680.331	15.607	3948.075621	964309.802642	92-10-17	180-01-07	13.276
D30-54	61786.503	-0.557	-6667.065	14.830	3713.555205	916293.839490	91-58-39	179-48-22	1.565
D30-49	61786.449	8.409	-6665.501	1.882	-56050.197909	116282.097018	2-09-07	90-10-28	8.469
D30-50	61794.912	16.599	-6665.183	0.624	-110635.372617	38560.025088	2-09-14	180-00-07	8.142
D30-48	61803.048	8.783	-6664.877	-16.856	-58537.614691	-1041752.177088	272-09-32	90-00-18	17.174
合計				倍面積	570.812924	-570.812924			67.582
				面 積	285.4064620	285.4064620			
				坪 数	86.33	86.33			

面積（座標法）計算書

地番：30D-6

測点名	[1] X(i)	[2] X(i+1)-X(i-1)	[3] Y(i)	[4] Y(i+1)-Y(i-1)	[2]*[3]	[1]*[4]	方向角	夾角	距離
D30-48	61803.048	-7.828	-6664.877	-8.536	52172.657156	-527550.817728	182-09-14	90-00-38	8.142
D30-50	61794.912	-8.445	-6665.183	7.924	56287.470435	489662.882688	92-09-01	89-59-47	8.236
D30-51	61794.603	7.828	-6656.953	8.536	-52110.628084	527478.731208	2-09-13	90-00-12	8.143
D30-32	61802.740	8.445	-6656.647	-7.924	-56215.383915	-489724.911760	272-08-36	89-59-23	8.236
合計				倍面積	134.115592	-134.115592			32.757
				面積	67.0577960	67.0577960			
				坪数	20.28	20.28			

面積（座標法）計算書

地番：30D-7

測点名	[1] X(i)	[2] X(i+1)-X(i-1)	[3] Y(i)	[4] Y(i+1)-Y(i-1)	[2]*[3]	[1]*[4]	方向角	夾角	距離
D30-32	61802.740	-8.063	-6656.647	-2.301	53672.544761	-142208.104740	182-09-13	90-01-46	8.143
D30-51	61794.603	-7.828	-6656.953	-8.536	52110.628084	-527478.731208	272-09-01	269-59-48	8.236
D30-50	61794.912	-8.154	-6665.183	-8.548	54347.902182	-528222.907776	182-09-07	90-00-06	8.469
D30-49	61786.449	-8.588	-6665.501	2.998	57243.322588	185235.774102	92-09-32	90-00-25	3.318
D30-52	61786.324	-0.485	-6662.185	12.855	3231.159725	794263.195020	92-09-41	180-00-09	9.546
D30-31	61785.964	16.342	-6652.646	7.533	-108717.540932	465433.666812	353-09-05	80-59-24	16.822
D30-23	61802.666	16.776	-6654.652	-4.001	-111638.441952	-247272.466666	272-07-27	98-58-22	1.996
合計				倍面積	249.574456	-249.574456			56.530
				面積	124.7872280	124.7872280			
				坪数	37.74	37.74			

面積（座標法）計算書

地番：30D-9-1

測点名	[1] X(i)	[2] X(i+1)-X(i-1)	[3] Y(i)	[4] Y(i+1)-Y(i-1)	[2]*[3]	[1]*[4]	方向角	夾角	距離
D30-52	61786.324	-14.094	-6662.185	-10.086	93896.835390	-623176.863864	182-10-02	90-00-21	14.464
D30-53	61771.870	-14.537	-6662.732	2.016	96856.135084	124532.089920	91-51-17	89-41-15	2.564
D30-17	61771.787	-0.192	-6660.169	7.531	1278.752448	465203.327897	91-15-25	179-24-08	4.969
D30-18	61771.678	-0.192	-6655.201	9.245	1277.798592	571079.163110	91-06-42	179-51-17	4.278
D30-24	61771.595	14.286	-6650.924	2.555	-95015.100264	157826.425225	353-09-58	82-03-16	14.472
D30-31	61785.964	14.729	-6652.646	-11.261	-97986.822934	-695771.740604	272-09-41	98-59-43	9.546
合計				倍面積	307.598316	-307.598316			50.293
				面積	153.7991580	153.7991580			
				坪数	46.52	46.52			

面積（座標法）計算書

地番：30D-9-2

測点名	[1] X(i)	[2] X(i+1)-X(i-1)	[3] Y(i)	[4] Y(i+1)-Y(i-1)	[2]*[3]	[1]*[4]	方向角	夾角	距離
D30-39	61787.006	-13.742	-6680.331	-13.805	91801.108602	-852969.617830	182-10-01	89-59-44	14.255
D30-28	61772.761	-14.303	-6680.870	0.314	95556.483610	19396.646954	93-53-23	91-43-22	0.855
D30-13	61772.703	-0.351	-6680.017	5.809	2344.685967	358837.631727	93-23-00	179-29-37	4.965
D30-14	61772.410	-0.546	-6675.061	9.920	3644.583306	612782.307200	92-55-04	179-32-04	4.970
D30-15	61772.157	-0.366	-6670.097	7.450	2441.255502	460202.569650	92-36-09	179-41-05	2.489
D30-55	61772.044	14.346	-6667.611	3.032	-95653.547406	187292.837408	2-09-45	89-33-36	14.469
D30-54	61786.503	14.962	-6667.065	-12.720	-99752.626530	-785924.318160	272-10-17	90-00-32	13.276
合計				倍面積	381.943051	-381.943051			55.279
				面積	190.9715255	190.9715255			
				坪数	57.76	57.76			

面積（座標法）計算書

地番：30D-10

測点名	[1] X(i)	[2] X(i+1)-X(i-1)	[3] Y(i)	[4] Y(i+1)-Y(i-1)	[2]*[3]	[1]*[4]	方向角	夾角	距離
D30-54	61786.503	-14.405	-6667.065	-2.110	96039.071325	-130369.521330	182-09-45	90-11-06	14.469
D30-55	61772.044	-14.556	-6667.611	1.929	97053.745716	119158.272876	92-14-40	90-04-55	2.477
D30-16	61771.947	-0.174	-6665.136	4.879	1159.733664	301385.329413	91-50-04	179-35-24	2.405
D30-53	61771.870	14.377	-6662.732	2.951	-95790.097964	182288.788370	2-10-02	90-19-58	14.464
D30-52	61786.324	14.579	-6662.185	-2.769	-97127.995115	-171086.331156	272-09-32	89-59-30	3.318
D30-49	61786.449	0.179	-6665.501	-4.880	-1193.124679	-301517.871120	271-58-39	179-49-07	1.565
合計				倍面積	141.332947	-141.332947			38.698
				面積	70.6664735	70.6664735			
				坪数	21.37	21.37			

面積（座標法）計算書

地番：30D-12

測点名	[1] X(i)	[2] X(i+1)-X(i-1)	[3] Y(i)	[4] Y(i+1)-Y(i-1)	[2]*[3]	[1]*[4]	方向角	夾角	距離
D30-38	61787.094	-14.085	-6682.672	-2.876	94125.435120	-177699.682344	182-09-42	90-00-32	14.183
D30-27	61772.921	-14.333	-6683.207	1.802	95790.405931	111314.803642	93-55-00	91-45-18	2.342
D30-28	61772.761	14.085	-6680.870	2.876	-94100.053950	177658.460636	2-10-01	88-15-01	14.255
D30-39	61787.006	14.333	-6680.331	-1.802	-95749.184223	-111340.184812	272-09-10	89-59-09	2.343
合計				倍面積	66.602878	-66.602878			33.123
				面積	33.3014390	33.3014390			
				坪数	10.07	10.07			

面積（座標法）計算書

地番：30D-S

測点名	[1] X(i)	[2] X(i+1)-X(i-1)	[3] Y(i)	[4] Y(i+1)-Y(i-1)	[2]*[3]	[1]*[4]	方向角	夾角	距離
D30-23	61802.666	-16.680	-6654.652	1.226	110999.595360	75770.068516	173-09-05	81-32-09	16.822
D30-31	61785.964	-31.071	-6652.646	3.728	206704.363866	230338.073792	173-09-58	180-00-53	14.472
D30-24	61771.595	-14.367	-6650.924	1.984	95553.825108	122554.844480	89-33-45	96-23-47	0.262
D30-19	61771.597	3.718	-6650.662	3.578	-24727.161316	221018.774066	41-44-40	132-10-55	4.980
D30-20	61775.313	27.660	-6647.346	0.451	-183865.590360	27860.666163	353-10-36	131-25-56	24.115
D30-21	61799.257	27.331	-6650.211	-6.526	-181756.916841	-403301.951182	312-46-25	139-35-49	4.987
D30-22	61802.644	3.409	-6653.872	-4.441	-22683.049648	-274465.542004	271-36-56	138-50-31	0.780
合計				倍面積	225.066169	-225.066169			66.418
				面積	112.5330845	112.5330845			
				坪数	34.04	34.04			