
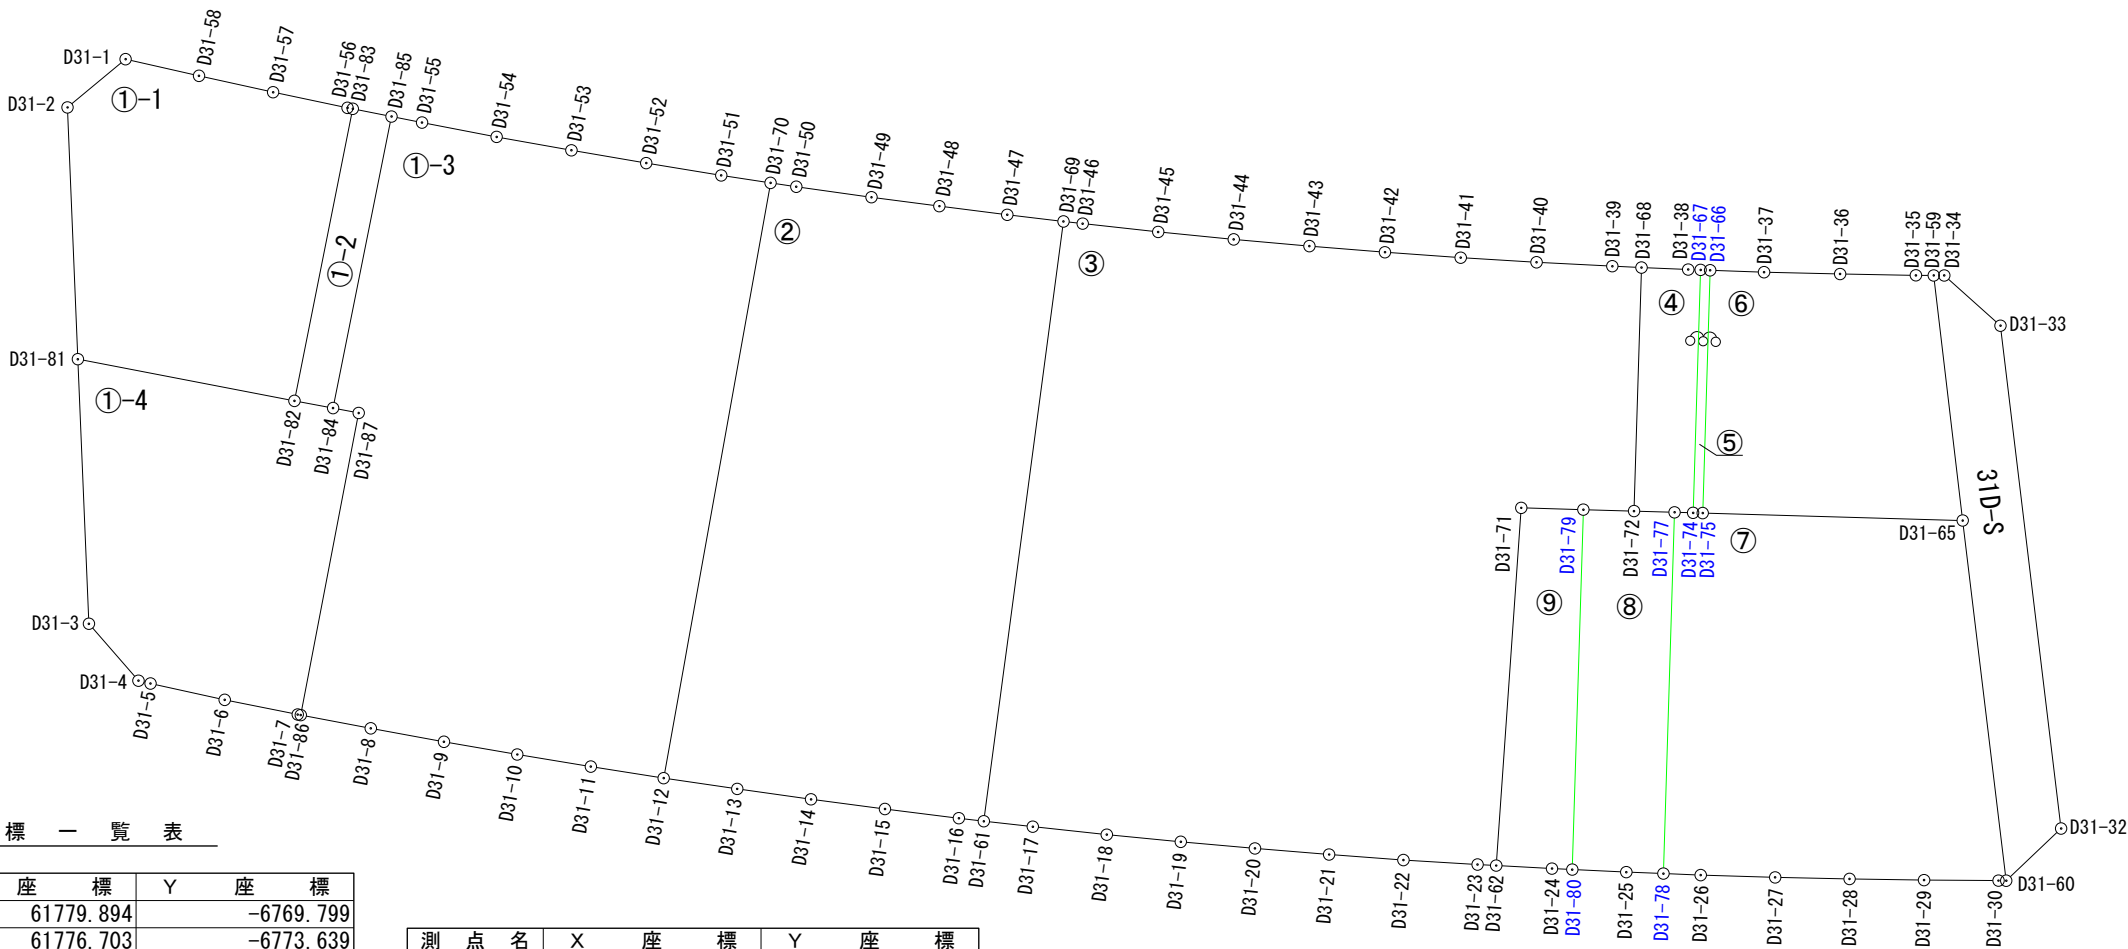


出来形確認測量図（縮尺1：500）

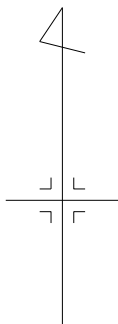

座 標 一 覧 表

測 点 名	X	座 標	Y	座 標
D31-1		61779.894		-6769.799
D31-2		61776.703		-6773.639
D31-3		61742.555		-6772.227
D31-4		61738.791		-6768.950
D31-5		61738.608		-6768.152
D31-6		61737.527		-6763.248
D31-7		61736.556		-6758.416
D31-8		61735.640		-6753.583
D31-9		61734.749		-6748.738
D31-10		61733.914		-6743.888
D31-11		61733.110		-6739.026
D31-12		61732.347		-6734.205
D31-13		61731.636		-6729.340
D31-14		61730.945		-6724.461
D31-15		61730.305		-6719.571
D31-16		61729.698		-6714.682
D31-17		61729.136		-6709.791
D31-18		61728.612		-6704.898
D31-19		61728.135		-6700.001
D31-20		61727.700		-6695.095
D31-21		61727.295		-6690.190
D31-22		61726.933		-6685.277
D31-23		61726.638		-6680.368
D31-24		61726.364		-6675.448
D31-25		61726.130		-6670.531
D31-26		61725.939		-6665.610
D31-27		61725.789		-6660.688
D31-28		61725.682		-6655.764
D31-29		61725.608		-6650.837
D31-30		61725.571		-6645.911

測 点 名	X	座 標	Y	座 標
D31-32		61729.019		-6641.771
D31-33		61762.267		-6645.781
D31-34		61765.594		-6649.501
D31-35		61765.599		-6651.375
D31-36		61765.687		-6656.389
D31-37		61765.807		-6661.418
D31-38		61765.984		-6666.437
D31-39		61766.201		-6671.455
D31-40		61766.460		-6676.471
D31-41		61766.767		-6681.487
D31-42		61767.129		-6686.496
D31-43		61767.533		-6691.495
D31-44		61767.977		-6696.500
D31-45		61768.469		-6701.497
D31-46		61769.018		-6706.491
D31-47		61769.602		-6711.482
D31-48		61770.170		-6715.971
D31-49		61770.761		-6720.459
D31-50		61771.455		-6725.434
D31-51		61772.208		-6730.403
D31-52		61773.021		-6735.360
D31-53		61773.865		-6740.310
D31-54		61774.754		-6745.258
D31-55		61775.702		-6750.189
D31-56		61776.678		-6755.122
D31-57		61777.708		-6760.042
D31-58		61778.794		-6764.946
D31-59		61765.593		-6650.193

測 点 名	X	座 標	Y	座 標
D31-60		61725.567		-6645.399
D31-61		61729.498		-6713.031
D31-62		61726.568		-6679.138
D31-65		61749.383		-6648.278
D31-66		61765.933		-6664.984
D31-67		61765.955		-6665.614
D31-68		61766.111		-6669.524
D31-69		61769.164		-6707.761
D31-70		61771.711		-6727.135
D31-71		61750.220		-6677.479
D31-72		61750.006		-6670.020
D31-74		61749.894		-6666.109
D31-75		61749.876		-6665.478
D31-77		61749.929		-6667.341
D31-78		61726.035		-6668.076
D31-79		61750.102		-6673.372
D31-80		61726.300		-6674.104
D31-81		61760.053		-6772.956
D31-82		61757.299		-6758.630
D31-83		61776.611		-6754.773
D31-84		61756.822		-6756.076
D31-85		61776.101		-6752.209
D31-86		61736.518		-6758.214
D31-87		61756.495		-6754.380

平成25年 2月21日測量
平成25年 2月 4日測量
平成24年 7月11日測量
平成24年 6月25日測量
平成24年 3月27日測量

凡 例	
	施工地区界
	道 路
	街区番号
	画地番号
D14-1	計 算 点
D14-2	境界標あり

面積（座標法）計算書

地 番： 31D-1-1

測点名	[1] X(i)	[2] X(i+1)-X(i-1)	[3] Y(i)	[4] Y(i+1)-Y(i-1)	[2]*[3]	[1]*[4]	方向角	夾 角	距 離
D31-1	61779.894	-2.091	-6769.799	-8.693	14155.649709	-537052.618542	230-16-26	127-30-10	4.993
D31-2	61776.703	-19.841	-6773.639	-3.157	134395.771399	-195029.051371	177-39-04	127-22-38	16.664
D31-81	61760.053	-19.404	-6772.956	15.009	131422.438224	926956.635477	100-52-54	103-13-50	14.588
D31-82	61757.299	16.558	-6758.630	18.183	-111909.395540	1122932.967717	11-17-40	90-24-46	19.693
D31-83	61776.611	19.379	-6754.773	3.508	-130900.745967	216712.351388	280-52-02	89-34-22	0.355
D31-56	61776.678	1.097	-6755.122	-5.269	-7410.368834	-325501.316382	281-49-27	180-57-25	5.027
D31-57	61777.708	2.116	-6760.042	-9.824	-14304.248872	-606904.203392	282-29-12	180-39-45	5.023
D31-58	61778.794	2.186	-6764.946	-9.757	-14788.171956	-602775.693058	282-46-16	180-17-04	4.976
合計				倍面積	660.928163	-660.928163			71.319
				面 積	330.4640815	330.4640815			
				坪 数	99.96	99.96			

面積（座標法）計算書

地番：31D-1-2

測点名	[1] X(i)	[2] X(i+1)-X(i-1)	[3] Y(i)	[4] Y(i+1)-Y(i-1)	[2]*[3]	[1]*[4]	方向角	夾角	距離
D31-83	61776.611	-18.802	-6754.773	-6.421	127003.241946	-396667.619231	191-17-40	90-02-41	19.693
D31-82	61757.299	-19.789	-6758.630	-1.303	133746.529070	-80469.760597	100-34-44	89-17-04	2.598
D31-84	61756.822	18.802	-6756.076	6.421	-127027.740952	396540.554062	11-20-31	90-45-47	19.663
D31-85	61776.101	19.789	-6752.209	1.303	-133619.463901	80494.259603	281-14-59	89-54-28	2.614
合計				倍面積	102.566163	-102.566163			44.568
				面積	51.2830815	51.2830815			
				坪数	15.51	15.51			

面積（座標法）計算書

地番：31D-1-3

測点名	[1] X(i)	[2] X(i+1)-X(i-1)	[3] Y(i)	[4] Y(i+1)-Y(i-1)	[2]*[3]	[1]*[4]	方向角	夾角	距離
D31-85	61776.101	-18.880	-6752.209	-5.887	127481.705920	-363675.906587	191-20-31	90-10-06	19.663
D31-84	61756.822	-19.606	-6756.076	-2.171	132459.626056	-134074.060562	100-54-47	89-34-16	1.727
D31-87	61756.495	-20.304	-6754.380	-2.138	137140.931520	-132035.386310	190-51-51	269-57-04	20.342
D31-86	61736.518	-20.855	-6758.214	0.797	140942.552970	49204.004846	100-44-07	89-52-16	4.713
D31-8	61735.640	-1.769	-6753.583	9.476	11947.088327	585006.924640	100-25-13	179-41-06	4.926
D31-9	61734.749	-1.726	-6748.738	9.695	11648.321788	598518.391555	99-46-07	179-20-54	4.921
D31-10	61733.914	-1.639	-6743.888	9.712	11053.232432	599559.772768	99-23-23	179-37-16	4.928
D31-11	61733.110	-1.567	-6739.026	9.683	10560.053742	597761.704130	98-59-36	179-36-13	4.881
D31-12	61732.347	38.601	-6734.205	11.891	-259947.047205	734059.338177	10-10-56	91-11-20	39.994
D31-70	61771.711	39.861	-6727.135	3.802	-268150.328235	234856.045222	278-38-50	88-27-54	3.306
D31-51	61772.208	1.310	-6730.403	-8.225	-8816.827930	-508076.410800	279-18-51	180-40-01	5.023
D31-52	61773.021	1.657	-6735.360	-9.907	-11160.491520	-611985.319047	279-40-34	180-21-43	5.021
D31-53	61773.865	1.733	-6740.310	-9.898	-11680.957230	-611437.715770	280-11-08	180-30-34	5.027
D31-54	61774.754	1.837	-6745.258	-9.879	-12391.038946	-610272.794766	280-52-57	180-41-49	5.021
D31-55	61775.702	1.347	-6750.189	-6.951	-9092.504583	-429402.904602	281-10-25	180-17-28	2.059
合計				倍面積	1994.317106	-1994.317106			131.552
				面積	997.1585530	997.1585530			
				坪数	301.64	301.64			

面積（座標法）計算書

地番：31D-1-4

測点名	[1] X(i)	[2] X(i+1)-X(i-1)	[3] Y(i)	[4] Y(i+1)-Y(i-1)	[2]*[3]	[1]*[4]	方向角	夾角	距離
D31-81	61760.053	-14.744	-6772.956	-13.597	99860.463264	-839751.440641	177-36-52	76-43-58	17.513
D31-3	61742.555	-21.262	-6772.227	4.006	143991.090474	247340.675330	138-57-24	141-20-32	4.991
D31-4	61738.791	-3.947	-6768.950	4.075	26717.045650	251585.573325	102-54-57	143-57-33	0.819
D31-5	61738.608	-1.264	-6768.152	5.702	8554.944128	352033.542816	102-25-52	179-30-55	5.022
D31-6	61737.527	-2.052	-6763.248	9.736	13878.184896	601076.562872	101-21-45	178-55-53	4.929
D31-7	61736.556	-1.009	-6758.416	5.034	6819.241744	310781.822904	100-39-14	179-17-29	0.206
D31-86	61736.518	19.939	-6758.214	4.036	-134752.028946	249168.586648	10-51-51	90-12-37	20.342
D31-87	61756.495	20.304	-6754.380	2.138	-137140.931520	132035.386310	280-54-47	90-02-56	1.727
D31-84	61756.822	0.804	-6756.076	-4.250	-5431.885104	-262466.493500	280-34-44	179-39-57	2.598
D31-82	61757.299	3.231	-6758.630	-16.880	-21837.133530	-1042463.207120	280-52-54	180-18-10	14.588
合計				倍面積	658.991056	-658.991056			72.735
				面積	329.4955280	329.4955280			
				坪数	99.67	99.67			

面積（座標法）計算書

地番：31D-2

測点名	[1] X(i)	[2] X(i+1)-X(i-1)	[3] Y(i)	[4] Y(i+1)-Y(i-1)	[2]*[3]	[1]*[4]	方向角	夾角	距離
D31-70	61771.711	-39.108	-6727.135	-8.771	263084.795580	-541799.677181	190-10-56	91-37-24	39.994
D31-12	61732.347	-40.075	-6734.205	-2.205	269873.265375	-136119.825135	98-18-53	88-07-57	4.917
D31-13	61731.636	-1.402	-6729.340	9.744	9434.534680	601513.061184	98-03-40	179-44-47	4.928
D31-14	61730.945	-1.331	-6724.461	9.769	8950.257591	603049.601705	97-27-23	179-23-43	4.932
D31-15	61730.305	-1.247	-6719.571	9.779	8379.305037	603660.652595	97-04-39	179-37-16	4.927
D31-16	61729.698	-0.807	-6714.682	6.540	5418.748374	403712.224920	96-54-25	179-49-46	1.663
D31-61	61729.498	39.466	-6713.031	6.921	-264936.481446	427229.855658	7-34-05	90-39-40	40.015
D31-69	61769.164	40.104	-6707.761	1.549	-269008.047144	95680.435036	276-42-48	89-08-43	3.747
D31-47	61769.602	1.006	-6711.482	-8.210	-6751.750892	-507128.432420	277-12-41	180-29-53	4.525
D31-48	61770.170	1.159	-6715.971	-8.977	-7783.810389	-554510.816090	277-30-06	180-17-25	4.527
D31-49	61770.761	1.285	-6720.459	-9.463	-8635.789815	-584536.711343	277-56-29	180-26-23	5.023
D31-50	61771.455	0.950	-6725.434	-6.676	-6389.162300	-412386.233580	278-33-32	180-37-03	1.720
合計				倍面積	1635.864651	-1635.864651			120.918
				面積	817.9323255	817.9323255			
				坪数	247.42	247.42			

面積（座標法）計算書

地 番： 31D-3

測点名	[1] X(i)	[2] X(i+1)-X(i-1)	[3] Y(i)	[4] Y(i+1)-Y(i-1)	[2]*[3]	[1]*[4]	方向角	夾 角	距 離
D31-69	61769.164	-39.520	-6707.761	-6.540	265090.714720	-403970.332560	187-34-05	91-00-36	40.015
D31-61	61729.498	-40.028	-6713.031	-2.030	268709.204868	-125310.880940	96-22-30	88-48-25	3.260
D31-17	61729.136	-0.886	-6709.791	8.133	5944.874826	502043.063088	96-06-45	179-44-15	4.921
D31-18	61728.612	-1.001	-6704.898	9.790	6711.602898	604323.111480	95-33-48	179-27-03	4.920
D31-19	61728.135	-0.912	-6700.001	9.803	6110.400912	605120.907405	95-04-01	179-30-13	4.925
D31-20	61727.700	-0.840	-6695.095	9.811	5623.879800	605610.464700	94-43-12	179-39-11	4.922
D31-21	61727.295	-0.767	-6690.190	9.818	5131.375730	606038.582310	94-12-51	179-29-39	4.926
D31-22	61726.933	-0.657	-6685.277	9.822	4392.226989	606281.935926	93-26-20	179-13-29	4.918
D31-23	61726.638	-0.365	-6680.368	6.139	2438.334320	378939.830682	93-15-26	179-49-06	1.232
D31-62	61726.568	23.582	-6679.138	2.889	-157507.432316	178328.054952	4-00-44	90-45-18	23.710
D31-71	61750.220	23.534	-6677.479	5.766	-157147.790786	356051.768520	91-38-45	267-38-01	4.109
D31-79	61750.102	-0.214	-6673.372	7.459	1428.101608	460594.010818	91-38-26	179-59-41	3.353
D31-72	61750.006	16.009	-6670.020	3.848	-106780.350180	237614.023088	1-45-51	90-07-25	16.113
D31-68	61766.111	16.195	-6669.524	-1.435	-108012.941180	-88634.369285	272-40-07	90-54-16	1.933
D31-39	61766.201	0.349	-6671.455	-6.947	-2328.337795	-429089.798347	272-57-21	180-17-14	5.023
D31-40	61766.460	0.566	-6676.471	-10.032	-3778.882586	-619641.126720	273-30-09	180-32-48	5.025
D31-41	61766.767	0.669	-6681.487	-10.025	-4469.914803	-619211.839175	274-08-01	180-37-52	5.022
D31-42	61767.129	0.766	-6686.496	-10.008	-5121.855936	-618165.427032	274-37-13	180-29-12	5.015
D31-43	61767.533	0.848	-6691.495	-10.004	-5674.387760	-617922.400132	275-04-10	180-26-57	5.025
D31-44	61767.977	0.936	-6696.500	-10.002	-6267.924000	-617803.305954	275-37-23	180-33-13	5.021
D31-45	61768.469	1.041	-6701.497	-9.991	-6976.258377	-617128.773779	276-16-24	180-39-01	5.024
D31-46	61769.018	0.695	-6706.491	-6.264	-4661.011245	-386921.128752	276-33-29	180-17-05	1.278
合計				倍面積	2853.629707	-2853.629707			159.690
				面 積	1426.8148535	1426.8148535			
				坪 数	431.61	431.61			

面積（座標法）計算書

地番：31D-4

測点名	[1] X(i)	[2] X(i+1)-X(i-1)	[3] Y(i)	[4] Y(i+1)-Y(i-1)	[2]*[3]	[1]*[4]	方向角	夾角	距離
D31-68	61766.111	-15.978	-6669.524	-3.583	106565.654472	-221307.975713	181-45-51	89-24-30	16.113
D31-72	61750.006	-16.182	-6670.020	2.183	107934.263640	134800.263098	91-38-47	89-52-56	2.680
D31-77	61749.929	-0.112	-6667.341	3.911	746.742192	241503.972319	91-37-38	179-58-51	1.232
D31-74	61749.894	16.026	-6666.109	1.727	-106831.062834	106642.066938	1-45-55	90-08-17	16.069
D31-67	61765.955	16.090	-6665.614	-0.328	-107249.729260	-20259.233240	272-01-05	90-15-10	0.824
D31-38	61765.984	0.156	-6666.437	-3.910	-1039.964172	-241504.997440	272-21-21	180-20-16	3.090
合計				倍面積	125.904038	-125.904038			40.008
				面積	62.9520190	62.9520190			
				坪数	19.04	19.04			

面積（座標法）計算書

地番：31D-5

測点名	[1] X(i)	[2] X(i+1)-X(i-1)	[3] Y(i)	[4] Y(i+1)-Y(i-1)	[2]*[3]	[1]*[4]	方向角	夾角	距離
D31-67	61765.955	-16.039	-6665.614	-1.125	106909.782946	-69486.699375	181-45-55	89-45-55	16.069
D31-74	61749.894	-16.079	-6666.109	0.136	107184.366611	8397.985584	91-38-02	89-52-07	0.631
D31-75	61749.876	16.039	-6665.478	1.125	-106907.601642	69468.610500	1-45-44	90-07-42	16.065
D31-66	61765.933	16.079	-6664.984	-0.136	-107166.277736	-8400.166888	272-00-00	90-14-16	0.630
合計				倍面積	20.270179	-20.270179			33.395
				面積	10.1350895	10.1350895			
				坪数	3.06	3.06			

面積（座標法）計算書

地番： 31D-6

測点名	[1] X(i)	[2] X(i+1)-X(i-1)	[3] Y(i)	[4] Y(i+1)-Y(i-1)	[2]*[3]	[1]*[4]	方向角	夾角	距離
D31-66	61765.933	-15.931	-6664.984	-4.060	106179.860104	-250769.687980	181-45-44	89-44-19	16.065
D31-75	61749.876	-16.550	-6665.478	16.706	110313.660900	1031593.428456	91-38-31	89-52-47	17.207
D31-65	61749.383	15.717	-6648.278	15.285	-104490.985326	943839.319155	353-15-45	81-37-14	16.323
D31-59	61765.593	16.216	-6650.193	-3.097	-107839.529688	-191288.041521	270-17-27	97-01-42	1.182
D31-35	61765.599	0.094	-6651.375	-6.196	-625.229250	-382699.651404	271-00-20	180-42-53	5.015
D31-36	61765.687	0.208	-6656.389	-10.043	-1384.528912	-620312.794541	271-22-01	180-21-41	5.030
D31-37	61765.807	0.246	-6661.418	-8.595	-1638.708828	-530877.111165	272-01-25	180-39-24	3.568
合計				倍面積	514.539000	-514.539000			64.390
				面積	257.2695000	257.2695000			
				坪数	77.82	77.82			

面積（座標法）計算書

地番：31D-7

測点名	[1] X(i)	[2] X(i+1)-X(i-1)	[3] Y(i)	[4] Y(i+1)-Y(i-1)	[2]*[3]	[1]*[4]	方向角	夾角	距離
D31-77	61749.929	-23.859	-6667.341	-1.967	159076.088919	-121462.110343	181-45-43	90-08-05	23.905
D31-78	61726.035	-23.990	-6668.076	1.731	159967.143240	106847.766585	92-13-46	90-28-03	2.468
D31-26	61725.939	-0.246	-6665.610	7.388	1639.740060	456031.237332	91-44-44	179-30-58	4.924
D31-27	61725.789	-0.257	-6660.688	9.846	1711.796816	607752.118494	91-14-41	179-29-57	4.925
D31-28	61725.682	-0.181	-6655.764	9.851	1204.693284	608059.693382	90-51-38	179-36-57	4.928
D31-29	61725.608	-0.111	-6650.837	9.853	738.242907	608182.415624	90-25-49	179-34-11	4.926
D31-30	61725.571	-0.041	-6645.911	5.438	272.482351	335663.655098	90-26-51	180-01-02	0.512
D31-60	61725.567	23.812	-6645.399	-2.367	-158240.240988	-146104.417089	353-06-26	82-39-35	23.989
D31-65	61749.383	24.309	-6648.278	-20.079	-161612.989902	-1239865.861257	271-38-31	98-32-05	17.207
D31-75	61749.876	0.511	-6665.478	-17.831	-3406.059258	-1101062.038956	271-38-02	179-59-31	0.631
D31-74	61749.894	0.053	-6666.109	-1.863	-353.303777	-115040.052522	271-37-38	179-59-36	1.232
合計				倍面積	997.593652	-997.593652			89.647
				面積	498.7968260	498.7968260			
				坪数	150.88	150.88			

面積（座標法）計算書

地番：31D-8

測点名	[1] X(i)	[2] X(i+1)-X(i-1)	[3] Y(i)	[4] Y(i+1)-Y(i-1)	[2]*[3]	[1]*[4]	方向角	夾角	距離
D31-79	61750.102	-23.706	-6673.372	-4.084	158198.956632	-252187.416568	181-45-41	90-07-15	23.813
D31-80	61726.300	-23.972	-6674.104	2.841	159991.621088	175364.418300	92-43-26	90-57-45	3.577
D31-25	61726.130	-0.265	-6670.531	6.028	1767.690715	372085.111640	92-12-58	179-29-32	2.457
D31-78	61726.035	23.799	-6668.076	3.190	-158693.540724	196906.051650	1-45-43	89-32-45	23.905
D31-77	61749.929	23.971	-6667.341	-1.944	-159822.831111	-120041.861976	271-38-47	89-53-04	2.680
D31-72	61750.006	0.173	-6670.020	-6.031	-1153.913460	-372414.286186	271-38-26	179-59-39	3.353
合計				倍面積	287.983140	-287.983140			59.785
				面積	143.9915700	143.9915700			
				坪数	43.55	43.55			

面積（座標法）計算書

地番：31D-9

測点名	[1] X(i)	[2] X(i+1)-X(i-1)	[3] Y(i)	[4] Y(i+1)-Y(i-1)	[2]*[3]	[1]*[4]	方向角	夾角	距離
D31-71	61750.220	-23.534	-6677.479	-5.766	157147.790786	-356051.768520	184-00-44	92-21-59	23.710
D31-62	61726.568	-23.856	-6679.138	2.031	159337.516128	125366.659608	93-09-52	89-09-08	3.696
D31-24	61726.364	-0.268	-6675.448	5.034	1789.020064	310730.516376	92-43-35	179-33-43	1.346
D31-80	61726.300	23.738	-6674.104	2.076	-158429.880752	128143.798800	1-45-41	89-02-06	23.813
D31-79	61750.102	23.920	-6673.372	-3.375	-159627.058240	-208406.594250	271-38-45	89-53-04	4.109
合計				倍面積	217.387986	-217.387986			56.674
				面積	108.6939930	108.6939930			
				坪数	32.87	32.87			

面積（座標法）計算書

地番：31D-S

測点名	[1] X(i)	[2] X(i+1)-X(i-1)	[3] Y(i)	[4] Y(i+1)-Y(i-1)	[2]*[3]	[1]*[4]	方向角	夾角	距離
D31-59	61765.593	-16.211	-6650.193	1.223	107806.278723	75539.320239	173-15-45	83-20-43	16.323
D31-65	61749.383	-40.026	-6648.278	4.794	266103.975228	296026.542102	173-06-26	179-50-41	23.989
D31-60	61725.567	-20.364	-6645.399	6.507	135326.905236	401648.264469	46-25-26	53-19-00	5.008
D31-32	61729.019	36.700	-6641.771	-0.382	-243752.995700	-23580.485258	353-07-22	126-41-56	33.489
D31-33	61762.267	36.575	-6645.781	-7.730	-243069.440075	-477422.323910	311-48-29	138-41-07	4.991
D31-34	61765.594	3.326	-6649.501	-4.412	-22116.240326	-272509.800728	269-55-02	138-06-33	0.692
合計				倍面積	298.483086	-298.483086			84.492
				面積	149.2415430	149.2415430			
				坪数	45.14	45.14			