



出来形確認測量図（縮尺1：500）

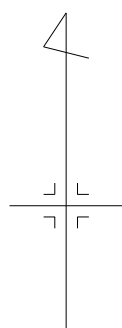

座 標 一 覧 表

測 点 名	X 座 標	Y 座 標
D32-2	61931.076	-6727.145
D32-3	61856.382	-6666.860
D32-4	61855.581	-6666.222
D32-5	61853.138	-6664.336
D32-6	61850.627	-6662.528
D32-7	61848.065	-6660.806
D32-8	61845.449	-6659.159
D32-9	61844.517	-6658.599
D32-10	61844.264	-6657.631
D32-11	61857.417	-6633.175
D32-15	61863.994	-6636.877
D32-16	61866.428	-6638.717
D32-17	61868.332	-6640.240
D32-18	61869.731	-6641.419
D32-33	61921.024	-6687.529
D32-34	61928.842	-6695.947
D32-59	61858.099	-6633.001
D32-60	61862.159	-6635.524
D32-62	61964.052	-6727.378
D32-64	61956.787	-6736.359
D32-66	61925.582	-6722.711
D32-67	61921.387	-6719.326
D32-68	61920.138	-6718.318
D32-69	61915.470	-6714.548
D32-72	61905.773	-6706.717
D32-73	61904.234	-6705.475
D32-74	61899.935	-6702.006
D32-75	61896.381	-6699.132
D32-76	61895.322	-6698.277
D32-81	61875.631	-6682.372
D32-84	61857.258	-6667.566
D32-85	61848.441	-6661.059
D32-86	61847.075	-6660.183
D32-87	61862.686	-6635.912
D32-89	61873.942	-6644.963
D32-91	61892.978	-6660.888
D32-93	61911.732	-6677.953
D32-96	61933.924	-6701.247
D32-97	61931.238	-6715.711

測 点 名	X 座 標	Y 座 標
D32-98	61927.039	-6712.323
D32-99	61925.790	-6711.315
D32-100	61925.562	-6711.597
D32-101	61920.894	-6707.827
D32-102	61913.926	-6696.591
D32-103	61912.404	-6695.363
D32-104	61908.105	-6691.893
D32-105	61904.542	-6689.020
D32-106	61903.483	-6688.165
D32-114	61891.865	-6695.480
D32-115	61899.903	-6685.523
D32-116	61890.017	-6693.988
D32-117	61898.055	-6684.032
D32-120	61879.077	-6685.159
D32-121	61887.120	-6675.214
D32-122	61902.279	-6669.031
D32-123	61893.273	-6680.174
D32-124	61943.309	-6710.302
D32-125	61930.252	-6726.484
D32-126	61953.133	-6718.860
D32-127	61942.977	-6731.412
D32-128	61883.476	-6652.956
D32-129	61874.211	-6664.464
D32-130	61881.111	-6669.987
D32-131	61872.907	-6680.173
D32-132	61867.761	-6659.237
D32-133	61859.983	-6669.764
D32-134	61958.528	-6723.200
D32-135	61948.149	-6714.679
D32-136	61938.571	-6705.872
D32-137	61916.489	-6682.681
D32-138	61907.800	-6674.132
D32-139	61897.691	-6664.890
D32-150	61883.848	-6672.200
D32-151	61865.023	-6657.049

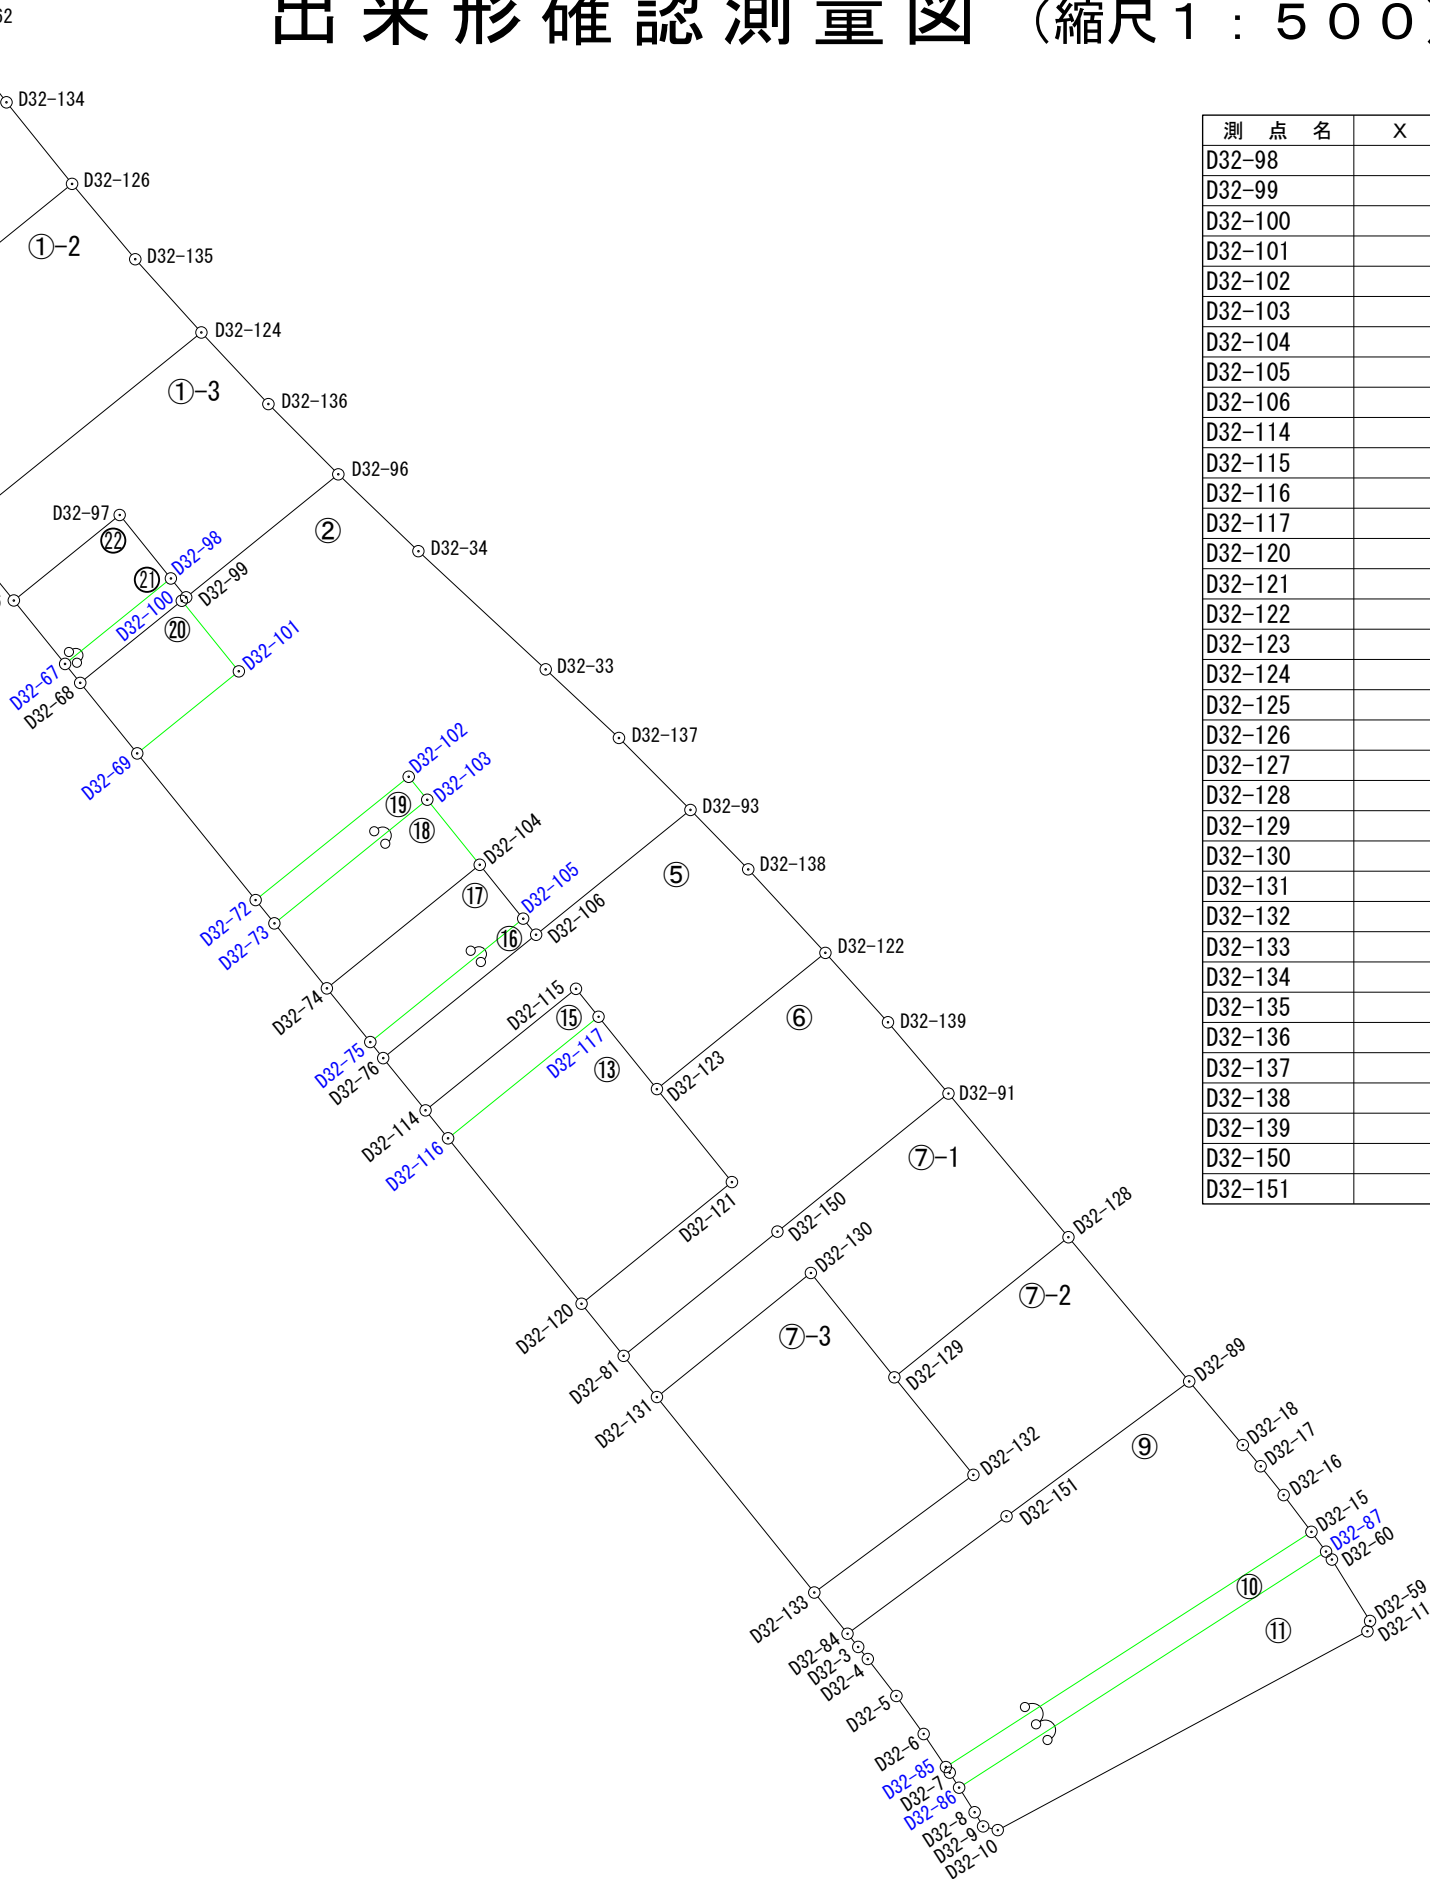

平成25年 3月 7日測量
平成25年 3月 2日測量
平成25年 3月 1日測量
平成25年 2月 8日測量
平成24年 4月 9日測量

凡 例	
	施工地区界
	道 路
	街区番号
	画地番号
D14-1	計 算 点
D14-2	境界標あり

面積（座標法）計算書

地番：32D-1-1

測点名	[1] X(i)	[2] X(i+1)-X(i-1)	[3] Y(i)	[4] Y(i+1)-Y(i-1)	[2]*[3]	[1]*[4]	方向角	夾角	距離
D32-64	61956.787	-21.075	-6736.359	-4.034	141968.765925	-249933.678758	160-17-29	109-15-43	14.669
D32-127	61942.977	-3.654	-6731.412	17.499	24596.579448	1083940.154523	51-01-23	70-43-54	16.146
D32-126	61953.133	15.551	-6718.860	8.212	-104484.991860	508759.128196	321-11-06	90-09-43	6.924
D32-134	61958.528	10.919	-6723.200	-8.518	-73410.620800	-527762.741504	322-53-54	181-42-48	6.926
D32-62	61964.052	-1.741	-6727.378	-13.159	11712.365098	-815384.960268	231-01-46	88-07-52	11.552
合計				倍面積	382.097811	-382.097811			56.217
				面積	191.0489055	191.0489055			
				坪数	57.79	57.79			

面積（座標法）計算書

地番：32D-1-2

測点名	[1] X(i)	[2] X(i+1)-X(i-1)	[3] Y(i)	[4] Y(i+1)-Y(i-1)	[2]*[3]	[1]*[4]	方向角	夾角	距離
D32-127	61942.977	-22.057	-6731.412	-8.285	148474.754484	-513197.564445	160-16-31	109-15-08	12.643
D32-2	61931.076	-12.725	-6727.145	4.928	85602.920125	305196.342528	141-15-50	160-59-19	1.056
D32-125	61930.252	12.233	-6726.484	16.843	-82285.078772	1043091.234436	51-06-02	89-50-12	20.793
D32-124	61943.309	17.897	-6710.302	11.805	-120094.274894	731240.762745	317-52-33	86-46-31	6.526
D32-135	61948.149	9.824	-6714.679	-8.558	-65965.006496	-530152.259142	320-00-26	182-07-53	6.505
D32-126	61953.133	-5.172	-6718.860	-16.733	34749.943920	-1036661.774489	231-01-23	91-00-57	16.146
合計				倍面積	483.258367	-483.258367			63.669
				面積	241.6291835	241.6291835			
				坪数	73.09	73.09			

面積（座標法）計算書

地 番： 32D-1-3

測点名	[1] X(i)	[2] X(i+1)-X(i-1)	[3] Y(i)	[4] Y(i+1)-Y(i-1)	[2]*[3]	[1]*[4]	方向角	夾 角	距 離
D32-125	61930.252	-17.727	-6726.484	-12.409	119240.381868	-768492.497068	141-03-52	89-57-50	6.004
D32-66	61925.582	0.986	-6722.711	10.773	-6628.593046	667124.294886	51-03-42	89-59-50	8.999
D32-97	61931.238	1.457	-6715.711	10.388	-9784.790927	643341.700344	141-06-05	270-02-23	5.395
D32-98	61927.039	-5.448	-6712.323	4.396	36568.735704	272231.263444	141-05-42	179-59-37	1.605
D32-99	61925.790	6.885	-6711.315	11.076	-46207.403775	685890.050040	51-03-54	89-58-12	12.943
D32-96	61933.924	12.781	-6701.247	5.443	-85648.637907	337106.348332	315-08-09	84-04-15	6.556
D32-136	61938.571	9.385	-6705.872	-9.055	-62934.608720	-560853.760405	316-55-27	181-47-18	6.486
D32-124	61943.309	-8.319	-6710.302	-20.612	55823.002338	-1276775.485108	231-06-02	94-10-35	20.793
合計				倍面積	428.085535	-428.085535			68.781
				面 積	214.0427675	214.0427675			
				坪 数	64.74	64.74			

面積（座標法）計算書

地番： 32D-2

測点名	[1] X(i)	[2] X(i+1)-X(i-1)	[3] Y(i)	[4] Y(i+1)-Y(i-1)	[2]*[3]	[1]*[4]	方向角	夾角	距離
D32-69	61915.470	-15.121	-6714.548	1.110	101530.680308	68726.171700	141-04-36	89-58-52	12.464
D32-72	61905.773	-1.544	-6706.717	17.957	10355.171048	1111641.965761	51-09-38	90-05-02	13.000
D32-102	61913.926	6.631	-6696.591	11.354	-44405.094921	702970.715804	141-06-08	269-56-30	1.956
D32-103	61912.404	-5.821	-6695.363	4.698	38973.708023	290864.473992	141-05-27	179-59-19	5.525
D32-104	61908.105	-7.862	-6691.893	6.343	52611.662766	392683.110015	141-07-09	180-01-42	4.577
D32-105	61904.542	-4.622	-6689.020	3.728	30916.650440	230780.132576	141-05-02	179-57-53	1.361
D32-106	61903.483	7.190	-6688.165	11.067	-48087.906350	685085.846361	51-04-11	89-59-09	13.127
D32-93	61911.732	13.006	-6677.953	5.484	-86853.456718	339523.938288	315-10-31	84-06-20	6.707
D32-137	61916.489	9.292	-6682.681	-9.576	-62095.471852	-592912.298664	313-05-22	177-54-51	6.638
D32-33	61921.024	12.353	-6687.529	-13.266	-82611.045737	-821444.304384	312-53-01	179-47-39	11.488
D32-34	61928.842	12.900	-6695.947	-13.718	-86377.716300	-849539.854556	313-47-50	180-54-49	7.343
D32-96	61933.924	-3.052	-6701.247	-15.368	20452.205844	-951800.544032	231-03-54	97-16-04	12.943
D32-99	61925.790	-8.362	-6711.315	-10.350	56120.016030	-640931.926500	231-02-39	179-58-45	0.363
D32-100	61925.562	-4.896	-6711.597	3.488	32859.978912	215996.360256	141-04-29	90-01-50	6.000
D32-101	61920.894	-10.092	-6707.827	-2.951	67695.390084	-182728.558194	231-05-44	270-01-15	8.637
合計				倍面積	1084.771577	-1084.771577			112.129
				面積	542.3857885	542.3857885			
				坪数	164.07	164.07			

面積（座標法）計算書

地番：32D-5

測点名	[1] X(i)	[2] X(i+1)-X(i-1)	[3] Y(i)	[4] Y(i+1)-Y(i-1)	[2]*[3]	[1]*[4]	方向角	夾角	距離
D32-76	61895.322	-11.618	-6698.277	-7.315	77820.582186	-452764.280430	141-01-27	89-55-47	4.447
D32-114	61891.865	4.581	-6695.480	12.754	-30671.993880	789368.846210	51-05-13	90-03-46	12.797
D32-115	61899.903	6.190	-6685.523	11.448	-41383.387370	708630.089544	141-06-10	270-00-57	2.374
D32-117	61898.055	-6.630	-6684.032	5.349	44315.132160	331092.696195	141-06-15	180-00-05	6.144
D32-123	61893.273	4.224	-6680.174	15.001	-28217.054976	928460.988273	51-03-15	89-57-00	14.327
D32-122	61902.279	14.527	-6669.031	6.042	-96881.013337	374013.569718	317-15-52	86-12-37	7.517
D32-138	61907.800	9.453	-6674.132	-8.922	-63090.569796	-552341.391600	315-49-13	178-33-21	5.483
D32-93	61911.732	-4.317	-6677.953	-14.033	28828.723101	-868807.335156	231-04-11	95-14-58	13.127
D32-106	61903.483	-16.410	-6688.165	-20.324	109752.787650	-1258126.388492	231-05-40	180-01-29	12.994
合計				倍面積	473.205738	-473.205738			79.210
				面積	236.6028690	236.6028690			
				坪数	71.57	71.57			

面積（座標法）計算書

地番： 32D-6

測点名	[1] X(i)	[2] X(i+1)-X(i-1)	[3] Y(i)	[4] Y(i+1)-Y(i-1)	[2]*[3]	[1]*[4]	方向角	夾角	距離
D32-120	61879.077	-11.489	-6685.159	-7.158	76805.791751	-442930.433166	141-02-07	89-59-58	4.432
D32-81	61875.631	4.771	-6682.372	12.959	-31881.596812	801846.302129	51-04-07	90-02-00	13.076
D32-150	61883.848	17.347	-6672.200	21.484	-115742.653400	1329512.590432	51-05-34	180-01-27	14.537
D32-91	61892.978	13.843	-6660.888	7.310	-92206.672584	452437.669180	319-39-51	88-34-17	6.183
D32-139	61897.691	9.301	-6664.890	-8.143	-61990.141890	-504032.897813	317-55-53	178-16-02	6.180
D32-122	61902.279	-4.418	-6669.031	-15.284	29463.778958	-946114.432236	231-03-15	93-07-22	14.327
D32-123	61893.273	-15.159	-6680.174	-6.183	101264.757666	-382686.106959	141-07-38	90-04-23	7.903
D32-121	61887.120	-14.196	-6675.214	-4.985	94761.337944	-308507.293200	231-02-09	269-54-31	12.790
合計				倍面積	474.601633	-474.601633			79.428
				面積	237.3008165	237.3008165			
				坪数	71.78	71.78			

面積（座標法）計算書

地 番： 32D-7-1

測点名	[1] X(i)	[2] X(i+1)-X(i-1)	[3] Y(i)	[4] Y(i+1)-Y(i-1)	[2]*[3]	[1]*[4]	方向角	夾 角	距 離
D32-81	61875.631	-10.941	-6682.372	-7.973	73111.832052	-493334.405963	141-05-14	90-01-07	3.501
D32-131	61872.907	5.480	-6680.173	12.385	-36607.348040	766295.953195	51-09-05	90-03-51	13.079
D32-130	61881.111	1.304	-6669.987	15.709	-8697.663048	972090.372699	141-19-30	270-10-25	8.838
D32-129	61874.211	2.365	-6664.464	17.031	-15761.457360	1053779.687541	51-09-46	89-50-16	14.774
D32-128	61883.476	18.767	-6652.956	3.576	-124856.025252	221295.310176	320-08-45	88-58-59	12.378
D32-91	61892.978	0.372	-6660.888	-19.244	-2477.850336	-1191068.468632	231-05-34	90-56-49	14.537
D32-150	61883.848	-17.347	-6672.200	-21.484	115742.653400	-1329512.590432	231-04-07	179-58-33	13.076
合計				倍面積	454.141416	-454.141416			80.183
				面 積	227.0707080	227.0707080			
				坪 数	68.68	68.68			

面積（座標法）計算書

地番： 32D-7-2

測点名	[1] X(i)	[2] X(i+1)-X(i-1)	[3] Y(i)	[4] Y(i+1)-Y(i-1)	[2]*[3]	[1]*[4]	方向角	夾角	距離
D32-133	61859.983	-10.503	-6669.764	-8.329	70052.531292	-515231.798407	141-06-37	87-34-10	3.501
D32-84	61857.258	5.040	-6667.566	12.715	-33604.532640	786515.035470	53-33-38	92-27-01	13.073
D32-151	61865.023	16.684	-6657.049	22.603	-111066.205516	1398335.114869	53-34-27	180-00-49	15.021
D32-89	61873.942	18.453	-6644.963	4.093	-122619.502239	253250.044606	320-01-29	86-27-02	12.441
D32-128	61883.476	0.269	-6652.956	-19.501	-1789.645164	-1206789.665476	231-09-46	91-08-17	14.774
D32-129	61874.211	-15.715	-6664.464	-6.281	104732.051760	-388631.919291	140-58-45	89-48-59	8.302
D32-132	61867.761	-14.228	-6659.237	-5.300	94747.624036	-327899.133300	233-32-27	272-33-42	13.089
合計				倍面積	452.321529	-452.321529			80.201
				面積	226.1607645	226.1607645			
				坪数	68.41	68.41			

面積（座標法）計算書

地番：32D-7-3

測点名	[1] X(i)	[2] X(i+1)-X(i-1)	[3] Y(i)	[4] Y(i+1)-Y(i-1)	[2]*[3]	[1]*[4]	方向角	夾角	距離
D32-131	61872.907	-21.128	-6680.173	0.223	141138.695144	13797.658261	141-09-07	90-00-02	16.594
D32-133	61859.983	-5.146	-6669.764	20.936	34322.605544	1295100.604088	53-32-27	92-23-20	13.089
D32-132	61867.761	14.228	-6659.237	5.300	-94747.624036	327899.133300	320-58-45	87-26-18	8.302
D32-129	61874.211	13.350	-6664.464	-10.750	-88970.594400	-665147.768250	321-19-30	180-20-45	8.838
D32-130	61881.111	-1.304	-6669.987	-15.709	8697.663048	-972090.372699	231-09-05	89-49-35	13.079
合計				倍面積	440.745300	-440.745300			59.902
				面積	220.3726500	220.3726500			
				坪数	66.66	66.66			

面積（座標法）計算書

地 番： 32D-9

測点名	[1] X(i)	[2] X(i+1)-X(i-1)	[3] Y(i)	[4] Y(i+1)-Y(i-1)	[2]*[3]	[1]*[4]	方向角	夾 角	距 離
D32-89	61873.942	-4.708	-6644.963	-15.630	31284.485804	-967089.713460	233-34-27	93-39-30	15.021
D32-151	61865.023	-16.684	-6657.049	-22.603	111066.205516	-1398335.114869	233-33-38	179-59-11	13.073
D32-84	61857.258	-8.641	-6667.566	-9.811	57614.437806	-606881.558238	141-08-00	87-34-22	1.125
D32-3	61856.382	-1.677	-6666.860	1.344	11180.324220	83134.977408	141-27-45	180-19-45	1.024
D32-4	61855.581	-3.244	-6666.222	2.524	21625.224168	156123.486444	142-19-54	180-52-09	3.086
D32-5	61853.138	-4.954	-6664.336	3.694	33015.120544	228485.491772	144-14-42	181-54-48	3.094
D32-6	61850.627	-4.697	-6662.528	3.277	31293.894016	202684.504679	146-05-56	181-51-14	2.634
D32-85	61848.441	13.367	-6661.059	25.651	-89038.375653	1586474.360091	57-15-08	91-09-12	28.752
D32-15	61863.994	17.987	-6636.877	22.342	-119377.506599	1382165.353948	322-54-44	85-39-36	3.051
D32-16	61866.428	4.338	-6638.717	-3.363	-28798.754346	-208056.797364	321-20-38	178-25-54	2.438
D32-17	61868.332	3.303	-6640.240	-2.702	-21932.712720	-167168.233064	319-52-40	178-32-02	1.830
D32-18	61869.731	5.610	-6641.419	-4.723	-37258.360590	-292210.739513	319-54-57	180-02-17	5.504
合計				倍面積	673.982166	-673.982166			80.632
				面 積	336.9910830	336.9910830			
				坪 数	101.93	101.93			

面積（座標法）計算書

地番：32D-10

測点名	[1] X(i)	[2] X(i+1)-X(i-1)	[3] Y(i)	[4] Y(i+1)-Y(i-1)	[2]*[3]	[1]*[4]	方向角	夾角	距離
D32-85	61848.441	-15.929	-6661.059	-23.929	106104.008811	-1479971.344689	146-03-52	88-48-44	0.453
D32-7	61848.065	-1.366	-6660.806	0.876	9098.660996	54178.904940	147-49-05	181-45-13	1.170
D32-86	61847.075	14.621	-6660.183	24.894	-97378.535643	1539621.085050	57-15-04	89-25-59	28.858
D32-87	61862.686	16.919	-6635.912	23.306	-112272.995128	1441771.759916	323-34-53	86-19-49	1.625
D32-15	61863.994	-14.245	-6636.877	-25.147	94542.312865	-1555693.857118	237-15-08	93-40-15	28.752
合計				倍面積	93.451901	-93.451901			60.858
				面積	46.7259505	46.7259505			
				坪数	14.13	14.13			

面積（座標法）計算書

地 番： 32D-11

測点名	[1] X(i)	[2] X(i+1)-X(i-1)	[3] Y(i)	[4] Y(i+1)-Y(i-1)	[2]*[3]	[1]*[4]	方向角	夾 角	距 離
D32-87	61862.686	-15.084	-6635.912	-24.659	100096.096608	-1525471.974074	237-15-04	93-36-48	28.858
D32-86	61847.075	-17.237	-6660.183	-23.247	114801.574371	-1437758.952525	147-47-55	90-32-51	1.922
D32-8	61845.449	-2.558	-6659.159	1.584	17034.128722	97963.191216	149-00-00	181-12-05	1.087
D32-9	61844.517	-1.185	-6658.599	1.528	7890.439815	94498.421976	104-38-51	135-38-51	1.001
D32-10	61844.264	12.900	-6657.631	25.424	-85883.439900	1572328.567936	61-43-39	137-04-48	27.769
D32-11	61857.417	13.835	-6633.175	24.630	-91769.976125	1523548.180710	14-18-46	132-35-07	0.704
D32-59	61858.099	4.742	-6633.001	-2.349	-31453.690742	-145304.674551	328-08-31	133-49-45	4.780
D32-60	61862.159	4.587	-6635.524	-2.911	-30437.148588	-180080.744849	323-38-16	175-29-45	0.654
合計				倍面積	277.984161	-277.984161			66.775
				面 積	138.9920805	138.9920805			
				坪 数	42.04	42.04			

面積（座標法）計算書

地番：32D-13

測点名	[1] X(i)	[2] X(i+1)-X(i-1)	[3] Y(i)	[4] Y(i+1)-Y(i-1)	[2]*[3]	[1]*[4]	方向角	夾角	距離
D32-116	61890.017	-18.978	-6693.988	-1.127	127038.504264	-69750.049159	141-05-42	90-00-39	14.058
D32-120	61879.077	-2.897	-6685.159	18.774	19366.905623	1161717.791598	51-02-09	89-56-27	12.790
D32-121	61887.120	14.196	-6675.214	4.985	-94761.337944	308507.293200	321-07-38	90-05-29	7.903
D32-123	61893.273	10.935	-6680.174	-8.818	-73047.702690	-545774.881314	321-06-15	179-58-37	6.144
D32-117	61898.055	-3.256	-6684.032	-13.814	21763.208192	-855059.731770	231-05-03	89-58-48	12.796
合計				倍面積	359.577445	-359.577445			53.691
				面積	179.7887225	179.7887225			
				坪数	54.38	54.38			

面積（座標法）計算書

地 番： 32D-15

測点名	[1] X(i)	[2] X(i+1)-X(i-1)	[3] Y(i)	[4] Y(i+1)-Y(i-1)	[2]*[3]	[1]*[4]	方向角	夾 角	距 離
D32-114	61891.865	-9.886	-6695.480	-8.465	66191.515280	-523914.637225	141-05-02	89-59-49	2.375
D32-116	61890.017	6.190	-6693.988	11.448	-41435.785720	708516.914616	51-05-03	90-00-01	12.796
D32-117	61898.055	9.886	-6684.032	8.465	-66078.340352	523967.035575	321-06-10	90-01-07	2.374
D32-115	61899.903	-6.190	-6685.523	-11.448	41383.387370	-708630.089544	231-05-13	89-59-03	12.797
合計				倍面積	60.776578	-60.776578			30.342
				面 積	30.3882890	30.3882890			
				坪 数	9.19	9.19			

面積（座標法）計算書

地番：32D-16

測点名	[1] X(i)	[2] X(i+1)-X(i-1)	[3] Y(i)	[4] Y(i+1)-Y(i-1)	[2]*[3]	[1]*[4]	方向角	夾角	距離
D32-75	61896.381	-9.220	-6699.132	-9.257	61765.997040	-572974.798917	141-05-02	89-59-22	1.361
D32-76	61895.322	7.102	-6698.277	10.967	-47571.163254	678805.996374	51-05-40	90-00-38	12.994
D32-106	61903.483	9.220	-6688.165	9.257	-61664.881300	573040.542131	321-05-02	89-59-22	1.361
D32-105	61904.542	-7.102	-6689.020	-10.967	47505.420040	-678907.112114	231-05-40	90-00-38	12.994
合計				倍面積	35.372526	-35.372526			28.710
				面積	17.6862630	17.6862630			
				坪数	5.35	5.35			

面積（座標法）計算書

地番：32D-17

測点名	[1] X(i)	[2] X(i+1)-X(i-1)	[3] Y(i)	[4] Y(i+1)-Y(i-1)	[2]*[3]	[1]*[4]	方向角	夾角	距離
D32-74	61899.935	-11.724	-6702.006	-7.239	78574.318344	-448093.629465	141-02-19	89-58-20	4.571
D32-75	61896.381	4.607	-6699.132	12.986	-30862.901124	803786.403666	51-05-40	90-03-21	12.994
D32-105	61904.542	11.724	-6689.020	7.239	-78422.070480	448126.979538	321-07-09	90-01-29	4.577
D32-104	61908.105	-4.607	-6691.893	-12.986	30829.551051	-803938.651530	231-03-59	89-56-50	13.001
合計				倍面積	118.897791	-118.897791			35.143
				面積	59.4488955	59.4488955			
				坪数	17.98	17.98			

面積（座標法）計算書

地番：32D-18

測点名	[1] X(i)	[2] X(i+1)-X(i-1)	[3] Y(i)	[4] Y(i+1)-Y(i-1)	[2]*[3]	[1]*[4]	方向角	夾角	距離
D32-73	61904.234	-12.469	-6705.475	-6.643	83610.567775	-411229.826462	141-05-56	90-02-07	5.524
D32-74	61899.935	3.871	-6702.006	13.582	-25943.465226	840724.917170	51-03-59	89-58-03	13.001
D32-104	61908.105	12.469	-6691.893	6.643	-83441.213817	411255.541515	321-05-27	90-01-28	5.525
D32-103	61912.404	-3.871	-6695.363	-13.582	25917.750173	-840894.271128	231-03-49	89-58-22	13.000
合計				倍面積	143.638905	-143.638905			37.050
				面積	71.8194525	71.8194525			
				坪数	21.72	21.72			

面積（座標法）計算書

地番：32D-19

測点名	[1] X(i)	[2] X(i+1)-X(i-1)	[3] Y(i)	[4] Y(i+1)-Y(i-1)	[2]*[3]	[1]*[4]	方向角	夾角	距離
D32-72	61905.773	-9.692	-6706.717	-8.884	65001.501164	-549970.887332	141-05-45	89-56-07	1.978
D32-73	61904.234	6.631	-6705.475	11.354	-44464.004725	702860.672836	51-03-49	89-58-04	13.000
D32-103	61912.404	9.692	-6695.363	8.884	-64891.458196	550029.797136	321-06-08	90-02-19	1.956
D32-102	61913.926	-6.631	-6696.591	-11.354	44405.094921	-702970.715804	231-09-38	90-03-30	13.000
合計				倍面積	51.133164	-51.133164			29.934
				面積	25.5665820	25.5665820			
				坪数	7.73	7.73			

面積（座標法）計算書

地番：32D-20

測点名	[1] X(i)	[2] X(i+1)-X(i-1)	[3] Y(i)	[4] Y(i+1)-Y(i-1)	[2]*[3]	[1]*[4]	方向角	夾角	距離
D32-68	61920.138	10.092	-6718.318	2.951	-67801.265256	182726.327238	51-05-44	270-01-15	8.637
D32-100	61925.562	0.756	-6711.597	10.491	-5073.967332	649661.070942	141-04-29	269-58-45	6.000
D32-101	61920.894	-10.092	-6707.827	-2.951	67695.390084	-182728.558194	231-05-44	270-01-15	8.637
D32-69	61915.470	-0.756	-6714.548	-10.491	5076.198288	-649555.195770	321-04-29	269-58-45	6.000
合計				倍面積	-103.644216	103.644216			29.274
				面積	51.8221080	51.8221080			
				坪数	15.67	15.67			

面積（座標法）計算書

地番：32D-21

測点名	[1] X(i)	[2] X(i+1)-X(i-1)	[3] Y(i)	[4] Y(i+1)-Y(i-1)	[2]*[3]	[1]*[4]	方向角	夾角	距離
D32-67	61921.387	-6.901	-6719.326	-5.995	46370.068726	-371218.715065	141-05-42	90-00-05	1.605
D32-68	61920.138	4.175	-6718.318	7.729	-28048.977650	478580.746602	51-05-44	90-00-02	8.637
D32-100	61925.562	5.652	-6711.597	7.003	-37933.946244	433664.710686	51-02-39	179-56-55	0.363
D32-99	61925.790	1.477	-6711.315	-0.726	-9912.612255	-44958.123540	321-05-42	90-03-03	1.605
D32-98	61927.039	-4.403	-6712.323	-8.011	29554.358169	-496097.509429	231-05-37	89-59-55	8.999
合計				倍面積	28.890746	-28.890746			21.209
				面積	14.4453730	14.4453730			
				坪数	4.36	4.36			

面積（座標法）計算書

地番：32D-22

測点名	[1] X(i)	[2] X(i+1)-X(i-1)	[3] Y(i)	[4] Y(i+1)-Y(i-1)	[2]*[3]	[1]*[4]	方向角	夾角	距離
D32-66	61925.582	-9.851	-6722.711	-3.615	66225.426061	-223860.978930	141-05-58	90-02-16	5.390
D32-67	61921.387	1.457	-6719.326	10.388	-9790.057982	643239.368156	51-05-37	89-59-39	8.999
D32-98	61927.039	9.851	-6712.323	3.615	-66123.093873	223866.245985	321-06-05	90-00-28	5.395
D32-97	61931.238	-1.457	-6715.711	-10.388	9784.790927	-643341.700344	231-03-42	89-57-37	8.999
合計				倍面積	97.065133	-97.065133			28.783
				面積	48.5325665	48.5325665			
				坪数	14.68	14.68			