
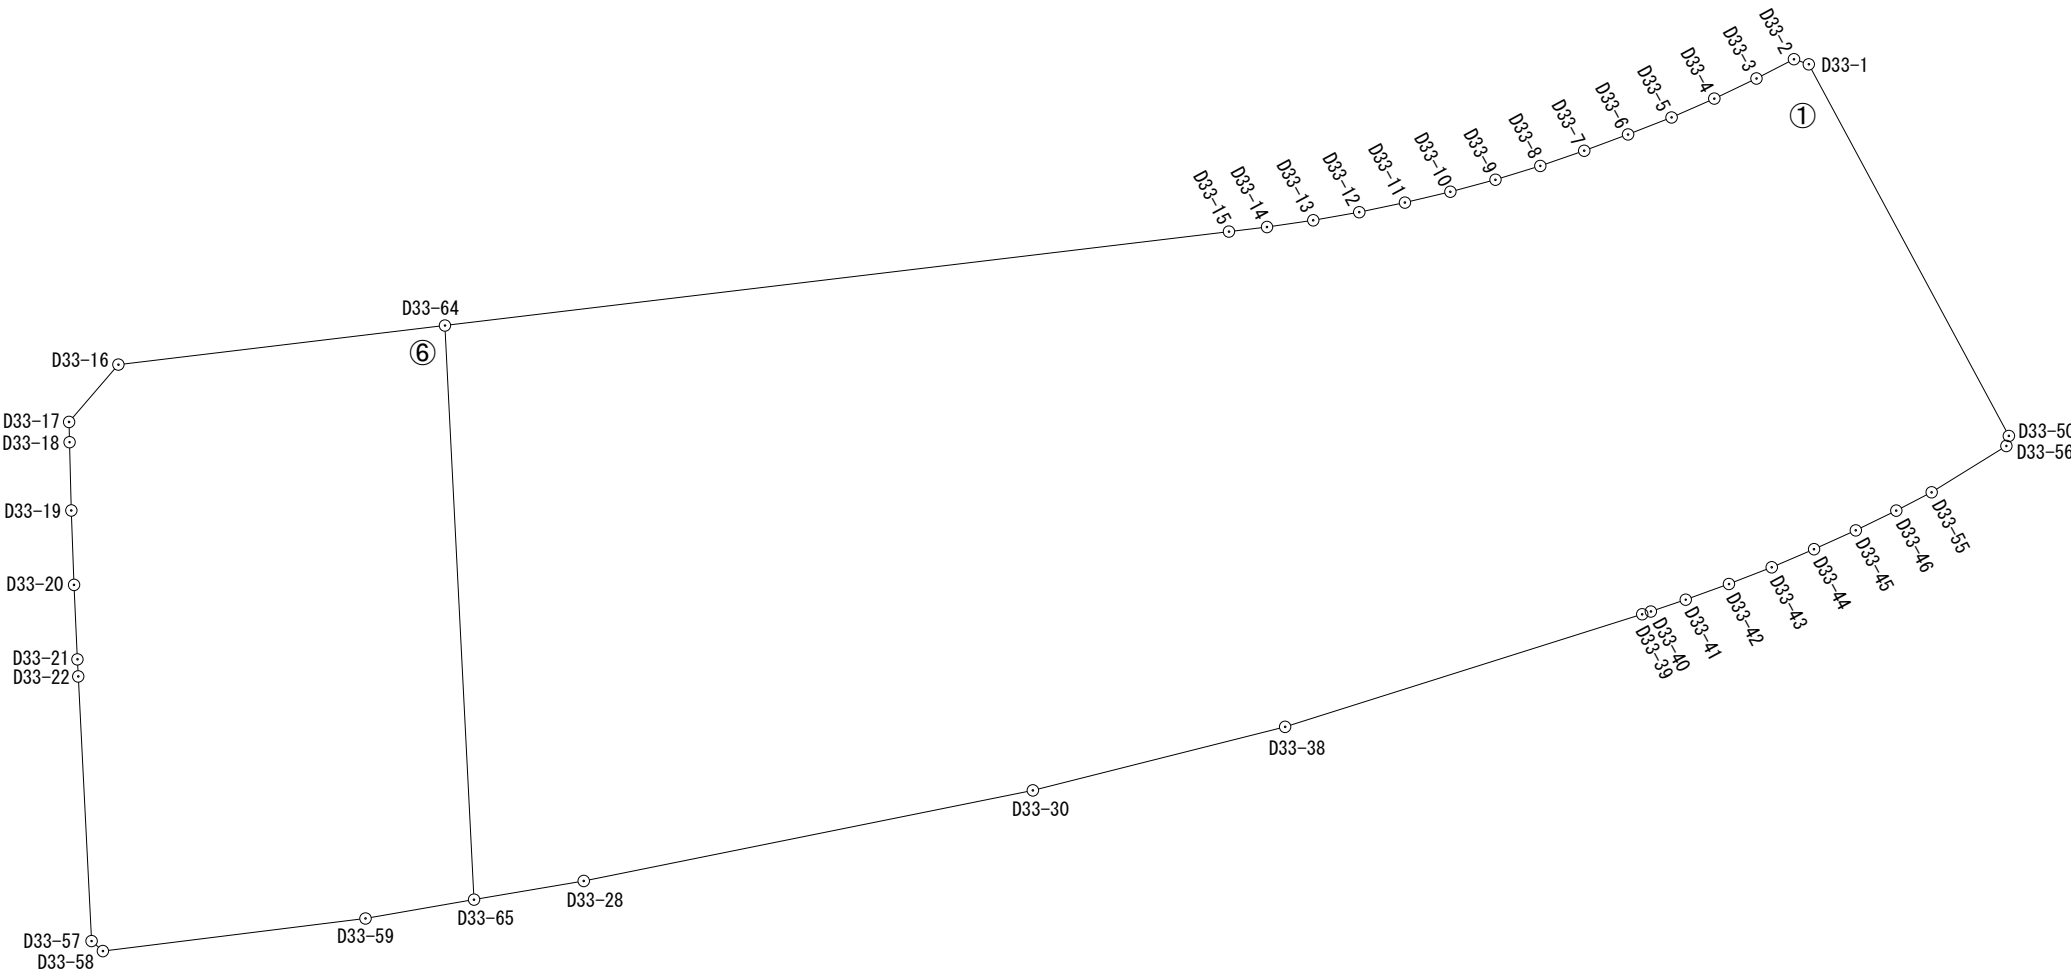


出来形確認測量図（縮尺１：５００）

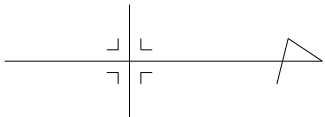

座 標 一 覧 表

測 点 名	X 座 標	Y 座 標
D33-1	61840.796	-6655.614
D33-2	61839.818	-6655.945
D33-3	61837.336	-6654.673
D33-4	61834.547	-6653.343
D33-5	61831.720	-6652.096
D33-6	61828.843	-6650.969
D33-7	61825.944	-6649.898
D33-8	61823.037	-6648.893
D33-9	61820.072	-6647.977
D33-10	61817.089	-6647.181
D33-11	61814.082	-6646.467
D33-12	61811.060	-6645.830
D33-13	61808.016	-6645.298
D33-14	61804.957	-6644.853
D33-15	61802.444	-6644.547
D33-16	61728.983	-6635.749
D33-17	61725.718	-6631.964
D33-18	61725.752	-6630.622
D33-19	61725.865	-6626.106
D33-20	61726.048	-6621.187

測 点 名	X 座 標	Y 座 標
D33-21	61726.273	-6616.263
D33-22	61726.329	-6615.129
D33-28	61759.761	-6601.607
D33-30	61789.472	-6607.597
D33-38	61806.158	-6611.799
D33-39	61829.775	-6619.241
D33-40	61830.354	-6619.428
D33-41	61832.656	-6620.208
D33-42	61835.516	-6621.243
D33-43	61838.349	-6622.352
D33-44	61841.144	-6623.547
D33-45	61843.907	-6624.794
D33-46	61846.580	-6626.097
D33-50	61854.030	-6631.038
D33-55	61848.921	-6627.306
D33-56	61853.869	-6630.370
D33-57	61727.205	-6597.630
D33-58	61727.959	-6596.974
D33-59	61745.329	-6599.125
D33-64	61750.583	-6638.335
D33-65	61752.510	-6600.372

凡 例	
	施工地区界
	道 路
	街区番号
	画地番号
D14-1	計 算 点
D14-2	境界標あり

平成25年 3月 2日測量
平成25年 2月 4日測量
平成24年 4月12日測量

面積（座標法）計算書

地 番： 33D-1

測点名	[1] X(i)	[2] X(i+1)-X(i-1)	[3] Y(i)	[4] Y(i+1)-Y(i-1)	[2]*[3]	[1]*[4]	方向角	夾 角	距 離
D33-64	61750.583	-49.934	-6638.335	44.175	331478.619890	2727832.004025	87-05-39	93-55-29	38.012
D33-65	61752.510	9.178	-6600.372	36.728	-60578.214216	2268046.187280	350-20-03	83-14-24	7.355
D33-28	61759.761	36.962	-6601.607	-7.225	-244008.597934	-446214.273225	348-36-05	178-16-02	30.309
D33-30	61789.472	46.397	-6607.597	-10.192	-306572.678009	-629758.298624	345-51-55	177-15-50	17.207
D33-38	61806.158	40.303	-6611.799	-11.644	-266475.335097	-719670.903752	342-30-35	176-38-40	24.762
D33-39	61829.775	24.196	-6619.241	-7.629	-160159.155236	-471699.353475	342-06-04	179-35-29	0.608
D33-40	61830.354	2.881	-6619.428	-0.967	-19070.572068	-59789.952318	341-16-54	179-10-50	2.431
D33-41	61832.656	5.162	-6620.208	-1.815	-34173.513696	-112226.270640	340-06-19	178-49-25	3.042
D33-42	61835.516	5.693	-6621.243	-2.144	-37694.736399	-132575.346304	338-37-18	178-30-59	3.042
D33-43	61838.349	5.628	-6622.352	-2.304	-37270.597056	-142475.556096	336-51-03	178-13-45	3.040
D33-44	61841.144	5.558	-6623.547	-2.442	-36813.674226	-151016.073648	335-42-34	178-51-31	3.031
D33-45	61843.907	5.436	-6624.794	-2.550	-36012.380184	-157701.962850	334-00-44	178-18-10	2.974
D33-46	61846.580	5.014	-6626.097	-2.512	-33223.250358	-155358.608960	332-41-10	178-40-26	2.635
D33-55	61848.921	7.289	-6627.306	-4.273	-48306.433434	-264280.439433	328-13-57	175-32-47	5.820
D33-56	61853.869	5.109	-6630.370	-3.732	-33874.560330	-230838.639108	283-33-03	135-19-06	0.687
D33-50	61854.030	-13.073	-6631.038	-25.244	86687.559774	-1561443.133320	241-41-52	138-08-49	27.913
D33-1	61840.796	-14.212	-6655.614	-24.907	94589.586168	-1540268.705972	198-41-53	137-00-01	1.032
D33-2	61839.818	-3.460	-6655.945	0.941	23029.569700	58191.268738	152-51-55	134-10-02	2.789
D33-3	61837.336	-5.271	-6654.673	2.602	35076.781383	160900.748272	154-30-17	181-38-22	3.090
D33-4	61834.547	-5.616	-6653.343	2.577	37365.174288	159347.627619	156-11-51	181-41-34	3.090
D33-5	61831.720	-5.704	-6652.096	2.374	37943.555584	146788.503280	158-36-30	182-24-39	3.090
D33-6	61828.843	-5.776	-6650.969	2.198	38415.996944	135899.796914	159-43-26	181-06-56	3.091
D33-7	61825.944	-5.806	-6649.898	2.076	38609.307788	128350.659744	160-55-44	181-12-18	3.076
D33-8	61823.037	-5.872	-6648.893	1.921	39042.299696	118762.054077	162-49-56	181-54-12	3.103
D33-9	61820.072	-5.948	-6647.977	1.712	39542.167196	105835.963264	165-03-32	182-13-36	3.087
D33-10	61817.089	-5.990	-6647.181	1.510	39816.614190	93343.804390	166-38-34	181-35-02	3.091
D33-11	61814.082	-6.029	-6646.467	1.351	40071.549543	83510.824782	168-05-49	181-27-15	3.088
D33-12	61811.060	-6.066	-6645.830	1.169	40313.604780	72257.129140	170-05-12	181-59-23	3.090
D33-13	61808.016	-6.103	-6645.298	0.977	40556.253694	60386.431632	171-43-23	181-38-11	3.091
D33-14	61804.957	-5.572	-6644.853	0.751	37025.120916	46415.522707	173-03-27	181-20-04	2.532

面積（座標法）計算書

地番：33D-1

測点名	[1] X(i)	[2] X(i+1)-X(i-1)	[3] Y(i)	[4] Y(i+1)-Y(i-1)	[2]*[3]	[1]*[4]	方向角	夾角	距離
D33-15	61802.444	-54.374	-6644.547	6.518	361290.598578	402828.329992	173-10-10	180-06-43	52.232
合計				倍面積	6620.661869	-6620.661869			265.440
				面積	3310.3309345	3310.3309345			
				坪数	1001.37	1001.37			

面積（座標法）計算書

地番： 33D-6

測点名	[1] X(i)	[2] X(i+1)-X(i-1)	[3] Y(i)	[4] Y(i+1)-Y(i-1)	[2]*[3]	[1]*[4]	方向角	夾角	距離
D33-16	61728.983	-24.865	-6635.749	6.371	164997.898885	393275.350693	130-46-54	137-36-31	4.999
D33-17	61725.718	-3.231	-6631.964	5.127	21427.875684	316467.756186	88-32-55	137-46-01	1.342
D33-18	61725.752	0.147	-6630.622	5.858	-974.701434	361589.455216	88-34-00	180-01-05	4.517
D33-19	61725.865	0.296	-6626.106	9.435	-1961.327376	582383.536275	87-52-10	179-18-10	4.922
D33-20	61726.048	0.408	-6621.187	9.843	-2701.444296	607569.490464	87-23-01	179-30-51	4.929
D33-21	61726.273	0.281	-6616.263	6.058	-1859.169903	373937.761834	87-10-22	179-47-21	1.135
D33-22	61726.329	0.932	-6615.129	18.633	-6165.300228	1150146.688257	87-08-03	179-57-41	17.521
D33-57	61727.205	1.630	-6597.630	18.155	-10754.136900	1120657.406775	41-01-27	133-53-24	0.999
D33-58	61727.959	18.124	-6596.974	-1.495	-119563.556776	-92283.298705	352-56-27	131-55-00	17.503
D33-59	61745.329	24.551	-6599.125	-3.398	-162015.117875	-209810.627942	350-08-55	177-12-28	7.288
D33-65	61752.510	5.254	-6600.372	-39.210	-34678.354488	-2421315.917100	267-05-39	96-56-44	38.012
D33-64	61750.583	-23.527	-6638.335	-35.377	156180.107545	-2184550.374791	173-10-23	86-04-44	21.754
合計				倍面積	1932.772838	-1932.772838			124.921
				面積	966.3864190	966.3864190			
				坪数	292.33	292.33			