
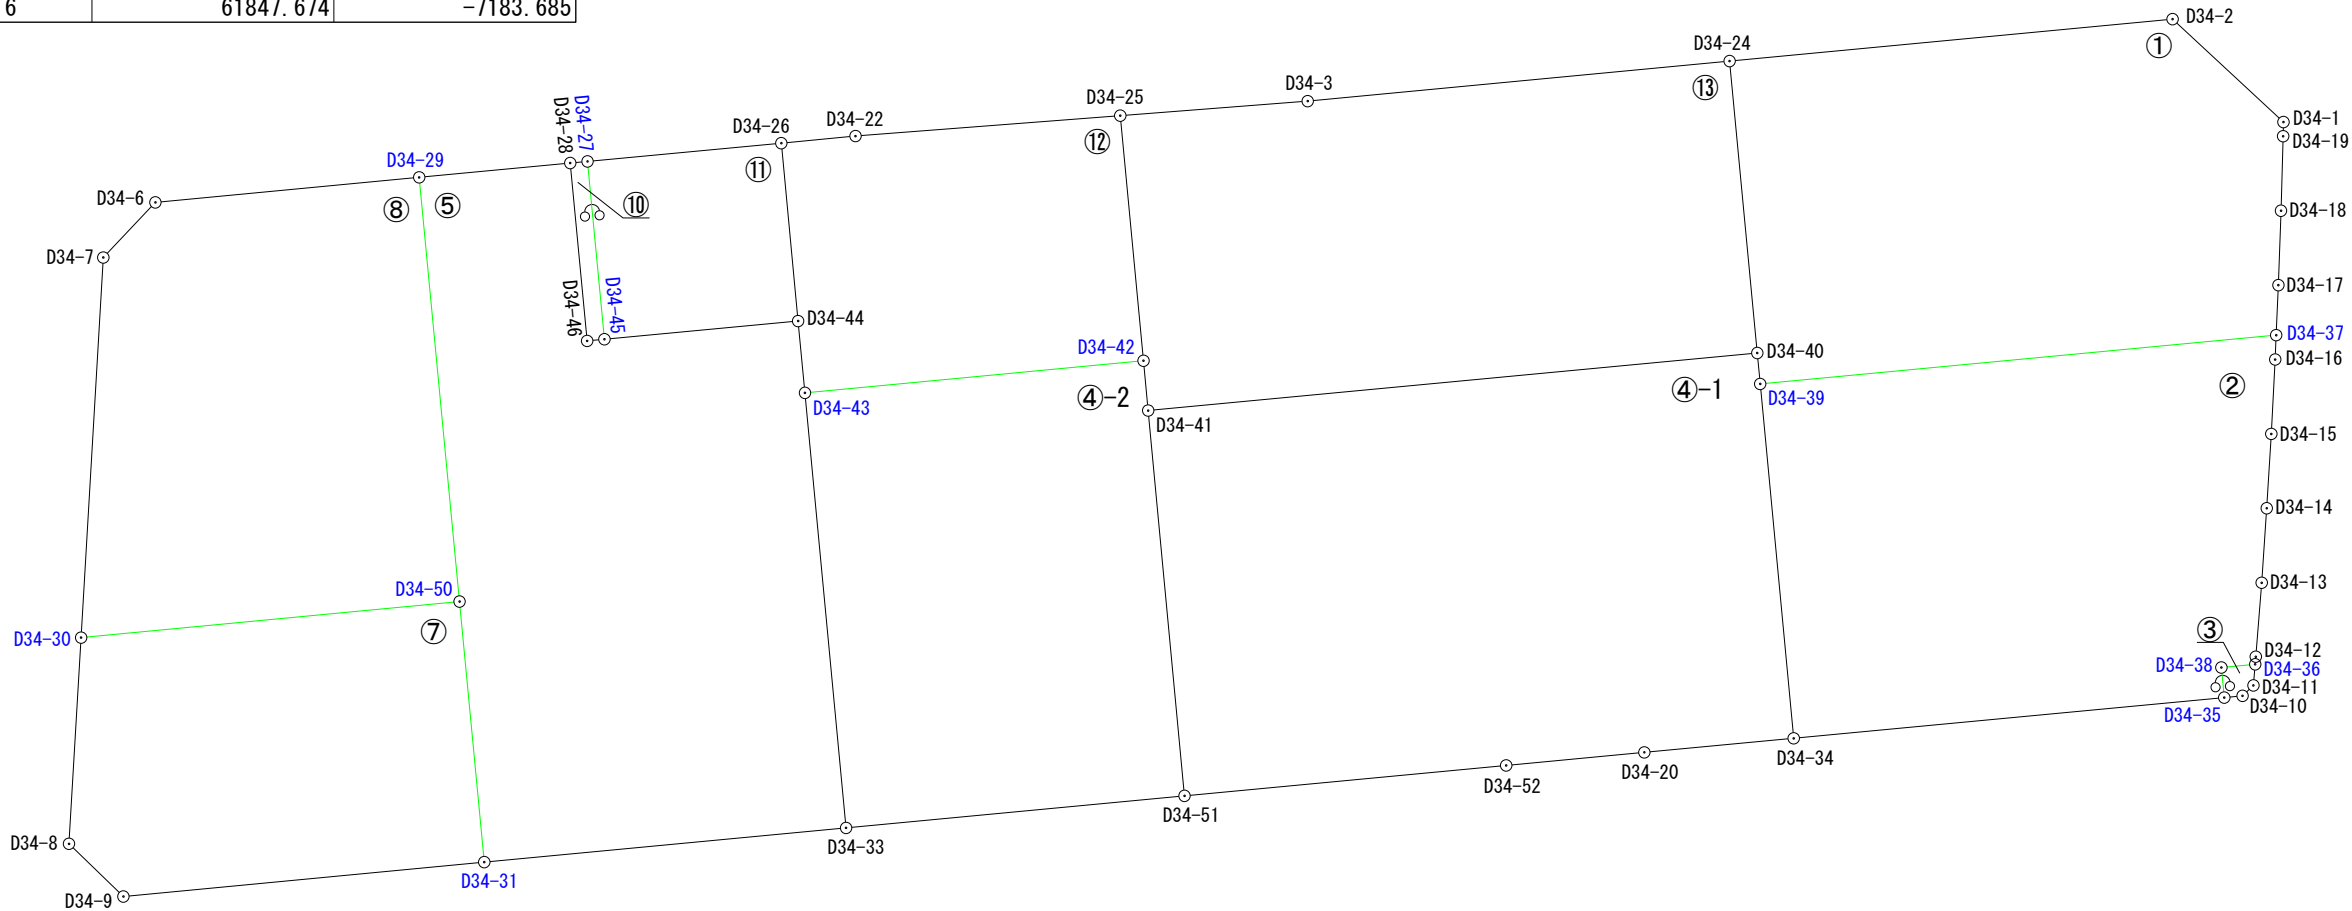



座 標 一 覧 表		
測 点 名	X 座 標	Y 座 標
D34-1	61848.224	-7199.391
D34-2	61840.887	-7206.197
D34-3	61783.681	-7200.768
D34-6	61707.456	-7194.074
D34-7	61704.010	-7190.428
D34-8	61701.742	-7151.662
D34-9	61705.340	-7148.173
D34-10	61845.517	-7161.443
D34-11	61846.235	-7162.137
D34-12	61846.390	-7164.029
D34-13	61846.781	-7168.917
D34-14	61847.115	-7173.849
D34-15	61847.417	-7178.765
D34-16	61847.674	-7183.685

出来形確認測量図（縮尺1：500）

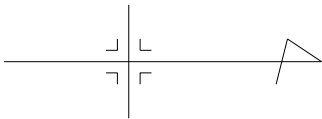

測 点 名	X 座 標	Y 座 標
D34-17	61847.885	-7188.606
D34-18	61848.063	-7193.525
D34-19	61848.200	-7198.452
D34-20	61805.945	-7157.704
D34-22	61753.767	-7198.458
D34-24	61811.585	-7203.421
D34-25	61771.283	-7199.807
D34-26	61748.863	-7197.992
D34-27	61736.040	-7196.785
D34-28	61734.896	-7196.678
D34-29	61724.908	-7195.730
D34-30	61702.539	-7165.293
D34-31	61729.214	-7150.448
D34-33	61753.141	-7152.709
D34-34	61815.825	-7158.637

測 点 名	X 座 標	Y 座 標
D34-35	61844.304	-7161.329
D34-36	61846.349	-7163.531
D34-37	61847.743	-7185.296
D34-38	61844.116	-7163.320
D34-39	61813.610	-7182.071
D34-40	61813.417	-7184.112
D34-41	61773.128	-7180.310
D34-42	61772.817	-7183.602
D34-43	61750.421	-7181.481
D34-44	61749.972	-7186.228
D34-45	61737.159	-7185.024
D34-46	61736.015	-7184.917
D34-50	61727.575	-7167.681
D34-51	61775.531	-7154.830
D34-52	61796.808	-7156.840

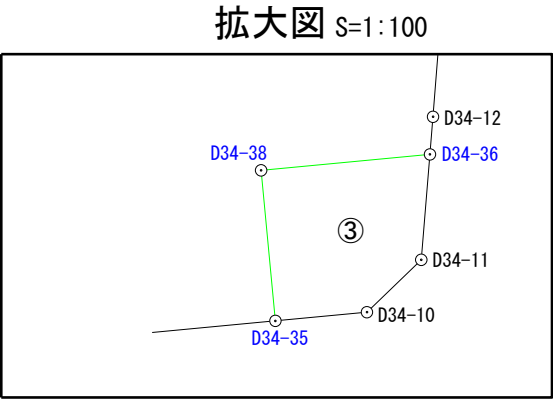

平成25年 3月11日測量
平成24年10月 2日測量
平成24年 1月26日測量
平成23年11月22日測量
平成23年11月21日測量

凡 例	
	施工地区界
	道 路
	街区番号
	画地番号
D14-1	計 算 点
D14-2	境界標あり

面積（座標法）計算書

地番：34D-1

測点名	[1] X(i)	[2] X(i+1)-X(i-1)	[3] Y(i)	[4] Y(i+1)-Y(i-1)	[2]*[3]	[1]*[4]	方向角	夾角	距離
D34-24	61811.585	-27.470	-7203.421	22.085	197877.974870	1365108.854725	84-34-48	89-59-31	19.396
D34-40	61813.417	2.025	-7184.112	21.350	-14547.826800	1319716.452950	84-35-53	180-01-05	2.050
D34-39	61813.610	34.326	-7182.071	-1.184	-246531.769146	-73187.314240	354-36-09	90-00-16	34.285
D34-37	61847.743	34.275	-7185.296	-6.535	-246276.020400	-404175.000505	272-27-23	97-51-14	3.313
D34-17	61847.885	0.320	-7188.606	-8.229	-2300.353920	-508946.245665	272-04-21	179-36-58	4.922
D34-18	61848.063	0.315	-7193.525	-9.846	-2265.960375	-608956.028298	271-35-34	179-31-13	4.929
D34-19	61848.200	0.161	-7198.452	-5.866	-1158.950772	-362801.541200	271-27-51	179-52-17	0.939
D34-1	61848.224	-7.313	-7199.391	-7.745	52649.146383	-479014.494880	222-50-59	131-23-08	10.008
D34-2	61840.887	-36.639	-7206.197	-4.030	264027.851883	-249218.774610	174-35-17	131-44-18	29.433
合計				倍面積	1474.091723	-1474.091723			109.275
				面積	737.0458615	737.0458615			
				坪数	222.95	222.95			

面積（座標法）計算書

地 番： 34D-2

測点名	[1] X(i)	[2] X(i+1)-X(i-1)	[3] Y(i)	[4] Y(i+1)-Y(i-1)	[2]*[3]	[1]*[4]	方向角	夾 角	距 離
D34-39	61813.610	-31.918	-7182.071	26.659	229237.342178	1647889.028990	84-36-01	89-59-52	23.538
D34-34	61815.825	30.694	-7158.637	20.742	-219727.204078	1282183.842150	354-36-00	89-59-59	28.606
D34-35	61844.304	28.291	-7161.329	-4.683	-202601.158739	-289616.875632	264-36-21	90-00-21	2.000
D34-38	61844.116	2.045	-7163.320	-2.202	-14648.989400	-136180.743432	354-36-07	269-59-46	2.243
D34-36	61846.349	2.274	-7163.531	-0.709	-16289.869494	-43849.061441	274-42-23	100-06-16	0.500
D34-12	61846.390	0.432	-7164.029	-5.386	-3094.860528	-333104.656540	274-34-24	179-52-01	4.904
D34-13	61846.781	0.725	-7168.917	-9.820	-5197.464825	-607335.389420	273-52-27	179-18-03	4.943
D34-14	61847.115	0.636	-7173.849	-9.848	-4562.567964	-609070.388520	273-30-55	179-38-28	4.925
D34-15	61847.417	0.559	-7178.765	-9.836	-4012.929635	-608331.193612	272-59-25	179-28-30	4.927
D34-16	61847.674	0.326	-7183.685	-6.531	-2341.881310	-403927.158894	272-27-09	179-27-44	1.612
D34-37	61847.743	-34.064	-7185.296	1.614	244759.922944	99822.257202	174-36-09	82-09-00	34.285
合計				倍面積	1520.339149	-1520.339149			112.483
				面 積	760.1695745	760.1695745			
				坪 数	229.95	229.95			

面積（座標法）計算書

地番：34D-3

測点名	[1] X(i)	[2] X(i+1)-X(i-1)	[3] Y(i)	[4] Y(i+1)-Y(i-1)	[2]*[3]	[1]*[4]	方向角	夾角	距離
D34-38	61844.116	-2.045	-7163.320	2.202	14648.989400	136180.743432	84-36-21	90-00-14	2.000
D34-35	61844.304	1.401	-7161.329	1.877	-10033.021929	116081.758608	354-37-52	90-01-31	1.218
D34-10	61845.517	1.931	-7161.443	-0.808	-13828.746433	-49971.177736	315-58-26	141-20-34	0.999
D34-11	61846.235	0.832	-7162.137	-2.088	-5958.897984	-129134.938680	274-40-31	138-42-05	1.399
D34-36	61846.349	-2.119	-7163.531	-1.183	15179.522189	-73164.230867	174-36-07	79-55-36	2.243
合計				倍面積	7.845243	-7.845243			7.859
				面積	3.9226215	3.9226215			
				坪数	1.18	1.18			

面積（座標法）計算書

地 番： 34D-4-1

測点名	[1] X(i)	[2] X(i+1)-X(i-1)	[3] Y(i)	[4] Y(i+1)-Y(i-1)	[2]*[3]	[1]*[4]	方向角	夾 角	距 離
D34-41	61773.128	-37.886	-7180.310	29.282	272033.224660	1808840.734096	84-36-45	90-00-12	25.593
D34-51	61775.531	23.680	-7154.830	23.470	-169426.374400	1449871.712570	354-36-12	89-59-27	21.372
D34-52	61796.808	30.414	-7156.840	-2.874	-217668.131760	-177604.026192	354-35-53	179-59-41	9.178
D34-20	61805.945	19.017	-7157.704	-1.797	-136118.056968	-111065.283165	354-36-19	180-00-26	9.924
D34-34	61815.825	7.665	-7158.637	-24.367	-54870.952605	-1506266.207775	264-36-01	89-59-42	23.538
D34-39	61813.610	-2.408	-7182.071	-25.475	17294.426968	-1574701.714750	264-35-53	179-59-52	2.050
D34-40	61813.417	-40.482	-7184.112	1.761	290827.221984	108853.427337	174-36-33	90-00-40	40.468
合計				倍面積	2071.357879	-2071.357879			132.123
				面 積	1035.6789395	1035.6789395			
				坪 数	313.29	313.29			

面積（座標法）計算書

地 番： 34D-4-2

測点名	[1] X(i)	[2] X(i+1)-X(i-1)	[3] Y(i)	[4] Y(i+1)-Y(i-1)	[2]*[3]	[1]*[4]	方向角	夾 角	距 離
D34-43	61750.421	-19.676	-7181.481	30.893	141302.820156	1907655.755953	84-35-58	90-00-34	28.900
D34-33	61753.141	25.110	-7152.709	26.651	-179604.522990	1645782.960791	354-35-19	89-59-21	22.490
D34-51	61775.531	19.987	-7154.830	-27.601	-143003.587210	-1705066.431131	264-36-45	90-01-26	25.593
D34-41	61773.128	-2.714	-7180.310	-28.772	19487.361340	-1777336.438816	264-36-12	179-59-27	3.307
D34-42	61772.817	-22.707	-7183.602	-1.171	163118.050614	-72335.968707	174-35-24	89-59-12	22.496
合計				倍面積	1300.121910	-1300.121910			102.786
				面 積	650.0609550	650.0609550			
				坪 数	196.64	196.64			

面積（座標法）計算書

地番：34D-5

測点名	[1] X(i)	[2] X(i+1)-X(i-1)	[3] Y(i)	[4] Y(i+1)-Y(i-1)	[2]*[3]	[1]*[4]	方向角	夾角	距離
D34-29	61724.908	-7.321	-7195.730	28.997	52679.939330	1789837.157276	84-34-06	89-59-25	28.176
D34-50	61727.575	4.306	-7167.681	45.282	-30864.034386	2795148.051150	84-34-01	179-59-55	17.311
D34-31	61729.214	25.566	-7150.448	14.972	-182808.353568	924209.792008	354-36-07	90-02-06	24.034
D34-33	61753.141	21.207	-7152.709	-31.033	-151687.499763	-1916385.224653	264-35-58	89-59-51	28.900
D34-43	61750.421	-3.169	-7181.481	-33.519	22758.113289	-2069812.361499	264-35-48	179-59-50	4.768
D34-44	61749.972	-13.262	-7186.228	-3.543	95303.755736	-218780.150796	174-37-55	90-02-07	12.869
D34-45	61737.159	-13.957	-7185.024	1.311	100281.379968	80937.415449	174-39-24	180-01-29	1.149
D34-46	61736.015	-2.263	-7184.917	-11.654	16259.467171	-719471.518810	264-33-54	269-54-30	11.814
D34-28	61734.896	-11.107	-7196.678	-10.813	79933.502546	-667539.430448	174-34-41	90-00-47	10.033
合計				倍面積	1856.270323	-1856.270323			139.054
				面積	928.1351615	928.1351615			
				坪数	280.76	280.76			

面積（座標法）計算書

地番：34D-7

測点名	[1] X(i)	[2] X(i+1)-X(i-1)	[3] Y(i)	[4] Y(i+1)-Y(i-1)	[2]*[3]	[1]*[4]	方向角	夾角	距離
D34-30	61702.539	-25.833	-7165.293	16.019	185101.014069	988412.972241	93-20-47	98-47-42	13.654
D34-8	61701.742	2.801	-7151.662	17.120	-20031.805262	1056333.823040	44-07-08	130-46-21	5.012
D34-9	61705.340	27.472	-7148.173	1.214	-196374.608656	74910.282760	354-33-24	130-26-16	23.982
D34-31	61729.214	22.235	-7150.448	-19.508	-158990.211280	-1204213.506712	264-34-01	90-00-37	17.311
D34-50	61727.575	-26.675	-7167.681	-14.845	191197.890675	-916345.850875	174-33-05	89-59-04	25.150
合計				倍面積	902.279546	-902.279546			85.109
				面積	451.1397730	451.1397730			
				坪数	136.46	136.46			

面積（座標法）計算書

地番：34D-8

測点名	[1] X(i)	[2] X(i+1)-X(i-1)	[3] Y(i)	[4] Y(i+1)-Y(i-1)	[2]*[3]	[1]*[4]	方向角	夾角	距離
D34-6	61707.456	-20.898	-7194.074	5.302	150341.758452	327172.931712	133-23-05	138-48-19	5.017
D34-7	61704.010	-4.917	-7190.428	28.781	35355.334476	1775903.111810	93-20-58	139-57-53	25.178
D34-30	61702.539	23.565	-7165.293	22.747	-168850.129545	1403547.654633	354-33-05	81-12-07	25.150
D34-50	61727.575	22.369	-7167.681	-30.437	-160333.856289	-1878802.200275	264-34-06	90-01-01	28.176
D34-29	61724.908	-20.119	-7195.730	-26.393	144770.891870	-1629105.496844	174-34-46	90-00-40	17.530
合計				倍面積	1283.998964	-1283.998964			101.051
				面積	641.9994820	641.9994820			
				坪数	194.20	194.20			

面積（座標法）計算書

地番：34D-10

測点名	[1] X(i)	[2] X(i+1)-X(i-1)	[3] Y(i)	[4] Y(i+1)-Y(i-1)	[2]*[3]	[1]*[4]	方向角	夾角	距離
D34-28	61734.896	-0.025	-7196.678	11.868	179.916950	732669.745728	84-33-54	89-54-30	11.814
D34-46	61736.015	2.263	-7184.917	11.654	-16259.467171	719471.518810	354-39-24	90-05-30	1.149
D34-45	61737.159	0.025	-7185.024	-11.868	-179.625600	-732696.603012	264-33-54	89-54-30	11.814
D34-27	61736.040	-2.263	-7196.785	-11.654	16286.324455	-719471.810160	174-39-24	90-05-30	1.149
合計				倍面積	27.148634	-27.148634			25.926
				面積	13.5743170	13.5743170			
				坪数	4.10	4.10			

面積（座標法）計算書

地番：34D-11

測点名	[1] X(i)	[2] X(i+1)-X(i-1)	[3] Y(i)	[4] Y(i+1)-Y(i-1)	[2]*[3]	[1]*[4]	方向角	夾角	距離
D34-27	61736.040	-11.704	-7196.785	12.968	84231.171640	800592.966720	84-33-54	89-56-32	11.814
D34-45	61737.159	13.932	-7185.024	10.557	-100101.754368	651759.187563	354-37-55	90-04-01	12.869
D34-44	61749.972	11.704	-7186.228	-12.968	-84107.612512	-800773.636896	264-36-53	89-58-58	11.816
D34-26	61748.863	-13.932	-7197.992	-10.557	100282.424544	-651882.746691	174-37-22	90-00-29	12.880
合計				倍面積	304.229304	-304.229304			49.379
				面積	152.1146520	152.1146520			
				坪数	46.01	46.01			

面積（座標法）計算書

地 番： 34D-12

測点名	[1] X(i)	[2] X(i+1)-X(i-1)	[3] Y(i)	[4] Y(i+1)-Y(i-1)	[2]*[3]	[1]*[4]	方向角	夾 角	距 離
D34-26	61748.863	-3.795	-7197.992	12.230	27316.379640	755188.594490	84-36-53	90-02-35	11.816
D34-44	61749.972	1.558	-7186.228	16.511	-11196.143224	1019553.787692	84-35-48	179-58-55	4.768
D34-43	61750.421	22.845	-7181.481	2.626	-164060.933445	162156.605546	354-35-24	89-59-36	22.496
D34-42	61772.817	20.862	-7183.602	-18.326	-149864.304924	-1132048.644342	264-35-33	90-00-09	16.277
D34-25	61771.283	-19.050	-7199.807	-14.856	137156.323350	-917674.180248	175-35-46	91-00-13	17.568
D34-22	61753.767	-22.420	-7198.458	1.815	161389.428360	112083.087105	174-34-18	178-58-32	4.926
合計				倍面積	740.749757	-740.749757			77.851
				面 積	370.3748785	370.3748785			
				坪 数	112.03	112.03			

面積（座標法）計算書

地 番： 34D-13

測点名	[1] X(i)	[2] X(i+1)-X(i-1)	[3] Y(i)	[4] Y(i+1)-Y(i-1)	[2]*[3]	[1]*[4]	方向角	夾 角	距 離
D34-25	61771.283	-10.864	-7199.807	17.166	78218.703248	1060365.843978	84-35-33	89-01-29	16.277
D34-42	61772.817	1.845	-7183.602	19.497	-13253.745690	1204384.613049	84-36-12	180-00-39	3.307
D34-41	61773.128	40.600	-7180.310	-0.510	-291520.586000	-31504.295280	354-36-33	90-00-21	40.468
D34-40	61813.417	38.457	-7184.112	-23.111	-276279.395184	-1428569.880287	264-34-48	89-58-15	19.396
D34-24	61811.585	-29.736	-7203.421	-16.656	214200.926856	-1029533.759760	174-34-08	89-59-20	28.030
D34-3	61783.681	-40.302	-7200.768	3.614	290205.351936	223286.223134	175-34-04	180-59-56	12.435
合計				倍面積	1571.255166	-1571.255166			119.913
				面 積	785.6275830	785.6275830			
				坪 数	237.65	237.65			

面積（座標法）計算書

地 番： 34D-13-1

測点名	[1] X(i)	[2] X(i+1)-X(i-1)	[3] Y(i)	[4] Y(i+1)-Y(i-1)	[2]*[3]	[1]*[4]	方向角	夾 角	距 離
D34-25	61771.283	-10.864	-7199.807	17.166	78218.703248	1060365.843978	84-35-33	89-01-29	16.277
D34-42	61772.817	1.845	-7183.602	19.497	-13253.745690	1204384.613049	84-36-12	180-00-39	3.307
D34-41	61773.128	20.429	-7180.310	1.393	-146686.552990	86049.967304	354-36-28	90-00-16	20.207
D34-54	61793.246	18.288	-7182.209	-21.193	-131348.238192	-1309584.262478	264-34-55	89-58-27	19.381
D34-53	61791.416	-9.565	-7201.503	-18.559	68882.376195	-1146786.889544	174-34-19	89-59-24	7.770
D34-3	61783.681	-20.133	-7200.768	1.696	144973.062144	104785.122976	175-34-04	180-59-45	12.435
合計				倍面積	785.604715	-785.604715			79.377
				面 積	392.8023575	392.8023575			
				坪 数	118.82	118.82			

面積（座標法）計算書

地番：34D-13-2

測点名	[1] X(i)	[2] X(i+1)-X(i-1)	[3] Y(i)	[4] Y(i+1)-Y(i-1)	[2]*[3]	[1]*[4]	方向角	夾角	距離
D34-53	61791.416	-18.339	-7201.503	21.212	132068.363517	1310719.516192	84-34-55	90-00-51	19.381
D34-54	61793.246	22.001	-7182.209	17.391	-158015.780209	1074646.341186	354-36-38	90-01-43	20.261
D34-40	61813.417	18.339	-7184.112	-21.212	-131749.429968	-1311186.201404	264-34-48	89-58-10	19.396
D34-24	61811.585	-22.001	-7203.421	-17.391	158482.465421	-1074965.274735	174-34-04	89-59-16	20.260
合計				倍面積	785.618761	-785.618761			79.298
				面積	392.8093805	392.8093805			
				坪数	118.82	118.82			