


出来形確認測量図（縮尺1：500）

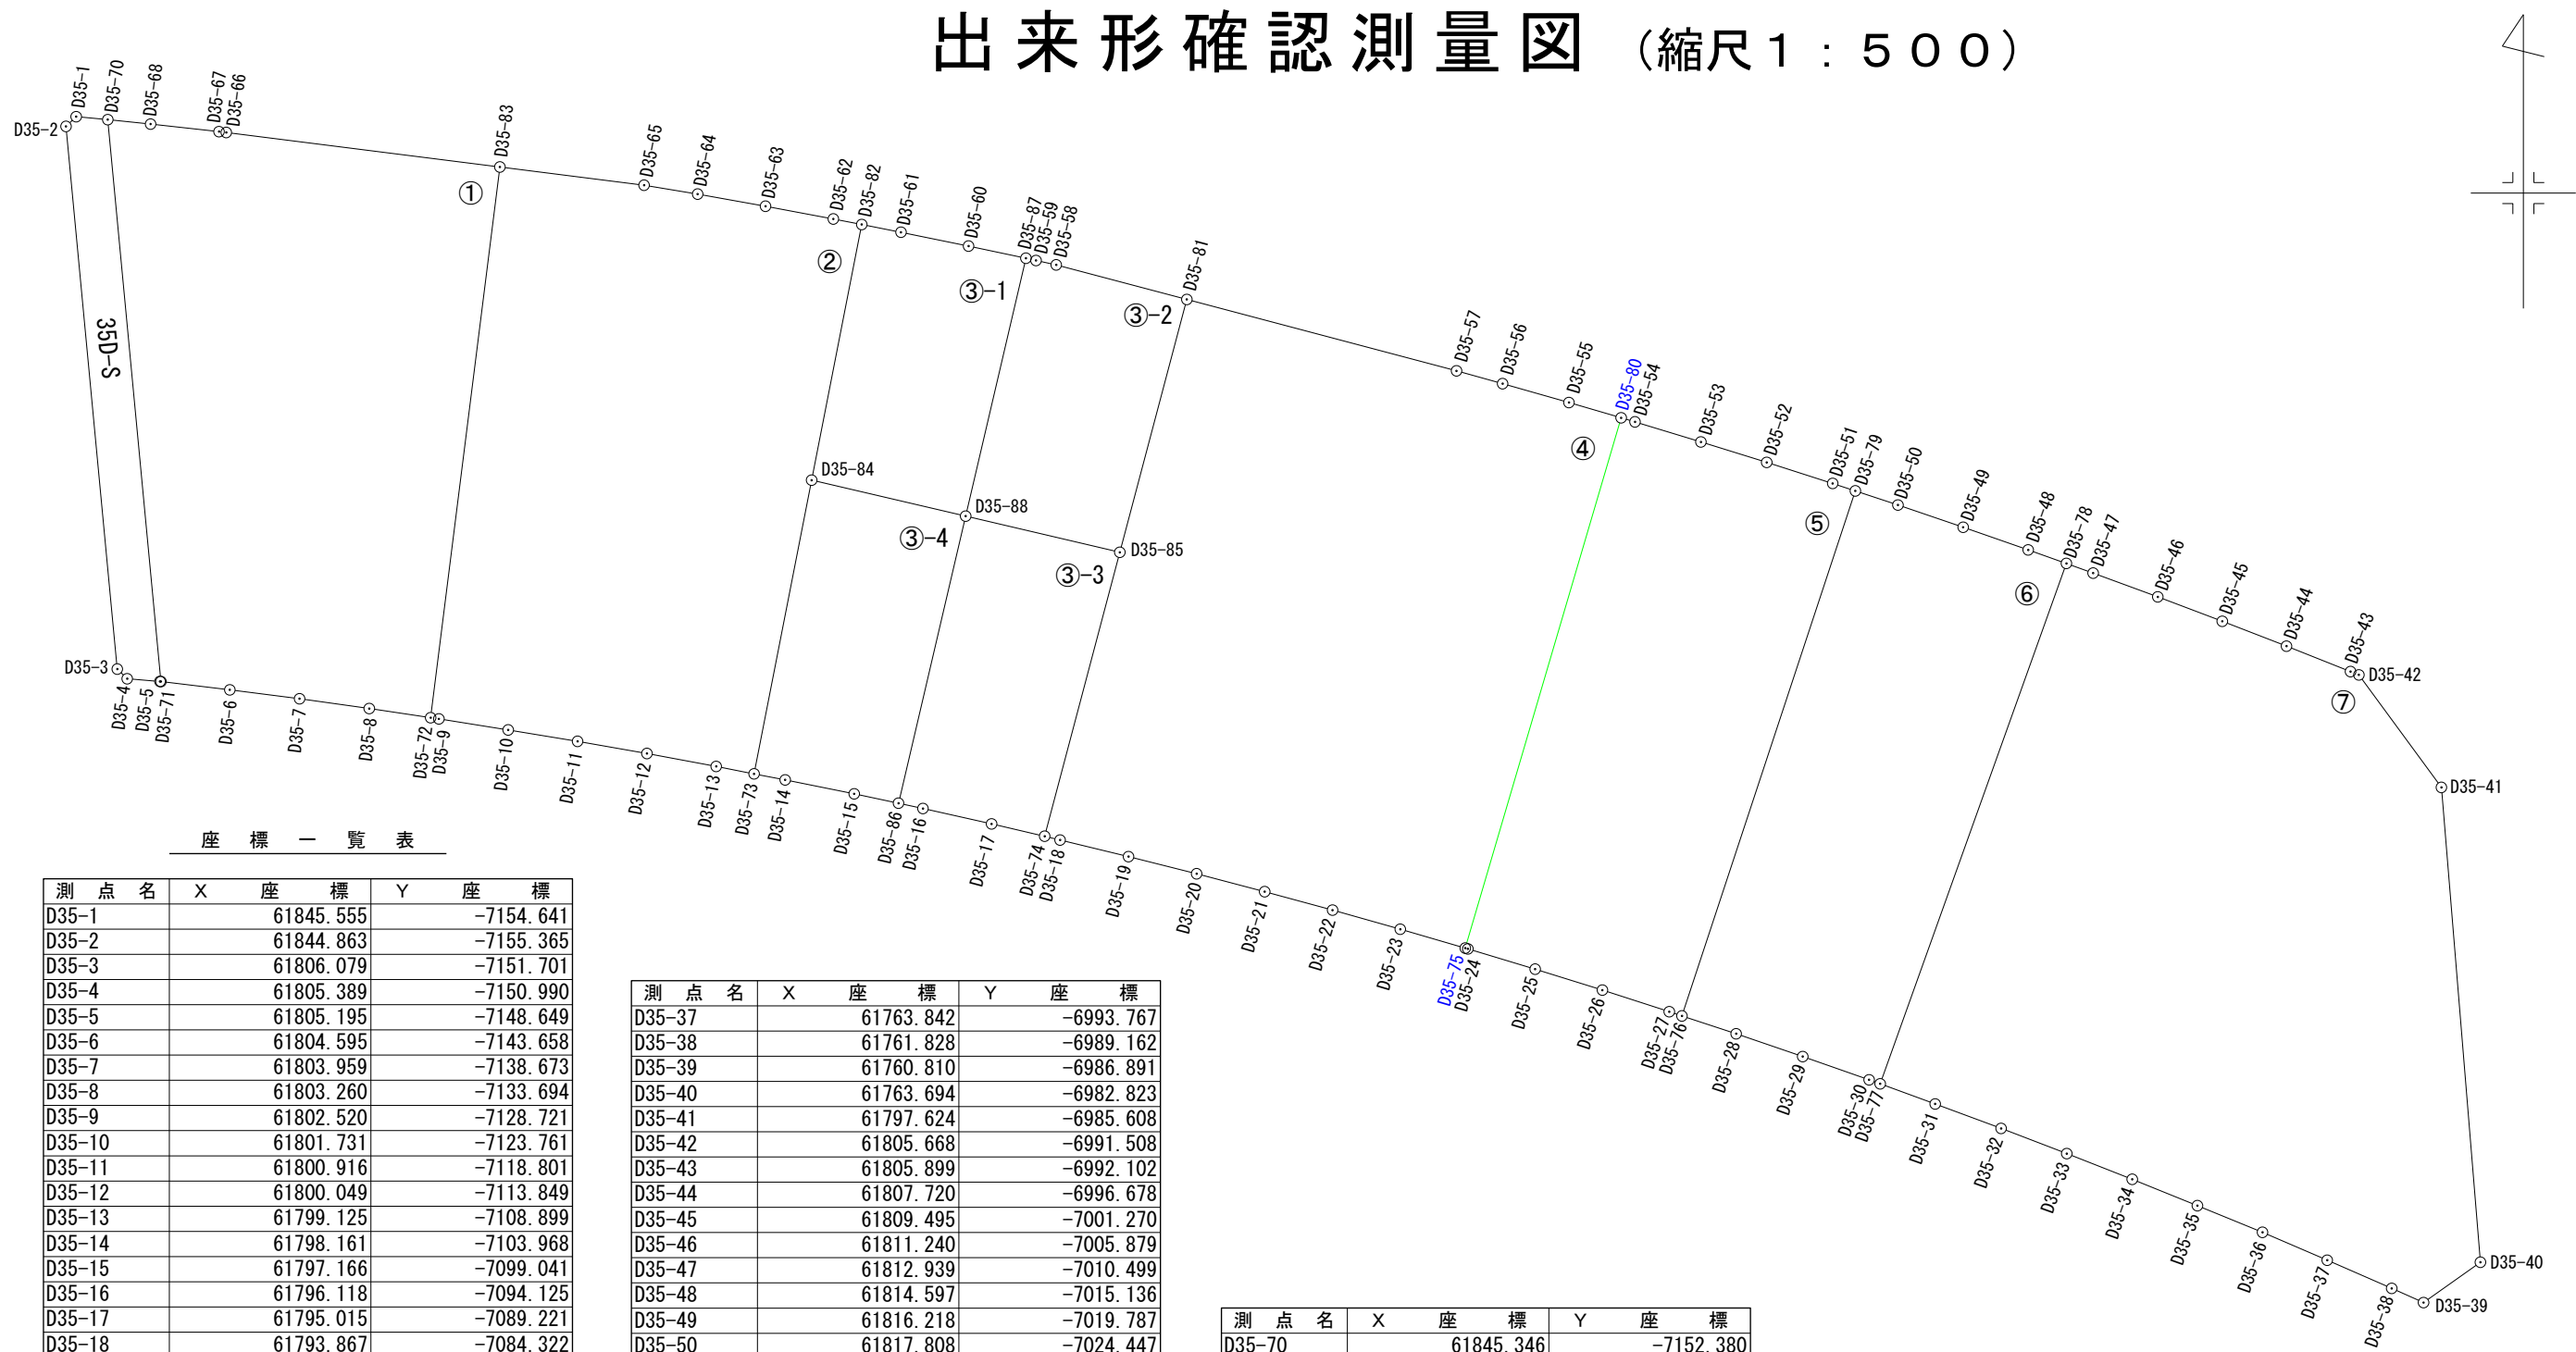

座 標 一 覧 表

測 点 名	X	座 標	Y	座 標
D35-1		61845.555		-7154.641
D35-2		61844.863		-7155.365
D35-3		61806.079		-7151.701
D35-4		61805.389		-7150.990
D35-5		61805.195		-7148.649
D35-6		61804.595		-7143.658
D35-7		61803.959		-7138.673
D35-8		61803.260		-7133.694
D35-9		61802.520		-7128.721
D35-10		61801.731		-7123.761
D35-11		61800.916		-7118.801
D35-12		61800.049		-7113.849
D35-13		61799.125		-7108.899
D35-14		61798.161		-7103.968
D35-15		61797.166		-7099.041
D35-16		61796.118		-7094.125
D35-17		61795.015		-7089.221
D35-18		61793.867		-7084.322
D35-19		61792.683		-7079.435
D35-20		61791.456		-7074.562
D35-21		61790.177		-7069.702
D35-22		61788.858		-7064.852
D35-23		61787.490		-7060.014
D35-24		61786.086		-7055.186
D35-25		61784.640		-7050.372
D35-26		61783.143		-7045.569
D35-27		61781.596		-7040.791
D35-28		61780.020		-7036.011
D35-29		61778.391		-7031.254
D35-30		61776.731		-7026.509
D35-31		61775.007		-7021.787
D35-32		61773.256		-7017.075
D35-33		61771.454		-7012.384
D35-34		61769.621		-7007.705
D35-35		61767.734		-7003.046
D35-36		61765.829		-6998.394

測 点 名	X	座 標	Y	座 標
D35-37		61763.842		-6993.767
D35-38		61761.828		-6989.162
D35-39		61760.810		-6986.891
D35-40		61763.694		-6982.823
D35-41		61797.624		-6985.608
D35-42		61805.668		-6991.508
D35-43		61805.899		-6992.102
D35-44		61807.720		-6996.678
D35-45		61809.495		-7001.270
D35-46		61811.240		-7005.879
D35-47		61812.939		-7010.499
D35-48		61814.597		-7015.136
D35-49		61816.218		-7019.787
D35-50		61817.808		-7024.447
D35-51		61819.346		-7029.115
D35-52		61820.851		-7033.821
D35-53		61822.313		-7038.528
D35-54		61823.744		-7043.238
D35-55		61825.130		-7047.958
D35-56		61826.474		-7052.700
D35-57		61827.389		-7055.994
D35-58		61834.964		-7084.601
D35-59		61835.283		-7086.044
D35-60		61836.309		-7090.866
D35-61		61837.296		-7095.694
D35-62		61838.248		-7100.531
D35-63		61839.155		-7105.376
D35-64		61840.024		-7110.226
D35-65		61840.662		-7114.056
D35-66		61844.426		-7143.910
D35-67		61844.485		-7144.427
D35-68		61845.026		-7149.317

測 点 名	X	座 標	Y	座 標
D35-70		61845.346		-7152.380
D35-71		61805.192		-7148.577
D35-72		61802.607		-7129.305
D35-73		61798.593		-7106.192
D35-74		61794.134		-7085.423
D35-75		61786.139		-7055.368
D35-76		61781.297		-7039.882
D35-77		61776.446		-7025.721
D35-78		61813.628		-7012.409
D35-79		61818.817		-7027.493
D35-80		61824.035		-7044.226
D35-81		61832.497		-7075.269
D35-82		61837.852		-7098.496
D35-83		61841.960		-7124.359
D35-84		61819.583		-7102.081
D35-85		61814.428		-7080.053
D35-86		61796.496		-7095.869
D35-87		61835.443		-7086.765
D35-88		61817.013		-7091.076

凡 例	
	施工地区界
	道 路
	街区番号
	画地番号
D14-1	計 算 点
D14-2	境界標あり

平成24年10月 2日測量
平成24年 9月28日測量
平成24年 1月26日測量
平成23年11月16日測量
平成23年11月15日測量
平成23年11月14日測量
平成23年11月10日測量
平成23年11月 9日測量

面積（座標法）計算書

地 番： 35D-1

測点名	[1] X(i)	[2] X(i+1)-X(i-1)	[3] Y(i)	[4] Y(i+1)-Y(i-1)	[2]*[3]	[1]*[4]	方向角	夾 角	距 離
D35-70	61845.346	-39.834	-7152.380	0.740	284907.904920	45765.556040	174-35-23	78-37-32	40.334
D35-71	61805.192	-40.751	-7148.577	8.722	291311.661327	539064.884624	96-55-12	102-19-49	4.955
D35-6	61804.595	-1.233	-7143.658	9.904	8808.130314	612112.708880	97-16-14	180-21-02	5.025
D35-7	61803.959	-1.335	-7138.673	9.964	9530.128455	615814.647476	97-59-29	180-43-15	5.028
D35-8	61803.260	-1.352	-7133.694	9.368	9644.754288	578972.939680	98-27-45	180-28-16	4.437
D35-72	61802.607	38.700	-7129.305	9.335	-275904.103500	576927.336345	7-09-49	88-42-04	39.663
D35-83	61841.960	41.819	-7124.359	-14.605	-297933.569021	-903201.825800	277-11-20	90-01-31	19.706
D35-66	61844.426	2.525	-7143.910	-20.068	-18038.372750	-1241093.940968	276-30-38	179-19-18	0.520
D35-67	61844.485	0.600	-7144.427	-5.407	-4286.656200	-334393.130395	276-18-47	179-48-09	4.920
D35-68	61845.026	0.861	-7149.317	-7.953	-6155.561937	-491853.491778	275-57-51	179-39-04	3.080
合計				倍面積	1884.315896	-1884.315896			127.668
				面積	942.1579480	942.1579480			
				坪 数	285.00	285.00			

面 積 (座 標 法) 計 算 書

地 番 : 35D-2

測点名	[1] X(i)	[2] X(i+1)-X(i-1)	[3] Y(i)	[4] Y(i+1)-Y(i-1)	[2]*[3]	[1]*[4]	方向角	夾 角	距 離
D35-83	61841.960	-38.055	-7124.359	-15.249	271117.481745	-943028.048040	187-09-49	89-58-59	39.663
D35-72	61802.607	-39.440	-7129.305	-4.362	281179.789200	-269582.971734	98-28-23	91-18-34	0.590
D35-9	61802.520	-0.876	-7128.721	5.544	6244.759596	342633.170880	99-02-18	180-33-55	5.022
D35-10	61801.731	-1.604	-7123.761	9.920	11426.512644	613073.171520	99-19-52	180-17-34	5.027
D35-11	61800.916	-1.682	-7118.801	9.912	11973.823282	612570.679392	99-55-51	180-35-59	5.027
D35-12	61800.049	-1.791	-7113.849	9.902	12740.903559	611944.085198	100-34-25	180-38-34	5.036
D35-13	61799.125	-1.456	-7108.899	7.657	10350.556944	473195.900125	101-07-07	180-32-42	2.759
D35-73	61798.593	20.458	-7106.192	6.818	-145378.475936	421342.807074	11-04-53	89-57-46	21.389
D35-84	61819.583	39.259	-7102.081	7.696	-278820.597979	475763.510768	11-06-08	180-01-15	18.617
D35-82	61837.852	18.665	-7098.496	1.550	-132493.427840	95848.670600	281-00-43	89-54-35	2.073
D35-62	61838.248	1.303	-7100.531	-6.880	-9251.991893	-425447.146240	280-36-12	179-35-29	4.929
D35-63	61839.155	1.776	-7105.376	-9.695	-12619.147776	-599530.607725	280-09-30	179-33-18	4.927
D35-64	61840.024	1.507	-7110.226	-8.680	-10715.110582	-536771.408320	279-27-27	179-17-57	3.883
D35-65	61840.662	1.936	-7114.056	-14.133	-13772.812416	-873994.076046	277-10-50	177-43-23	10.384
合計				倍面積	1982.262548	-1982.262548			129.326
				面 積	991.1312740	991.1312740			
				坪 数	299.81	299.81			

面積（座標法）計算書

地 番： 35D-3-1

測点名	[1] X(i)	[2] X(i+1)-X(i-1)	[3] Y(i)	[4] Y(i+1)-Y(i-1)	[2]*[3]	[1]*[4]	方向角	夾 角	距 離
D35-82	61837.852	-17.713	-7098.496	-6.387	125735.659648	-394958.360724	191-06-08	89-52-44	18.617
D35-84	61819.583	-20.839	-7102.081	7.420	148000.265959	458701.305860	103-08-41	92-02-33	11.301
D35-88	61817.013	15.860	-7091.076	15.316	-112464.465360	946789.371108	13-09-56	90-01-15	18.927
D35-87	61835.443	19.296	-7086.765	0.210	-136746.217440	12985.443030	281-55-26	88-45-30	4.191
D35-60	61836.309	1.853	-7090.866	-8.929	-13139.374698	-552136.403061	281-33-14	179-37-48	4.928
D35-61	61837.296	1.543	-7095.694	-7.630	-10948.655842	-471818.568480	281-13-24	179-40-10	2.857
合計				倍面積	437.212267	-437.212267			60.821
				面 積	218.6061335	218.6061335			
				坪 数	66.12	66.12			

面積（座標法）計算書

地 番： 35D-3-2

測点名	[1] X(i)	[2] X(i+1)-X(i-1)	[3] Y(i)	[4] Y(i+1)-Y(i-1)	[2]*[3]	[1]*[4]	方向角	夾 角	距 離
D35-87	61835.443	-18.270	-7086.765	-5.032	129475.196550	-311155.949176	193-09-56	90-39-13	18.927
D35-88	61817.013	-21.015	-7091.076	6.712	149018.962140	414915.791256	103-11-53	90-01-57	11.322
D35-85	61814.428	15.484	-7080.053	15.807	-109627.540652	977100.663396	14-49-46	91-37-53	18.692
D35-81	61832.497	20.536	-7075.269	-4.548	-145297.724184	-281214.196356	284-48-28	89-58-42	9.653
D35-58	61834.964	2.786	-7084.601	-10.775	-19737.698386	-666271.737100	282-27-57	177-39-29	1.478
D35-59	61835.283	0.479	-7086.044	-2.164	-3394.215076	-133811.552412	282-30-43	180-02-46	0.739
合計				倍面積	436.980392	-436.980392			60.811
				面 積	218.4901960	218.4901960			
				坪 数	66.09	66.09			

面積（座標法）計算書

地 番： 35D-3-3

測点名	[1] X(i)	[2] X(i+1)-X(i-1)	[3] Y(i)	[4] Y(i+1)-Y(i-1)	[2]*[3]	[1]*[4]	方向角	夾 角	距 離
D35-88	61817.013	-17.932	-7091.076	-15.816	127157.174832	-977697.877608	193-08-57	89-57-04	21.069
D35-86	61796.496	-20.895	-7095.869	-3.049	148268.182755	-188417.516304	102-13-46	89-04-49	1.784
D35-16	61796.118	-1.481	-7094.125	6.648	10506.399125	410820.592464	102-40-33	180-26-47	5.027
D35-17	61795.015	-1.984	-7089.221	8.702	14065.014464	537740.220530	103-03-35	180-23-02	3.899
D35-74	61794.134	19.413	-7085.423	9.168	-137549.316699	566528.620512	14-49-17	91-45-42	20.992
D35-85	61814.428	22.879	-7080.053	-5.653	-161984.532587	-349436.961484	283-11-53	88-22-36	11.322
合計				倍面積	462.921890	-462.921890			64.093
				面 積	231.4609450	231.4609450			
				坪 数	70.01	70.01			

面積（座標法）計算書

地番：35D-3-4

測点名	[1] X(i)	[2] X(i+1)-X(i-1)	[3] Y(i)	[4] Y(i+1)-Y(i-1)	[2]*[3]	[1]*[4]	方向角	夾角	距離
D35-84	61819.583	-18.420	-7102.081	-15.116	130820.332020	-934464.816628	191-04-53	87-56-12	21.389
D35-73	61798.593	-21.422	-7106.192	-1.887	152228.845024	-116613.944991	100-59-33	89-54-40	2.266
D35-14	61798.161	-1.427	-7103.968	7.151	10137.362336	441918.649311	101-25-02	180-25-29	5.026
D35-15	61797.166	-1.665	-7099.041	8.099	11819.903265	500495.247434	101-55-37	180-30-35	3.242
D35-86	61796.496	19.847	-7095.869	7.965	-140831.712043	492209.090640	13-08-57	91-13-20	21.069
D35-88	61817.013	23.087	-7091.076	-6.212	-163711.671612	-384007.284756	283-08-41	89-59-44	11.301
合計				倍面積	463.058990	-463.058990			64.293
				面積	231.5294950	231.5294950			
				坪数	70.03	70.03			

面積（座標法）計算書

地番： 35D-4

測点名	[1] X(i)	[2] X(i+1)-X(i-1)	[3] Y(i)	[4] Y(i+1)-Y(i-1)	[2]*[3]	[1]*[4]	方向角	夾 角	距 離
D35-81	61832.497	-12.961	-7075.269	-24.059	91702.561509	-1487628.045323	194-49-46	89-59-13	18.692
D35-85	61814.428	-38.363	-7080.053	-10.154	271612.073239	-627663.701912	194-49-17	179-59-31	20.992
D35-74	61794.134	-20.561	-7085.423	-4.269	145683.382303	-263799.158046	103-37-53	88-48-36	1.133
D35-18	61793.867	-1.451	-7084.322	5.988	10279.351222	370021.675596	103-37-08	179-59-15	5.028
D35-19	61792.683	-2.411	-7079.435	9.760	17068.517785	603096.586080	104-07-59	180-30-51	5.025
D35-20	61791.456	-2.506	-7074.562	9.733	17728.852372	601416.241248	104-44-39	180-36-40	5.025
D35-21	61790.177	-2.598	-7069.702	9.710	18367.085796	599982.618670	105-12-51	180-28-12	5.026
D35-22	61788.858	-2.687	-7064.852	9.688	18983.257324	598610.456304	105-47-20	180-34-29	5.028
D35-23	61787.490	-2.719	-7060.014	9.484	19196.178066	585992.555160	106-12-50	180-25-30	4.838
D35-75	61786.139	36.545	-7055.368	15.788	-257838.423560	975479.562532	16-23-03	90-10-13	39.500
D35-80	61824.035	38.991	-7044.226	7.410	-274661.415966	458116.099350	286-21-08	89-58-05	3.889
D35-55	61825.130	2.439	-7047.958	-8.474	-17189.969562	-523906.151620	285-49-27	179-28-19	4.929
D35-56	61826.474	2.259	-7052.700	-8.036	-15932.049300	-496837.545064	285-31-27	179-42-00	3.419
D35-57	61827.389	6.023	-7055.994	-22.569	-42498.251862	-1395382.342341	284-50-33	179-19-06	19.940
合計				倍面積	2501.149366	-2501.149366			142.464
				面 積	1250.5746830	1250.5746830			
				坪 数	378.29	378.29			

面積（座標法）計算書

地 番： 35D-5

測点名	[1] X(i)	[2] X(i+1)-X(i-1)	[3] Y(i)	[4] Y(i+1)-Y(i-1)	[2]*[3]	[1]*[4]	方向角	夾 角	距 離
D35-80	61824.035	-37.605	-7044.226	-12.130	264898.118730	-749925.544550	196-23-03	89-58-22	39.500
D35-75	61786.139	-37.949	-7055.368	-10.960	267744.160232	-677176.083440	106-14-10	89-51-07	0.190
D35-24	61786.086	-1.499	-7055.186	4.996	10575.723814	308683.285656	106-43-08	180-28-58	5.026
D35-25	61784.640	-2.943	-7050.372	9.617	20749.244796	594182.882880	107-18-40	180-35-32	5.031
D35-26	61783.143	-3.044	-7045.569	9.581	21446.712036	591944.293083	107-56-26	180-37-46	5.022
D35-27	61781.596	-1.846	-7040.791	5.687	12997.300186	351351.936452	108-12-28	180-16-02	0.957
D35-76	61781.297	37.221	-7039.882	13.298	-262031.447922	821567.687506	18-16-23	90-03-55	39.513
D35-79	61818.817	38.049	-7027.493	10.767	-267389.081157	665603.202639	288-03-48	89-47-25	1.706
D35-51	61819.346	2.034	-7029.115	-6.328	-14297.219910	-391192.821488	287-44-04	179-40-16	4.941
D35-52	61820.851	2.967	-7033.821	-9.413	-20869.346907	-581919.670463	287-15-17	179-31-13	4.929
D35-53	61822.313	2.893	-7038.528	-9.417	-20362.461504	-582180.721521	286-54-00	179-38-43	4.923
D35-54	61823.744	1.722	-7043.238	-5.698	-12128.455836	-352271.693312	286-24-41	179-30-41	1.030
合計				倍面積	1333.246558	-1333.246558			112.768
				面 積	666.6232790	666.6232790			
				坪 数	201.65	201.65			

面積（座標法）計算書

地番：35D-6

測点名	[1] X(i)	[2] X(i+1)-X(i-1)	[3] Y(i)	[4] Y(i+1)-Y(i-1)	[2]*[3]	[1]*[4]	方向角	夾角	距離
D35-79	61818.817	-36.511	-7027.493	-15.435	256580.796923	-954173.440395	198-16-23	89-56-43	39.513
D35-76	61781.297	-38.797	-7039.882	-8.518	273126.301954	-526253.087846	108-15-26	89-59-03	4.076
D35-28	61780.020	-2.906	-7036.011	8.628	20446.647966	533038.012560	108-54-12	180-38-46	5.028
D35-29	61778.391	-3.289	-7031.254	9.502	23125.794406	587018.271282	109-16-55	180-22-43	5.027
D35-30	61776.731	-1.945	-7026.509	5.533	13666.560005	341810.652623	109-53-02	180-36-07	0.838
D35-77	61776.446	36.897	-7025.721	14.100	-259228.027737	871047.888600	19-41-55	89-48-53	39.493
D35-78	61813.628	38.151	-7012.409	10.585	-267530.415759	654297.252380	289-33-43	89-51-48	2.894
D35-48	61814.597	2.590	-7015.136	-7.378	-18169.202240	-456068.096666	289-12-53	179-39-10	4.925
D35-49	61816.218	3.211	-7019.787	-9.311	-22540.536057	-575570.805798	288-50-23	179-37-30	4.924
D35-50	61817.808	2.599	-7024.447	-7.706	-18256.537753	-476368.028448	288-19-40	179-29-17	3.209
合計				倍面積	1221.381708	-1221.381708			109.927
				面積	610.6908540	610.6908540			
				坪数	184.73	184.73			

面積（座標法）計算書

地番：35D-7

測点名	[1] X(i)	[2] X(i+1)-X(i-1)	[3] Y(i)	[4] Y(i+1)-Y(i-1)	[2]*[3]	[1]*[4]	方向角	夾角	距離
D35-78	61813.628	-36.493	-7012.409	-15.222	255903.841637	-940927.045416	199-41-55	89-51-45	39.493
D35-77	61776.446	-38.621	-7025.721	-9.378	271340.370741	-579339.510588	110-05-30	90-23-35	4.189
D35-31	61775.007	-3.190	-7021.787	8.646	22399.500530	534106.710522	110-23-07	180-17-37	5.027
D35-32	61773.256	-3.553	-7017.075	9.403	24931.667475	580853.926168	111-00-50	180-37-43	5.025
D35-33	61771.454	-3.635	-7012.384	9.370	25490.015840	578798.523980	111-23-34	180-22-44	5.025
D35-34	61769.621	-3.720	-7007.705	9.338	26068.662600	576804.720898	112-02-57	180-39-23	5.027
D35-35	61767.734	-3.792	-7003.046	9.311	26555.550432	575119.371274	112-16-09	180-13-12	5.027
D35-36	61765.829	-3.892	-6998.394	9.279	27237.749448	573125.127291	113-14-26	180-58-17	5.036
D35-37	61763.842	-4.001	-6993.767	9.232	27982.061767	570203.789344	113-37-20	180-22-54	5.026
D35-38	61761.828	-3.032	-6989.162	6.876	21191.139184	424674.329328	114-08-41	180-31-21	2.489
D35-39	61760.810	1.866	-6986.891	6.339	-13037.538606	391501.774590	54-39-55	120-31-14	4.987
D35-40	61763.694	36.814	-6982.823	1.283	-257065.645922	79242.819402	355-18-27	120-38-32	34.044
D35-41	61797.624	41.974	-6985.608	-8.685	-293213.910192	-536712.364440	323-44-28	148-26-01	9.976
D35-42	61805.668	8.275	-6991.508	-6.494	-57854.728700	-401366.007992	291-15-02	147-30-34	0.637
D35-43	61805.899	2.052	-6992.102	-5.170	-14347.793304	-319536.497830	291-42-00	180-26-58	4.925
D35-44	61807.720	3.596	-6996.678	-9.168	-25160.054088	-566653.176960	291-08-01	179-26-01	4.923
D35-45	61809.495	3.520	-7001.270	-9.201	-24644.470400	-568709.163495	290-44-13	179-36-12	4.928
D35-46	61811.240	3.444	-7005.879	-9.229	-24128.247276	-570455.933960	290-11-27	179-27-14	4.922
D35-47	61812.939	2.388	-7010.499	-6.530	-16741.071612	-403638.491670	289-50-10	179-38-43	2.030
合計				倍面積	2907.099554	-2907.099554			152.736
				面積	1453.5497770	1453.5497770			
				坪数	439.69	439.69			

面積（座標法）計算書

地 番： 35D-S

測点名	[1] X(i)	[2] X(i+1)-X(i-1)	[3] Y(i)	[4] Y(i+1)-Y(i-1)	[2]*[3]	[1]*[4]	方向角	夾 角	距 離
D35-1	61845.555	-0.483	-7154.641	-2.985	3455.691603	-184608.981675	226-17-41	131-00-49	1.002
D35-2	61844.863	-39.476	-7155.365	2.940	282465.188740	181823.897220	174-36-11	128-18-30	38.957
D35-3	61806.079	-39.474	-7151.701	4.375	282306.245274	270401.595625	134-08-28	139-32-17	0.991
D35-4	61805.389	-0.884	-7150.990	3.052	6321.475160	188630.047228	94-44-14	140-35-46	2.349
D35-5	61805.195	-0.197	-7148.649	2.413	1408.283853	149135.935535	92-23-09	177-38-55	0.072
D35-71	61805.192	40.151	-7148.577	-3.731	-287022.515127	-230595.171352	354-35-23	82-12-14	40.334
D35-70	61845.346	40.363	-7152.380	-6.064	-288691.513940	-375030.178144	275-16-52	100-41-29	2.271
合計				倍面積	242.855563	-242.855563			85.976
				面 積	121.4277815	121.4277815			
				坪 数	36.73	36.73			