


出来形確認測量図（縮尺1：250）

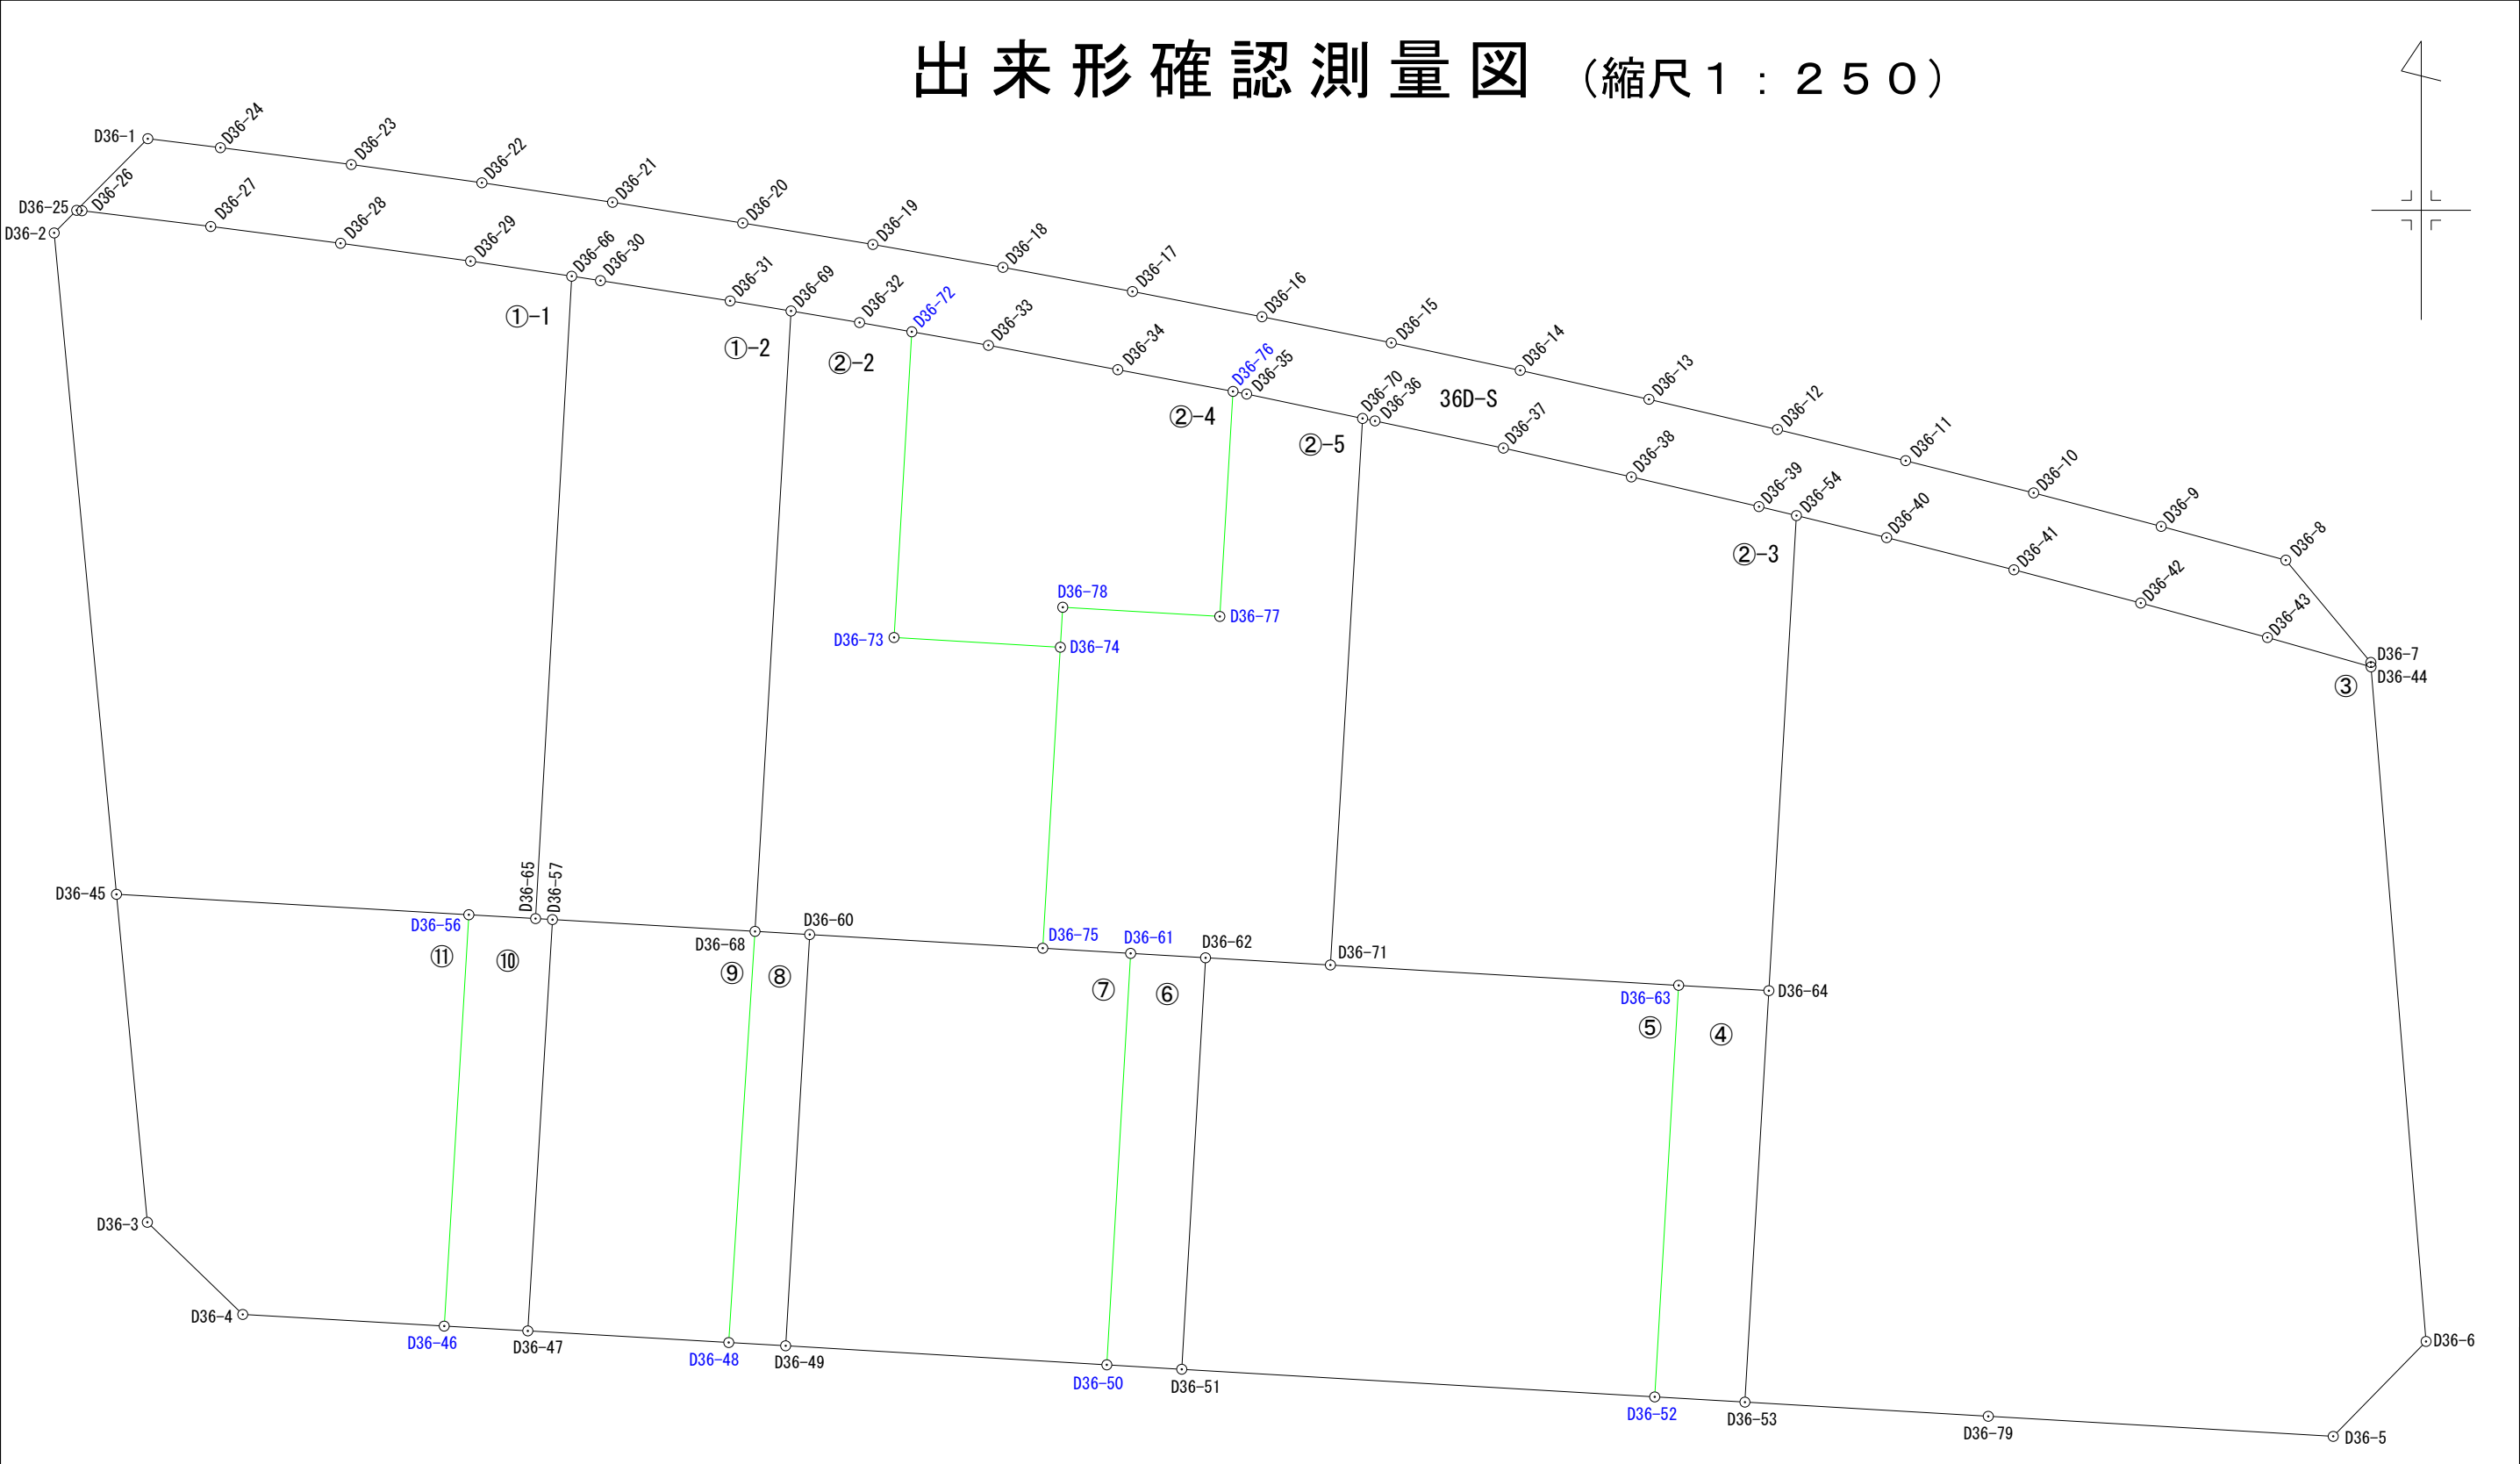

平成25年 3月22日測量
平成25年 3月15日測量
平成25年 3月13日測量
平成25年 3月12日測量
平成24年10月 3日測量
平成24年10月 2日測量
平成23年11月22日測量
平成23年11月21日測量
平成23年11月16日測量
平成23年11月15日測量

凡 例		凡 例	
			施工地区界
			道 路
			街区番号
D14-1	計 算 点		画 地 番 号
D14-2	境界標あり		

座 標 一 覽 表

測 点 名	X 座 標	Y 座 標
D36-1	61798.978	-7147.139
D36-2	61795.428	-7150.668
D36-3	61758.158	-7147.157
D36-4	61754.684	-7143.561
D36-5	61750.093	-7064.765
D36-6	61753.667	-7061.265
D36-7	61779.247	-7063.348
D36-8	61783.101	-7066.553
D36-9	61784.372	-7071.249
D36-10	61785.636	-7076.057
D36-11	61786.848	-7080.880
D36-12	61788.022	-7085.712
D36-13	61789.160	-7090.556
D36-14	61790.251	-7095.409
D36-15	61791.290	-7100.270
D36-16	61792.270	-7105.145
D36-17	61793.219	-7110.023
D36-18	61794.129	-7114.909
D36-19	61794.993	-7119.812
D36-20	61795.801	-7124.714
D36-21	61796.583	-7129.624
D36-22	61797.317	-7134.547
D36-23	61798.006	-7139.472
D36-24	61798.640	-7144.403
D36-25	61796.279	-7149.821
D36-26	61796.264	-7149.626
D36-27	61795.670	-7144.766
D36-28	61795.038	-7139.875
D36-29	61794.363	-7134.976
D36-30	61793.631	-7130.077
D36-31	61792.868	-7125.189
D36-32	61792.052	-7120.313
D36-33	61791.195	-7115.453
D36-34	61790.275	-7110.580
D36-35	61789.361	-7105.723
D36-36	61788.344	-7100.883
D36-37	61787.324	-7096.045
D36-38	61786.235	-7091.219
D36-39	61785.118	-7086.409
D36-40	61783.949	-7081.597
D36-41	61782.737	-7076.799
D36-42	61781.486	-7072.019
D36-43	61780.187	-7067.244
D36-44	61779.082	-7063.337
D36-45	61770.512	-7148.322
D36-46	61754.247	-7135.968
D36-47	61754.066	-7132.816
D36-48	61753.629	-7125.242
D36-49	61753.505	-7123.098

測 点 名	X 座 標	Y 座 標
D36-50	61752.788	-7110.991
D36-51	61752.621	-7108.166
D36-52	61751.581	-7090.339
D36-53	61751.382	-7086.939
D36-54	61784.780	-7084.996
D36-56	61769.743	-7135.040
D36-57	61769.560	-7131.888
D36-60	61768.997	-7122.193
D36-61	61768.287	-7110.095
D36-62	61768.122	-7107.270
D36-63	61767.082	-7089.436
D36-64	61766.883	-7086.036
D36-65	61769.597	-7132.525
D36-66	61793.797	-7131.161
D36-68	61769.116	-7124.252
D36-69	61792.488	-7122.893
D36-70	61788.440	-7101.353
D36-71	61767.850	-7102.565
D36-72	61791.704	-7118.342
D36-73	61780.187	-7119.012
D36-74	61779.819	-7112.741
D36-75	61768.482	-7113.408
D36-76	61789.457	-7106.235
D36-77	61780.981	-7106.734
D36-78	61781.328	-7112.652
D36-79	61750.849	-7077.766

面積（座標法）計算書

地番：36D-1-1

測点名	[1] X(i)	[2] X(i+1)-X(i-1)	[3] Y(i)	[4] Y(i+1)-Y(i-1)	[2]*[3]	[1]*[4]	方向角	夾角	距離
D36-45	61770.512	-25.685	-7148.322	15.628	183604.650570	965349.561536	93-18-49	98-41-33	13.304
D36-56	61769.743	-0.915	-7135.040	15.797	6528.561600	975776.630171	93-19-21	180-00-32	2.519
D36-65	61769.597	24.054	-7132.525	3.879	-171565.756350	239604.266763	3-13-34	89-54-13	24.238
D36-66	61793.797	24.766	-7131.161	-2.451	-176610.333326	-151456.596447	278-26-20	95-12-46	3.857
D36-29	61794.363	1.241	-7134.976	-8.714	-8854.505216	-538476.079182	277-50-42	179-24-22	4.945
D36-28	61795.038	1.307	-7139.875	-9.790	-9331.816625	-604973.422020	277-21-46	179-31-04	4.932
D36-27	61795.670	1.226	-7144.766	-9.751	-8759.483116	-602569.578170	276-58-06	179-36-20	4.896
D36-26	61796.264	0.609	-7149.626	-5.055	-4354.122234	-312380.114520	274-23-55	177-25-49	0.196
D36-25	61796.279	-0.836	-7149.821	-1.042	5977.250356	-64391.722718	224-51-54	130-27-59	1.201
D36-2	61795.428	-25.767	-7150.668	1.499	184251.262356	92631.346572	174-37-16	129-45-22	25.026
合計				倍面積	885.708015	-885.708015			85.114
				面積	442.8540075	442.8540075			
				坪数	133.96	133.96			

面積（座標法）計算書

地番：36D-1-2

測点名	[1] X(i)	[2] X(i+1)-X(i-1)	[3] Y(i)	[4] Y(i+1)-Y(i-1)	[2]*[3]	[1]*[4]	方向角	夾角	距離
D36-66	61793.797	-24.034	-7131.161	-2.448	171390.323474	-151271.215056	183-13-34	84-31-11	24.238
D36-65	61769.597	-24.237	-7132.525	-0.727	172871.008425	-44906.497019	93-19-27	90-05-53	0.638
D36-57	61769.560	-0.481	-7131.888	8.273	3430.438128	511019.569880	93-19-40	180-00-13	7.649
D36-68	61769.116	22.928	-7124.252	8.995	-163344.849856	555613.198420	3-19-40	90-00-00	23.411
D36-69	61792.488	23.752	-7122.893	-0.937	-169182.954536	-57899.561256	279-23-51	96-04-11	2.327
D36-31	61792.868	1.143	-7125.189	-7.184	-8144.091027	-443919.963712	278-52-19	179-28-28	4.947
D36-30	61793.631	0.929	-7130.077	-5.972	-6623.841533	-369031.564332	278-42-23	179-50-04	1.097
合計				倍面積	396.033075	-396.033075			64.307
				面積	198.0165375	198.0165375			
				坪数	59.90	59.90			

面積（座標法）計算書

地 番： 36D-2-2

測点名	[1] X(i)	[2] X(i+1)-X(i-1)	[3] Y(i)	[4] Y(i+1)-Y(i-1)	[2]*[3]	[1]*[4]	方向角	夾 角	距 離
D36-69	61792.488	-22.936	-7122.893	-3.939	163370.673848	-243400.610232	183-19-40	83-44-09	23.411
D36-68	61769.116	-23.491	-7124.252	0.700	167355.803732	43238.381200	93-18-28	89-58-48	2.062
D36-60	61768.997	-0.634	-7122.193	10.844	4515.470362	669823.003468	93-21-18	180-02-50	8.800
D36-75	61768.482	10.822	-7113.408	9.452	-76981.301376	583835.691864	3-22-01	90-00-43	11.357
D36-74	61779.819	11.705	-7112.741	-5.604	-83254.633405	-346214.105676	273-21-30	89-59-29	6.282
D36-73	61780.187	11.885	-7119.012	-5.601	-84609.457620	-346030.827387	3-19-46	269-58-16	11.536
D36-72	61791.704	11.865	-7118.342	-1.301	-84459.127830	-80391.006904	280-00-47	96-41-01	2.001
D36-32	61792.052	0.784	-7120.313	-4.551	-5582.325392	-281215.628652	279-35-31	179-34-44	2.617
合計				倍面積	355.102319	-355.102319			68.066
				面 積	177.5511595	177.5511595			
				坪 数	53.70	53.70			

面積（座標法）計算書

地番：36D-2-3

測点名	[1] X(i)	[2] X(i+1)-X(i-1)	[3] Y(i)	[4] Y(i+1)-Y(i-1)	[2]*[3]	[1]*[4]	方向角	夾角	距離
D36-70	61788.440	-20.494	-7101.353	-1.682	145535.128382	-103928.156080	183-22-07	81-49-28	20.626
D36-71	61767.850	-21.358	-7102.565	11.917	151696.583270	736087.468450	93-20-52	89-58-45	13.151
D36-63	61767.082	-0.967	-7089.436	16.529	6855.484612	1020948.098378	93-20-59	180-00-07	3.406
D36-64	61766.883	17.698	-7086.036	4.440	-125408.665128	274244.960520	3-19-33	89-58-34	17.927
D36-54	61784.780	18.235	-7084.996	-0.373	-129194.902060	-23045.722940	283-27-10	100-07-37	1.453
D36-39	61785.118	1.455	-7086.409	-6.223	-10310.725095	-384488.789314	283-04-26	179-37-16	4.938
D36-38	61786.235	2.206	-7091.219	-9.636	-15643.229114	-595372.160460	282-42-58	179-38-32	4.947
D36-37	61787.324	2.109	-7096.045	-9.664	-14965.558905	-597112.699136	281-54-19	179-11-21	4.944
D36-36	61788.344	1.116	-7100.883	-5.308	-7924.585428	-327972.529952	281-32-39	179-38-20	0.480
合計				倍面積	639.530534	-639.530534			71.872
				面積	319.7652670	319.7652670			
				坪数	96.72	96.72			

面積（座標法）計算書

地番：36D-2-4

測点名	[1] X(i)	[2] X(i+1)-X(i-1)	[3] Y(i)	[4] Y(i+1)-Y(i-1)	[2]*[3]	[1]*[4]	方向角	夾角	距離
D36-72	61791.704	-11.008	-7118.342	-3.559	78358.708736	-219916.674536	183-19-46	83-20-14	11.536
D36-73	61780.187	-11.885	-7119.012	5.601	84609.457620	346030.827387	93-21-30	90-01-44	6.282
D36-74	61779.819	1.141	-7112.741	6.360	-8115.637481	392919.648840	3-22-31	90-01-01	1.512
D36-78	61781.328	1.162	-7112.652	6.007	-8264.901624	371120.437296	93-21-20	269-58-49	5.928
D36-77	61780.981	8.129	-7106.734	6.417	-57770.640686	396448.555077	3-22-09	90-00-49	8.491
D36-76	61789.457	9.294	-7106.235	-3.846	-66045.348090	-237642.251622	280-39-43	97-17-34	4.421
D36-34	61790.275	1.738	-7110.580	-9.218	-12358.188040	-569582.754950	280-41-29	180-01-46	4.959
D36-33	61791.195	1.429	-7115.453	-7.762	-10167.982337	-479623.255590	279-59-32	179-18-03	2.933
合計				倍面積	245.468098	-245.468098			46.062
				面積	122.7340490	122.7340490			
				坪数	37.12	37.12			

面積（座標法）計算書

地番：36D-2-5

測点名	[1] X(i)	[2] X(i+1)-X(i-1)	[3] Y(i)	[4] Y(i+1)-Y(i-1)	[2]*[3]	[1]*[4]	方向角	夾角	距離
D36-76	61789.457	-8.380	-7106.235	-1.011	59550.249300	-62469.141027	183-22-09	82-44-58	8.491
D36-77	61780.981	-8.129	-7106.734	-6.417	57770.640686	-396448.555077	273-21-20	269-59-11	5.928
D36-78	61781.328	-1.162	-7112.652	-6.007	8264.901624	-371120.437296	183-22-31	90-01-11	1.512
D36-74	61779.819	-12.846	-7112.741	-0.756	91370.270886	-46705.543164	183-22-01	179-59-30	11.357
D36-75	61768.482	-11.532	-7113.408	2.646	82031.821056	163439.403372	93-22-07	90-00-06	3.319
D36-61	61768.287	-0.360	-7110.095	6.138	2559.634200	379133.745606	93-20-34	179-58-27	2.830
D36-62	61768.122	-0.437	-7107.270	7.530	3105.876990	465113.958660	93-18-31	179-57-57	4.713
D36-71	61767.850	20.318	-7102.565	5.917	-144309.915670	365480.368450	3-22-07	90-03-36	20.626
D36-70	61788.440	21.511	-7101.353	-3.158	-152757.204383	-195127.893520	281-54-04	98-31-57	4.466
D36-35	61789.361	1.017	-7105.723	-4.882	-7226.520291	-301655.660402	280-37-11	178-43-07	0.521
合計				倍面積	359.754398	-359.754398			63.763
				面積	179.8771990	179.8771990			
				坪数	54.41	54.41			

面積（座標法）計算書

地番：36D-3

測点名	[1] X(i)	[2] X(i+1)-X(i-1)	[3] Y(i)	[4] Y(i+1)-Y(i-1)	[2]*[3]	[1]*[4]	方向角	夾角	距離
D36-54	61784.780	-17.066	-7084.996	-4.439	120912.541736	-274262.638420	183-19-33	79-35-15	17.927
D36-64	61766.883	-33.398	-7086.036	-1.943	236659.430328	-120013.053669	183-20-02	180-00-29	15.527
D36-53	61751.382	-16.034	-7086.939	8.270	113631.979926	510683.929140	93-19-32	89-59-30	9.188
D36-79	61750.849	-1.289	-7077.766	22.174	9123.240374	1369263.325726	93-19-41	180-00-09	13.023
D36-5	61750.093	2.818	-7064.765	16.501	-19908.507770	1018938.284593	44-24-02	131-04-21	5.002
D36-6	61753.667	28.989	-7061.265	1.428	-204699.011085	88184.236476	355-20-21	130-56-19	25.499
D36-44	61779.082	26.520	-7063.337	-5.979	-187319.697240	-369377.131278	285-47-32	110-27-11	4.060
D36-43	61780.187	2.404	-7067.244	-8.682	-16989.654576	-536375.583534	285-13-07	179-25-35	4.949
D36-42	61781.486	2.550	-7072.019	-9.555	-18033.648450	-590322.098730	284-39-58	179-26-51	4.941
D36-41	61782.737	2.463	-7076.799	-9.578	-17430.155937	-591755.054986	284-10-36	179-30-38	4.949
D36-40	61783.949	2.043	-7081.597	-8.197	-14467.702671	-506443.029953	283-44-18	179-33-42	3.499
合計				倍面積	1478.814635	-1478.814635			108.564
				面積	739.4073175	739.4073175			
				坪数	223.67	223.67			

面積（座標法）計算書

地番：36D-4

測点名	[1] X(i)	[2] X(i+1)-X(i-1)	[3] Y(i)	[4] Y(i+1)-Y(i-1)	[2]*[3]	[1]*[4]	方向角	夾角	距離
D36-63	61767.082	-15.302	-7089.436	-4.303	108482.549672	-265783.753846	183-20-02	89-59-03	15.527
D36-52	61751.581	-15.700	-7090.339	2.497	111318.322300	154193.697757	93-20-59	90-00-57	3.406
D36-53	61751.382	15.302	-7086.939	4.303	-108444.340578	265716.196746	3-20-02	89-59-03	15.527
D36-64	61766.883	15.700	-7086.036	-2.497	-111250.765200	-154231.906851	273-20-59	90-00-57	3.406
合計				倍面積	105.766194	-105.766194			37.866
				面積	52.8830970	52.8830970			
				坪数	15.99	15.99			

面積（座標法）計算書

地番：36D-5

測点名	[1] X(i)	[2] X(i+1)-X(i-1)	[3] Y(i)	[4] Y(i+1)-Y(i-1)	[2]*[3]	[1]*[4]	方向角	夾角	距離
D36-62	61768.122	-15.229	-7107.270	-5.601	108236.614830	-345963.251322	183-18-29	89-59-58	15.527
D36-51	61752.621	-16.541	-7108.166	16.931	117576.173806	1045533.626151	93-20-20	90-01-51	17.857
D36-52	61751.581	14.461	-7090.339	18.730	-102533.392279	1156607.112130	3-20-02	89-59-42	15.527
D36-63	61767.082	16.269	-7089.436	-12.226	-115338.034284	-755164.344532	273-20-52	90-00-50	13.151
D36-71	61767.850	1.040	-7102.565	-17.834	-7386.667600	-1101567.836900	273-18-31	179-57-39	4.713
合計				倍面積	554.694473	-554.694473			66.775
				面積	277.3472365	277.3472365			
				坪数	83.89	83.89			

面積（座標法）計算書

地番：36D-6

測点名	[1] X(i)	[2] X(i+1)-X(i-1)	[3] Y(i)	[4] Y(i+1)-Y(i-1)	[2]*[3]	[1]*[4]	方向角	夾角	距離
D36-61	61768.287	-15.334	-7110.095	-3.721	109026.196730	-229839.795927	183-18-31	89-57-57	15.525
D36-50	61752.788	-15.666	-7110.991	1.929	111400.785006	119121.128052	93-22-59	90-04-28	2.830
D36-51	61752.621	15.334	-7108.166	3.721	-108996.617444	229781.502741	3-18-29	89-55-30	15.527
D36-62	61768.122	15.666	-7107.270	-1.929	-111342.491820	-119150.707338	273-20-34	90-02-05	2.830
合計				倍面積	87.872472	-87.872472			36.712
				面積	43.9362360	43.9362360			
				坪数	13.29	13.29			

面積（座標法）計算書

地番：36D-7

測点名	[1] X(i)	[2] X(i+1)-X(i-1)	[3] Y(i)	[4] Y(i+1)-Y(i-1)	[2]*[3]	[1]*[4]	方向角	夾角	距離
D36-60	61768.997	-14.977	-7122.193	-9.690	106669.084561	-598541.580930	183-20-36	89-59-18	15.518
D36-49	61753.505	-16.209	-7123.098	11.202	115458.295482	691762.763010	93-23-21	90-02-45	12.128
D36-50	61752.788	14.782	-7110.991	13.003	-105114.668962	802971.502364	3-18-31	89-55-10	15.525
D36-61	61768.287	15.694	-7110.095	-2.417	-111585.830930	-149293.949679	273-22-07	90-03-36	3.319
D36-75	61768.482	0.710	-7113.408	-12.098	-5050.519680	-747275.095236	273-21-18	179-59-11	8.800
合計				倍面積	376.360471	-376.360471			55.290
				面積	188.1802355	188.1802355			
				坪数	56.92	56.92			

面積（座標法）計算書

地番：36D-8

測点名	[1] X(i)	[2] X(i+1)-X(i-1)	[3] Y(i)	[4] Y(i+1)-Y(i-1)	[2]*[3]	[1]*[4]	方向角	夾角	距離
D36-68	61769.116	-15.368	-7124.252	-3.049	109485.504736	-188334.034684	183-39-27	90-20-59	15.519
D36-48	61753.629	-15.611	-7125.242	1.154	111232.152862	71263.687866	93-18-36	89-39-09	2.148
D36-49	61753.505	15.368	-7123.098	3.049	-109467.770064	188286.436745	3-20-36	90-02-00	15.518
D36-60	61768.997	15.611	-7122.193	-1.154	-111184.554923	-71281.422538	273-18-28	89-57-52	2.062
合計				倍面積	65.332611	-65.332611			35.247
				面積	32.6663055	32.6663055			
				坪数	9.88	9.88			

面積（座標法）計算書

地番：36D-9

測点名	[1] X(i)	[2] X(i+1)-X(i-1)	[3] Y(i)	[4] Y(i+1)-Y(i-1)	[2]*[3]	[1]*[4]	方向角	夾角	距離
D36-57	61769.560	-15.050	-7131.888	-8.564	107334.914400	-528994.511840	183-25-39	90-05-59	15.522
D36-47	61754.066	-15.931	-7132.816	6.646	113632.891696	410417.522636	93-18-08	89-52-29	7.587
D36-48	61753.629	15.050	-7125.242	8.564	-107234.892100	528858.078756	3-39-27	90-21-19	15.519
D36-68	61769.116	15.931	-7124.252	-6.646	-113496.458612	-410517.544936	273-19-40	89-40-13	7.649
合計				倍面積	236.455384	-236.455384			46.277
				面積	118.2276920	118.2276920			
				坪数	35.76	35.76			

面積（座標法）計算書

地番：36D-10

測点名	[1] X(i)	[2] X(i+1)-X(i-1)	[3] Y(i)	[4] Y(i+1)-Y(i-1)	[2]*[3]	[1]*[4]	方向角	夾角	距離
D36-56	61769.743	-15.350	-7135.040	-3.443	109522.864000	-212673.225149	183-25-38	90-06-17	15.524
D36-46	61754.247	-15.677	-7135.968	2.224	111870.570336	137341.445328	93-17-12	89-51-34	3.157
D36-47	61754.066	15.313	-7132.816	4.080	-109224.811408	251956.589280	3-25-39	90-08-27	15.522
D36-57	61769.560	15.531	-7131.888	0.291	-110765.352528	17974.941960	273-19-27	89-53-48	0.638
D36-65	61769.597	0.183	-7132.525	-3.152	-1305.252075	-194697.769744	273-19-21	179-59-54	2.519
合計				倍面積	98.018325	-98.018325			37.360
				面積	49.0091625	49.0091625			
				坪数	14.82	14.82			

面積（座標法）計算書

地番：36D-11

測点名	[1] X(i)	[2] X(i+1)-X(i-1)	[3] Y(i)	[4] Y(i+1)-Y(i-1)	[2]*[3]	[1]*[4]	方向角	夾角	距離
D36-45	61770.512	-11.585	-7148.322	-12.117	82813.310370	-748473.293904	174-36-46	81-17-57	12.409
D36-3	61758.158	-15.828	-7147.157	4.761	113125.200996	294030.590238	134-00-41	139-23-55	5.000
D36-4	61754.684	-3.911	-7143.561	11.189	27938.467071	690973.159276	93-17-38	139-16-57	7.606
D36-46	61754.247	15.059	-7135.968	8.521	-107460.542112	526207.938687	3-25-38	90-08-00	15.524
D36-56	61769.743	16.265	-7135.040	-12.354	-116051.425600	-763103.405022	273-18-49	89-53-11	13.304
合計				倍面積	365.010725	-365.010725			53.843
				面積	182.5053625	182.5053625			
				坪数	55.20	55.20			

面積（座標法）計算書

地 番： 36D-S

測点名	[1] X(i)	[2] X(i+1)-X(i-1)	[3] Y(i)	[4] Y(i+1)-Y(i-1)	[2]*[3]	[1]*[4]	方向角	夾 角	距 離
D36-1	61798.978	-2.361	-7147.139	-5.418	16874.395179	-334826.862804	224-49-08	127-46-35	3.805
D36-25	61796.279	-2.714	-7149.821	-2.487	19404.614194	-153687.345873	94-23-55	49-34-47	0.196
D36-26	61796.264	-0.609	-7149.626	5.055	4354.122234	312380.114520	96-58-06	182-34-11	4.896
D36-27	61795.670	-1.226	-7144.766	9.751	8759.483116	602569.578170	97-21-46	180-23-40	4.932
D36-28	61795.038	-1.307	-7139.875	9.790	9331.816625	604973.422020	97-50-42	180-28-56	4.945
D36-29	61794.363	-1.241	-7134.976	8.714	8854.505216	538476.079182	98-26-20	180-35-38	3.857
D36-66	61793.797	-0.732	-7131.161	4.899	5220.009852	302727.811503	98-42-23	180-16-03	1.097
D36-30	61793.631	-0.929	-7130.077	5.972	6623.841533	369031.564332	98-52-19	180-09-56	4.947
D36-31	61792.868	-1.143	-7125.189	7.184	8144.091027	443919.963712	99-23-51	180-31-32	2.327
D36-69	61792.488	-0.816	-7122.893	4.876	5812.280688	301300.171488	99-35-31	180-11-40	2.617
D36-32	61792.052	-0.784	-7120.313	4.551	5582.325392	281215.628652	100-00-47	180-25-16	2.001
D36-72	61791.704	-0.857	-7118.342	4.860	6100.419094	300307.681440	99-59-32	179-58-45	2.933
D36-33	61791.195	-1.429	-7115.453	7.762	10167.982337	479623.255590	100-41-29	180-41-57	4.959
D36-34	61790.275	-1.738	-7110.580	9.218	12358.188040	569582.754950	100-39-43	179-58-14	4.421
D36-76	61789.457	-0.914	-7106.235	4.857	6495.098790	300111.392649	100-37-11	179-57-28	0.521
D36-35	61789.361	-1.017	-7105.723	4.882	7226.520291	301655.660402	101-54-04	181-16-53	4.466
D36-70	61788.440	-1.017	-7101.353	4.840	7222.076001	299056.049600	101-32-39	179-38-35	0.480
D36-36	61788.344	-1.116	-7100.883	5.308	7924.585428	327972.529952	101-54-19	180-21-40	4.944
D36-37	61787.324	-2.109	-7096.045	9.664	14965.558905	597112.699136	102-42-58	180-48-39	4.947
D36-38	61786.235	-2.206	-7091.219	9.636	15643.229114	595372.160460	103-04-26	180-21-28	4.938
D36-39	61785.118	-1.455	-7086.409	6.223	10310.725095	384488.789314	103-27-10	180-22-44	1.453
D36-54	61784.780	-1.169	-7084.996	4.812	8282.360324	297308.361360	103-44-18	180-17-08	3.499
D36-40	61783.949	-2.043	-7081.597	8.197	14467.702671	506443.029953	104-10-36	180-26-18	4.949
D36-41	61782.737	-2.463	-7076.799	9.578	17430.155937	591755.054986	104-39-58	180-29-22	4.941
D36-42	61781.486	-2.550	-7072.019	9.555	18033.648450	590322.098730	105-13-07	180-33-09	4.949
D36-43	61780.187	-2.404	-7067.244	8.682	16989.654576	536375.583534	105-47-32	180-34-25	4.060
D36-44	61779.082	-0.940	-7063.337	3.896	6639.536780	240691.303472	356-11-09	70-23-37	0.165
D36-7	61779.247	4.019	-7063.348	-3.216	-28387.595612	-198682.058352	320-15-11	144-04-02	5.013
D36-8	61783.101	5.125	-7066.553	-7.901	-36216.084125	-488148.281001	285-08-41	144-53-30	4.865
D36-9	61784.372	2.535	-7071.249	-9.504	-17925.616215	-587198.671488	284-43-46	179-35-05	4.971
D36-10	61785.636	2.476	-7076.057	-9.631	-17520.317132	-595057.460316	284-06-22	179-22-36	4.973

面積（座標法）計算書

地 番： 36D-S

測点名	[1] X(i)	[2] X(i+1)-X(i-1)	[3] Y(i)	[4] Y(i+1)-Y(i-1)	[2]*[3]	[1]*[4]	方向角	夾 角	距 離
D36-11	61786.848	2.386	-7080.880	-9.655	-16894.979680	-596552.017440	283-39-22	179-33-00	4.973
D36-12	61788.022	2.312	-7085.712	-9.676	-16382.166144	-597860.900872	283-13-15	179-33-53	4.976
D36-13	61789.160	2.229	-7090.556	-9.697	-15804.849324	-599169.484520	282-40-12	179-26-57	4.974
D36-14	61790.251	2.130	-7095.409	-9.714	-15113.221170	-600230.498214	282-03-54	179-23-42	4.971
D36-15	61791.290	2.019	-7100.270	-9.736	-14335.445130	-601599.999440	281-21-59	179-18-05	4.973
D36-16	61792.270	1.929	-7105.145	-9.753	-13705.824705	-602660.009310	281-00-33	179-38-34	4.969
D36-17	61793.219	1.859	-7110.023	-9.764	-13217.532757	-603348.990316	280-33-01	179-32-28	4.970
D36-18	61794.129	1.774	-7114.909	-9.789	-12621.848566	-604902.728781	279-59-38	179-26-37	4.979
D36-19	61794.993	1.672	-7119.812	-9.805	-11904.325664	-605899.906365	279-21-36	179-21-58	4.968
D36-20	61795.801	1.590	-7124.714	-9.812	-11328.295260	-606340.399412	279-02-58	179-41-22	4.972
D36-21	61796.583	1.516	-7129.624	-9.833	-10808.509984	-607645.800639	278-28-48	179-25-50	4.977
D36-22	61797.317	1.423	-7134.547	-9.848	-10152.460381	-608579.977816	277-57-50	179-29-02	4.973
D36-23	61798.006	1.323	-7139.472	-9.856	-9445.521456	-609081.147136	277-19-36	179-21-46	4.972
D36-24	61798.640	0.972	-7144.403	-7.667	-6944.359716	-473810.172880	277-02-33	179-42-57	2.757
合計				倍面積	509.973868	-509.973868			179.471
				面 積	254.9869340	254.9869340			
				坪 数	77.13	77.13			