
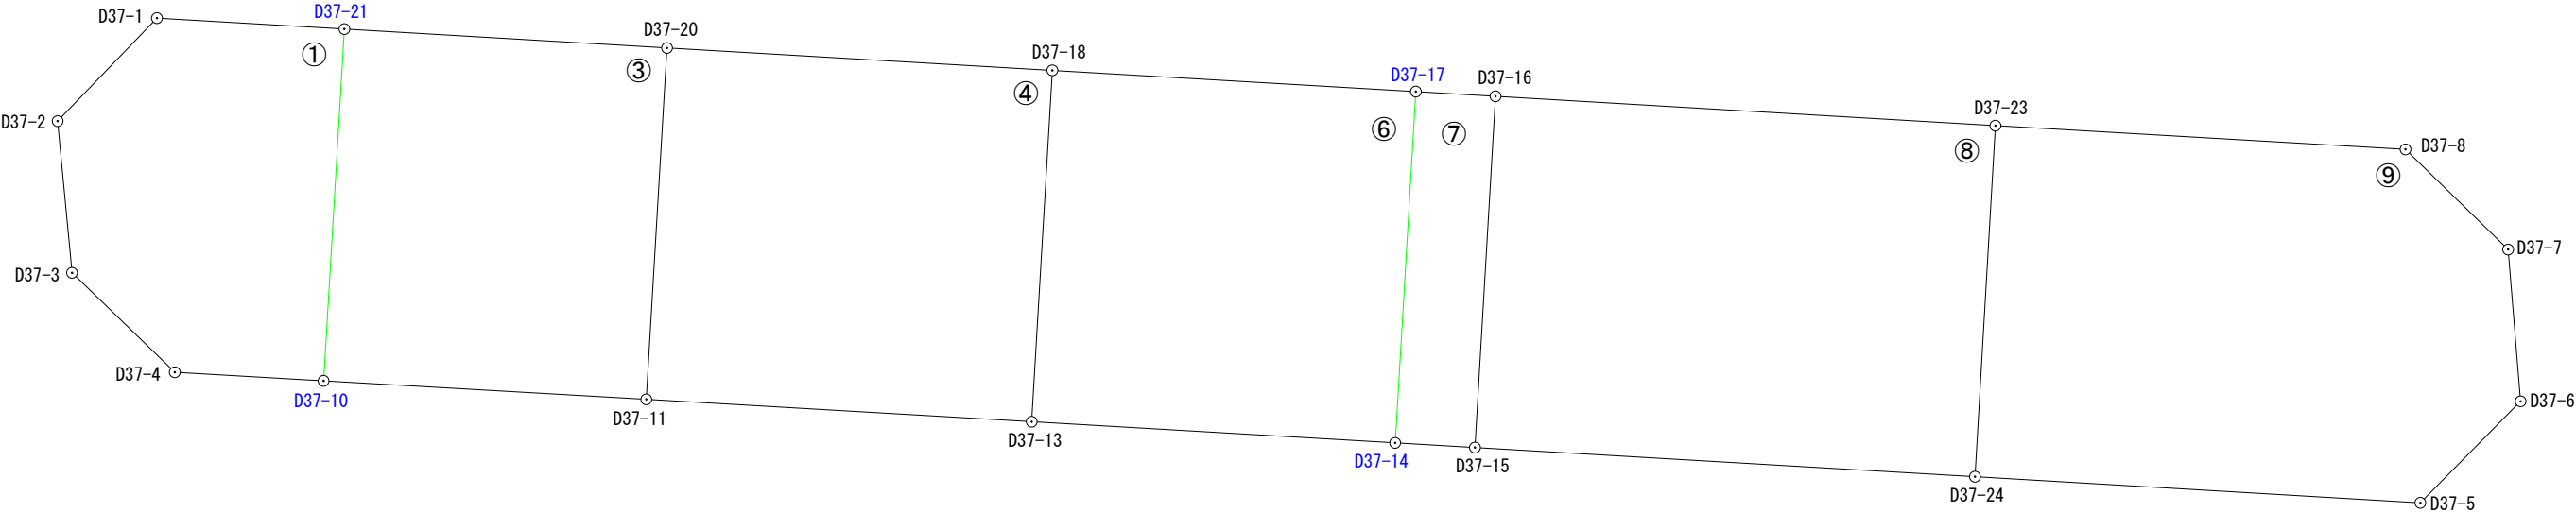


出来形確認測量図（縮尺１：２５０）

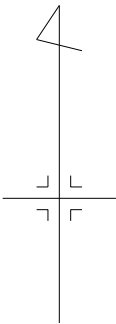

座 標 一 覧 表

測 点 名	X 座 標	Y 座 標
D37-1	61748.624	-7142.436
D37-2	61745.018	-7145.912
D37-3	61739.708	-7145.408
D37-4	61736.227	-7141.811
D37-5	61731.659	-7063.246
D37-6	61735.210	-7059.740
D37-7	61740.525	-7060.176
D37-8	61744.027	-7063.767
D37-10	61735.929	-7136.607
D37-11	61735.280	-7125.317
D37-13	61734.494	-7111.832
D37-14	61733.754	-7099.115
D37-15	61733.592	-7096.325
D37-16	61745.889	-7095.603
D37-17	61746.051	-7098.393
D37-18	61746.792	-7111.109
D37-20	61747.577	-7124.589
D37-21	61748.239	-7135.878
D37-23	61744.857	-7078.115
D37-24	61732.573	-7078.830

凡 例	
	施工地区界
	道 路
	街区番号
	画地番号
D14-1	計 算 点
D14-2	境界標あり

平成23年11月23日測量
平成23年11月22日測量

面積（座標法）計算書

地 番： 37D-1

測点名	[1] X(i)	[2] X(i+1)-X(i-1)	[3] Y(i)	[4] Y(i+1)-Y(i-1)	[2]*[3]	[1]*[4]	方向角	夾 角	距 離
D37-1	61748.624	-3.221	-7142.436	-10.034	23005.786356	-619585.693216	223-56-54	130-35-19	5.009
D37-2	61745.018	-8.916	-7145.912	-2.972	63712.951392	-183506.193496	174-34-41	130-37-47	5.334
D37-3	61739.708	-8.791	-7145.408	4.101	62815.281728	253194.542508	134-03-40	139-28-59	5.006
D37-4	61736.227	-3.779	-7141.811	8.801	26988.903769	543340.533827	93-16-39	139-12-59	5.213
D37-10	61735.929	12.012	-7136.607	5.933	-85724.923284	366279.266757	3-23-21	90-06-42	12.332
D37-21	61748.239	12.695	-7135.878	-5.829	-90589.971210	-359930.485131	273-21-35	89-58-14	6.569
合計				倍面積	208.028751	-208.028751			39.463
				面 積	104.0143755	104.0143755			
				坪 数	31.46	31.46			

面積（座標法）計算書

地番：37D-3

測点名	[1] X(i)	[2] X(i+1)-X(i-1)	[3] Y(i)	[4] Y(i+1)-Y(i-1)	[2]*[3]	[1]*[4]	方向角	夾角	距離
D37-21	61748.239	-11.648	-7135.878	-12.018	83118.706944	-742090.336302	183-23-21	90-01-59	12.332
D37-10	61735.929	-12.959	-7136.607	10.561	92483.290113	651993.146169	93-17-24	89-54-03	11.309
D37-11	61735.280	11.648	-7125.317	12.018	-82995.692416	741934.595040	3-23-17	90-05-53	12.319
D37-20	61747.577	12.959	-7124.589	-10.561	-92327.548851	-652116.160697	273-21-22	89-58-05	11.308
合計				倍面積	278.755790	-278.755790			47.268
				面積	139.3778950	139.3778950			
				坪数	42.16	42.16			

面積（座標法）計算書

地番：37D-4

測点名	[1] X(i)	[2] X(i+1)-X(i-1)	[3] Y(i)	[4] Y(i+1)-Y(i-1)	[2]*[3]	[1]*[4]	方向角	夾角	距離
D37-20	61747.577	-11.512	-7124.589	-14.208	82018.268568	-877309.574016	183-23-17	90-03-19	12.319
D37-11	61735.280	-13.083	-7125.317	12.757	93220.522311	787556.966960	93-20-09	89-56-52	13.508
D37-13	61734.494	11.512	-7111.832	14.208	-81871.409984	877123.690752	3-21-52	90-01-43	12.319
D37-18	61746.792	13.083	-7111.109	-12.757	-93034.639047	-787703.825544	273-19-58	89-58-06	13.503
合計				倍面積	332.741848	-332.741848			51.649
				面積	166.3709240	166.3709240			
				坪数	50.32	50.32			

面積（座標法）計算書

地番：37D-6

測点名	[1] X(i)	[2] X(i+1)-X(i-1)	[3] Y(i)	[4] Y(i+1)-Y(i-1)	[2]*[3]	[1]*[4]	方向角	夾角	距離
D37-18	61746.792	-11.557	-7111.109	-13.439	82183.086713	-829815.137688	183-21-52	90-01-46	12.319
D37-13	61734.494	-13.038	-7111.832	11.994	92724.065616	740443.521036	93-19-49	89-57-57	12.739
D37-14	61733.754	11.557	-7099.115	13.439	-82044.472055	829639.920006	3-21-37	90-01-48	12.318
D37-17	61746.051	13.038	-7098.393	-11.994	-92548.847934	-740582.135694	273-20-06	89-58-29	12.738
合計				倍面積	313.832340	-313.832340			50.114
				面積	156.9161700	156.9161700			
				坪数	47.46	47.46			

面積（座標法）計算書

地番：37D-7

測点名	[1] X(i)	[2] X(i+1)-X(i-1)	[3] Y(i)	[4] Y(i+1)-Y(i-1)	[2]*[3]	[1]*[4]	方向角	夾角	距離
D37-17	61746.051	-12.135	-7098.393	-3.512	86138.999055	-216852.131112	183-21-37	90-02-14	12.318
D37-14	61733.754	-12.459	-7099.115	2.068	88447.873785	127665.403272	93-19-23	89-57-46	2.795
D37-15	61733.592	12.135	-7096.325	3.512	-86113.903875	216808.375104	3-21-37	90-02-14	12.318
D37-16	61745.889	12.459	-7095.603	-2.068	-88404.117777	-127690.498452	273-19-23	89-57-46	2.795
合計				倍面積	68.851188	-68.851188			30.226
				面積	34.4255940	34.4255940			
				坪数	10.41	10.41			

面積（座標法）計算書

地番：37D-8

測点名	[1] X(i)	[2] X(i+1)-X(i-1)	[3] Y(i)	[4] Y(i+1)-Y(i-1)	[2]*[3]	[1]*[4]	方向角	夾角	距離
D37-16	61745.889	-11.265	-7095.603	-18.210	79931.967795	-1124392.638690	183-21-37	89-58-59	12.318
D37-15	61733.592	-13.316	-7096.325	16.773	94494.663700	1035457.538616	93-20-00	89-58-23	17.525
D37-24	61732.573	11.265	-7078.830	18.210	-79743.019950	1124150.154330	3-19-52	89-59-52	12.305
D37-23	61744.857	13.316	-7078.115	-16.773	-94252.179340	-1035646.486461	273-22-38	90-02-46	17.518
合計				倍面積	431.432205	-431.432205			59.666
				面積	215.7161025	215.7161025			
				坪数	65.25	65.25			

面積（座標法）計算書

地 番： 37D-9

測点名	[1] X(i)	[2] X(i+1)-X(i-1)	[3] Y(i)	[4] Y(i+1)-Y(i-1)	[2]*[3]	[1]*[4]	方向角	夾 角	距 離
D37-23	61744.857	-11.454	-7078.115	-15.063	81072.729210	-930062.780991	183-19-52	90-01-13	12.305
D37-24	61732.573	-13.198	-7078.830	14.869	93426.398340	917901.627937	93-21-24	90-01-32	15.611
D37-5	61731.659	2.637	-7063.246	19.090	-18625.779702	1178457.370310	44-38-05	131-16-41	4.990
D37-6	61735.210	8.866	-7059.740	3.070	-62591.654840	189527.094700	355-18-37	130-40-32	5.333
D37-7	61740.525	8.817	-7060.176	-4.027	-62249.571792	-248629.094175	314-16-52	138-58-15	5.016
D37-8	61744.027	4.332	-7063.767	-17.939	-30600.238644	-1107626.100353	273-18-39	139-01-47	14.372
合計				倍面積	431.882572	-431.882572			57.627
				面 積	215.9412860	215.9412860			
				坪 数	65.32	65.32			