
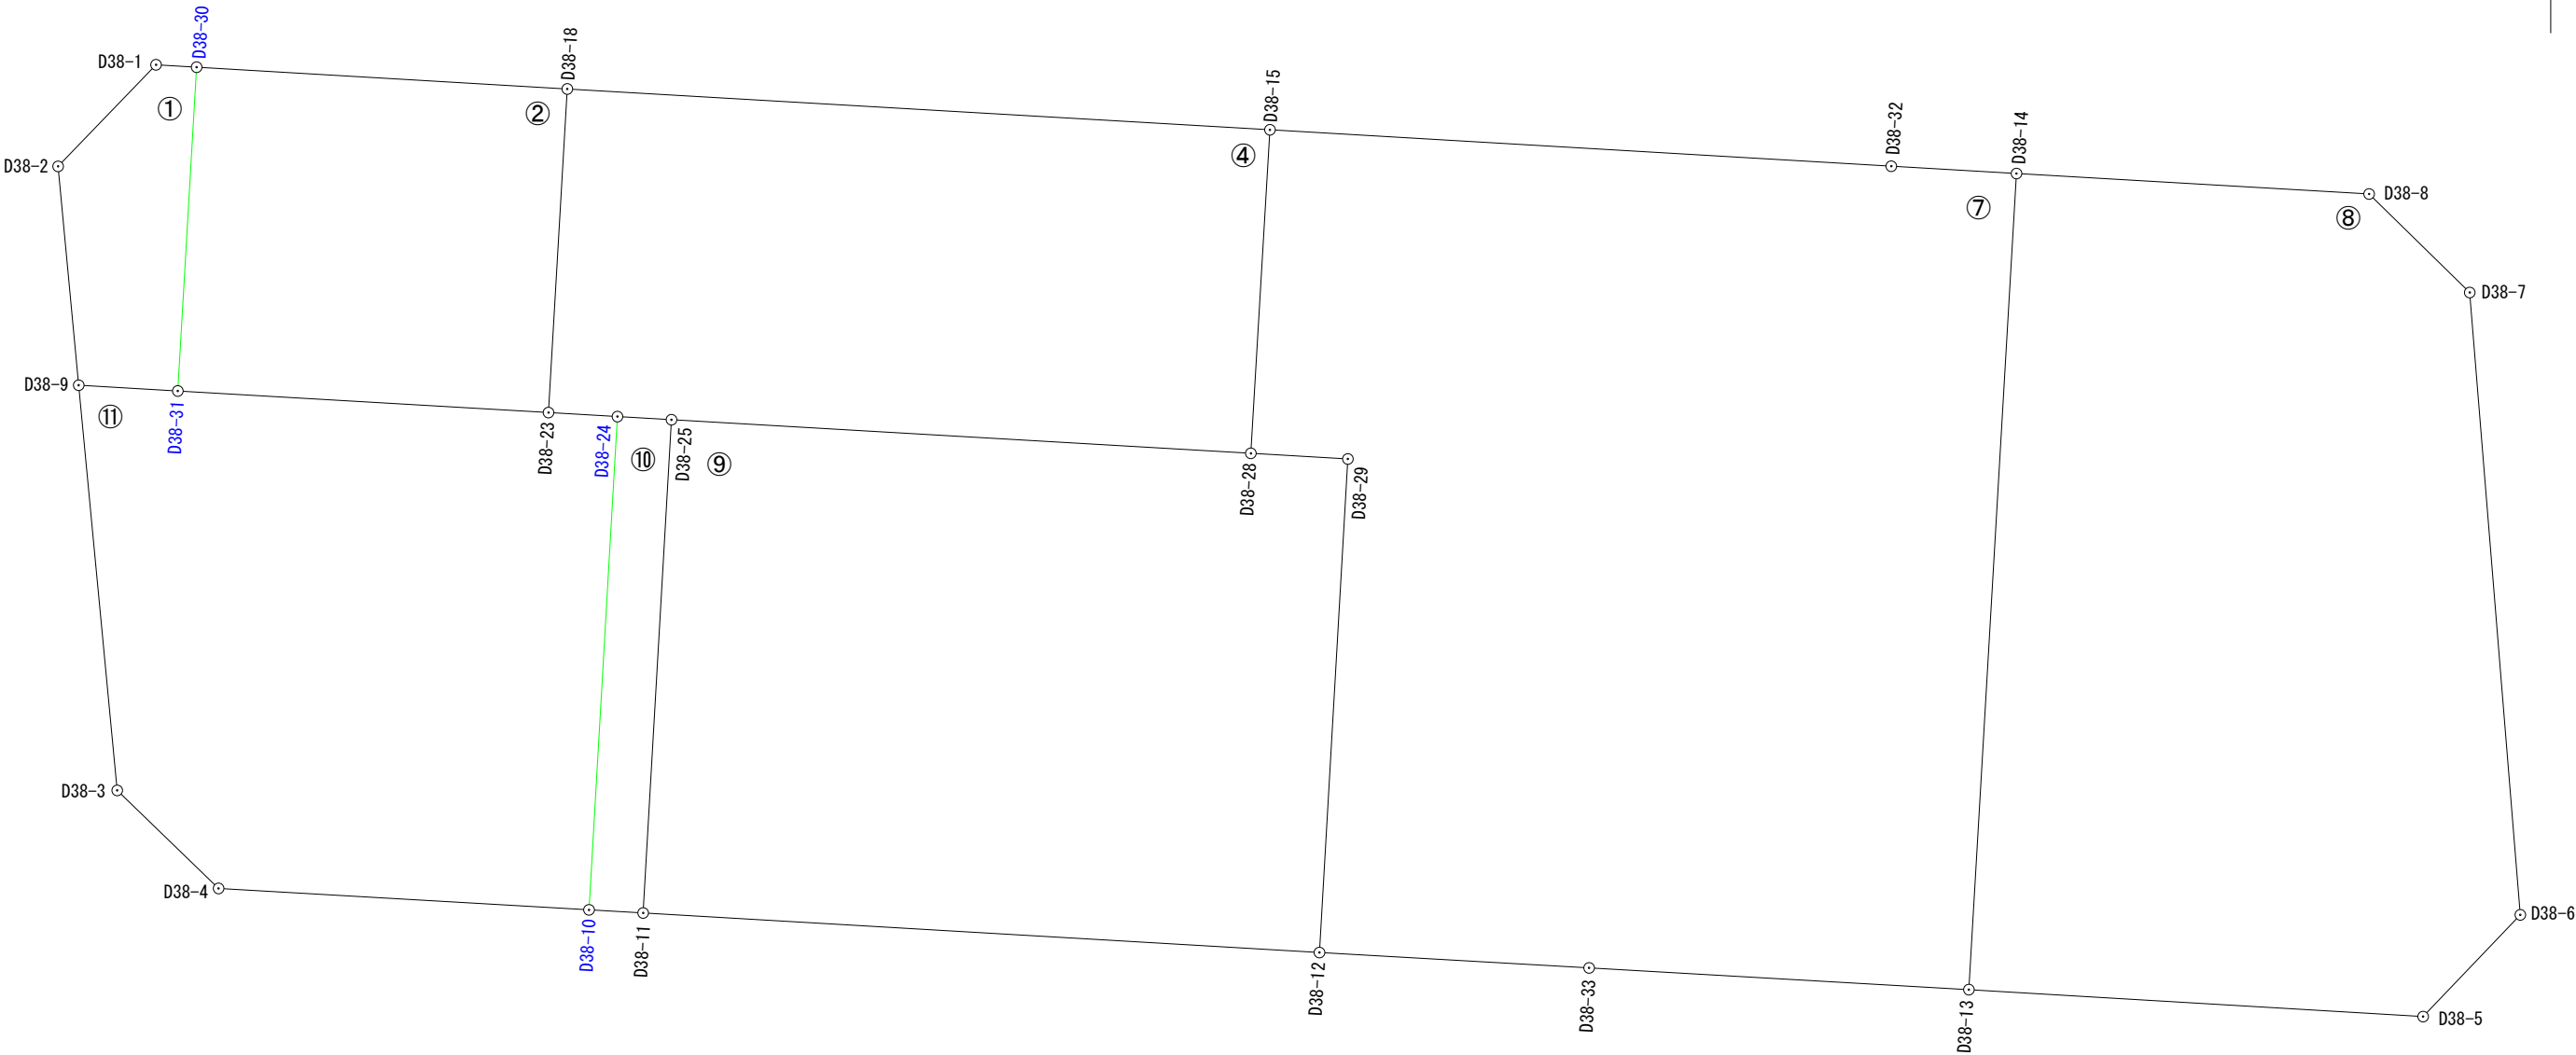


出来形確認測量図（縮尺１：２５０）

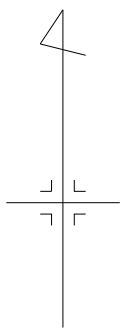

座 標 一 覧 表

測 点 名	X	座 標	Y	座 標
D38-1		61730.172		-7140.693
D38-2		61726.572		-7144.168
D38-3		61704.454		-7142.071
D38-4		61700.977		-7138.480
D38-5		61696.434		-7060.328
D38-6		61700.041		-7056.883
D38-7		61722.100		-7058.676
D38-8		61725.594		-7062.245
D38-9		61718.815		-7143.436
D38-10		61700.218		-7125.347
D38-11		61700.108		-7123.427
D38-12		61698.706		-7099.453
D38-13		61697.390		-7076.432
D38-14		61726.318		-7074.745

測 点 名	X	座 標	Y	座 標
D38-15		61727.868		-7101.209
D38-18		61729.314		-7126.117
D38-23		61717.844		-7126.782
D38-24		61717.702		-7124.338
D38-25		61717.591		-7122.423
D38-28		61716.399		-7101.883
D38-29		61716.200		-7098.445
D38-30		61730.088		-7139.256
D38-31		61718.610		-7139.923
D38-32		61726.577		-7079.181
D38-33		61698.160		-7089.894

凡 例	
	施工地区界
	道 路
	街区番号
	画地番号
D14-1	計 算 点
D14-2	境界標あり

平成25年 3月22日測量
平成25年 3月12日測量
平成24年10月 5日測量
平成23年11月23日測量
平成23年11月22日測量

面積（座標法）計算書

地番：38D-1

測点名	[1] X(i)	[2] X(i+1)-X(i-1)	[3] Y(i)	[4] Y(i+1)-Y(i-1)	[2]*[3]	[1]*[4]	方向角	夾角	距離
D38-1	61730.172	-3.516	-7140.693	-4.912	25106.676588	-303218.604864	223-59-16	130-38-32	5.004
D38-2	61726.572	-11.357	-7144.168	-2.743	81136.315976	-169315.986996	174-36-33	130-37-17	7.791
D38-9	61718.815	-7.962	-7143.436	4.245	56876.037432	261996.369675	93-20-23	98-43-50	3.519
D38-31	61718.610	11.273	-7139.923	4.180	-80488.351979	257983.789800	3-19-33	89-59-10	11.497
D38-30	61730.088	11.562	-7139.256	-0.770	-82544.077872	-47532.167760	273-20-44	90-01-11	1.439
合計				倍面積	86.600145	-86.600145			29.250
				面積	43.3000725	43.3000725			
				坪数	13.09	13.09			

面積（座標法）計算書

地番：38D-2

測点名	[1] X(i)	[2] X(i+1)-X(i-1)	[3] Y(i)	[4] Y(i+1)-Y(i-1)	[2]*[3]	[1]*[4]	方向角	夾角	距離
D38-30	61730.088	-10.704	-7139.256	-13.806	76418.596224	-852245.594928	183-19-33	89-57-16	11.497
D38-31	61718.610	-12.244	-7139.923	12.474	87421.217212	769877.941140	93-20-10	90-00-37	13.163
D38-23	61717.844	10.704	-7126.782	13.806	-76285.074528	852076.554264	3-19-05	89-58-55	11.489
D38-18	61729.314	12.244	-7126.117	-12.474	-87252.176548	-770011.462836	273-22-17	90-03-12	13.162
合計				倍面積	302.562360	-302.562360			49.311
				面積	151.2811800	151.2811800			
				坪数	45.76	45.76			

面積（座標法）計算書

地番：38D-4

測点名	[1] X(i)	[2] X(i+1)-X(i-1)	[3] Y(i)	[4] Y(i+1)-Y(i-1)	[2]*[3]	[1]*[4]	方向角	夾角	距離
D38-18	61729.314	-10.024	-7126.117	-25.573	71432.196808	-1578603.746922	183-19-05	89-59-44	11.489
D38-23	61717.844	-11.612	-7126.782	1.779	82756.192584	109796.044476	93-19-31	90-00-26	2.448
D38-24	61717.702	-0.253	-7124.338	4.359	1802.457514	269027.463018	93-19-02	179-59-31	1.918
D38-25	61717.591	-1.303	-7122.423	22.455	9280.517169	1385868.505905	93-19-17	180-00-15	20.575
D38-28	61716.399	10.277	-7101.883	21.214	-72986.051591	1309251.688386	3-21-48	90-02-31	11.489
D38-15	61727.868	12.915	-7101.209	-24.234	-91712.114235	-1495913.153112	273-19-21	89-57-33	24.950
合計				倍面積	573.198249	-573.198249			72.869
				面積	286.5991245	286.5991245			
				坪数	86.69	86.69			

面積（座標法）計算書

地番：38D-7

測点名	[1] X(i)	[2] X(i+1)-X(i-1)	[3] Y(i)	[4] Y(i+1)-Y(i-1)	[2]*[3]	[1]*[4]	方向角	夾角	距離
D38-15	61727.868	-10.178	-7101.209	-22.702	72276.105202	-1401346.059336	183-21-48	90-00-33	11.489
D38-28	61716.399	-11.668	-7101.883	2.764	82864.770844	170584.126836	93-18-46	89-56-58	3.444
D38-29	61716.200	-17.693	-7098.445	2.430	125592.787385	149970.366000	183-17-52	269-59-06	17.523
D38-12	61698.706	-18.040	-7099.453	8.551	128074.132120	527585.635006	93-16-09	89-58-17	9.575
D38-33	61698.160	-1.316	-7089.894	23.021	9330.300504	1420353.341360	93-16-25	180-00-16	13.484
D38-13	61697.390	28.158	-7076.432	15.149	-199258.172256	934653.761110	3-20-15	90-03-50	28.977
D38-14	61726.318	29.187	-7074.745	-2.749	-206490.582315	-169685.648182	273-20-29	90-00-14	4.444
D38-32	61726.577	1.550	-7079.181	-26.464	-10972.730550	-1633532.133728	273-21-15	180-00-46	22.066
合計				倍面積	1416.610934	-1416.610934			111.002
				面積	708.3054670	708.3054670			
				坪数	214.26	214.26			

面積（座標法）計算書

地番：38D-8

測点名	[1] X(i)	[2] X(i+1)-X(i-1)	[3] Y(i)	[4] Y(i+1)-Y(i-1)	[2]*[3]	[1]*[4]	方向角	夾角	距離
D38-14	61726.318	-28.204	-7074.745	-14.187	199536.107980	-875711.273466	183-20-15	90-01-21	28.977
D38-13	61697.390	-29.884	-7076.432	14.417	211472.093888	889491.271630	93-23-50	90-03-35	16.132
D38-5	61696.434	2.651	-7060.328	19.549	-18716.929528	1206103.588266	43-41-02	130-17-12	4.988
D38-6	61700.041	25.666	-7056.883	1.652	-181121.959078	101928.467732	355-21-11	131-40-09	22.132
D38-7	61722.100	25.553	-7058.676	-5.362	-180370.347828	-330953.900200	314-23-30	139-02-19	4.995
D38-8	61725.594	4.218	-7062.245	-16.069	-29788.549410	-991868.569986	273-18-54	138-55-24	12.521
合計				倍面積	1010.416024	-1010.416024			89.745
				面積	505.2080120	505.2080120			
				坪数	152.82	152.82			

面積（座標法）計算書

地番：38D-9

測点名	[1] X(i)	[2] X(i+1)-X(i-1)	[3] Y(i)	[4] Y(i+1)-Y(i-1)	[2]*[3]	[1]*[4]	方向角	夾角	距離
D38-25	61717.591	-16.291	-7122.423	-21.544	116031.393093	-1329643.780504	183-17-12	89-57-55	17.512
D38-11	61700.108	-18.885	-7123.427	22.970	134525.918895	1417251.480760	93-20-49	90-03-37	24.015
D38-12	61698.706	16.092	-7099.453	24.982	-114244.397676	1541357.073292	3-17-52	89-57-03	17.523
D38-29	61716.200	17.693	-7098.445	-2.430	-125592.787385	-149970.366000	273-18-46	90-00-54	3.444
D38-28	61716.399	1.391	-7101.883	-23.978	-9878.719253	-1479835.815222	273-19-17	180-00-31	20.575
合計				倍面積	841.407674	-841.407674			83.069
				面積	420.7038370	420.7038370			
				坪数	127.26	127.26			

面積（座標法）計算書

地番：38D-10

測点名	[1] X(i)	[2] X(i+1)-X(i-1)	[3] Y(i)	[4] Y(i+1)-Y(i-1)	[2]*[3]	[1]*[4]	方向角	夾角	距離
D38-24	61717.702	-17.373	-7124.338	-2.924	123771.124074	-180462.560648	183-18-10	89-59-08	17.513
D38-10	61700.218	-17.594	-7125.347	0.911	125363.355118	56208.898598	93-16-44	89-58-34	1.923
D38-11	61700.108	17.373	-7123.427	2.924	-123755.297271	180411.115792	3-17-12	90-00-28	17.512
D38-25	61717.591	17.594	-7122.423	-0.911	-125311.910262	-56224.725401	273-19-02	90-01-50	1.918
合計				倍面積	67.271659	-67.271659			38.866
				面積	33.6358295	33.6358295			
				坪数	10.17	10.17			

面積（座標法）計算書

地 番： 38D-11

測点名	[1] X(i)	[2] X(i+1)-X(i-1)	[3] Y(i)	[4] Y(i+1)-Y(i-1)	[2]*[3]	[1]*[4]	方向角	夾 角	距 離
D38-9	61718.815	-14.156	-7143.436	-2.148	101122.480016	-132572.014620	174-34-13	81-13-50	14.426
D38-3	61704.454	-17.838	-7142.071	4.956	127400.262498	305807.274024	134-04-33	139-30-20	4.998
D38-4	61700.977	-4.236	-7138.480	16.724	30238.601280	1031887.139348	93-18-27	139-13-54	13.155
D38-10	61700.218	16.725	-7125.347	14.142	-119171.428575	872564.482956	3-18-10	89-59-43	17.513
D38-24	61717.702	17.626	-7124.338	-1.435	-125573.581588	-88564.902370	273-19-31	90-01-21	2.448
D38-23	61717.844	0.908	-7126.782	-15.585	-6471.118056	-961872.598740	273-20-10	180-00-39	13.163
D38-31	61718.610	0.971	-7139.923	-16.654	-6932.865233	-1027861.730940	273-20-23	180-00-13	3.519
合計				倍面積	612.350342	-612.350342			69.222
				面 積	306.1751710	306.1751710			
				坪 数	92.61	92.61			