
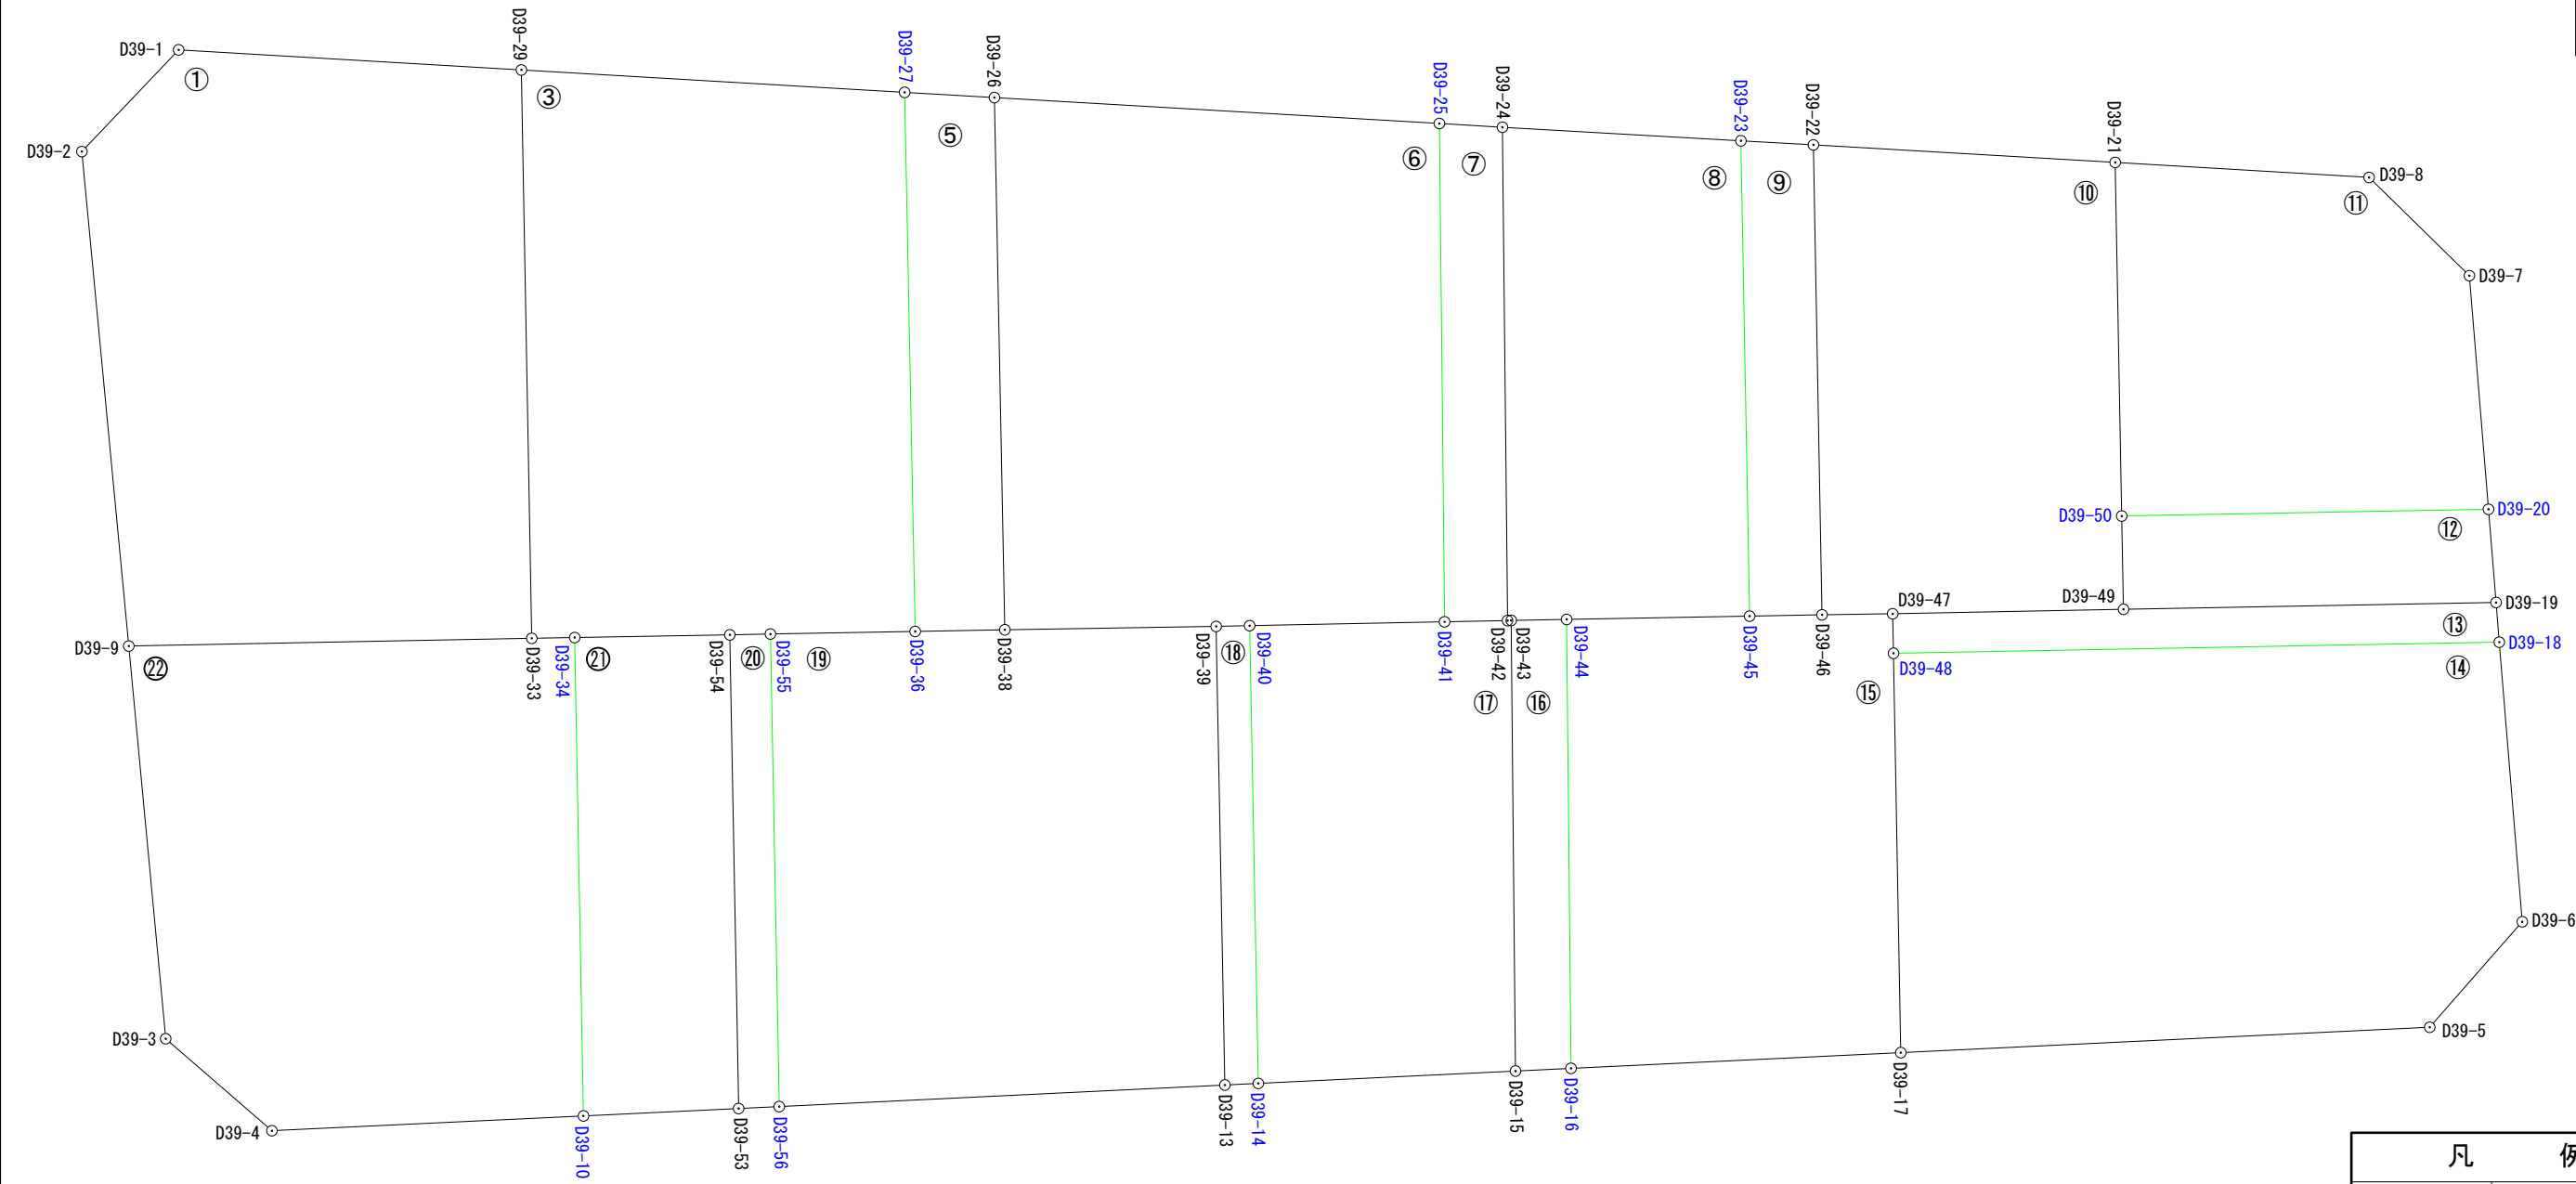


出来形確認測量図 (縮尺1 : 250)

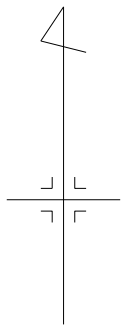

凡 例	
	施工地区界
	道 路
	街区番号
	画地番号
D14-1	計 算 点
D14-2	境界標あり

平成23年11月23日測量
平成23年11月22日測量

座 標 一 覽 表

測 点 名	X 座 標	Y 座 標
D39-1	61694.911	-7137.384
D39-2	61691.291	-7140.833
D39-3	61659.701	-7137.845
D39-4	61656.426	-7134.062
D39-5	61660.112	-7057.210
D39-6	61663.865	-7053.915
D39-7	61686.871	-7055.796
D39-8	61690.369	-7059.369
D39-9	61673.685	-7139.163
D39-10	61656.954	-7122.967
D39-13	61658.054	-7100.123
D39-14	61658.111	-7098.930
D39-15	61658.551	-7089.770
D39-16	61658.646	-7087.796
D39-17	61659.209	-7076.050
D39-18	61673.821	-7054.731
D39-19	61675.233	-7054.847
D39-20	61678.554	-7055.118
D39-21	61690.904	-7068.412
D39-22	61691.527	-7079.159
D39-23	61691.674	-7081.743
D39-24	61692.157	-7090.238
D39-25	61692.288	-7092.483
D39-26	61693.213	-7108.330
D39-27	61693.399	-7111.528
D39-29	61694.196	-7125.178
D39-33	61673.958	-7124.807
D39-34	61673.986	-7123.280
D39-36	61674.205	-7111.152
D39-38	61674.263	-7107.959
D39-39	61674.384	-7100.432
D39-40	61674.408	-7099.239
D39-41	61674.545	-7092.298
D39-42	61674.590	-7090.053
D39-43	61674.595	-7089.924
D39-44	61674.631	-7087.949
D39-45	61674.749	-7081.432
D39-46	61674.796	-7078.851
D39-47	61674.831	-7076.336
D39-48	61673.426	-7076.310
D39-49	61674.990	-7068.118
D39-50	61678.314	-7068.179
D39-53	61657.217	-7117.440
D39-54	61674.084	-7117.751
D39-55	61674.110	-7116.307
D39-56	61657.287	-7115.995

面積（座標法）計算書

地番：39D-1

測点名	[1] X(i)	[2] X(i+1)-X(i-1)	[3] Y(i)	[4] Y(i+1)-Y(i-1)	[2]*[3]	[1]*[4]	方向角	夾角	距離
D39-1	61694.911	-2.905	-7137.384	-15.655	20734.100520	-965833.831705	223-36-51	130-15-42	5.000
D39-2	61691.291	-21.226	-7140.833	-1.779	151571.321258	-109748.806689	174-34-53	130-58-02	17.685
D39-9	61673.685	-17.333	-7139.163	16.026	123743.112279	988382.475810	88-54-38	94-19-45	14.359
D39-33	61673.958	20.511	-7124.807	13.985	-146136.916377	862510.302630	358-56-59	90-02-21	20.241
D39-29	61694.196	20.953	-7125.178	-12.577	-149293.854634	-775927.903092	273-21-09	94-24-10	12.227
合計				倍面積	617.763046	-617.763046			69.512
				面積	308.8815230	308.8815230			
				坪数	93.43	93.43			

面積（座標法）計算書

地番：39D-3

測点名	[1] X(i)	[2] X(i+1)-X(i-1)	[3] Y(i)	[4] Y(i+1)-Y(i-1)	[2]*[3]	[1]*[4]	方向角	夾角	距離
D39-29	61694.196	-19.441	-7125.178	-13.279	138520.585498	-819237.228684	178-56-59	85-36-29	20.241
D39-33	61673.958	-20.210	-7124.807	1.898	143992.349470	117057.172284	88-56-58	89-59-59	1.527
D39-34	61673.986	0.126	-7123.280	7.056	-897.533280	435171.645216	88-59-04	180-02-06	5.530
D39-54	61674.084	0.124	-7117.751	6.973	-882.601124	430053.387732	88-58-06	179-59-02	1.444
D39-55	61674.110	0.121	-7116.307	6.599	-861.073147	406987.451890	88-56-39	179-58-33	5.156
D39-36	61674.205	19.289	-7111.152	4.779	-137167.010928	294741.025695	358-52-40	89-56-01	19.198
D39-27	61693.399	19.991	-7111.528	-14.026	-142166.556248	-865311.614374	273-20-30	94-27-50	13.673
合計				倍面積	538.160241	-538.160241			66.769
				面積	269.0801205	269.0801205			
				坪数	81.39	81.39			

面積（座標法）計算書

地番：39D-5

測点名	[1] X(i)	[2] X(i+1)-X(i-1)	[3] Y(i)	[4] Y(i+1)-Y(i-1)	[2]*[3]	[1]*[4]	方向角	夾角	距離
D39-27	61693.399	-19.008	-7111.528	-2.822	135175.924224	-174098.771978	178-52-40	85-32-57	19.198
D39-36	61674.205	-19.136	-7111.152	3.569	136079.004672	220115.237645	88-57-34	90-04-54	3.194
D39-38	61674.263	19.008	-7107.959	2.822	-135108.084672	174044.770186	358-52-42	89-55-08	18.954
D39-26	61693.213	19.136	-7108.330	-3.569	-136025.002880	-220183.077197	273-19-43	94-27-01	3.203
合計				倍面積	121.841344	-121.841344			44.549
				面積	60.9206720	60.9206720			
				坪数	18.42	18.42			

面積（座標法）計算書

地 番： 39D-6

測点名	[1] X(i)	[2] X(i+1)-X(i-1)	[3] Y(i)	[4] Y(i+1)-Y(i-1)	[2]*[3]	[1]*[4]	方向角	夾 角	距 離
D39-26	61693.213	-18.025	-7108.330	-15.476	128127.648250	-954764.164388	178-52-42	85-32-16	18.954
D39-38	61674.263	-18.829	-7107.959	7.898	133835.760011	487103.329174	89-04-44	90-12-02	7.528
D39-39	61674.384	0.145	-7100.432	8.720	-1029.562640	537800.628480	88-50-51	179-46-07	1.193
D39-40	61674.408	0.161	-7099.239	8.134	-1142.977479	501659.634672	88-52-09	180-01-18	6.942
D39-41	61674.545	17.880	-7092.298	6.756	-126810.288240	416673.226020	359-24-09	90-32-00	17.744
D39-25	61692.288	18.668	-7092.483	-16.032	-132402.472644	-989050.761216	273-20-26	93-56-17	15.874
合計				倍面積	578.107258	-578.107258			68.235
				面 積	289.0536290	289.0536290			
				坪 数	87.43	87.43			

面積（座標法）計算書

地 番： 39D-7

測点名	[1] X(i)	[2] X(i+1)-X(i-1)	[3] Y(i)	[4] Y(i+1)-Y(i-1)	[2]*[3]	[1]*[4]	方向角	夾 角	距 離
D39-25	61692.288	-17.612	-7092.483	-2.060	124912.810596	-127086.113280	179-24-09	86-03-47	17.744
D39-41	61674.545	-17.698	-7092.298	2.430	125519.490004	149869.144350	88-51-06	89-26-57	2.245
D39-42	61674.590	17.612	-7090.053	2.060	-124870.013436	127049.655400	359-23-48	90-32-42	17.568
D39-24	61692.157	17.698	-7090.238	-2.430	-125483.032124	-149911.941510	273-20-22	93-56-34	2.249
合計				倍面積	79.255040	-79.255040			39.806
				面 積	39.6275200	39.6275200			
				坪 数	11.98	11.98			

面積（座標法）計算書

地番：39D-8

測点名	[1] X(i)	[2] X(i+1)-X(i-1)	[3] Y(i)	[4] Y(i+1)-Y(i-1)	[2]*[3]	[1]*[4]	方向角	夾角	距離
D39-24	61692.157	-17.084	-7090.238	-8.310	121129.625992	-512661.824670	179-23-48	86-08-33	17.568
D39-42	61674.590	-17.562	-7090.053	0.314	124515.510786	19365.821260	87-46-49	88-23-01	0.129
D39-43	61674.595	0.041	-7089.924	2.104	-290.686884	129763.347880	88-57-21	181-10-32	1.975
D39-44	61674.631	0.154	-7087.949	8.492	-1091.544146	523740.966452	88-57-46	180-00-25	6.518
D39-45	61674.749	17.043	-7081.432	6.206	-120688.845576	382753.492294	358-56-50	89-59-04	16.928
D39-23	61691.674	17.408	-7081.743	-8.806	-123278.982144	-543256.881244	273-15-15	94-18-25	8.509
合計				倍面積	295.078028	-295.078028			51.627
				面積	147.5390140	147.5390140			
				坪数	44.63	44.63			

面積（座標法）計算書

地番：39D-9

測点名	[1] X(i)	[2] X(i+1)-X(i-1)	[3] Y(i)	[4] Y(i+1)-Y(i-1)	[2]*[3]	[1]*[4]	方向角	夾角	距離
D39-23	61691.674	-16.778	-7081.743	-2.273	118817.484054	-140225.175002	178-56-50	85-41-29	16.928
D39-45	61674.749	-16.878	-7081.432	2.892	119520.409296	178363.374108	88-57-24	90-00-34	2.581
D39-46	61674.796	16.778	-7078.851	2.273	-118768.962078	140186.811308	358-56-43	89-59-19	16.734
D39-22	61691.527	16.878	-7079.159	-2.892	-119482.045602	-178411.896084	273-15-21	94-18-38	2.588
合計				倍面積	86.885670	-86.885670			38.831
				面積	43.4428350	43.4428350			
				坪数	13.14	13.14			

面積（座標法）計算書

地番：39D-10

測点名	[1] X(i)	[2] X(i+1)-X(i-1)	[3] Y(i)	[4] Y(i+1)-Y(i-1)	[2]*[3]	[1]*[4]	方向角	夾角	距離
D39-22	61691.527	-16.108	-7079.159	-10.439	114031.093172	-643997.850353	178-56-43	85-37-39	16.734
D39-46	61674.796	-16.696	-7078.851	2.823	118188.496296	174107.949108	89-12-10	90-15-27	2.515
D39-47	61674.831	0.194	-7076.336	10.733	-1372.809184	661955.961123	88-53-30	179-41-20	8.220
D39-49	61674.990	3.483	-7068.118	8.157	-24618.254994	503082.893430	358-56-55	90-03-25	3.325
D39-50	61678.314	15.914	-7068.179	-0.294	-112483.000606	-18133.424316	358-56-23	179-59-28	12.592
D39-21	61690.904	13.213	-7068.412	-10.980	-93394.927756	-677366.125920	273-19-04	94-22-41	10.765
合計				倍面積	350.596928	-350.596928			54.151
				面積	175.2984640	175.2984640			
				坪数	53.02	53.02			

面積（座標法）計算書

地番：39D-11

測点名	[1] X(i)	[2] X(i+1)-X(i-1)	[3] Y(i)	[4] Y(i+1)-Y(i-1)	[2]*[3]	[1]*[4]	方向角	夾角	距離
D39-21	61690.904	-12.055	-7068.412	-8.810	85209.706660	-543496.864240	178-56-23	85-33-14	12.592
D39-50	61678.314	-12.350	-7068.179	13.294	87292.010650	819951.506316	88-56-50	90-00-27	13.063
D39-20	61678.554	8.557	-7055.118	12.383	-60370.644726	763765.534182	355-20-22	86-23-32	8.345
D39-7	61686.871	11.815	-7055.796	-4.251	-83364.229740	-262230.888621	314-23-32	139-03-10	5.000
D39-8	61690.369	4.033	-7059.369	-12.616	-28470.435177	-778285.695304	273-23-09	138-59-37	9.059
合計				倍面積	296.407667	-296.407667			48.059
				面積	148.2038335	148.2038335			
				坪数	44.83	44.83			

面積（座標法）計算書

地番：39D-12

測点名	[1] X(i)	[2] X(i+1)-X(i-1)	[3] Y(i)	[4] Y(i+1)-Y(i-1)	[2]*[3]	[1]*[4]	方向角	夾角	距離
D39-50	61678.314	-3.564	-7068.179	-13.000	25190.989956	-801818.082000	178-56-55	90-00-05	3.325
D39-49	61674.990	-3.081	-7068.118	13.332	21776.871558	822250.966680	88-57-04	90-00-09	13.273
D39-19	61675.233	3.564	-7054.847	13.000	-25143.474708	801778.029000	355-20-06	86-23-02	3.332
D39-20	61678.554	3.081	-7055.118	-13.332	-21736.818558	-822298.481928	268-56-50	93-36-44	13.063
合計				倍面積	87.568248	-87.568248			32.993
				面積	43.7841240	43.7841240			
				坪数	13.24	13.24			

面積（座標法）計算書

地番：39D-13

測点名	[1] X(i)	[2] X(i+1)-X(i-1)	[3] Y(i)	[4] Y(i+1)-Y(i-1)	[2]*[3]	[1]*[4]	方向角	夾角	距離
D39-47	61674.831	-1.564	-7076.336	-8.192	11067.389504	-505240.215552	178-56-23	90-02-53	1.405
D39-48	61673.426	-1.010	-7076.310	21.605	7147.073100	1332454.368730	88-57-05	90-00-42	21.583
D39-18	61673.821	1.807	-7054.731	21.463	-12747.898917	1323705.220123	355-18-13	86-21-08	1.417
D39-19	61675.233	1.169	-7054.847	-13.387	-8247.116143	-825646.344171	268-57-04	93-38-51	13.273
D39-49	61674.990	-0.402	-7068.118	-21.489	2841.383436	-1325333.860110	268-53-30	179-56-26	8.220
合計				倍面積	60.830980	-60.830980			45.898
				面積	30.4154900	30.4154900			
				坪数	9.20	9.20			

面積（座標法）計算書

地番：39D-14

測点名	[1] X(i)	[2] X(i+1)-X(i-1)	[3] Y(i)	[4] Y(i+1)-Y(i-1)	[2]*[3]	[1]*[4]	方向角	夾角	距離
D39-48	61673.426	-14.612	-7076.310	-21.319	103399.041720	-1314815.768894	178-57-08	90-00-03	14.219
D39-17	61659.209	-13.314	-7076.050	19.100	94210.529700	1177690.891900	87-15-21	88-18-13	18.862
D39-5	61660.112	4.656	-7057.210	22.135	-32858.369760	1364846.579120	41-16-55	134-01-34	4.994
D39-6	61663.865	13.709	-7053.915	2.479	-96702.120735	152864.721335	355-18-52	134-01-57	9.989
D39-18	61673.821	9.561	-7054.731	-22.395	-67450.283091	-1381185.221295	268-57-05	93-38-13	21.583
合計				倍面積	598.797834	-598.797834			69.647
				面積	299.3989170	299.3989170			
				坪数	90.56	90.56			

面積（座標法）計算書

地番：39D-15

測点名	[1] X(i)	[2] X(i+1)-X(i-1)	[3] Y(i)	[4] Y(i+1)-Y(i-1)	[2]*[3]	[1]*[4]	方向角	夾角	距離
D39-44	61674.631	-16.103	-7087.949	-6.364	114137.242747	-392497.351684	179-27-06	90-29-20	15.986
D39-16	61658.646	-15.422	-7087.796	11.899	109307.989912	733676.228754	87-15-21	87-48-15	11.759
D39-17	61659.209	14.780	-7076.050	11.486	-104584.019000	708217.674574	358-57-08	91-41-47	14.219
D39-48	61673.426	15.622	-7076.310	-0.286	-110546.114820	-17638.599836	358-56-23	179-59-15	1.405
D39-47	61674.831	1.370	-7076.336	-2.541	-9694.580320	-156715.745571	269-12-10	90-15-47	2.515
D39-46	61674.796	-0.082	-7078.851	-5.096	580.465782	-314294.760416	268-57-24	179-45-14	2.581
D39-45	61674.749	-0.165	-7081.432	-9.098	1168.436280	-561116.866402	268-57-46	180-00-22	6.518
合計				倍面積	369.420581	-369.420581			54.983
				面積	184.7102905	184.7102905			
				坪数	55.87	55.87			

面積（座標法）計算書

地番：39D-16

測点名	[1] X(i)	[2] X(i+1)-X(i-1)	[3] Y(i)	[4] Y(i+1)-Y(i-1)	[2]*[3]	[1]*[4]	方向角	夾角	距離
D39-43	61674.595	-16.080	-7089.924	-1.821	114005.977920	-112309.437495	179-27-00	90-29-39	16.045
D39-15	61658.551	-15.949	-7089.770	2.128	113074.741730	131209.396528	87-14-41	87-47-41	1.976
D39-16	61658.646	16.080	-7087.796	1.821	-113971.759680	112280.394366	359-27-06	92-12-25	15.986
D39-44	61674.631	15.949	-7087.949	-2.128	-113045.698601	-131243.614768	268-57-21	89-30-15	1.975
合計				倍面積	63.261369	-63.261369			35.982
				面積	31.6306845	31.6306845			
				坪数	9.56	9.56			

面積（座標法）計算書

地番：39D-17

測点名	[1] X(i)	[2] X(i+1)-X(i-1)	[3] Y(i)	[4] Y(i+1)-Y(i-1)	[2]*[3]	[1]*[4]	方向角	夾角	距離
D39-40	61674.408	-16.434	-7099.239	-6.632	116668.893726	-409024.673856	178-54-50	90-02-41	16.300
D39-14	61658.111	-15.857	-7098.930	9.469	112567.733010	583840.653059	87-15-00	88-20-10	9.171
D39-15	61658.551	16.484	-7089.770	9.006	-116867.768680	555296.910306	359-27-00	92-12-00	16.045
D39-43	61674.595	16.039	-7089.924	-0.283	-113715.291036	-17453.910385	267-46-49	88-19-49	0.129
D39-42	61674.590	-0.050	-7090.053	-2.374	354.502650	-146415.476660	268-51-06	181-04-17	2.245
D39-41	61674.545	-0.182	-7092.298	-9.186	1290.798236	-566542.370370	268-52-09	180-01-03	6.942
合計				倍面積	298.867906	-298.867906			50.832
				面積	149.4339530	149.4339530			
				坪数	45.20	45.20			

面積（座標法）計算書

地 番： 39D-18

測点名	[1] X(i)	[2] X(i+1)-X(i-1)	[3] Y(i)	[4] Y(i+1)-Y(i-1)	[2]*[3]	[1]*[4]	方向角	夾 角	距 離
D39-39	61674.384	-16.354	-7100.432	-0.884	116120.464928	-54520.155456	178-54-57	90-04-06	16.333
D39-13	61658.054	-16.273	-7100.123	1.502	115540.301579	92610.397108	87-15-52	88-20-55	1.194
D39-14	61658.111	16.354	-7098.930	0.884	-116095.901220	54505.770124	358-54-50	91-38-58	16.300
D39-40	61674.408	16.273	-7099.239	-1.502	-115525.916247	-92634.960816	268-50-51	89-56-01	1.193
合計				倍面積	38.949040	-38.949040			35.020
				面 積	19.4745200	19.4745200			
				坪 数	5.89	5.89			

面積（座標法）計算書

地番：39D-19

測点名	[1] X(i)	[2] X(i+1)-X(i-1)	[3] Y(i)	[4] Y(i+1)-Y(i-1)	[2]*[3]	[1]*[4]	方向角	夾角	距離
D39-55	61674.110	-16.918	-7116.307	-4.843	120393.681826	-298687.714730	178-56-15	89-59-36	16.826
D39-56	61657.287	-16.056	-7115.995	16.184	114254.415720	997861.532808	87-14-00	88-17-45	15.891
D39-13	61658.054	17.097	-7100.123	15.563	-121390.802931	959584.294402	358-54-57	91-40-57	16.333
D39-39	61674.384	16.209	-7100.432	-7.836	-115090.902288	-483280.473024	269-04-44	90-09-47	7.528
D39-38	61674.263	-0.179	-7107.959	-10.720	1272.324661	-661148.099360	268-57-34	179-52-50	3.194
D39-36	61674.205	-0.153	-7111.152	-8.348	1088.006256	-514856.263340	268-56-39	179-59-05	5.156
合計				倍面積	526.723244	-526.723244			64.928
				面積	263.3616220	263.3616220			
				坪数	79.66	79.66			

面積（座標法）計算書

地番：39D-20

測点名	[1] X(i)	[2] X(i+1)-X(i-1)	[3] Y(i)	[4] Y(i+1)-Y(i-1)	[2]*[3]	[1]*[4]	方向角	夾角	距離
D39-54	61674.084	-16.893	-7117.751	-1.133	120240.167643	-69876.737172	178-56-37	89-58-31	16.870
D39-53	61657.217	-16.797	-7117.440	1.756	119551.639680	108270.073052	87-13-36	88-16-59	1.447
D39-56	61657.287	16.893	-7115.995	1.133	-120210.503535	69857.706171	358-56-15	91-42-39	16.826
D39-55	61674.110	16.797	-7116.307	-1.756	-119532.608679	-108299.737160	268-58-06	90-01-51	1.444
合計				倍面積	48.695109	-48.695109			36.587
				面積	24.3475545	24.3475545			
				坪数	7.36	7.36			

面積（座標法）計算書

地番：39D-21

測点名	[1] X(i)	[2] X(i+1)-X(i-1)	[3] Y(i)	[4] Y(i+1)-Y(i-1)	[2]*[3]	[1]*[4]	方向角	夾角	距離
D39-34	61673.986	-17.130	-7123.280	-5.216	122021.786400	-321691.510976	178-56-50	89-57-46	17.035
D39-10	61656.954	-16.769	-7122.967	5.840	119445.033623	360076.611360	87-16-32	88-19-42	5.533
D39-53	61657.217	17.130	-7117.440	5.216	-121921.747200	321604.043872	358-56-37	91-40-05	16.870
D39-54	61674.084	16.769	-7117.751	-5.840	-119357.566519	-360176.650560	268-59-04	90-02-27	5.530
合計				倍面積	187.506304	-187.506304			44.968
				面積	93.7531520	93.7531520			
				坪数	28.36	28.36			

面積（座標法）計算書

地番：39D-22

測点名	[1] X(i)	[2] X(i+1)-X(i-1)	[3] Y(i)	[4] Y(i+1)-Y(i-1)	[2]*[3]	[1]*[4]	方向角	夾角	距離
D39-9	61673.685	-14.257	-7139.163	-13.038	101783.046891	-804101.505030	174-36-57	85-42-19	14.046
D39-3	61659.701	-17.259	-7137.845	5.101	123192.066855	314526.134801	130-53-00	136-16-03	5.004
D39-4	61656.426	-2.747	-7134.062	14.878	19597.268314	917324.306028	87-16-31	136-23-31	11.108
D39-10	61656.954	17.560	-7122.967	10.782	-125079.300520	664785.278028	358-56-50	91-40-19	17.035
D39-34	61673.986	17.004	-7123.280	-1.840	-121124.253120	-113480.134240	268-56-58	90-00-08	1.527
D39-33	61673.958	-0.301	-7124.807	-15.883	2144.566907	-979567.474914	268-54-38	179-57-40	14.359
合計				倍面積	513.395327	-513.395327			63.079
				面積	256.6976635	256.6976635			
				坪数	77.65	77.65			