
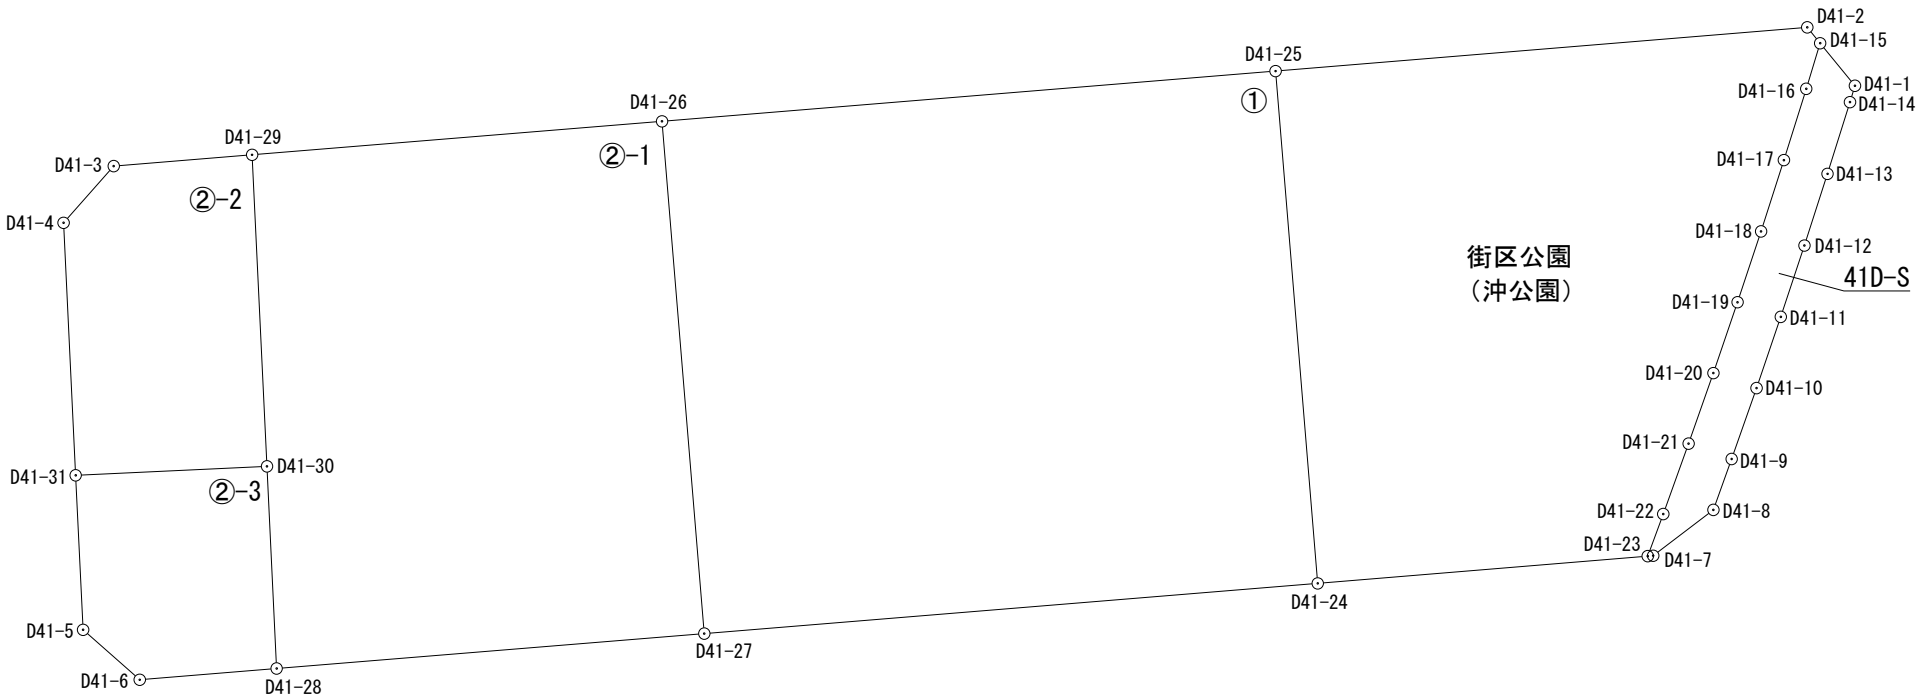


出来形確認測量図（縮尺１：５００）

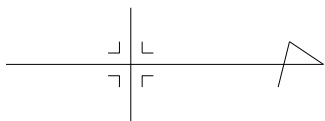

座 標 一 覧 表

測 点 名	X 座 標	Y 座 標
D41-1	61779.231	-7053.211
D41-2	61776.078	-7057.078
D41-3	61664.049	-7047.903
D41-4	61660.739	-7044.151
D41-5	61662.024	-7017.237
D41-6	61665.777	-7013.933
D41-7	61765.885	-7022.135
D41-8	61769.865	-7025.165
D41-9	61771.077	-7028.530
D41-10	61772.723	-7033.221
D41-11	61774.325	-7037.930
D41-12	61775.890	-7042.647
D41-13	61777.418	-7047.388
D41-14	61778.900	-7052.130
D41-15	61776.931	-7056.025
D41-16	61776.011	-7053.012

測 点 名	X 座 標	Y 座 標
D41-17	61774.530	-7048.296
D41-18	61773.019	-7043.580
D41-19	61771.465	-7038.898
D41-20	61769.864	-7034.210
D41-21	61768.224	-7029.545
D41-22	61766.553	-7024.890
D41-23	61765.525	-7022.106
D41-24	61743.694	-7020.304
D41-25	61740.905	-7054.180
D41-26	61700.322	-7050.862
D41-27	61703.115	-7016.985
D41-28	61674.830	-7014.674
D41-29	61673.208	-7048.646
D41-30	61674.193	-7028.048
D41-31	61661.537	-7027.451

平成24年10月 3日測量
平成24年10月 2日測量
平成23年11月24日測量
平成23年11月23日測量
平成23年11月22日測量
平成23年11月15日測量
平成23年11月14日測量

凡 例	
	施工地区界
	道 路
	街区番号
	画地番号
D14-1	計 算 点
D14-2	境界標あり

面積（座標法）計算書

地番：41D-1

測点名	[1] X(i)	[2] X(i+1)-X(i-1)	[3] Y(i)	[4] Y(i+1)-Y(i-1)	[2]*[3]	[1]*[4]	方向角	夾角	距離
D41-26	61700.322	-37.790	-7050.862	37.195	266452.074980	2294943.476790	85-17-13	89-57-39	33.992
D41-27	61703.115	43.372	-7016.985	30.558	-304340.673420	1885523.788170	355-19-27	90-02-14	40.715
D41-24	61743.694	37.790	-7020.304	-37.195	-265297.288160	-2296556.698330	265-17-36	89-58-09	33.991
D41-25	61740.905	-43.372	-7054.180	-30.558	305953.894960	-1886678.574990	175-19-34	90-01-58	40.718
合計				倍面積	2768.008360	-2768.008360			149.416
				面積	1384.0041800	1384.0041800			
				坪数	418.66	418.66			

面積（座標法）計算書

地番：41D-2-1

測点名	[1] X(i)	[2] X(i+1)-X(i-1)	[3] Y(i)	[4] Y(i+1)-Y(i-1)	[2]*[3]	[1]*[4]	方向角	夾角	距離
D41-29	61673.208	-26.129	-7048.646	22.814	184174.071334	1407012.567312	87-15-44	91-56-04	20.622
D41-30	61674.193	1.622	-7028.048	33.972	-11399.493856	2095195.684596	87-16-23	180-00-39	13.389
D41-28	61674.830	28.922	-7014.674	11.063	-202878.401428	682308.644290	355-19-45	88-03-22	28.379
D41-27	61703.115	25.492	-7016.985	-36.188	-178876.981620	-2232912.325620	265-17-13	89-57-28	33.992
D41-26	61700.322	-29.907	-7050.862	-31.661	210870.129834	-1953493.894842	175-19-40	90-02-27	27.204
合計				倍面積	1889.324264	-1889.324264			123.586
				面積	944.6621320	944.6621320			
				坪数	285.76	285.76			

面積（座標法）計算書

地番：41D-2-2

測点名	[1] X(i)	[2] X(i+1)-X(i-1)	[3] Y(i)	[4] Y(i+1)-Y(i-1)	[2]*[3]	[1]*[4]	方向角	夾角	距離
D41-3	61664.049	-12.469	-7047.903	4.495	87880.302507	277179.900255	131-25-07	136-03-23	5.003
D41-4	61660.739	-2.512	-7044.151	20.452	17694.907312	1261085.434028	87-15-51	135-50-44	16.719
D41-31	61661.537	13.454	-7027.451	16.103	-94547.325754	992935.730311	357-17-57	90-02-06	12.670
D41-30	61674.193	11.671	-7028.048	-21.195	-82024.348208	-1307184.520635	267-15-44	89-57-47	20.622
D41-29	61673.208	-10.144	-7048.646	-19.855	71501.465024	-1224521.544840	175-21-44	88-06-00	9.189
合計				倍面積	505.000881	-505.000881			64.203
				面積	252.5004405	252.5004405			
				坪数	76.38	76.38			

面積（座標法）計算書

地番：41D-2-3

測点名	[1] X(i)	[2] X(i+1)-X(i-1)	[3] Y(i)	[4] Y(i+1)-Y(i-1)	[2]*[3]	[1]*[4]	方向角	夾角	距離
D41-31	61661.537	-12.169	-7027.451	10.811	85517.051219	666622.876507	87-16-13	89-58-16	10.226
D41-5	61662.024	4.240	-7017.237	13.518	-29753.084880	833547.240432	41-21-34	134-05-21	5.000
D41-6	61665.777	12.806	-7013.933	2.563	-89820.425998	158049.386451	355-19-15	133-57-41	9.083
D41-28	61674.830	8.416	-7014.674	-14.115	-59035.496384	-870540.225450	267-16-23	91-57-08	13.389
D41-30	61674.193	-13.293	-7028.048	-12.777	93423.842064	-788011.163961	177-17-57	90-01-34	12.670
合計				倍面積	331.886021	-331.886021			50.368
				面積	165.9430105	165.9430105			
				坪数	50.19	50.19			

面積（座標法）計算書

地番：41D-K

測点名	[1] X(i)	[2] X(i+1)-X(i-1)	[3] Y(i)	[4] Y(i+1)-Y(i-1)	[2]*[3]	[1]*[4]	方向角	夾角	距離
D41-25	61740.905	-32.384	-7054.180	36.774	228442.565120	2270460.040470	85-17-36	90-00-12	33.991
D41-24	61743.694	24.620	-7020.304	32.074	-172839.884480	1980367.241356	355-16-53	89-59-17	21.905
D41-23	61765.525	22.859	-7022.106	-4.586	-160518.321054	-283256.697650	290-16-01	114-59-08	2.968
D41-22	61766.553	2.699	-7024.890	-7.439	-18960.178110	-459481.387767	289-44-48	179-28-47	4.946
D41-21	61768.224	3.311	-7029.545	-9.320	-23274.823495	-575679.847680	289-22-10	179-37-22	4.945
D41-20	61769.864	3.241	-7034.210	-9.353	-22797.874610	-577733.537992	288-51-20	179-29-10	4.954
D41-19	61771.465	3.155	-7038.898	-9.370	-22207.723190	-578798.627050	288-21-41	179-30-21	4.933
D41-18	61773.019	3.065	-7043.580	-9.398	-21588.572700	-580542.832562	287-45-55	179-24-14	4.952
D41-17	61774.530	2.992	-7048.296	-9.432	-21088.501632	-582657.366960	287-26-03	179-40-08	4.943
D41-16	61776.011	2.401	-7053.012	-7.729	-16934.281812	-477466.789019	286-58-47	179-32-44	3.150
D41-15	61776.931	0.067	-7056.025	-4.066	-472.753675	-251185.001446	230-59-25	124-00-38	1.355
D41-2	61776.078	-36.026	-7057.078	1.845	254238.292028	113976.863910	175-17-24	124-17-59	35.292
合計				倍面積	1997.942390	-1997.942390			128.334
				面積	998.9711950	998.9711950			
				坪数	302.18	302.18			

面積（座標法）計算書

地 番： 41D-S

測点名	[1] X(i)	[2] X(i+1)-X(i-1)	[3] Y(i)	[4] Y(i+1)-Y(i-1)	[2]*[3]	[1]*[4]	方向角	夾 角	距 離
D41-15	61776.931	-3.220	-7056.025	0.199	22720.400500	12293.609269	106-58-47	56-14-25	3.150
D41-16	61776.011	-2.401	-7053.012	7.729	16934.281812	477466.789019	107-26-03	180-27-16	4.943
D41-17	61774.530	-2.992	-7048.296	9.432	21088.501632	582657.366960	107-45-55	180-19-52	4.952
D41-18	61773.019	-3.065	-7043.580	9.398	21588.572700	580542.832562	108-21-41	180-35-46	4.933
D41-19	61771.465	-3.155	-7038.898	9.370	22207.723190	578798.627050	108-51-20	180-29-39	4.954
D41-20	61769.864	-3.241	-7034.210	9.353	22797.874610	577733.537992	109-22-10	180-30-50	4.945
D41-21	61768.224	-3.311	-7029.545	9.320	23274.823495	575679.847680	109-44-48	180-22-38	4.946
D41-22	61766.553	-2.699	-7024.890	7.439	18960.178110	459481.387767	110-16-01	180-31-13	2.968
D41-23	61765.525	-0.668	-7022.106	2.755	4690.766808	170164.021375	355-23-40	65-07-39	0.361
D41-7	61765.885	4.340	-7022.135	-3.059	-30476.065900	-188941.842215	322-43-04	147-19-24	5.002
D41-8	61769.865	5.192	-7025.165	-6.395	-36474.656680	-395018.286675	289-48-29	147-05-25	3.577
D41-9	61771.077	2.858	-7028.530	-8.056	-20087.538740	-497627.796312	289-20-07	179-31-38	4.971
D41-10	61772.723	3.248	-7033.221	-9.400	-22843.901808	-580663.596200	288-47-18	179-27-11	4.974
D41-11	61774.325	3.167	-7037.930	-9.426	-22289.124310	-582284.787450	288-21-17	179-33-59	4.970
D41-12	61775.890	3.093	-7042.647	-9.458	-21782.907171	-584276.367620	287-51-50	179-30-33	4.981
D41-13	61777.418	3.010	-7047.388	-9.483	-21212.637880	-585835.254894	287-21-19	179-29-29	4.968
D41-14	61778.900	1.813	-7052.130	-5.823	-12785.511690	-359738.534700	287-01-28	179-40-09	1.131
D41-1	61779.231	-1.969	-7053.211	-3.895	13887.772459	-240630.104745	230-44-22	123-42-54	3.634
合計				倍面積	198.551137	-198.551137			74.360
				面 積	99.2755685	99.2755685			
				坪 数	30.03	30.03			