
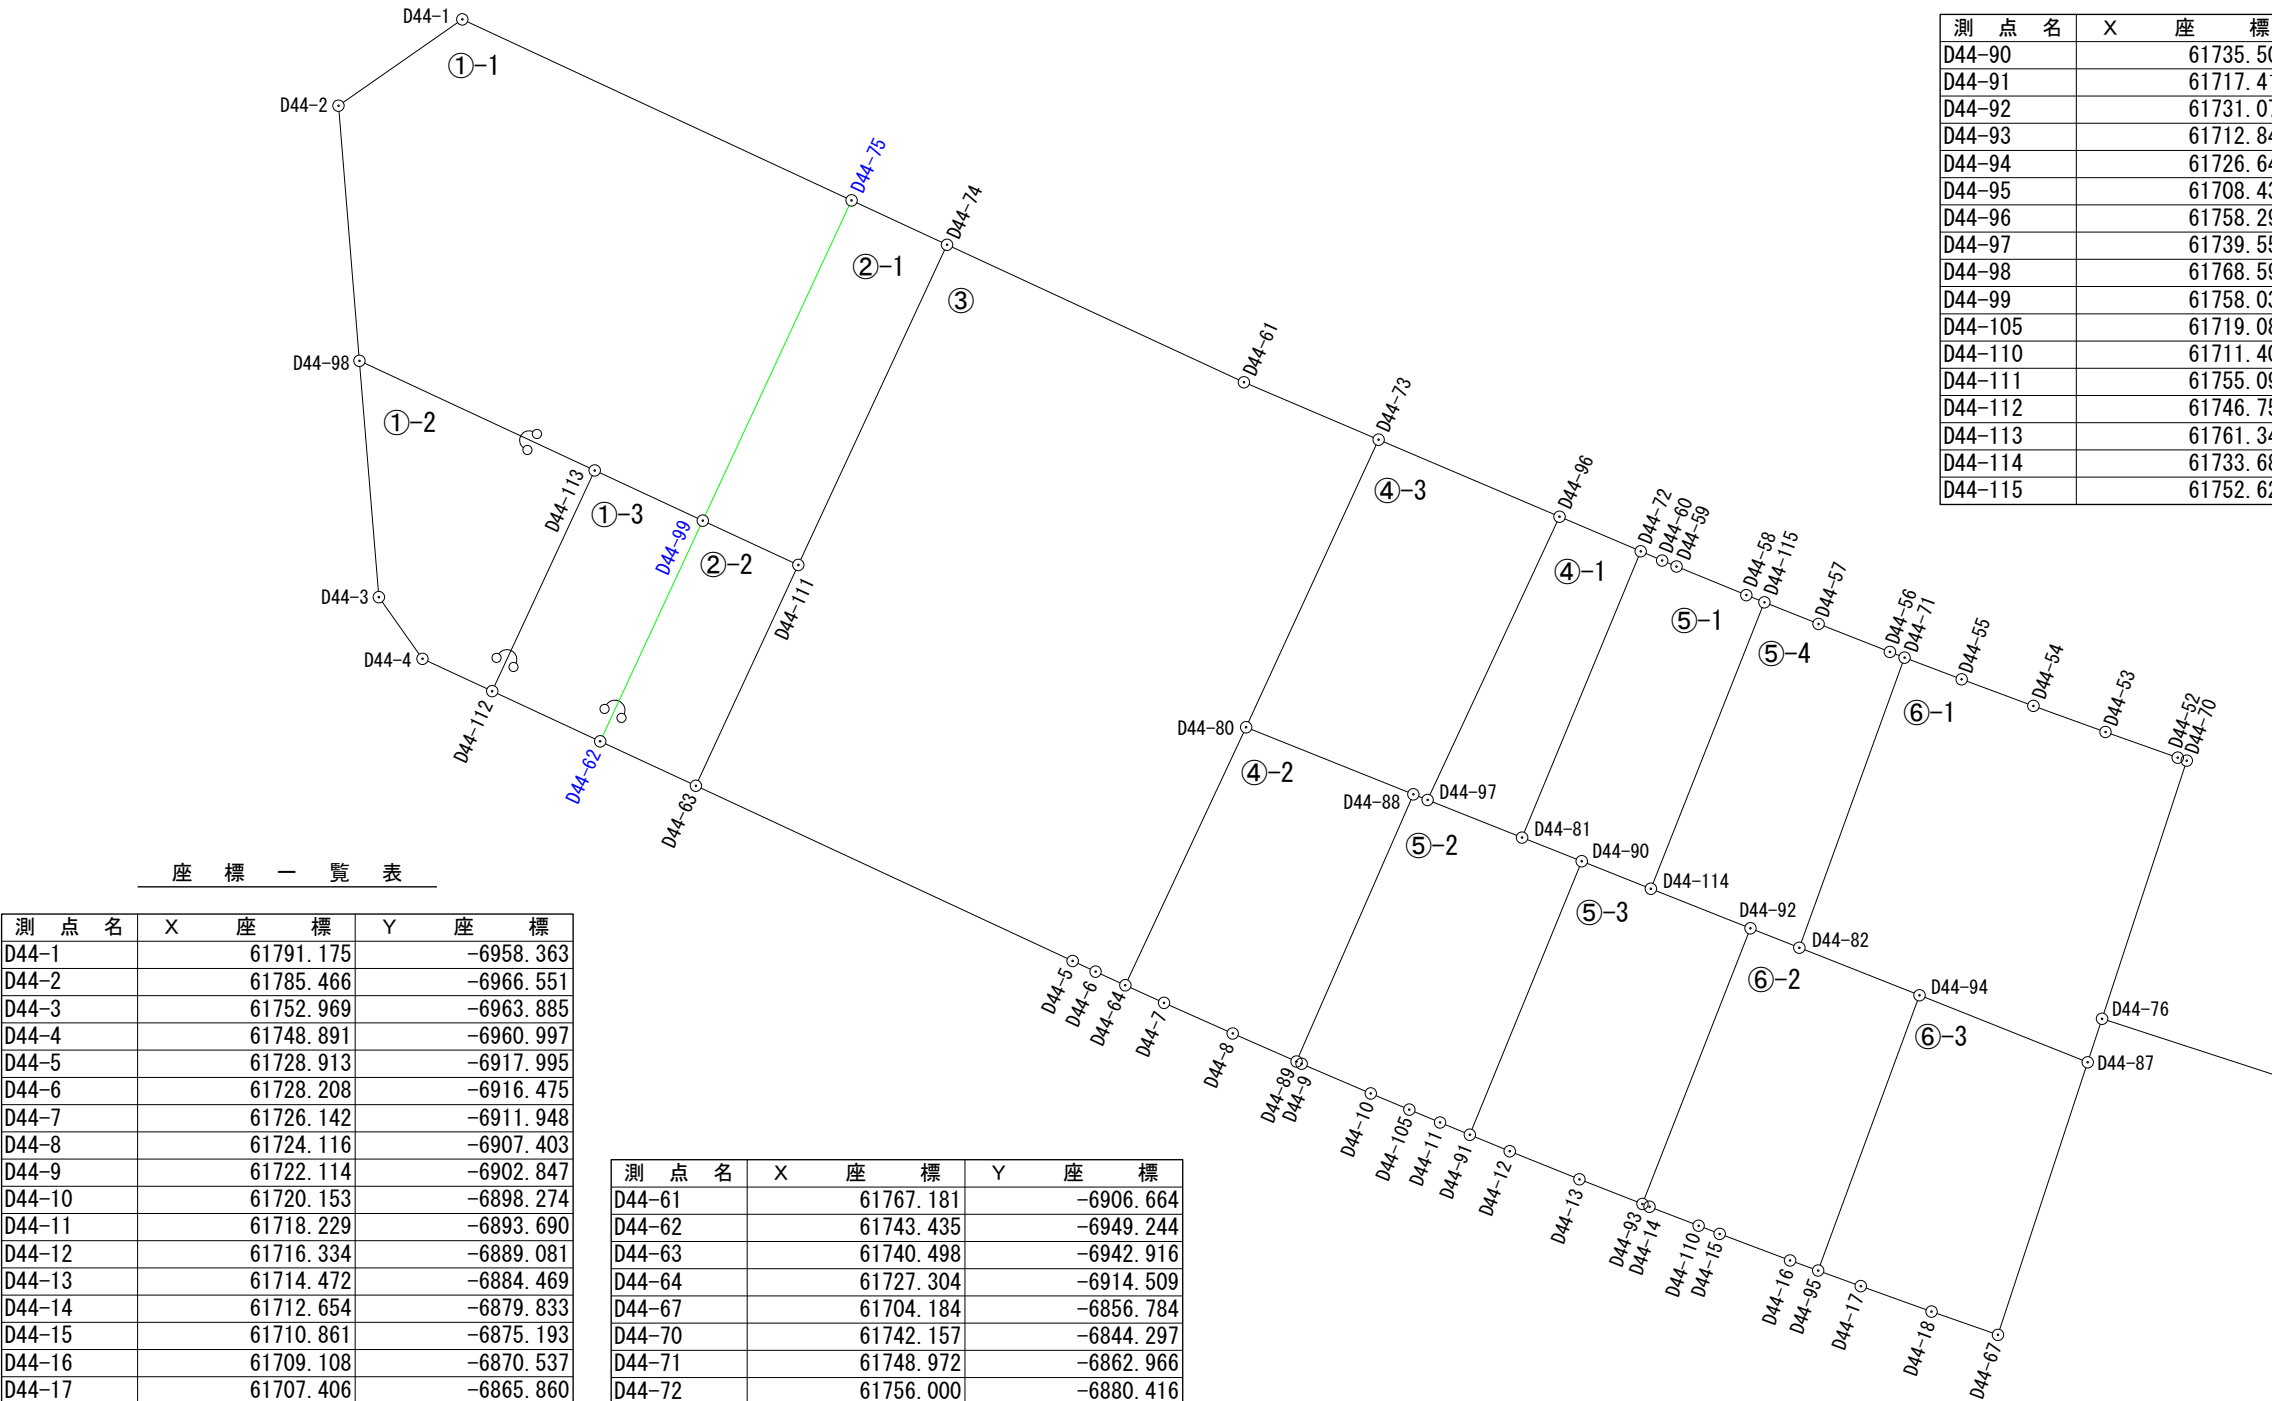


出来形確認測量図（縮尺１：５００）

2-1

2-2

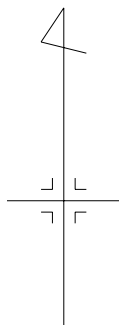

測点名	X座標	Y座標
D44-90	61735.504	-6884.318
D44-91	61717.419	-6891.721
D44-92	61731.071	-6873.157
D44-93	61712.840	-6880.302
D44-94	61726.642	-6861.973
D44-95	61708.434	-6868.676
D44-96	61758.291	-6885.791
D44-97	61739.555	-6894.515
D44-98	61768.594	-6965.167
D44-99	61758.030	-6942.460
D44-105	61719.080	-6895.724
D44-110	61711.402	-6876.585
D44-111	61755.096	-6936.138
D44-112	61746.751	-6956.387
D44-113	61761.349	-6949.609
D44-114	61733.688	-6879.743
D44-115	61752.625	-6872.231



座 標 一 覧 表			
測点名	X座標	Y座標	
D44-1	61791.175	-6958.363	
D44-2	61785.466	-6966.551	
D44-3	61752.969	-6963.885	
D44-4	61748.891	-6960.997	
D44-5	61728.913	-6917.995	
D44-6	61728.208	-6916.475	
D44-7	61726.142	-6911.948	
D44-8	61724.116	-6907.403	
D44-9	61722.114	-6902.847	
D44-10	61720.153	-6898.274	
D44-11	61718.229	-6893.690	
D44-12	61716.334	-6889.081	
D44-13	61714.472	-6884.469	
D44-14	61712.654	-6879.833	
D44-15	61710.861	-6875.193	
D44-16	61709.108	-6870.537	
D44-17	61707.406	-6865.860	
D44-18	61705.724	-6861.178	
D44-52	61742.358	-6844.893	
D44-53	61744.050	-6849.669	
D44-54	61745.776	-6854.437	
D44-55	61747.536	-6859.191	
D44-56	61749.346	-6863.935	
D44-57	61751.195	-6868.656	
D44-58	61753.106	-6873.430	
D44-59	61754.997	-6878.047	
D44-60	61755.394	-6878.998	

測点名	X座標	Y座標	
D44-61	61767.181	-6906.664	
D44-62	61743.435	-6949.244	
D44-63	61740.498	-6942.916	
D44-64	61727.304	-6914.509	
D44-67	61704.184	-6856.784	
D44-70	61742.157	-6844.297	
D44-71	61748.972	-6862.966	
D44-72	61756.000	-6880.416	
D44-73	61763.388	-6897.755	
D44-74	61776.272	-6926.305	
D44-75	61779.206	-6932.618	
D44-76	61725.085	-6849.901	
D44-80	61744.366	-6906.517	
D44-81	61737.073	-6888.266	
D44-82	61729.787	-6869.923	
D44-87	61722.212	-6850.848	
D44-88	61739.931	-6895.454	
D44-89	61722.262	-6903.182	

平成25年 7月30日測量
平成25年 3月 2日測量
平成25年 2月21日測量
平成24年12月11日測量
平成24年12月 7日測量
平成24年 6月25日測量
平成24年 4月24日測量
平成24年 3月30日測量
平成24年 3月28日測量


凡 例	
	施工地区界
	道 路
	街区番号
	画地番号
D14-1	計 算 点
D14-2	境界標あり

出来形確認測量図（縮尺１：５００）

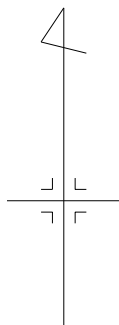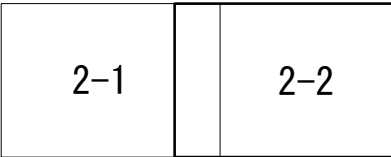

座 標 一 覧 表

測 点 名	X	座 標	Y	座 標
D44-19		61704. 073		-6856. 468
D44-20		61702. 469		-6851. 760
D44-21		61700. 902		-6847. 036
D44-22		61699. 367		-6842. 305
D44-23		61697. 864		-6837. 562
D44-24		61696. 412		-6832. 806
D44-25		61694. 988		-6828. 043
D44-26		61693. 596		-6823. 259
D44-27		61692. 253		-6818. 486
D44-28		61690. 926		-6813. 689
D44-29		61689. 643		-6808. 880
D44-30		61688. 409		-6804. 059
D44-31		61687. 210		-6799. 223
D44-32		61686. 043		-6794. 391
D44-33		61684. 911		-6789. 548
D44-34		61683. 821		-6784. 691
D44-35		61683. 148		-6781. 588
D44-36		61686. 297		-6777. 692
D44-37		61720. 062		-6777. 771
D44-38		61723. 955		-6780. 920
D44-39		61724. 109		-6781. 589
D44-40		61725. 293		-6786. 514
D44-41		61726. 492		-6791. 448
D44-42		61727. 718		-6796. 368
D44-43		61729. 008		-6801. 272
D44-44		61730. 331		-6806. 168
D44-45		61731. 690		-6811. 053
D44-46		61733. 060		-6815. 805
D44-47		61734. 539		-6820. 786
D44-48		61736. 018		-6825. 641
D44-49		61737. 540		-6830. 476
D44-50		61739. 111		-6835. 296
D44-51		61740. 719		-6840. 097
D44-67		61704. 184		-6856. 784
D44-68		61696. 254		-6832. 285
D44-69		61734. 741		-6821. 462
D44-70		61742. 157		-6844. 297
D44-76		61725. 085		-6849. 901
D44-77		61717. 455		-6826. 332
D44-87		61722. 212		-6850. 848
D44-100		61731. 058		-6808. 797
D44-101		61727. 643		-6796. 062
D44-102		61689. 132		-6806. 888
D44-103		61692. 567		-6819. 623
D44-104		61700. 373		-6845. 434
D44-106		61708. 386		-6801. 466
D44-107		61711. 813		-6814. 218
D44-108		61715. 495		-6826. 882
D44-109		61721. 391		-6838. 519

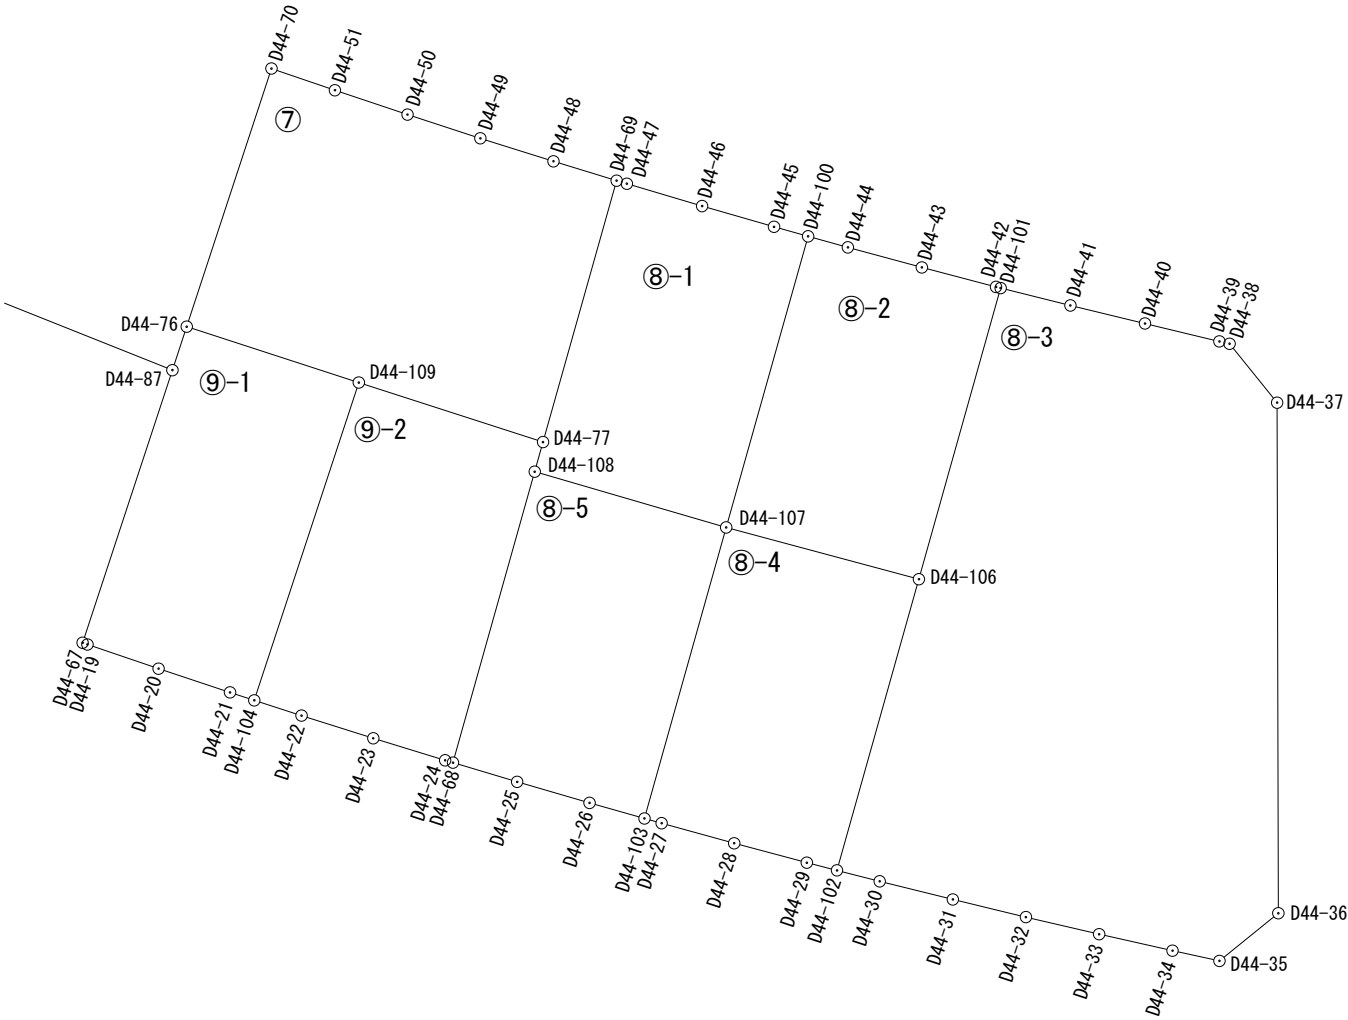

凡 例	
	施工地区界
	道 路
	街区番号
	画 地 番 号
D14-1	計 算 点
D14-2	境界標あり

平成24年12月11日測量
平成24年12月 7日測量
平成24年 3月30日測量
平成24年 3月28日測量

面積（座標法）計算書

地番： 44D-1-1

測点名	[1] X(i)	[2] X(i+1)-X(i-1)	[3] Y(i)	[4] Y(i+1)-Y(i-1)	[2]*[3]	[1]*[4]	方向角	夾角	距離
D44-1	61791.175	6.260	-6958.363	-33.933	-43559.352380	-2096759.941275	235-06-51	120-10-49	9.982
D44-2	61785.466	-22.581	-6966.551	-6.804	157311.688131	-420388.310664	175-18-38	120-11-47	16.929
D44-98	61768.594	-24.117	-6965.167	16.942	167978.932539	1046483.519548	114-58-13	119-39-35	17.162
D44-113	61761.349	-10.564	-6949.609	22.707	73415.669476	1402414.951743	114-54-13	179-56-00	7.882
D44-99	61758.030	17.857	-6942.460	16.991	-123971.508220	1049330.687730	24-55-40	90-01-27	23.351
D44-75	61779.206	33.145	-6932.618	-15.903	-229781.623610	-982474.713018	294-56-02	90-00-22	28.391
合計				倍面積	1393.805936	-1393.805936			103.697
				面積	696.9029680	696.9029680			
				坪数	210.81	210.81			

面積（座標法）計算書

地番： 44D-1-2

測点名	[1] X(i)	[2] X(i+1)-X(i-1)	[3] Y(i)	[4] Y(i+1)-Y(i-1)	[2]*[3]	[1]*[4]	方向角	夾角	距離
D44-98	61768.594	-8.380	-6965.167	-14.276	58368.099460	-881808.447944	175-18-34	60-20-21	15.678
D44-3	61752.969	-19.703	-6963.885	4.170	137209.426155	257509.880730	144-41-39	149-23-05	4.997
D44-4	61748.891	-6.218	-6960.997	7.498	43283.479346	462993.184718	114-54-04	150-12-25	5.082
D44-112	61746.751	12.458	-6956.387	11.388	-86662.669246	703172.000388	24-54-21	90-00-17	16.095
D44-113	61761.349	21.843	-6949.609	-8.780	-151800.309387	-542264.644220	294-58-13	90-03-52	17.162
合計				倍面積	398.026328	-398.026328			59.014
				面積	199.0131640	199.0131640			
				坪数	60.20	60.20			

面積（座標法）計算書

地番：44D-1-3

測点名	[1] X(i)	[2] X(i+1)-X(i-1)	[3] Y(i)	[4] Y(i+1)-Y(i-1)	[2]*[3]	[1]*[4]	方向角	夾角	距離
D44-113	61761.349	-11.279	-6949.609	-13.927	78384.639911	-860150.307523	204-54-21	90-00-08	16.095
D44-112	61746.751	-17.914	-6956.387	0.365	124616.716718	22537.564115	114-54-08	89-59-47	7.875
D44-62	61743.435	11.279	-6949.244	13.927	-78380.523076	859900.819245	24-55-47	90-01-39	16.095
D44-99	61758.030	17.914	-6942.460	-0.365	-124367.228440	-22541.680950	294-54-13	89-58-26	7.882
合計				倍面積	253.605113	-253.605113			47.947
				面積	126.8025565	126.8025565			
				坪数	38.35	38.35			

面積（座標法）計算書

地番：44D-2-1

測点名	[1] X(i)	[2] X(i+1)-X(i-1)	[3] Y(i)	[4] Y(i+1)-Y(i-1)	[2]*[3]	[1]*[4]	方向角	夾角	距離
D44-75	61779.206	-18.242	-6932.618	-16.155	126464.817556	-998043.072930	204-55-40	90-00-03	23.351
D44-99	61758.030	-24.110	-6942.460	-3.520	167382.710600	-217388.265600	114-53-45	89-58-05	6.970
D44-111	61755.096	18.242	-6936.138	16.155	-126529.029396	997653.575880	24-54-27	90-00-42	23.348
D44-74	61776.272	24.110	-6926.305	3.520	-166993.213550	217452.477440	294-55-37	90-01-10	6.961
合計				倍面積	325.285210	-325.285210			60.630
				面積	162.6426050	162.6426050			
				坪数	49.19	49.19			

面積（座標法）計算書

地番：44D-2-2

測点名	[1] X(i)	[2] X(i+1)-X(i-1)	[3] Y(i)	[4] Y(i+1)-Y(i-1)	[2]*[3]	[1]*[4]	方向角	夾角	距離
D44-99	61758.030	-11.661	-6942.460	-13.106	80956.026060	-809400.741180	204-55-47	90-02-02	16.095
D44-62	61743.435	-17.532	-6949.244	-0.456	121834.145808	-28155.006360	114-53-50	89-58-03	6.976
D44-63	61740.498	11.661	-6942.916	13.106	-80961.343476	809170.966788	24-54-21	90-00-31	16.095
D44-111	61755.096	17.532	-6936.138	0.456	-121604.371416	28160.323776	294-53-45	89-59-24	6.970
合計				倍面積	224.456976	-224.456976			46.136
				面積	112.2284880	112.2284880			
				坪数	33.94	33.94			

面積（座標法）計算書

地 番： 44D-3

測点名	[1] X(i)	[2] X(i+1)-X(i-1)	[3] Y(i)	[4] Y(i+1)-Y(i-1)	[2]*[3]	[1]*[4]	方向角	夾 角	距 離
D44-74	61776.272	-12.085	-6926.305	-29.474	83704.395925	-1820793.840928	204-54-27	90-04-12	23.348
D44-111	61755.096	-35.774	-6936.138	-16.611	248133.400812	-1025813.899656	204-54-21	179-59-54	16.095
D44-63	61740.498	-26.183	-6942.916	18.143	181786.369628	1120157.855214	114-55-56	90-01-35	27.482
D44-5	61728.913	-12.290	-6917.995	26.441	85022.158550	1632174.188633	114-52-57	179-57-01	1.676
D44-6	61728.208	-1.609	-6916.475	3.486	11128.608275	215184.533088	114-41-38	179-48-41	2.164
D44-64	61727.304	16.158	-6914.509	9.958	-111724.636422	614680.493232	25-05-56	90-24-18	18.841
D44-80	61744.366	36.084	-6906.517	16.754	-249214.759428	1034465.107964	24-43-55	179-37-59	20.943
D44-73	61763.388	22.815	-6897.755	-0.147	-157372.280325	-9079.218036	293-03-43	88-19-48	9.683
D44-61	61767.181	12.884	-6906.664	-28.550	-88985.458976	-1763453.017550	294-50-15	181-46-32	21.643
合計				倍面積	2477.798039	-2477.798039			141.875
				面 積	1238.8990195	1238.8990195			
				坪 数	374.76	374.76			

面積（座標法）計算書

地 番： 44D-4-1

測点名	[1] X(i)	[2] X(i+1)-X(i-1)	[3] Y(i)	[4] Y(i+1)-Y(i-1)	[2]*[3]	[1]*[4]	方向角	夾 角	距 離
D44-96	61758.291	-16.445	-6885.791	-14.099	113236.832995	-870730.144809	204-58-05	91-52-58	20.668
D44-97	61739.555	-21.218	-6894.515	-2.475	146287.819270	-152805.398625	111-39-44	86-41-39	6.724
D44-81	61737.073	16.445	-6888.266	14.099	-113277.534370	870430.992227	22-31-35	90-51-51	20.490
D44-72	61756.000	21.218	-6880.416	2.475	-145988.666688	152846.100000	293-05-07	90-33-32	5.843
合計				倍面積	258.451207	-258.451207			53.725
				面 積	129.2256035	129.2256035			
				坪 数	39.09	39.09			

面積（座標法）計算書

地 番： 44D-4-2

測点名	[1] X(i)	[2] X(i+1)-X(i-1)	[3] Y(i)	[4] Y(i+1)-Y(i-1)	[2]*[3]	[1]*[4]	方向角	夾 角	距 離
D44-80	61744.366	-12.627	-6906.517	-19.055	87208.590159	-1176538.894130	205-05-56	93-15-13	18.841
D44-64	61727.304	-18.224	-6914.509	-5.431	126010.012016	-335240.988024	114-24-19	89-18-23	2.812
D44-7	61726.142	-3.188	-6911.948	7.106	22035.290224	438625.965052	114-01-32	179-37-13	4.976
D44-8	61724.116	-3.880	-6907.403	8.766	26800.723640	541073.600856	113-42-45	179-41-13	4.610
D44-89	61722.262	15.815	-6903.182	11.949	-109173.823330	737519.308638	23-37-24	89-54-39	19.285
D44-88	61739.931	22.104	-6895.454	-3.335	-152417.115216	-205902.669885	291-50-43	88-13-19	11.919
合計				倍面積	463.677493	-463.677493			62.443
				面 積	231.8387465	231.8387465			
				坪 数	70.13	70.13			

面積（座標法）計算書

地番：44D-4-3

測点名	[1] X(i)	[2] X(i+1)-X(i-1)	[3] Y(i)	[4] Y(i+1)-Y(i-1)	[2]*[3]	[1]*[4]	方向角	夾角	距離
D44-73	61763.388	-13.925	-6897.755	-20.726	96051.238375	-1280107.979688	204-43-55	91-39-24	20.943
D44-80	61744.366	-23.457	-6906.517	2.301	162006.169269	142073.786166	111-50-43	87-06-48	11.919
D44-88	61739.931	-4.811	-6895.454	12.002	33174.029194	741002.651862	111-49-21	179-58-38	1.011
D44-97	61739.555	18.360	-6894.515	9.663	-126583.295400	596589.319965	24-58-05	93-08-44	20.668
D44-96	61758.291	23.833	-6885.791	-3.240	-164109.056903	-200096.862840	293-04-31	88-06-26	13.004
合計				倍面積	539.084535	-539.084535			67.545
				面積	269.5422675	269.5422675			
				坪数	81.53	81.53			

面積（座標法）計算書

地番：44D-5-1

測点名	[1] X(i)	[2] X(i+1)-X(i-1)	[3] Y(i)	[4] Y(i+1)-Y(i-1)	[2]*[3]	[1]*[4]	方向角	夾角	距離
D44-72	61756.000	-18.321	-6880.416	-9.268	126056.101536	-572354.608000	202-31-35	89-23-11	20.490
D44-81	61737.073	-20.496	-6888.266	-3.902	141181.899936	-240898.058846	111-40-25	89-08-50	4.248
D44-90	61735.504	-3.385	-6884.318	8.523	23303.416430	526171.700592	111-39-00	179-58-35	4.922
D44-114	61733.688	17.121	-6879.743	12.087	-117788.079903	746175.086856	21-38-15	89-59-15	20.373
D44-115	61752.625	19.418	-6872.231	6.313	-133444.981558	389844.321625	291-51-33	90-13-18	1.292
D44-58	61753.106	2.372	-6873.430	-5.816	-16303.775960	-359156.064496	292-16-22	180-24-49	4.989
D44-59	61754.997	2.288	-6878.047	-5.568	-15736.971536	-343851.823296	292-39-30	180-23-08	1.031
D44-60	61755.394	1.003	-6878.998	-2.369	-6899.634994	-146298.528386	293-08-24	180-28-54	1.542
合計				倍面積	367.973951	-367.973951			58.887
				面積	183.9869755	183.9869755			
				坪数	55.65	55.65			

面積（座標法）計算書

地 番： 44D-5-2

測点名	[1] X(i)	[2] X(i+1)-X(i-1)	[3] Y(i)	[4] Y(i+1)-Y(i-1)	[2]*[3]	[1]*[4]	方向角	夾 角	距 離
D44-88	61739.931	-17.293	-6895.454	-8.667	119243.086022	-535099.981977	203-37-24	91-48-03	19.285
D44-89	61722.262	-17.817	-6903.182	-7.393	122993.993694	-456312.682966	113-50-07	90-12-43	0.366
D44-9	61722.114	-2.109	-6902.847	4.908	14558.104323	302932.135512	113-12-38	179-22-31	4.976
D44-10	61720.153	-3.034	-6898.274	7.123	20929.363316	439632.649819	112-49-14	179-36-36	2.767
D44-105	61719.080	-1.924	-6895.724	4.584	13267.372976	282920.262720	112-42-14	179-53-00	2.205
D44-11	61718.229	-1.661	-6893.690	4.003	11450.419090	247058.070687	112-21-40	179-39-26	2.129
D44-91	61717.419	17.275	-6891.721	9.372	-119054.480275	578415.650868	22-15-41	89-54-01	19.542
D44-90	61735.504	19.654	-6884.318	3.455	-135304.385972	213296.166320	291-40-25	89-24-44	4.248
D44-81	61737.073	4.051	-6888.266	-10.197	-27904.365566	-629532.933381	291-39-44	179-59-19	6.724
D44-97	61739.555	2.858	-6894.515	-7.188	-19704.523870	-443783.921340	291-49-21	180-09-37	1.011
合計				倍面積	474.583738	-474.583738			63.253
				面 積	237.2918690	237.2918690			
				坪 数	71.78	71.78			

面積（座標法）計算書

地 番： 44D-5-3

測点名	[1] X(i)	[2] X(i+1)-X(i-1)	[3] Y(i)	[4] Y(i+1)-Y(i-1)	[2]*[3]	[1]*[4]	方向角	夾 角	距 離
D44-90	61735.504	-16.269	-6884.318	-11.978	112000.969542	-739467.866912	202-15-41	90-36-41	19.542
D44-91	61717.419	-19.170	-6891.721	-4.763	132114.291570	-293960.066697	112-20-31	90-04-50	2.854
D44-12	61716.334	-2.947	-6889.081	7.252	20302.121707	447566.854168	111-59-07	179-38-36	4.974
D44-13	61714.472	-3.494	-6884.469	8.779	24054.334686	541791.349688	111-23-16	179-24-09	4.475
D44-93	61712.840	16.599	-6880.302	11.312	-114206.132898	698095.646080	21-24-03	90-00-47	19.581
D44-92	61731.071	20.848	-6873.157	0.559	-143291.577136	34507.668689	291-40-15	90-16-12	7.087
D44-114	61733.688	4.433	-6879.743	-11.161	-30497.900719	-689009.691768	291-39-00	179-58-45	4.922
合計				倍面積	476.106752	-476.106752			63.435
				面 積	238.0533760	238.0533760			
				坪 数	72.01	72.01			

面積（座標法）計算書

地 番： 44D-5-4

測点名	[1] X(i)	[2] X(i+1)-X(i-1)	[3] Y(i)	[4] Y(i+1)-Y(i-1)	[2]*[3]	[1]*[4]	方向角	夾 角	距 離
D44-115	61752.625	-17.507	-6872.231	-11.087	120312.148117	-684651.353375	201-38-15	89-50-10	20.373
D44-114	61733.688	-21.554	-6879.743	-0.926	148285.980622	-57165.395088	111-40-15	90-02-00	7.087
D44-92	61731.071	-3.901	-6873.157	9.820	26812.185457	606199.117220	111-39-17	179-59-02	3.480
D44-82	61729.787	17.901	-6869.923	10.191	-122978.491623	629088.259317	19-55-55	88-16-38	20.407
D44-71	61748.972	19.559	-6862.966	5.988	-134232.751994	369752.844336	291-06-17	91-10-22	1.039
D44-56	61749.346	2.223	-6863.935	-5.690	-15258.527505	-351353.778740	291-23-17	180-17-00	5.070
D44-57	61751.195	3.279	-6868.656	-8.296	-22522.323024	-512287.913720	291-48-05	180-24-48	3.850
合計				倍面積	418.220050	-418.220050			61.306
				面 積	209.1100250	209.1100250			
				坪 数	63.25	63.25			

面積（座標法）計算書

地番：44D-6-1

測点名	[1] X(i)	[2] X(i+1)-X(i-1)	[3] Y(i)	[4] Y(i+1)-Y(i-1)	[2]*[3]	[1]*[4]	方向角	夾角	距離
D44-71	61748.972	-17.749	-6862.966	-10.732	121810.783534	-662689.967504	199-55-55	89-06-19	20.407
D44-82	61729.787	-22.330	-6869.923	0.993	153405.380590	61297.678491	111-35-01	91-39-06	8.549
D44-94	61726.642	-7.575	-6861.973	19.075	51979.445475	1177435.696150	111-42-45	180-07-44	11.975
D44-87	61722.212	-1.557	-6850.848	12.072	10666.770336	745110.543264	18-14-36	86-31-51	3.025
D44-76	61725.085	19.945	-6849.901	6.551	-136621.275445	404361.031835	18-10-22	179-55-46	17.968
D44-70	61742.157	17.273	-6844.297	5.008	-118221.542081	309204.722256	288-38-12	90-27-50	0.629
D44-52	61742.358	1.893	-6844.893	-5.372	-12957.382449	-331679.947176	289-30-28	180-52-16	5.067
D44-53	61744.050	3.418	-6849.669	-9.544	-23412.168642	-589285.213200	289-54-00	180-23-32	5.071
D44-54	61745.776	3.486	-6854.437	-9.522	-23894.567382	-587943.279072	290-18-55	180-24-55	5.069
D44-55	61747.536	3.196	-6859.191	-8.529	-21921.974436	-526644.734544	290-49-36	180-30-41	4.039
合計				倍面積	833.469500	-833.469500			81.799
				面積	416.7347500	416.7347500			
				坪数	126.06	126.06			

面積（座標法）計算書

地 番： 44D-6-2

測点名	[1] X(i)	[2] X(i+1)-X(i-1)	[3] Y(i)	[4] Y(i+1)-Y(i-1)	[2]*[3]	[1]*[4]	方向角	夾 角	距 離
D44-92	61731.071	-16.947	-6873.157	-10.379	116479.391679	-640706.785909	201-24-03	89-44-46	19.581
D44-93	61712.840	-18.417	-6880.302	-6.676	126714.521934	-411994.919840	111-37-58	90-13-55	0.505
D44-14	61712.654	-1.438	-6879.833	3.717	9893.199854	229385.934918	111-04-48	179-26-50	3.481
D44-110	61711.402	-1.793	-6876.585	4.640	12329.716905	286340.905280	111-14-19	180-09-31	1.493
D44-15	61710.861	-2.294	-6875.193	6.048	15771.692742	373227.287328	110-37-54	179-23-35	4.975
D44-16	61709.108	-2.427	-6870.537	6.517	16674.793299	402158.256836	109-54-32	179-16-38	1.979
D44-95	61708.434	17.534	-6868.676	8.564	-120435.364984	528471.028776	20-12-38	90-18-06	19.403
D44-94	61726.642	21.353	-6861.973	-1.247	-146523.709469	-76973.122574	291-35-01	91-22-23	8.549
D44-82	61729.787	4.429	-6869.923	-11.184	-30426.888967	-690385.937808	291-39-17	180-04-16	3.480
合計				倍面積	477.352993	-477.352993			63.446
				面 積	238.6764965	238.6764965			
				坪 数	72.19	72.19			

面積（座標法）計算書

地 番： 44D-6-3

測点名	[1] X(i)	[2] X(i+1)-X(i-1)	[3] Y(i)	[4] Y(i+1)-Y(i-1)	[2]*[3]	[1]*[4]	方向角	夾 角	距 離
D44-94	61726.642	-13.778	-6861.973	-17.828	94544.263994	-1100462.573576	200-12-38	88-29-53	19.403
D44-95	61708.434	-19.236	-6868.676	-3.887	132125.851536	-239860.682958	110-03-18	89-50-40	2.998
D44-17	61707.406	-2.710	-6865.860	7.498	18606.480600	462682.130188	109-45-39	179-42-21	4.975
D44-18	61705.724	-3.222	-6861.178	9.076	22106.715516	560041.151024	109-18-52	179-33-13	4.656
D44-67	61704.184	16.488	-6856.784	10.330	-113054.654592	637404.220720	18-13-30	88-54-38	18.980
D44-87	61722.212	22.458	-6850.848	-5.189	-153856.344384	-320276.558068	291-42-45	93-29-15	11.975
合計				倍面積	472.312670	-472.312670			62.987
				面 積	236.1563350	236.1563350			
				坪 数	71.43	71.43			

面積（座標法）計算書

地 番： 44D-7

測点名	[1] X(i)	[2] X(i+1)-X(i-1)	[3] Y(i)	[4] Y(i+1)-Y(i-1)	[2]*[3]	[1]*[4]	方向角	夾 角	距 離
D44-70	61742.157	-15.634	-6844.297	-9.804	107003.739298	-605320.107228	198-10-22	89-16-21	17.968
D44-76	61725.085	-20.766	-6849.901	5.778	142245.044166	356647.541130	107-58-51	89-48-29	11.966
D44-109	61721.391	-7.630	-6838.519	23.569	52177.899970	1454711.464479	107-53-55	179-55-04	12.807
D44-77	61717.455	13.350	-6826.332	17.057	-91131.532200	1052714.629935	15-44-03	87-50-08	17.959
D44-69	61734.741	18.563	-6821.462	0.691	-126626.799106	42658.706031	286-59-31	91-15-28	4.370
D44-48	61736.018	2.799	-6825.641	-9.014	-19104.969159	-556488.466252	287-28-24	180-28-53	5.069
D44-49	61737.540	3.093	-6830.476	-9.655	-21126.662268	-596075.948700	288-03-09	180-34-45	5.070
D44-50	61739.111	3.179	-6835.296	-9.621	-21729.405984	-593991.986931	288-31-02	180-27-53	5.063
D44-51	61740.719	3.046	-6840.097	-9.001	-20834.935462	-555728.211719	288-54-01	180-22-59	4.439
合計				倍面積	872.379255	-872.379255			84.711
				面 積	436.1896275	436.1896275			
				坪 数	131.94	131.94			

面積（座標法）計算書

地番：44D-8-1

測点名	[1] X(i)	[2] X(i+1)-X(i-1)	[3] Y(i)	[4] Y(i+1)-Y(i-1)	[2]*[3]	[1]*[4]	方向角	夾角	距離
D44-69	61734.741	-17.084	-6821.462	-5.546	116537.856808	-342380.873586	195-44-03	89-05-50	17.959
D44-77	61717.455	-19.246	-6826.332	-5.420	131379.585672	-334508.606100	195-40-29	179-56-26	2.036
D44-108	61715.495	-5.642	-6826.882	12.114	38517.268244	747621.506430	106-12-42	90-32-13	13.188
D44-107	61711.813	15.563	-6814.218	18.085	-106049.674734	1116058.138105	15-43-54	89-31-12	19.994
D44-100	61731.058	19.877	-6808.797	3.165	-135338.457969	195378.798570	285-38-59	89-55-05	2.343
D44-45	61731.690	2.002	-6811.053	-7.008	-13635.728106	-432615.683520	286-04-56	180-25-57	4.946
D44-46	61733.060	2.849	-6815.805	-9.733	-19418.228445	-600847.872980	286-32-16	180-27-20	5.196
D44-47	61734.539	1.681	-6820.786	-5.657	-11465.741266	-349232.287123	286-38-13	180-05-57	0.706
合計				倍面積	526.880204	-526.880204			66.368
				面積	263.4401020	263.4401020			
				坪数	79.69	79.69			

面積（座標法）計算書

地 番： 44D-8-2

測点名	[1] X(i)	[2] X(i+1)-X(i-1)	[3] Y(i)	[4] Y(i+1)-Y(i-1)	[2]*[3]	[1]*[4]	方向角	夾 角	距 離
D44-100	61731.058	-18.518	-6808.797	-8.050	126085.302846	-496935.016900	195-43-54	90-16-26	19.994
D44-107	61711.813	-22.672	-6814.218	7.331	154491.950496	452409.301103	105-02-33	89-18-39	13.204
D44-106	61708.386	15.830	-6801.466	18.156	-107667.206780	1120377.456216	15-40-32	90-37-59	20.001
D44-101	61727.643	19.332	-6796.062	5.098	-131381.470584	314687.524014	283-46-18	88-05-46	0.315
D44-42	61727.718	1.365	-6796.368	-5.210	-9277.042320	-321601.410780	284-44-16	180-57-58	5.071
D44-43	61729.008	2.613	-6801.272	-9.800	-17771.723736	-604944.278400	285-07-17	180-23-01	5.072
D44-44	61730.331	2.050	-6806.168	-7.525	-13952.644400	-464520.740775	285-27-28	180-20-11	2.728
合計				倍面積	527.165522	-527.165522			66.385
				面 積	263.5827610	263.5827610			
				坪 数	79.73	79.73			

面積（座標法）計算書

地 番： 44D-8-3

測点名	[1] X(i)	[2] X(i+1)-X(i-1)	[3] Y(i)	[4] Y(i+1)-Y(i-1)	[2]*[3]	[1]*[4]	方向角	夾 角	距 離
D44-101	61727.643	-18.106	-6796.062	-10.018	123049.498572	-618387.527574	195-40-32	91-40-07	20.001
D44-106	61708.386	-38.511	-6801.466	-10.826	261931.257126	-668054.986836	195-43-39	180-03-07	20.003
D44-102	61689.132	-19.977	-6806.888	-2.593	135981.201576	-159959.919276	104-20-10	88-36-31	2.920
D44-30	61688.409	-1.922	-6804.059	7.665	13077.401398	472841.654985	103-55-29	179-35-19	4.982
D44-31	61687.210	-2.366	-6799.223	9.668	16086.961618	596391.946280	103-34-40	179-39-11	4.971
D44-32	61686.043	-2.299	-6794.391	9.675	15620.304909	596812.466025	103-09-22	179-34-42	4.974
D44-33	61684.911	-2.222	-6789.548	9.700	15086.375656	598343.636700	102-38-55	179-29-33	4.978
D44-34	61683.821	-1.763	-6784.691	7.960	11961.410233	491003.215160	102-14-14	179-35-19	3.175
D44-35	61683.148	2.476	-6781.588	6.999	-16791.211888	431720.352852	51-03-09	128-48-55	5.009
D44-36	61686.297	36.914	-6777.692	3.817	-250191.722488	235456.595649	359-51-57	128-48-48	33.765
D44-37	61720.062	37.658	-6777.771	-3.228	-255237.300318	-199232.360136	321-01-52	141-09-55	5.007
D44-38	61723.955	4.047	-6780.920	-3.818	-27442.383240	-235662.060190	282-57-48	141-55-56	0.686
D44-39	61724.109	1.338	-6781.589	-5.594	-9073.766082	-345284.665746	283-31-04	180-33-16	5.065
D44-40	61725.293	2.383	-6786.514	-9.859	-16172.262862	-608549.663687	283-39-31	180-08-27	5.078
D44-41	61726.492	2.350	-6791.448	-9.548	-15959.902800	-589364.545616	284-00-25	180-20-54	4.755
合計				倍面積	1925.861410	-1925.861410			125.369
				面 積	962.9307050	962.9307050			
				坪 数	291.28	291.28			

面積（座標法）計算書

地 番： 44D-8-4

測点名	[1] X(i)	[2] X(i+1)-X(i-1)	[3] Y(i)	[4] Y(i+1)-Y(i-1)	[2]*[3]	[1]*[4]	方向角	夾 角	距 離
D44-107	61711.813	-15.819	-6814.218	-18.157	107794.114542	-1120501.388641	195-41-12	90-38-39	19.991
D44-103	61692.567	-19.560	-6819.623	-4.268	133391.825880	-263303.875956	105-26-18	89-45-06	1.180
D44-27	61692.253	-1.641	-6818.486	5.934	11189.135526	366081.829302	105-27-47	180-01-29	4.977
D44-28	61690.926	-2.610	-6813.689	9.606	17783.728290	592603.035156	104-56-17	179-28-30	4.977
D44-29	61689.643	-1.794	-6808.880	6.801	12215.130720	419551.262043	104-23-15	179-26-58	2.056
D44-102	61689.132	18.743	-6806.888	7.414	-127581.501784	457363.224648	15-43-39	91-20-24	20.003
D44-106	61708.386	22.681	-6801.466	-7.330	-154264.050346	-452322.469380	285-02-33	89-18-54	13.204
合計				倍面積	528.382828	-528.382828			66.388
				面 積	264.1914140	264.1914140			
				坪 数	79.91	79.91			

面積（座標法）計算書

地 番： 44D-8-5

測点名	[1] X(i)	[2] X(i+1)-X(i-1)	[3] Y(i)	[4] Y(i+1)-Y(i-1)	[2]*[3]	[1]*[4]	方向角	夾 角	距 離
D44-108	61715.495	-15.559	-6826.882	-18.067	106219.457038	-1115013.848165	195-41-06	89-28-24	19.985
D44-68	61696.254	-20.507	-6832.285	-1.161	140109.668495	-71629.350894	106-37-03	90-55-57	4.427
D44-25	61694.988	-2.658	-6828.043	9.026	18148.938294	556858.961688	106-13-24	179-36-21	4.982
D44-26	61693.596	-2.421	-6823.259	8.420	16519.110039	519460.078320	105-48-06	179-34-42	3.779
D44-103	61692.567	18.217	-6819.623	9.041	-124233.072191	557762.498247	15-41-12	89-53-06	19.991
D44-107	61711.813	22.928	-6814.218	-7.259	-156236.390304	-447966.050567	286-12-42	90-31-30	13.188
合計				倍面積	527.711371	-527.711371			66.352
				面 積	263.8556855	263.8556855			
				坪 数	79.81	79.81			

面積（座標法）計算書

地 番： 44D-9-1

測点名	[1] X(i)	[2] X(i+1)-X(i-1)	[3] Y(i)	[4] Y(i+1)-Y(i-1)	[2]*[3]	[1]*[4]	方向角	夾 角	距 離
D44-76	61725.085	0.821	-6849.901	-12.329	-5623.768721	-761008.572965	198-14-36	90-15-45	3.025
D44-87	61722.212	-20.901	-6850.848	-6.883	143189.574048	-424833.985196	198-13-30	179-58-54	18.980
D44-67	61704.184	-18.139	-6856.784	-5.620	124375.204976	-346777.514080	109-21-17	91-07-47	0.335
D44-19	61704.073	-1.715	-6856.468	5.024	11758.842620	310001.262752	108-48-50	179-27-33	4.974
D44-20	61702.469	-3.171	-6851.760	9.432	21726.930960	581977.687608	108-21-04	179-32-14	4.977
D44-21	61700.902	-2.096	-6847.036	6.326	14351.387456	390319.906052	108-16-26	179-55-22	1.687
D44-104	61700.373	20.489	-6845.434	8.517	-140256.097226	525502.076841	18-12-41	89-56-15	22.126
D44-109	61721.391	24.712	-6838.519	-4.467	-168993.481528	-275709.453597	287-58-51	89-46-10	11.966
合計				倍面積	528.592585	-528.592585			68.070
				面 積	264.2962925	264.2962925			
				坪 数	79.94	79.94			

面積（座標法）計算書

地 番： 44D-9-2

測点名	[1] X(i)	[2] X(i+1)-X(i-1)	[3] Y(i)	[4] Y(i+1)-Y(i-1)	[2]*[3]	[1]*[4]	方向角	夾 角	距 離
D44-109	61721.391	-17.082	-6838.519	-19.102	116815.581558	-1179002.010882	198-12-41	90-18-46	22.126
D44-104	61700.373	-22.024	-6845.434	-3.786	150763.838416	-233597.612178	107-49-23	89-36-42	3.287
D44-22	61699.367	-2.509	-6842.305	7.872	17167.343245	485697.417024	107-34-58	179-45-35	4.975
D44-23	61697.864	-2.955	-6837.562	9.499	20204.995710	586068.010136	106-58-38	179-23-40	4.973
D44-24	61696.412	-1.610	-6832.806	5.277	11000.817660	325571.966124	106-52-14	179-53-36	0.544
D44-68	61696.254	19.083	-6832.285	5.924	-130380.494655	365488.608696	15-41-06	88-48-52	19.985
D44-108	61715.495	21.201	-6826.882	5.953	-144736.725282	367392.341735	15-40-29	179-59-23	2.036
D44-77	61717.455	5.896	-6826.332	-11.637	-40248.053472	-718206.023835	287-53-55	92-13-26	12.807
合計				倍面積	587.303180	-587.303180			70.733
				面 積	293.6515900	293.6515900			
				坪 数	88.82	88.82			