

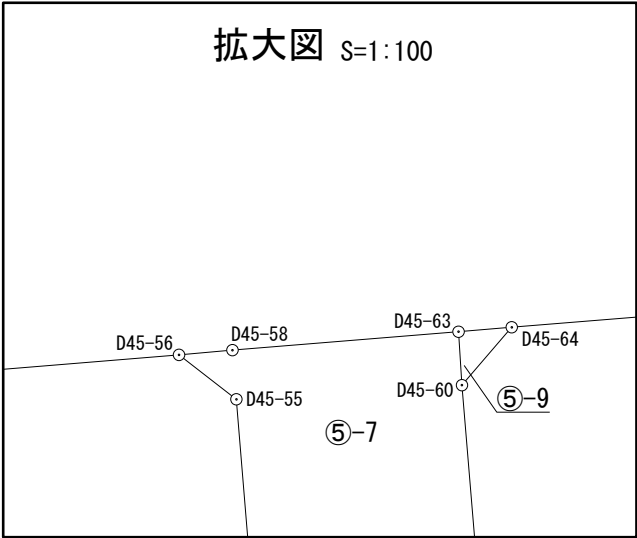


出来形確認測量図（縮尺1：500）

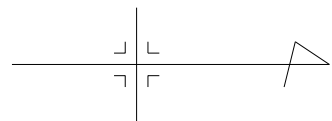

測点名	X座標	Y座標
D45-49	61663.369	-6927.966
D45-50	61568.723	-6930.724
D45-51	61588.126	-6920.784
D45-52	61587.185	-6932.242
D45-53	61586.247	-6943.702
D45-54	61570.012	-6942.374
D45-55	61585.280	-6955.509
D45-56	61584.521	-6956.096
D45-57	61604.128	-6933.617
D45-58	61585.228	-6956.159

測点名	X座標	Y座標
D45-59	61705.188	-6945.920
D45-60	61588.264	-6955.696
D45-61	61589.263	-6943.641
D45-62	61603.220	-6944.786
D45-63	61588.218	-6956.402
D45-64	61588.923	-6956.461
D45-65	61623.965	-6954.819
DK30	61570.704	-6948.633
DK31	61570.407	-6945.944

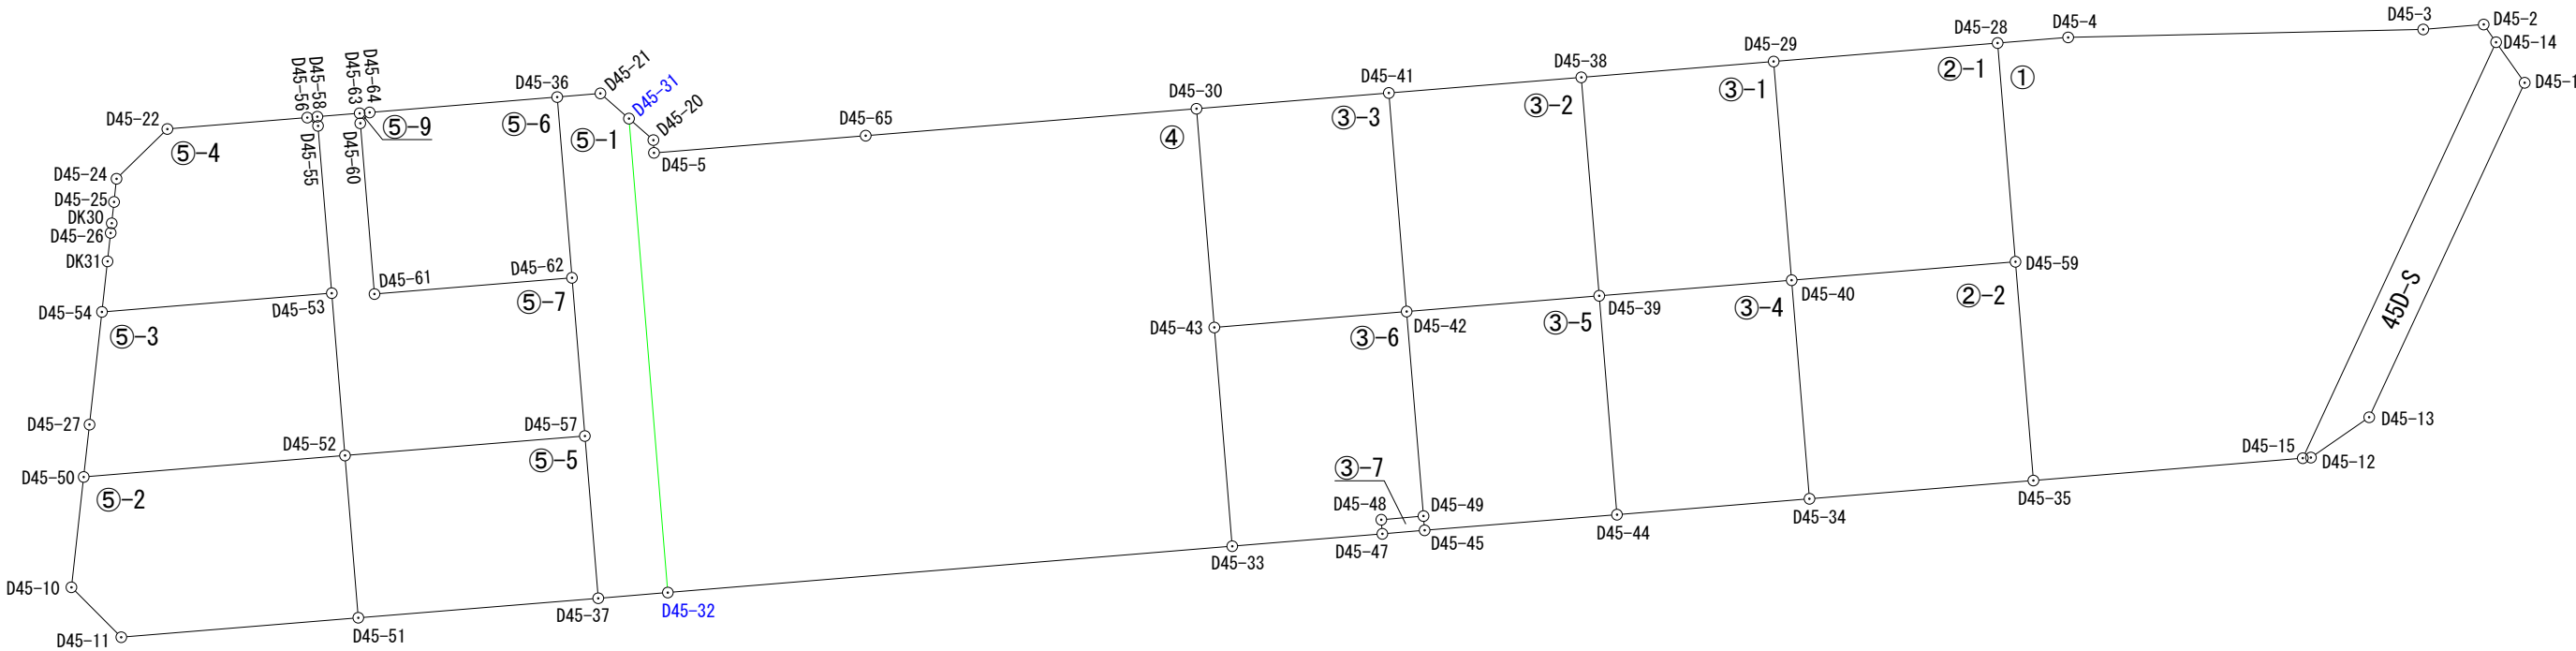


座 標 一 覧 表

測点名	X座標	Y座標
D45-1	61741.157	-6958.557
D45-2	61738.265	-6962.670
D45-3	61733.996	-6962.319
D45-4	61708.911	-6961.756
D45-5	61609.009	-6953.603
D45-10	61567.859	-6922.936
D45-11	61571.380	-6919.411
D45-12	61726.058	-6932.097
D45-13	61730.176	-6934.938
D45-14	61739.138	-6961.417
D45-15	61725.484	-6932.049
D45-20	61608.967	-6954.507
D45-21	61605.226	-6957.804
D45-22	61574.632	-6955.288
D45-24	61571.046	-6951.775
D45-25	61570.868	-6950.139
D45-26	61570.627	-6947.953
D45-27	61569.134	-6934.419
D45-28	61703.925	-6961.360

測点名	X座標	Y座標
D45-29	61688.106	-6960.056
D45-30	61647.334	-6956.718
D45-31	61607.246	-6956.024
D45-32	61609.991	-6922.566
D45-33	61649.857	-6925.837
D45-34	61690.631	-6929.184
D45-35	61706.454	-6930.475
D45-36	61602.176	-6957.546
D45-37	61605.072	-6922.162
D45-38	61674.519	-6958.935
D45-39	61675.786	-6943.513
D45-40	61689.373	-6944.614
D45-41	61660.924	-6957.836
D45-42	61662.180	-6942.403
D45-43	61648.592	-6941.279
D45-44	61677.038	-6928.064
D45-45	61663.450	-6926.960
D45-47	61660.462	-6926.710
D45-48	61660.387	-6927.707

拡大図 S=1:100

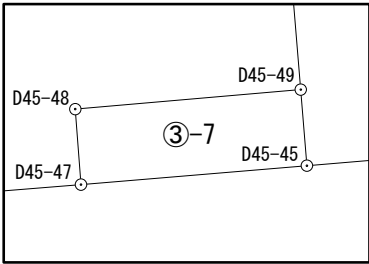

平成25年 3月19日測量
平成25年 3月 7日測量
平成25年 2月25日測量
平成24年10月 5日測量
平成24年10月 4日測量
平成24年 1月27日測量
平成23年11月29日測量
平成23年11月28日測量
平成23年11月27日測量
平成23年11月26日測量
平成23年11月25日測量
平成23年11月24日測量
平成23年11月10日測量

凡 例	
	施工地区界
	道 路
	街区番号
	画地番号
D14-1	計 算 点
D14-2	境界標あり

面積（座標法）計算書

地番： 45D-1

測点名	[1] X(i)	[2] X(i+1)-X(i-1)	[3] Y(i)	[4] Y(i+1)-Y(i-1)	[2]*[3]	[1]*[4]	方向角	夾角	距離
D45-28	61703.925	-3.723	-6961.360	15.836	25917.143280	977143.356300	85-19-25	89-51-53	15.492
D45-59	61705.188	2.529	-6945.920	30.885	-17566.231680	1905764.731380	85-18-51	179-59-26	15.497
D45-35	61706.454	20.296	-6930.475	13.871	-140660.920600	855930.223434	355-16-18	89-57-27	19.095
D45-15	61725.484	32.684	-6932.049	-30.942	-226567.089516	-1909909.925928	294-56-06	119-39-48	32.387
D45-14	61739.138	12.781	-6961.417	-30.621	-88973.870677	-1890514.144698	235-08-02	120-11-56	1.527
D45-2	61738.265	-5.142	-6962.670	-0.902	35802.049140	-55687.915030	175-17-59	120-09-57	4.283
D45-3	61733.996	-29.354	-6962.319	0.914	204371.911926	56424.872344	178-42-51	183-24-52	25.091
D45-4	61708.911	-30.071	-6961.756	0.959	209346.964676	59178.845649	175-27-32	176-44-41	5.002
合計				倍面積	1669.956549	-1669.956549			118.374
				面積	834.9782745	834.9782745			
				坪数	252.58	252.58			

面積（座標法）計算書

地番：45D-2-1

測点名	[1] X(i)	[2] X(i+1)-X(i-1)	[3] Y(i)	[4] Y(i+1)-Y(i-1)	[2]*[3]	[1]*[4]	方向角	夾角	距離
D45-29	61688.106	-14.552	-6960.056	16.746	101282.734912	1033029.023076	85-18-34	90-01-19	15.494
D45-40	61689.373	17.082	-6944.614	14.136	-118627.896348	872040.976728	355-16-45	89-58-11	15.869
D45-59	61705.188	14.552	-6945.920	-16.746	-101077.027840	-1033315.078248	265-19-25	90-02-40	15.492
D45-28	61703.925	-17.082	-6961.360	-14.136	118913.951520	-872246.683800	175-17-15	89-57-50	15.873
合計				倍面積	491.762244	-491.762244			62.728
				面積	245.8811220	245.8811220			
				坪数	74.37	74.37			

面積（座標法）計算書

地番：45D-2-2

測点名	[1] X(i)	[2] X(i+1)-X(i-1)	[3] Y(i)	[4] Y(i+1)-Y(i-1)	[2]*[3]	[1]*[4]	方向角	夾角	距離
D45-40	61689.373	-14.557	-6944.614	16.736	101092.745998	1032433.346528	85-20-20	90-03-35	15.481
D45-34	61690.631	17.081	-6929.184	14.139	-118357.391904	872243.831709	355-20-08	89-59-48	15.876
D45-35	61706.454	14.557	-6930.475	-16.736	-100886.924575	-1032719.214144	265-18-51	89-58-43	15.497
D45-59	61705.188	-17.081	-6945.920	-14.139	118643.259520	-872449.653132	175-16-45	89-57-54	15.869
合計				倍面積	491.689039	-491.689039			62.723
				面積	245.8445195	245.8445195			
				坪数	74.36	74.36			

面積（座標法）計算書

地番：45D-3-1

測点名	[1] X(i)	[2] X(i+1)-X(i-1)	[3] Y(i)	[4] Y(i+1)-Y(i-1)	[2]*[3]	[1]*[4]	方向角	夾角	距離
D45-38	61674.519	-12.320	-6958.935	16.543	85734.079200	1020281.567817	85-18-12	90-01-11	15.474
D45-39	61675.786	14.854	-6943.513	14.321	-103138.942102	883258.931306	355-22-02	90-03-50	13.632
D45-40	61689.373	12.320	-6944.614	-16.543	-85557.644480	-1020527.297539	265-18-34	89-56-32	15.494
D45-29	61688.106	-14.854	-6960.056	-14.321	103384.671824	-883435.366026	175-17-01	89-58-27	13.633
合計				倍面積	422.164442	-422.164442			58.233
				面積	211.0822210	211.0822210			
				坪数	63.85	63.85			

面積（座標法）計算書

地番：45D-3-2

測点名	[1] X(i)	[2] X(i+1)-X(i-1)	[3] Y(i)	[4] Y(i+1)-Y(i-1)	[2]*[3]	[1]*[4]	方向角	夾角	距離
D45-41	61660.924	-12.339	-6957.836	16.532	85852.738404	1019378.395568	85-20-50	89-58-08	15.484
D45-42	61662.180	14.862	-6942.403	14.323	-103177.993386	883187.404140	355-20-10	89-59-20	13.651
D45-39	61675.786	12.339	-6943.513	-16.532	-85676.006907	-1019624.094152	265-18-12	89-58-02	15.474
D45-38	61674.519	-14.862	-6958.935	-14.323	103423.691970	-883364.135637	175-22-42	90-04-30	13.639
合計				倍面積	422.430081	-422.430081			58.248
				面積	211.2150405	211.2150405			
				坪数	63.89	63.89			

面積（座標法）計算書

地番：45D-3-3

測点名	[1] X(i)	[2] X(i+1)-X(i-1)	[3] Y(i)	[4] Y(i+1)-Y(i-1)	[2]*[3]	[1]*[4]	方向角	夾角	距離
D45-30	61647.334	-12.332	-6956.718	16.557	85790.246376	1020694.909038	85-20-30	90-02-41	15.490
D45-43	61648.592	14.846	-6941.279	14.315	-103050.228034	882499.594480	355-16-17	89-55-47	13.634
D45-42	61662.180	12.332	-6942.403	-16.557	-85613.713796	-1020940.714260	265-20-50	90-04-33	15.484
D45-41	61660.924	-14.846	-6957.836	-14.315	103296.033256	-882676.127060	175-17-49	89-56-59	13.636
合計				倍面積	422.337802	-422.337802			58.244
				面積	211.1689010	211.1689010			
				坪数	63.87	63.87			

面積（座標法）計算書

地番：45D-3-4

測点名	[1] X(i)	[2] X(i+1)-X(i-1)	[3] Y(i)	[4] Y(i+1)-Y(i-1)	[2]*[3]	[1]*[4]	方向角	夾角	距離
D45-39	61675.786	-12.335	-6943.513	16.550	85648.232855	1020734.258300	85-22-01	89-59-59	15.500
D45-44	61677.038	14.845	-6928.064	14.329	-102847.110080	883770.277502	355-17-23	89-55-22	13.639
D45-34	61690.631	12.335	-6929.184	-16.550	-85471.484640	-1020979.943050	265-20-20	90-02-57	15.481
D45-40	61689.373	-14.845	-6944.614	-14.329	103092.794830	-883947.025717	175-22-02	90-01-42	13.632
合計				倍面積	422.432965	-422.432965			58.252
				面積	211.2164825	211.2164825			
				坪数	63.89	63.89			

面積（座標法）計算書

地番：45D-3-5

測点名	[1] X(i)	[2] X(i+1)-X(i-1)	[3] Y(i)	[4] Y(i+1)-Y(i-1)	[2]*[3]	[1]*[4]	方向角	夾角	距離
D45-42	61662.180	-12.417	-6942.403	15.547	86203.818051	958661.912460	85-17-31	89-57-21	14.486
D45-49	61663.369	1.270	-6927.966	15.443	-8798.516820	952267.407467	85-23-48	180-06-17	1.009
D45-45	61663.450	13.669	-6926.960	-0.098	-94684.616240	-6043.018100	355-21-18	89-57-30	13.633
D45-44	61677.038	12.336	-6928.064	-16.553	-85464.597504	-1020940.010014	265-22-01	90-00-43	15.500
D45-39	61675.786	-14.858	-6943.513	-14.339	103166.716154	-884369.095454	175-20-10	89-58-09	13.651
合計				倍面積	422.803641	-422.803641			58.279
				面積	211.4018205	211.4018205			
				坪数	63.94	63.94			

面積（座標法）計算書

地 番： 45D-3-6

測点名	[1] X(i)	[2] X(i+1)-X(i-1)	[3] Y(i)	[4] Y(i+1)-Y(i-1)	[2]*[3]	[1]*[4]	方向角	夾 角	距 離
D45-43	61648.592	-12.323	-6941.279	16.566	85537.381117	1021270.575072	85-19-01	90-02-44	15.494
D45-33	61649.857	11.870	-6925.837	14.569	-82209.685190	898176.766633	355-17-39	89-58-38	10.641
D45-47	61660.462	10.530	-6926.710	-1.870	-72938.256300	-115305.063940	265-41-53	90-24-14	1.000
D45-48	61660.387	2.907	-6927.707	-1.256	-20138.844249	-77445.446072	355-02-10	269-20-17	2.993
D45-49	61663.369	1.793	-6927.966	-14.696	-12421.843038	-906204.870824	265-17-31	90-15-21	14.486
D45-42	61662.180	-14.777	-6942.403	-13.313	102587.889131	-820908.602340	175-16-17	89-58-46	13.634
合計				倍面積	416.641471	-416.641471			58.248
				面 積	208.3207355	208.3207355			
				坪 数	63.01	63.01			

面積（座標法）計算書

地番：45D-3-7

測点名	[1] X(i)	[2] X(i+1)-X(i-1)	[3] Y(i)	[4] Y(i+1)-Y(i-1)	[2]*[3]	[1]*[4]	方向角	夾角	距離
D45-48	61660.387	-2.907	-6927.707	1.256	20138.844249	77445.446072	85-41-53	90-39-43	1.000
D45-47	61660.462	3.063	-6926.710	0.747	-21216.512730	46060.365114	355-13-02	89-31-09	2.998
D45-45	61663.450	2.907	-6926.960	-1.256	-20136.672720	-77449.293200	265-23-48	90-10-46	1.009
D45-49	61663.369	-3.063	-6927.966	-0.747	21220.359858	-46062.536643	175-02-10	89-38-22	2.993
合計				倍面積	6.018657	-6.018657			8.000
				面積	3.0093285	3.0093285			
				坪数	0.91	0.91			

面積（座標法）計算書

地番： 45D-4

測点名	[1] X(i)	[2] X(i+1)-X(i-1)	[3] Y(i)	[4] Y(i+1)-Y(i-1)	[2]*[3]	[1]*[4]	方向角	夾角	距離
D45-31	61607.246	1.024	-6956.024	31.941	-7122.968576	1967797.044486	85-18-35	43-54-53	33.570
D45-32	61609.991	42.611	-6922.566	30.187	-294977.459826	1859820.798317	355-18-34	89-59-59	40.000
D45-33	61649.857	38.601	-6925.837	-18.713	-267344.234037	-1153653.774041	265-19-01	90-00-27	15.494
D45-43	61648.592	-2.523	-6941.279	-30.881	17512.846917	-1903770.169552	265-20-30	180-01-29	15.490
D45-30	61647.334	-24.627	-6956.718	-13.540	171323.094186	-834704.902360	175-21-15	90-00-45	23.446
D45-65	61623.965	-38.325	-6954.819	3.115	266543.438175	191958.650975	175-21-06	179-59-51	15.005
D45-5	61609.009	-14.998	-6953.603	0.312	104290.137794	19222.010808	267-20-24	271-59-18	0.905
D45-20	61608.967	-1.763	-6954.507	-2.421	12260.795841	-149155.309107	221-23-42	134-03-18	2.294
合計				倍面積	2485.650474	-2485.650474			146.204
				面積	1242.8252370	1242.8252370			
				坪数	375.95	375.95			

面積（座標法）計算書

地 番： 45D-5-1

測点名	[1] X(i)	[2] X(i+1)-X(i-1)	[3] Y(i)	[4] Y(i+1)-Y(i-1)	[2]*[3]	[1]*[4]	方向角	夾 角	距 離
D45-36	61602.176	-2.006	-6957.546	13.018	13956.837276	801937.127168	85-19-21	90-09-28	12.803
D45-62	61603.220	1.952	-6944.786	23.929	-13556.222272	1474103.451380	85-21-08	180-01-47	11.206
D45-57	61604.128	1.852	-6933.617	22.624	-12841.058684	1393731.791872	85-17-20	179-56-12	11.494
D45-37	61605.072	5.863	-6922.162	11.051	-40584.635806	680797.650672	355-18-17	90-00-57	4.936
D45-32	61609.991	2.174	-6922.566	-33.862	-15049.658484	-2086237.515242	265-18-35	90-00-18	33.570
D45-31	61607.246	-4.765	-6956.024	-35.238	33145.454360	-2170916.134548	221-23-10	136-04-35	2.692
D45-21	61605.226	-5.070	-6957.804	-1.522	35276.066280	-93763.153972	175-09-53	133-46-43	3.061
合計				倍面積	346.782670	-346.782670			79.762
				面 積	173.3913350	173.3913350			
				坪 数	52.45	52.45			

面積（座標法）計算書

地番：45D-5-2

測点名	[1] X(i)	[2] X(i+1)-X(i-1)	[3] Y(i)	[4] Y(i+1)-Y(i-1)	[2]*[3]	[1]*[4]	方向角	夾角	距離
D45-50	61568.723	-19.326	-6930.724	9.306	133943.172024	572958.536238	96-19-50	101-01-52	7.836
D45-10	61567.859	2.657	-6922.936	11.313	-18394.240952	696517.188867	45-01-57	128-42-07	4.982
D45-11	61571.380	20.267	-6919.411	2.152	-140235.702737	132501.609760	355-18-46	130-16-49	16.802
D45-51	61588.126	15.805	-6920.784	-12.831	-109382.991120	-790237.244706	265-18-18	89-59-32	11.497
D45-52	61587.185	-19.403	-6932.242	-9.940	134506.291526	-612176.618900	175-17-58	89-59-40	18.524
合計				倍面積	436.528741	-436.528741			59.641
				面積	218.2643705	218.2643705			
				坪数	66.02	66.02			

面積（座標法）計算書

地番：45D-5-3

測点名	[1] X(i)	[2] X(i+1)-X(i-1)	[3] Y(i)	[4] Y(i+1)-Y(i-1)	[2]*[3]	[1]*[4]	方向角	夾角	距離
D45-54	61570.012	-17.113	-6942.374	9.283	118804.846262	571554.421396	96-17-54	100-58-29	8.003
D45-27	61569.134	-1.289	-6934.419	11.650	8938.466091	717280.411100	96-20-49	180-02-55	3.718
D45-50	61568.723	18.051	-6930.724	2.177	-125106.498924	134035.109971	355-17-58	78-57-09	18.524
D45-52	61587.185	17.524	-6932.242	-12.978	-121480.608808	-799278.486930	265-19-15	90-01-17	11.498
D45-53	61586.247	-17.173	-6943.702	-10.132	119244.194446	-623991.854604	175-19-25	90-00-10	16.289
合計				倍面積	400.399067	-400.399067			58.032
				面積	200.1995335	200.1995335			
				坪数	60.56	60.56			

面積（座標法）計算書

地番：45D-5-4

測点名	[1] X(i)	[2] X(i+1)-X(i-1)	[3] Y(i)	[4] Y(i+1)-Y(i-1)	[2]*[3]	[1]*[4]	方向角	夾角	距離
D45-22	61574.632	-13.475	-6955.288	4.321	93722.505800	266063.984872	135-35-21	140-15-37	5.020
D45-24	61571.046	-3.764	-6951.775	5.149	26166.481100	317029.315854	96-12-34	140-37-13	1.646
D45-25	61570.868	-0.342	-6950.139	3.142	2376.947538	193455.667256	96-12-54	180-00-20	1.515
DK30	61570.704	-0.241	-6948.633	2.186	1674.620553	134593.558944	96-27-37	180-14-43	0.684
D45-26	61570.627	-0.297	-6947.953	2.689	2063.542041	165563.416003	96-14-58	179-47-21	2.021
DK31	61570.407	-0.615	-6945.944	5.579	4271.755560	343501.300653	96-18-50	180-03-52	3.592
D45-54	61570.012	15.840	-6942.374	2.242	-109967.204160	138039.966904	355-19-25	79-00-35	16.289
D45-53	61586.247	15.268	-6943.702	-13.135	-106016.442136	-808935.354345	265-19-04	89-59-39	11.847
D45-55	61585.280	-1.726	-6955.509	-12.394	12005.208534	-763287.960320	217-43-04	132-24-00	0.960
D45-56	61584.521	-10.648	-6956.096	0.221	74068.510208	13610.179141	175-19-44	137-36-40	9.922
合計				倍面積	365.925038	-365.925038			53.496
				面積	182.9625190	182.9625190			
				坪数	55.34	55.34			

面積（座標法）計算書

地番：45D-5-5

測点名	[1] X(i)	[2] X(i+1)-X(i-1)	[3] Y(i)	[4] Y(i+1)-Y(i-1)	[2]*[3]	[1]*[4]	方向角	夾角	距離
D45-52	61587.185	-16.002	-6932.242	12.833	110929.736484	790348.345105	85-18-18	89-56-41	11.497
D45-51	61588.126	17.887	-6920.784	10.080	-123792.063408	620808.310080	355-21-04	90-02-46	17.002
D45-37	61605.072	16.002	-6922.162	-12.833	-110768.436324	-790577.888976	265-17-20	89-56-16	11.494
D45-57	61604.128	-17.887	-6933.617	-10.080	124021.607279	-620969.610240	175-21-37	90-04-17	16.999
合計				倍面積	390.844031	-390.844031			56.992
				面積	195.4220155	195.4220155			
				坪数	59.11	59.11			

面積（座標法）計算書

地番：45D-5-6

測点名	[1] X(i)	[2] X(i+1)-X(i-1)	[3] Y(i)	[4] Y(i+1)-Y(i-1)	[2]*[3]	[1]*[4]	方向角	夾角	距離
D45-64	61588.923	-13.912	-6956.461	1.850	96778.285432	113939.507550	130-44-34	135-25-23	1.010
D45-60	61588.264	0.340	-6955.696	12.820	-2364.936640	789561.544480	85-15-46	134-31-12	12.096
D45-61	61589.263	14.956	-6943.641	10.910	-103849.094796	671938.859330	355-18-36	90-02-50	14.004
D45-62	61603.220	12.913	-6944.786	-13.905	-89678.021618	-856592.774100	265-19-21	90-00-45	12.803
D45-36	61602.176	-14.297	-6957.546	-11.675	99472.035162	-719205.404800	175-19-11	89-59-50	13.297
合計				倍面積	358.267540	-358.267540			53.210
				面積	179.1337700	179.1337700			
				坪数	54.18	54.18			

面積（座標法）計算書

地番：45D-5-7

測点名	[1] X(i)	[2] X(i+1)-X(i-1)	[3] Y(i)	[4] Y(i+1)-Y(i-1)	[2]*[3]	[1]*[4]	方向角	夾角	距離
D45-58	61585.228	-3.697	-6956.159	0.306	25716.919823	18845.079768	174-54-28	179-33-15	0.710
D45-56	61584.521	0.052	-6956.096	0.650	-361.716992	40029.938650	37-43-04	42-48-36	0.960
D45-55	61585.280	1.726	-6955.509	12.394	-12005.208534	763287.960320	85-19-04	227-36-00	11.847
D45-53	61586.247	1.905	-6943.702	23.267	-13227.752310	1432927.208949	85-19-15	180-00-11	11.498
D45-52	61587.185	17.881	-6932.242	10.085	-123955.419202	621106.760725	355-21-37	90-02-22	16.999
D45-57	61604.128	16.035	-6933.617	-12.544	-111180.548595	-772762.181632	265-21-08	89-59-31	11.206
D45-62	61603.220	-14.865	-6944.786	-10.024	103234.243890	-617510.677280	175-18-36	89-57-28	14.004
D45-61	61589.263	-14.956	-6943.641	-10.910	103849.094796	-671938.859330	265-15-46	269-57-10	12.096
D45-60	61588.264	-1.045	-6955.696	-12.761	7268.702320	-785927.836904	266-16-20	181-00-34	0.707
D45-63	61588.218	-3.036	-6956.402	-0.463	21119.636472	-28515.344934	175-21-13	89-04-53	3.000
合計				倍面積	457.951668	-457.951668			83.027
				面積	228.9758340	228.9758340			
				坪数	69.26	69.26			

面積（座標法）計算書

地番：45D-5-9

測点名	[1] X(i)	[2] X(i+1)-X(i-1)	[3] Y(i)	[4] Y(i+1)-Y(i-1)	[2]*[3]	[1]*[4]	方向角	夾角	距離
D45-63	61588.218	-0.659	-6956.402	0.765	4584.268918	47114.986770	86-16-20	91-03-22	0.707
D45-60	61588.264	0.705	-6955.696	-0.059	-4903.765680	-3633.707576	310-44-34	44-28-14	1.010
D45-64	61588.923	-0.046	-6956.461	-0.706	319.997206	-43481.779638	175-12-58	44-28-24	0.707
合計				倍面積	0.500444	-0.500444			2.424
				面積	0.2502220	0.2502220			
				坪数	0.07	0.07			

面積（座標法）計算書

地番：45D-S

測点名	[1] X(i)	[2] X(i+1)-X(i-1)	[3] Y(i)	[4] Y(i+1)-Y(i-1)	[2]*[3]	[1]*[4]	方向角	夾角	距離
D45-14	61739.138	-15.673	-6961.417	26.508	109106.288641	1636581.070104	114-56-06	60-09-18	32.387
D45-15	61725.484	-13.080	-6932.049	29.320	90671.200920	1809791.190880	355-13-11	60-17-05	0.576
D45-12	61726.058	4.692	-6932.097	-2.889	-32525.399124	-178326.581562	325-23-54	150-10-43	5.003
D45-13	61730.176	15.099	-6934.938	-26.460	-104710.628862	-1633380.456960	294-56-05	149-32-11	26.047
D45-1	61741.157	8.962	-6958.557	-26.479	-62362.587834	-1634844.096203	234-46-48	119-50-43	3.501
合計				倍面積	178.873741	-178.873741			67.514
				面積	89.4368705	89.4368705			
				坪数	27.05	27.05			