
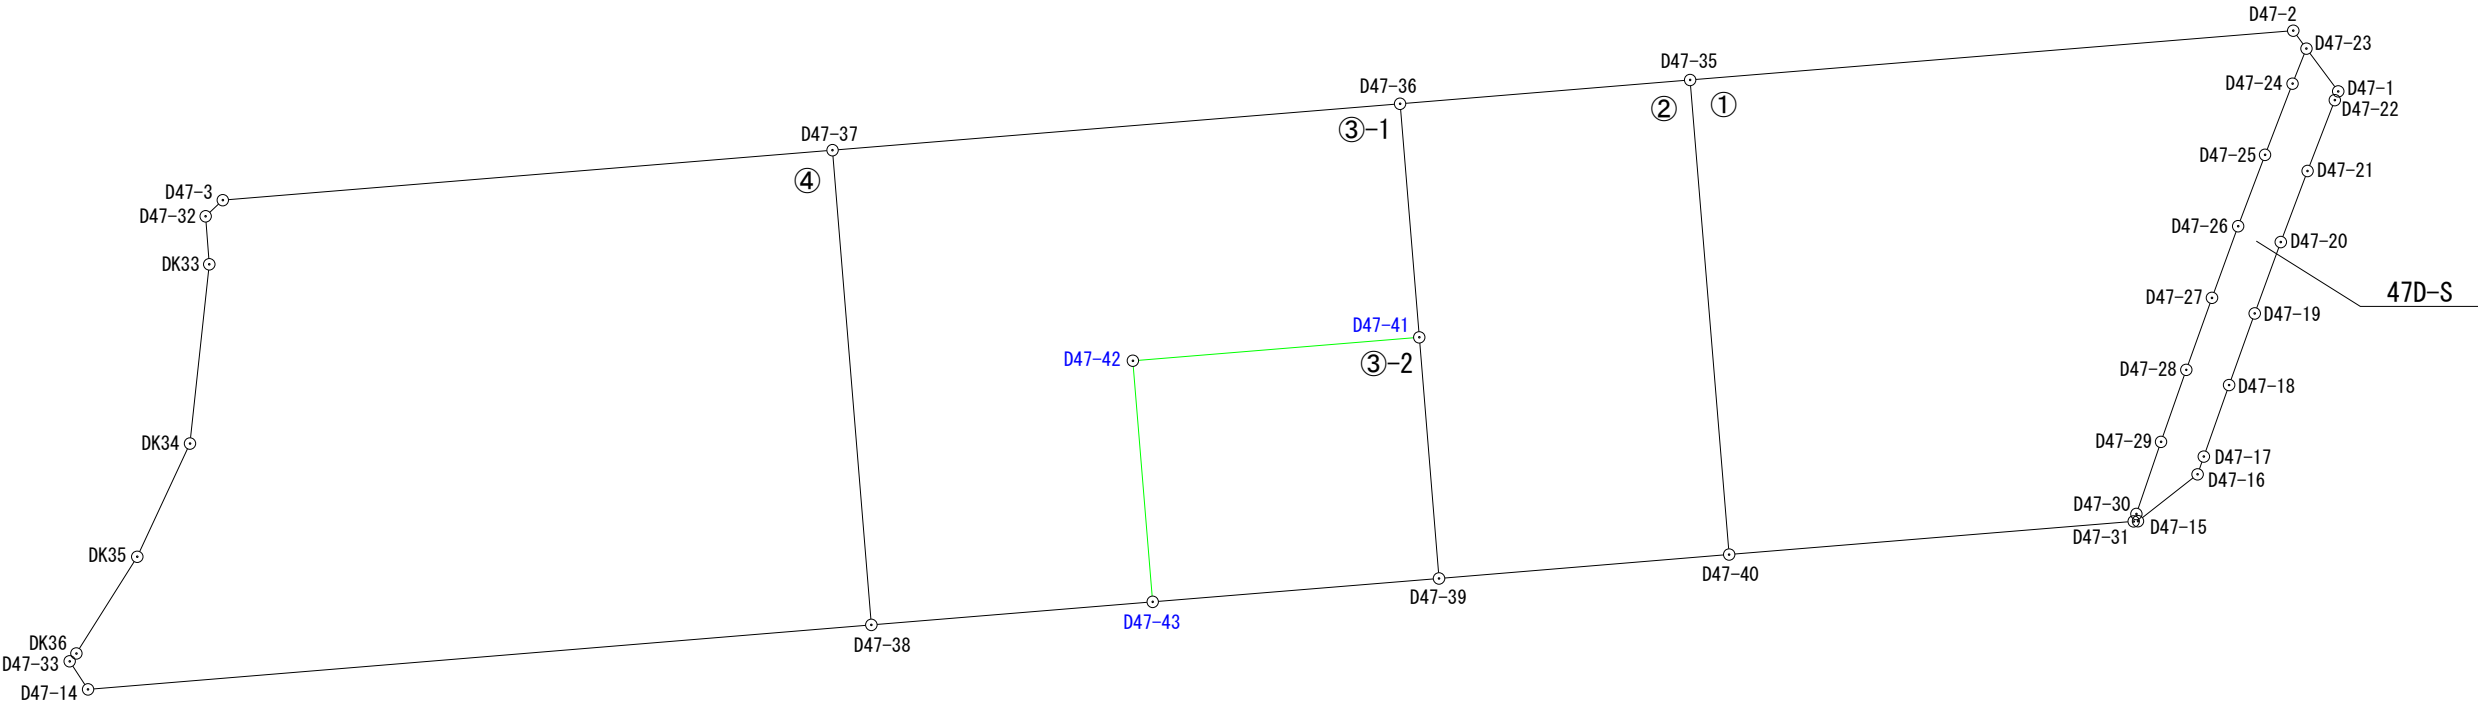


出来形確認測量図（縮尺１：５００）

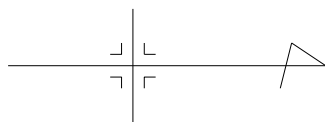

座 標 一 覧 表

測 点 名	X 座 標	Y 座 標
D47-1	61707. 299	-6882. 621
D47-2	61704. 323	-6886. 639
D47-3	61567. 370	-6875. 428
D47-14	61558. 457	-6843. 079
D47-15	61694. 055	-6854. 204
D47-16	61697. 997	-6857. 295
D47-17	61698. 410	-6858. 473
D47-18	61700. 078	-6863. 204
D47-19	61701. 778	-6867. 940
D47-20	61703. 502	-6872. 658
D47-21	61705. 272	-6877. 358
D47-22	61707. 077	-6882. 043
D47-23	61705. 196	-6885. 453
D47-24	61704. 280	-6883. 133
D47-25	61702. 461	-6878. 429
D47-26	61700. 682	-6873. 706
D47-27	61698. 951	-6868. 967
D47-28	61697. 252	-6864. 208

測 点 名	X 座 標	Y 座 標
D47-29	61695. 580	-6859. 450
D47-30	61693. 951	-6854. 676
D47-31	61693. 770	-6854. 185
D47-32	61566. 235	-6874. 361
D47-33	61557. 242	-6844. 931
D47-35	61664. 432	-6883. 377
D47-36	61645. 247	-6881. 803
D47-37	61607. 703	-6878. 732
D47-38	61610. 269	-6847. 345
D47-39	61647. 822	-6850. 415
D47-40	61667. 010	-6851. 994
D47-41	61646. 514	-6866. 359
D47-42	61627. 572	-6864. 808
D47-43	61628. 881	-6848. 867
DK33	61566. 474	-6871. 187
DK34	61565. 198	-6859. 335
DK35	61561. 710	-6851. 849
DK36	61557. 687	-6845. 454

平成25年 2月25日測量
平成24年10月26日測量
平成24年10月19日測量
平成24年10月15日測量
平成23年12月 1日測量
平成23年11月30日測量

凡 例	
	施工地区界
	道 路
	街区番号
	画地番号
D14-1	計 算 点
D14-2	境界標あり

面積（座標法）計算書

地 番： 47D-1

測点名	[1] X(i)	[2] X(i+1)-X(i-1)	[3] Y(i)	[4] Y(i+1)-Y(i-1)	[2]*[3]	[1]*[4]	方向角	夾 角	距 離
D47-35	61664.432	-37.313	-6883.377	34.645	256839.446001	2136364.246640	85-18-14	89-58-43	31.489
D47-40	61667.010	29.338	-6851.994	29.192	-201023.799972	1800183.355920	355-19-09	90-00-55	26.850
D47-31	61693.770	26.941	-6854.185	-2.682	-184658.598085	-165462.691140	290-14-08	114-54-59	0.523
D47-30	61693.951	1.810	-6854.676	-5.265	-12406.963560	-324818.652015	288-50-27	178-36-19	5.044
D47-29	61695.580	3.301	-6859.450	-9.532	-22643.044450	-588082.268560	289-21-43	180-31-16	5.043
D47-28	61697.252	3.371	-6864.208	-9.517	-23139.245168	-587172.747284	289-38-49	180-17-06	5.053
D47-27	61698.951	3.430	-6868.967	-9.498	-23560.556810	-586016.636598	290-03-56	180-25-07	5.045
D47-26	61700.682	3.510	-6873.706	-9.462	-24126.708060	-583811.853084	290-38-23	180-34-27	5.047
D47-25	61702.461	3.598	-6878.429	-9.427	-24748.587542	-581669.099847	291-08-28	180-30-05	5.043
D47-24	61704.280	2.735	-6883.133	-7.024	-18825.368755	-433410.862720	291-32-44	180-24-16	2.494
D47-23	61705.196	0.043	-6885.453	-3.506	-296.074479	-216338.417176	233-38-37	122-05-53	1.473
D47-2	61704.323	-40.764	-6886.639	2.076	280726.952196	128098.174548	175-19-31	121-40-54	40.024
合計				倍面積	2137.451316	-2137.451316			133.128
				面 積	1068.7256580	1068.7256580			
				坪 数	323.28	323.28			

面積（座標法）計算書

地番： 47D-2

測点名	[1] X(i)	[2] X(i+1)-X(i-1)	[3] Y(i)	[4] Y(i+1)-Y(i-1)	[2]*[3]	[1]*[4]	方向角	夾角	距離
D47-36	61645.247	-17.918	-6881.803	17.018	123308.146154	1049078.813446	85-18-36	90-00-01	15.496
D47-41	61646.514	2.575	-6866.359	31.388	-17680.874425	1934960.781432	85-18-36	180-00-00	15.998
D47-39	61647.822	20.496	-6850.415	14.365	-140406.105840	885570.963030	355-17-44	89-59-08	19.253
D47-40	61667.010	16.610	-6851.994	-32.962	-113811.620340	-2032667.983620	265-18-14	90-00-30	31.489
D47-35	61664.432	-21.763	-6883.377	-29.809	149802.933651	-1838155.053488	175-18-35	90-00-21	19.249
合計				倍面積	1212.479200	-1212.479200			101.485
				面積	606.2396000	606.2396000			
				坪数	183.38	183.38			

面積（座標法）計算書

地番：47D-3-1

測点名	[1] X(i)	[2] X(i+1)-X(i-1)	[3] Y(i)	[4] Y(i+1)-Y(i-1)	[2]*[3]	[1]*[4]	方向角	夾角	距離
D47-37	61607.703	-34.978	-6878.732	34.458	240604.287896	2122878.229974	85-19-35	90-00-09	31.492
D47-38	61610.269	21.178	-6847.345	29.865	-145013.072410	1839990.683685	355-19-30	89-59-55	18.674
D47-43	61628.881	17.303	-6848.867	-17.463	-118505.945701	-1076225.148903	265-18-20	89-58-50	15.995
D47-42	61627.572	17.633	-6864.808	-17.492	-121047.159464	-1077989.489424	355-19-08	270-00-48	19.005
D47-41	61646.514	17.675	-6866.359	-16.995	-121362.895325	-1047682.505430	265-18-36	89-59-28	15.496
D47-36	61645.247	-38.811	-6881.803	-12.373	267089.656233	-762736.641131	175-19-26	90-00-50	37.669
合計				倍面積	1764.871229	-1764.871229			138.331
				面積	882.4356145	882.4356145			
				坪数	266.93	266.93			

面積（座標法）計算書

地番：47D-3-2

測点名	[1] X(i)	[2] X(i+1)-X(i-1)	[3] Y(i)	[4] Y(i+1)-Y(i-1)	[2]*[3]	[1]*[4]	方向角	夾角	距離
D47-42	61627.572	-17.633	-6864.808	17.492	121047.159464	1077989.489424	85-18-20	89-59-12	15.995
D47-43	61628.881	20.250	-6848.867	14.393	-138689.556750	887024.484233	355-19-40	90-01-20	19.004
D47-39	61647.822	17.633	-6850.415	-17.492	-120793.367695	-1078343.702424	265-18-36	89-58-56	15.998
D47-41	61646.514	-20.250	-6866.359	-14.393	139043.769750	-887278.276002	175-19-08	90-00-32	19.005
合計				倍面積	608.004769	-608.004769			70.002
				面積	304.0023845	304.0023845			
				坪数	91.96	91.96			

面積（座標法）計算書

地番：47D-4

測点名	[1] X(i)	[2] X(i+1)-X(i-1)	[3] Y(i)	[4] Y(i+1)-Y(i-1)	[2]*[3]	[1]*[4]	方向角	夾角	距離
D47-3	61567.370	-41.468	-6875.428	4.371	285110.248304	269110.974270	136-46-08	141-27-07	1.558
D47-32	61566.235	-0.896	-6874.361	4.241	6159.427456	261102.402635	85-41-38	128-55-30	3.183
DK33	61566.474	-1.037	-6871.187	15.026	7125.420919	925097.838324	96-08-42	190-27-04	11.920
DK34	61565.198	-4.764	-6859.335	19.338	32677.871940	1190547.798924	114-58-57	198-50-15	8.259
DK35	61561.710	-7.511	-6851.849	13.881	51464.237839	854538.096510	122-10-24	187-11-27	7.555
DK36	61557.687	-4.468	-6845.454	6.918	30585.488472	425856.078666	130-23-35	188-13-11	0.687
D47-33	61557.242	0.770	-6844.931	2.375	-5270.596870	146198.449750	56-44-00	106-20-25	2.215
D47-14	61558.457	53.027	-6843.079	-2.414	-362867.950133	-148602.115198	355-17-35	118-33-35	51.987
D47-38	61610.269	49.246	-6847.345	-35.653	-337204.351870	-2196590.920657	265-19-35	90-02-00	31.492
D47-37	61607.703	-42.899	-6878.732	-28.083	295090.724068	-1730129.123349	175-19-01	89-59-26	40.468
合計				倍面積	2870.520125	-2870.520125			159.324
				面積	1435.2600625	1435.2600625			
				坪数	434.16	434.16			

面積（座標法）計算書

地 番： 47D-S

測点名	[1] X(i)	[2] X(i+1)-X(i-1)	[3] Y(i)	[4] Y(i+1)-Y(i-1)	[2]*[3]	[1]*[4]	方向角	夾 角	距 離
D47-23	61705.196	-3.019	-6885.453	-0.512	20787.182607	-31593.060352	111-32-44	58-08-33	2.494
D47-24	61704.280	-2.735	-6883.133	7.024	18825.368755	433410.862720	111-08-28	179-35-44	5.043
D47-25	61702.461	-3.598	-6878.429	9.427	24748.587542	581669.099847	110-38-23	179-29-55	5.047
D47-26	61700.682	-3.510	-6873.706	9.462	24126.708060	583811.853084	110-03-56	179-25-33	5.045
D47-27	61698.951	-3.430	-6868.967	9.498	23560.556810	586016.636598	109-38-49	179-34-53	5.053
D47-28	61697.252	-3.371	-6864.208	9.517	23139.245168	587172.747284	109-21-43	179-42-54	5.043
D47-29	61695.580	-3.301	-6859.450	9.532	22643.044450	588082.268560	108-50-27	179-28-44	5.044
D47-30	61693.951	-1.810	-6854.676	5.265	12406.963560	324818.652015	110-14-08	181-23-41	0.523
D47-31	61693.770	0.104	-6854.185	0.472	-712.835240	29119.459440	356-11-09	65-57-01	0.286
D47-15	61694.055	4.227	-6854.204	-3.110	-28972.720308	-191868.511050	321-53-57	145-42-48	5.009
D47-16	61697.997	4.355	-6857.295	-4.269	-29863.519725	-263388.749193	289-19-13	147-25-16	1.248
D47-17	61698.410	2.081	-6858.473	-5.909	-14272.482313	-364575.904690	289-25-16	180-06-03	5.016
D47-18	61700.078	3.368	-6863.204	-9.467	-23115.271072	-584114.638426	289-44-45	180-19-29	5.032
D47-19	61701.778	3.424	-6867.940	-9.454	-23515.826560	-583328.609212	290-04-22	180-19-37	5.023
D47-20	61703.502	3.494	-6872.658	-9.418	-24013.067052	-581123.581836	290-38-10	180-33-48	5.022
D47-21	61705.272	3.575	-6877.358	-9.385	-24586.554850	-579103.977720	291-04-13	180-26-03	5.021
D47-22	61707.077	2.027	-6882.043	-5.263	-13949.901161	-324764.346251	291-00-39	179-56-26	0.619
D47-1	61707.299	-1.881	-6882.621	-3.410	12946.210101	-210421.889590	233-24-11	122-23-32	3.527
合計				倍面積	181.688772	-181.688772			69.095
				面 積	90.8443860	90.8443860			
				坪 数	27.48	27.48			