
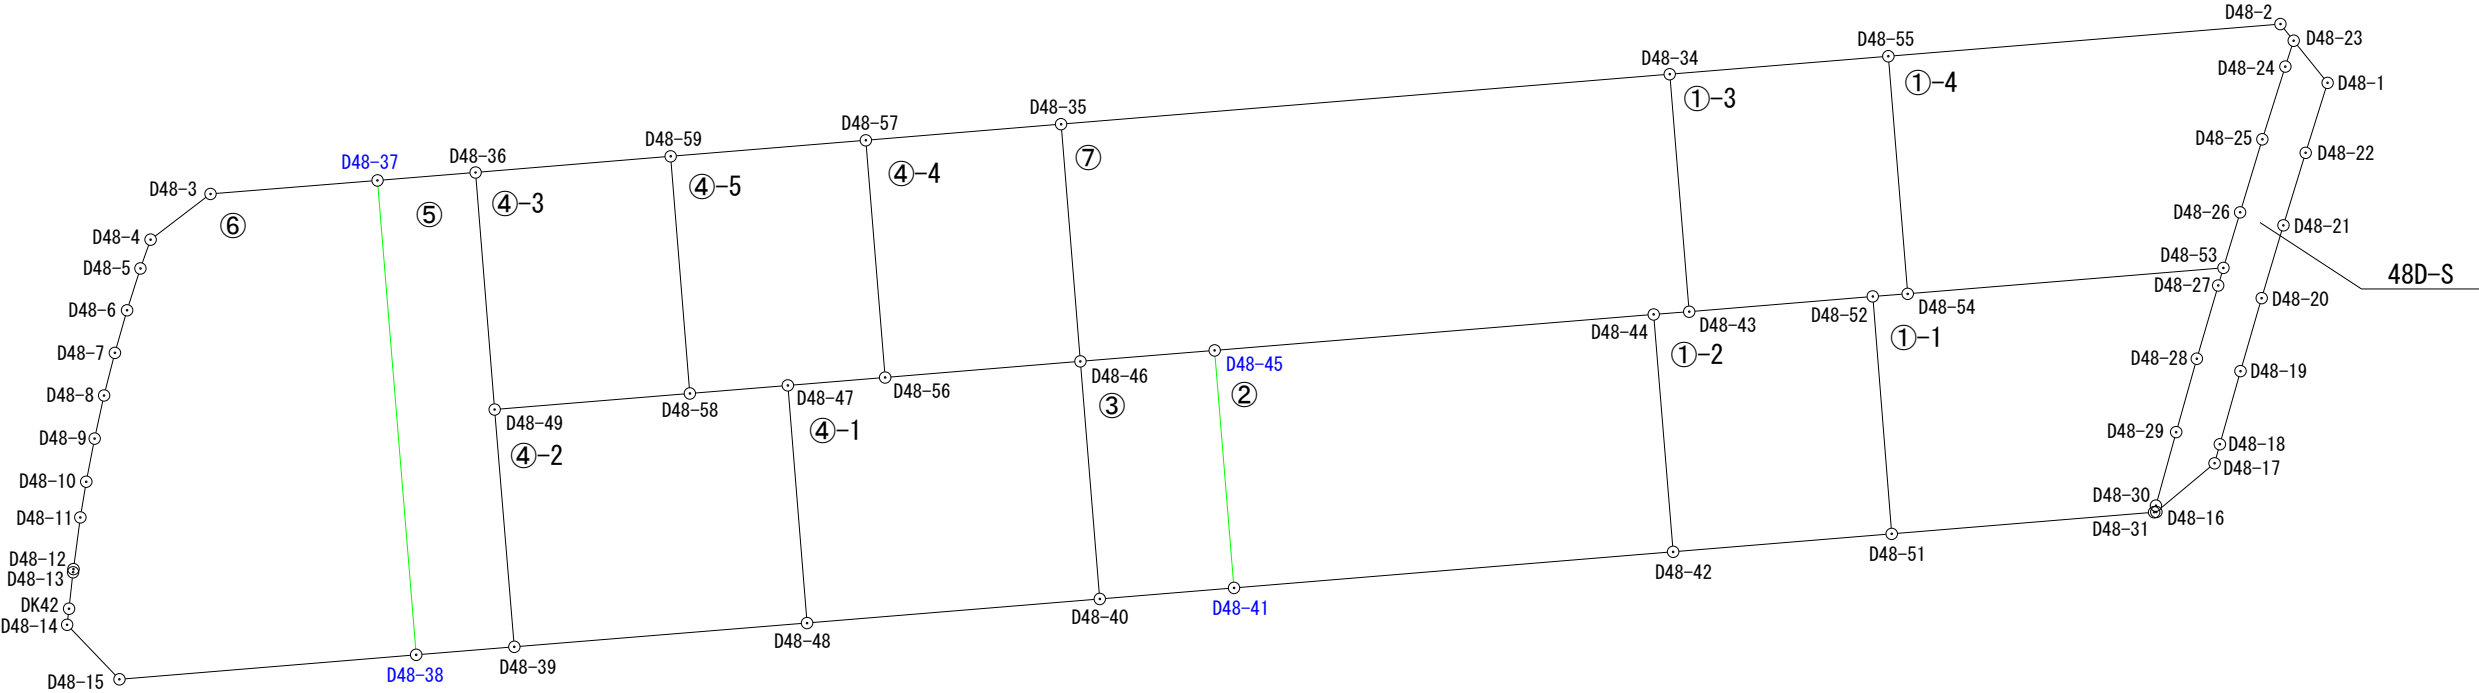


出来形確認測量図（縮尺1：500）

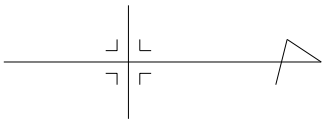

座 標 一 覧 表

測 点 名	X	座 標	Y	座 標
D48-1		61693.593	-6844.011	
D48-2		61690.471	-6847.897	
D48-3		61553.552	-6836.665	
D48-4		61549.588	-6833.641	
D48-5		61548.914	-6831.737	
D48-6		61548.032	-6828.975	
D48-7		61547.228	-6826.156	
D48-8		61546.510	-6823.337	
D48-9		61545.889	-6820.486	
D48-10		61545.332	-6817.633	
D48-11		61544.940	-6815.272	
D48-12		61544.486	-6811.854	
D48-13		61544.462	-6811.648	
D48-14		61544.067	-6808.174	
D48-15		61547.527	-6804.570	
D48-16		61682.264	-6815.633	
D48-17		61686.116	-6818.852	
D48-18		61686.466	-6820.111	
D48-19		61687.829	-6824.948	

測 点 名	X	座 標	Y	座 標
D48-20		61689.233	-6829.775	
D48-21		61690.674	-6834.587	
D48-22		61692.144	-6839.386	
D48-23		61691.344	-6846.798	
D48-24		61690.795	-6845.090	
D48-25		61689.277	-6840.279	
D48-26		61687.806	-6835.449	
D48-27		61686.357	-6830.613	
D48-28		61684.940	-6825.769	
D48-29		61683.579	-6820.911	
D48-30		61682.235	-6816.054	
D48-31		61682.116	-6815.620	
D48-34		61650.078	-6844.581	
D48-35		61609.815	-6841.277	
D48-36		61571.085	-6838.085	
D48-37		61564.595	-6837.559	
D48-38		61567.156	-6806.186	
D48-39		61573.646	-6806.720	
D48-40		61612.376	-6809.881	

測 点 名	X	座 標	Y	座 標
D48-41		61621.255	-6810.611	
D48-42		61650.300	-6812.998	
D48-43		61651.365	-6828.879	
D48-44		61649.013	-6828.699	
D48-45		61619.970	-6826.320	
D48-46		61611.092	-6825.592	
D48-47		61591.739	-6824.001	
D48-48		61593.012	-6808.290	
D48-49		61572.346	-6822.409	
D48-51		61664.754	-6814.190	
D48-52		61663.506	-6829.890	
D48-53		61686.702	-6831.774	
D48-54		61665.816	-6830.058	
D48-55		61664.535	-6845.771	
D48-56		61598.178	-6824.529	
D48-57		61596.903	-6840.213	
D48-58		61585.261	-6823.475	
D48-59		61583.991	-6839.152	
DK42		61544.193	-6809.239	

平成25年 2月25日測量
平成24年10月19日測量
平成24年10月15日測量
平成23年12月 7日測量
平成23年12月 2日測量
平成23年12月 1日測量

凡 例	
	施工地区界
	道 路
	街区番号
	画地番号
D14-1	計 算 点
D14-2	境界標あり

面積（座標法）計算書

地 番： 48D-1-1

測点名	[1] X(i)	[2] X(i+1)-X(i-1)	[3] Y(i)	[4] Y(i+1)-Y(i-1)	[2]*[3]	[1]*[4]	方向角	夾 角	距 離
D48-52	61663.506	-1.062	-6829.890	15.868	7253.343180	978476.513208	85-27-18	89-36-53	15.750
D48-51	61664.754	18.610	-6814.190	14.270	-126812.075900	879956.039580	355-17-30	89-50-12	17.421
D48-31	61682.116	17.481	-6815.620	-1.864	-119143.853220	-114975.464224	285-20-00	110-02-30	0.450
D48-30	61682.235	1.463	-6816.054	-5.291	-9971.887002	-326360.705385	285-28-03	180-08-03	5.040
D48-29	61683.579	2.705	-6820.911	-9.715	-18450.564255	-599255.969985	285-39-02	180-10-59	5.045
D48-28	61684.940	2.778	-6825.769	-9.702	-18961.986282	-598467.287880	286-18-20	180-39-18	5.047
D48-27	61686.357	1.762	-6830.613	-6.005	-12035.540106	-370426.573785	286-32-59	180-14-39	1.211
D48-53	61686.702	-20.541	-6831.774	0.555	140331.469734	34236.119610	175-18-11	68-45-12	20.956
D48-54	61665.816	-23.196	-6830.058	1.884	158430.025368	116178.397344	175-50-25	180-32-14	2.316
合計				倍面積	638.931517	-638.931517			73.236
				面 積	319.4657585	319.4657585			
				坪 数	96.63	96.63			

面積（座標法）計算書

地番：48D-1-2

測点名	[1] X(i)	[2] X(i+1)-X(i-1)	[3] Y(i)	[4] Y(i+1)-Y(i-1)	[2]*[3]	[1]*[4]	方向角	夾角	距離
D48-44	61649.013	-1.065	-6828.699	15.881	7272.564435	979047.975453	85-18-50	89-41-25	15.754
D48-42	61650.300	15.741	-6812.998	14.509	-107243.401518	894484.202700	355-17-08	89-58-18	14.503
D48-51	61664.754	13.206	-6814.190	-16.892	-89988.193140	-1041641.024568	265-27-18	90-10-10	15.750
D48-52	61663.506	-13.389	-6829.890	-14.689	91445.397210	-905775.239634	175-14-24	89-47-06	12.183
D48-43	61651.365	-14.493	-6828.879	1.191	98970.943347	73426.775715	175-37-25	180-23-01	2.359
合計				倍面積	457.310334	-457.310334			60.549
				面積	228.6551670	228.6551670			
				坪数	69.16	69.16			

面積（座標法）計算書

地番：48D-1-3

測点名	[1] X(i)	[2] X(i+1)-X(i-1)	[3] Y(i)	[4] Y(i+1)-Y(i-1)	[2]*[3]	[1]*[4]	方向角	夾角	距離
D48-34	61650.078	-13.170	-6844.581	16.892	90143.131770	1041393.117576	85-18-51	90-01-11	15.755
D48-43	61651.365	13.428	-6828.879	14.691	-91698.187212	905720.203215	355-14-24	89-55-33	12.183
D48-52	61663.506	14.451	-6829.890	-1.179	-98698.740390	-72701.273574	355-50-25	180-36-01	2.316
D48-54	61665.816	1.029	-6830.058	-15.881	-7028.129682	-979314.823896	265-20-21	89-29-56	15.765
D48-55	61664.535	-15.738	-6845.771	-14.523	107738.743998	-895554.041805	175-17-40	89-57-19	14.506
合計				倍面積	456.818484	-456.818484			60.525
				面積	228.4092420	228.4092420			
				坪数	69.09	69.09			

面積（座標法）計算書

地 番： 48D-1-4

測点名	[1] X(i)	[2] X(i+1)-X(i-1)	[3] Y(i)	[4] Y(i+1)-Y(i-1)	[2]*[3]	[1]*[4]	方向角	夾 角	距 離
D48-55	61664.535	-24.655	-6845.771	17.839	168782.484005	1100033.639865	85-20-21	90-01-31	15.765
D48-54	61665.816	22.167	-6830.058	13.997	-151401.895686	863136.426552	355-18-11	89-57-50	20.956
D48-53	61686.702	21.990	-6831.774	-5.391	-150230.710260	-332553.010482	286-43-15	111-25-04	3.837
D48-26	61687.806	2.575	-6835.449	-8.505	-17601.281175	-524654.790030	286-56-18	180-13-03	5.049
D48-25	61689.277	2.989	-6840.279	-9.641	-20445.593931	-594746.319557	287-30-43	180-34-25	5.045
D48-24	61690.795	2.067	-6845.090	-6.519	-14148.801030	-402162.292605	287-49-08	180-18-25	1.794
D48-23	61691.344	-0.324	-6846.798	-2.807	2218.362552	-173167.602608	231-32-16	123-43-08	1.404
D48-2	61690.471	-26.809	-6847.897	1.027	183585.270673	63356.113717	175-18-50	123-46-34	26.023
合計				倍面積	757.835148	-757.835148			79.873
				面 積	378.9175740	378.9175740			
				坪 数	114.62	114.62			

面積（座標法）計算書

地番：48D-2

測点名	[1] X(i)	[2] X(i+1)-X(i-1)	[3] Y(i)	[4] Y(i+1)-Y(i-1)	[2]*[3]	[1]*[4]	方向角	夾角	距離
D48-45	61619.970	-27.758	-6826.320	18.088	189484.990560	1114582.017360	85-19-25	90-00-23	15.761
D48-41	61621.255	30.330	-6810.611	13.322	-206565.831630	820918.359110	355-18-07	89-58-42	29.143
D48-42	61650.300	27.758	-6812.998	-18.088	-189115.198484	-1115130.626400	265-18-50	90-00-43	15.754
D48-44	61649.013	-30.330	-6828.699	-13.322	207114.440670	-821288.151186	175-19-02	90-00-12	29.140
合計				倍面積	918.401116	-918.401116			89.798
				面積	459.2005580	459.2005580			
				坪数	138.90	138.90			

面積（座標法）計算書

地番：48D-3

測点名	[1] X(i)	[2] X(i+1)-X(i-1)	[3] Y(i)	[4] Y(i+1)-Y(i-1)	[2]*[3]	[1]*[4]	方向角	夾角	距離
D48-46	61611.092	-7.594	-6825.592	16.439	51833.545648	1012824.741388	85-19-40	90-00-56	15.763
D48-40	61612.376	10.163	-6809.881	14.981	-69208.820603	923015.004856	355-18-00	89-58-20	8.909
D48-41	61621.255	7.594	-6810.611	-16.439	-51719.779934	-1012991.810945	265-19-25	90-01-25	15.761
D48-45	61619.970	-10.163	-6826.320	-14.981	69375.890160	-923128.770570	175-18-44	89-59-19	8.908
合計				倍面積	280.835271	-280.835271			49.341
				面積	140.4176355	140.4176355			
				坪数	42.47	42.47			

面積（座標法）計算書

地番：48D-4-1

測点名	[1] X(i)	[2] X(i+1)-X(i-1)	[3] Y(i)	[4] Y(i+1)-Y(i-1)	[2]*[3]	[1]*[4]	方向角	夾角	距離
D48-47	61591.739	-5.166	-6824.001	16.239	35252.789166	1000188.249621	85-22-04	90-03-20	15.762
D48-48	61593.012	20.637	-6808.290	14.120	-140502.680730	869693.329440	355-18-11	89-56-07	19.429
D48-40	61612.376	18.080	-6809.881	-17.302	-123122.648480	-1066017.329552	265-19-40	90-01-29	15.763
D48-46	61611.092	-14.198	-6825.592	-14.648	96909.755216	-902479.275616	175-17-40	89-58-00	12.958
D48-56	61598.178	-19.353	-6824.529	1.591	132075.109737	98002.701198	175-18-44	180-01-04	6.461
合計				倍面積	612.324909	-612.324909			70.373
				面積	306.1624545	306.1624545			
				坪数	92.61	92.61			

面積（座標法）計算書

地番：48D-4-2

測点名	[1] X(i)	[2] X(i+1)-X(i-1)	[3] Y(i)	[4] Y(i+1)-Y(i-1)	[2]*[3]	[1]*[4]	方向角	夾角	距離
D48-49	61572.346	-11.615	-6822.409	16.755	79242.280535	1031644.657230	85-15-48	89-58-55	15.743
D48-39	61573.646	20.666	-6806.720	14.119	-140667.675520	869358.307874	355-21-55	90-06-07	19.430
D48-48	61593.012	18.093	-6808.290	-17.281	-123182.390970	-1064388.840372	265-22-04	90-00-09	15.762
D48-47	61591.739	-7.751	-6824.001	-15.185	52892.831751	-935270.556715	175-21-28	89-59-24	6.499
D48-58	61585.261	-19.393	-6823.475	1.592	132327.650675	98043.735512	175-16-53	179-55-25	12.959
合計				倍面積	612.696471	-612.696471			70.393
				面積	306.3482355	306.3482355			
				坪数	92.67	92.67			

面積（座標法）計算書

地番：48D-4-3

測点名	[1] X(i)	[2] X(i+1)-X(i-1)	[3] Y(i)	[4] Y(i+1)-Y(i-1)	[2]*[3]	[1]*[4]	方向角	夾角	距離
D48-36	61571.085	-11.645	-6838.085	16.743	79629.499825	1030884.676155	85-24-03	90-07-37	15.727
D48-49	61572.346	14.176	-6822.409	14.610	-96714.469984	899571.975060	355-16-53	89-52-50	12.959
D48-58	61585.261	11.645	-6823.475	-16.743	-79459.366375	-1031122.024923	265-22-07	90-05-14	15.728
D48-59	61583.991	-14.176	-6839.152	-14.610	96951.818752	-899742.108510	175-16-26	89-54-19	12.950
合計				倍面積	407.482218	-407.482218			57.364
				面積	203.7411090	203.7411090			
				坪数	61.63	61.63			

面積（座標法）計算書

地番：48D-4-4

測点名	[1] X(i)	[2] X(i+1)-X(i-1)	[3] Y(i)	[4] Y(i+1)-Y(i-1)	[2]*[3]	[1]*[4]	方向角	夾角	距離
D48-57	61596.903	-11.637	-6840.213	16.748	79599.558681	1031624.931444	85-21-09	90-03-48	15.736
D48-56	61598.178	14.189	-6824.529	14.621	-96833.241981	900626.960538	355-17-40	89-56-31	12.958
D48-46	61611.092	11.637	-6825.592	-16.748	-79429.414104	-1031862.568816	265-20-44	90-03-04	15.737
D48-35	61609.815	-14.189	-6841.277	-14.621	97070.879353	-900797.105115	175-17-21	89-56-37	12.956
合計				倍面積	407.781949	-407.781949			57.387
				面積	203.8909745	203.8909745			
				坪数	61.67	61.67			

面積（座標法）計算書

地番： 48D-4-5

測点名	[1] X(i)	[2] X(i+1)-X(i-1)	[3] Y(i)	[4] Y(i+1)-Y(i-1)	[2]*[3]	[1]*[4]	方向角	夾角	距離
D48-59	61583.991	-11.642	-6839.152	16.738	79621.407584	1030792.841358	85-22-07	90-03-58	15.728
D48-58	61585.261	7.748	-6823.475	15.151	-52868.284300	933078.289411	355-21-28	89-59-21	6.499
D48-47	61591.739	12.917	-6824.001	-1.054	-88145.620917	-64917.692906	355-18-44	179-57-16	6.461
D48-56	61598.178	5.164	-6824.529	-16.212	-35241.867756	-998629.661736	265-21-09	90-02-25	15.736
D48-57	61596.903	-14.187	-6840.213	-14.623	97042.101831	-900731.512569	175-18-09	89-57-00	12.956
合計				倍面積	407.736442	-407.736442			57.380
				面積	203.8682210	203.8682210			
				坪数	61.67	61.67			

面積（座標法）計算書

地番： 48D-5

測点名	[1] X(i)	[2] X(i+1)-X(i-1)	[3] Y(i)	[4] Y(i+1)-Y(i-1)	[2]*[3]	[1]*[4]	方向角	夾角	距離
D48-37	61564.595	-3.929	-6837.559	31.899	26864.769311	1963849.015905	85-20-00	89-58-01	31.477
D48-38	61567.156	9.051	-6806.186	30.839	-61602.789486	1898669.523884	355-17-47	89-57-47	6.512
D48-39	61573.646	5.190	-6806.720	-16.223	-35326.876800	-998909.259058	265-15-48	89-58-01	15.743
D48-49	61572.346	-2.561	-6822.409	-31.365	17472.189449	-1931216.632290	265-24-03	180-08-15	15.727
D48-36	61571.085	-7.751	-6838.085	-15.150	53001.996835	-932801.937750	175-21-59	89-57-56	6.511
合計				倍面積	409.289309	-409.289309			75.970
				面積	204.6446545	204.6446545			
				坪数	61.90	61.90			

面積（座標法）計算書

地 番： 48D-6

測点名	[1] X(i)	[2] X(i+1)-X(i-1)	[3] Y(i)	[4] Y(i+1)-Y(i-1)	[2]*[3]	[1]*[4]	方向角	夾 角	距 離
D48-3	61553.552	-15.007	-6836.665	3.918	102597.831655	241166.816736	142-39-40	147-17-22	4.986
D48-4	61549.588	-4.638	-6833.641	4.928	31694.426958	303316.369664	109-29-37	146-49-57	2.020
D48-5	61548.914	-1.556	-6831.737	4.666	10630.182772	287187.232724	107-42-36	178-12-59	2.899
D48-6	61548.032	-1.686	-6828.975	5.581	11513.651850	343499.566592	105-55-07	178-12-31	2.931
D48-7	61547.228	-1.522	-6826.156	5.638	10389.409432	347003.271464	104-17-22	178-22-15	2.909
D48-8	61546.510	-1.339	-6823.337	5.670	9136.448243	348968.711700	102-17-17	177-59-55	2.918
D48-9	61545.889	-1.178	-6820.486	5.704	8034.532508	351057.750856	101-02-49	178-45-32	2.907
D48-10	61545.332	-0.949	-6817.633	5.214	6469.933717	320897.361048	99-25-37	178-22-48	2.393
D48-11	61544.940	-0.846	-6815.272	5.779	5765.720112	355668.208260	97-33-58	178-08-21	3.448
D48-12	61544.486	-0.478	-6811.854	3.624	3256.066212	223037.217264	96-38-43	179-04-45	0.207
D48-13	61544.462	-0.293	-6811.648	2.615	1995.812864	160938.768130	96-22-17	179-43-34	2.424
DK42	61544.193	-0.395	-6809.239	3.474	2689.649405	213804.526482	96-44-50	180-22-33	1.072
D48-14	61544.067	3.334	-6808.174	4.669	-22698.452116	287349.248823	46-10-04	129-25-14	4.996
D48-15	61547.527	23.089	-6804.570	1.988	-157110.716730	122356.483676	355-17-37	129-07-33	19.695
D48-38	61567.156	17.068	-6806.186	-32.989	-116167.982648	-2031038.909284	265-20-00	90-02-23	31.477
D48-37	61564.595	-13.604	-6837.559	-30.479	93018.152636	-1876427.291005	175-22-18	90-02-18	11.079
合計				倍面積	1214.666870	-1214.666870			98.361
				面 積	607.3334350	607.3334350			
				坪 数	183.71	183.71			

面積（座標法）計算書

地番： 48D-7

測点名	[1] X(i)	[2] X(i+1)-X(i-1)	[3] Y(i)	[4] Y(i+1)-Y(i-1)	[2]*[3]	[1]*[4]	方向角	夾角	距離
D48-35	61609.815	-38.986	-6841.277	18.989	266714.025122	1169908.777035	85-20-44	90-02-12	15.737
D48-46	61611.092	10.155	-6825.592	14.957	-69313.886760	921517.103044	355-18-44	89-58-00	8.908
D48-45	61619.970	37.921	-6826.320	-3.107	-258860.880720	-191453.246790	355-19-02	180-00-18	29.140
D48-44	61649.013	31.395	-6828.699	-2.559	-214387.005105	-157759.824267	355-37-25	180-18-23	2.359
D48-43	61651.365	1.065	-6828.879	-15.882	-7272.756135	-979146.978930	265-18-51	89-41-26	15.755
D48-34	61650.078	-41.550	-6844.581	-12.398	284392.340550	-764337.667044	175-18-32	89-59-41	40.398
合計				倍面積	1271.836952	-1271.836952			112.297
				面積	635.9184760	635.9184760			
				坪数	192.36	192.36			

面積（座標法）計算書

地番： 48D-S

測点名	[1] X(i)	[2] X(i+1)-X(i-1)	[3] Y(i)	[4] Y(i+1)-Y(i-1)	[2]*[3]	[1]*[4]	方向角	夾 角	距 離
D48-23	61691.344	-2.798	-6846.798	-1.079	19157.340804	-66564.960176	107-49-08	56-43-16	1.794
D48-24	61690.795	-2.067	-6845.090	6.519	14148.801030	402162.292605	107-30-43	179-41-35	5.045
D48-25	61689.277	-2.989	-6840.279	9.641	20445.593931	594746.319557	106-56-18	179-25-35	5.049
D48-26	61687.806	-2.575	-6835.449	8.505	17601.281175	524654.790030	106-43-15	179-46-57	3.837
D48-53	61686.702	-1.449	-6831.774	4.836	9899.240526	298316.890872	106-32-59	179-49-44	1.211
D48-27	61686.357	-1.762	-6830.613	6.005	12035.540106	370426.573785	106-18-20	179-45-21	5.047
D48-28	61684.940	-2.778	-6825.769	9.702	18961.986282	598467.287880	105-39-02	179-20-42	5.045
D48-29	61683.579	-2.705	-6820.911	9.715	18450.564255	599255.969985	105-28-03	179-49-01	5.040
D48-30	61682.235	-1.463	-6816.054	5.291	9971.887002	326360.705385	105-20-00	179-51-57	0.450
D48-31	61682.116	0.029	-6815.620	0.421	-197.652980	25968.170836	354-58-49	69-38-49	0.149
D48-16	61682.264	4.000	-6815.633	-3.232	-27262.532000	-199357.077248	320-06-56	145-08-07	5.020
D48-17	61686.116	4.202	-6818.852	-4.478	-28652.816104	-276230.427448	285-32-09	145-25-13	1.307
D48-18	61686.466	1.713	-6820.111	-6.096	-11682.850143	-376040.696736	285-44-14	180-12-05	5.025
D48-19	61687.829	2.767	-6824.948	-9.664	-18884.631116	-596151.179456	286-13-04	180-28-50	5.027
D48-20	61689.233	2.845	-6829.775	-9.639	-19430.709875	-594622.516887	286-40-15	180-27-11	5.023
D48-21	61690.674	2.911	-6834.587	-9.611	-19895.482757	-592909.067814	287-01-50	180-21-35	5.019
D48-22	61692.144	2.919	-6839.386	-9.424	-19964.167734	-581386.765056	287-23-44	180-21-54	4.847
D48-1	61693.593	-0.800	-6844.011	-7.412	5475.208800	-457272.911316	231-05-52	123-42-08	3.581
合計				倍面積	176.601202	-176.601202			67.516
				面積	88.3006010	88.3006010			
				坪 数	26.71	26.71			