
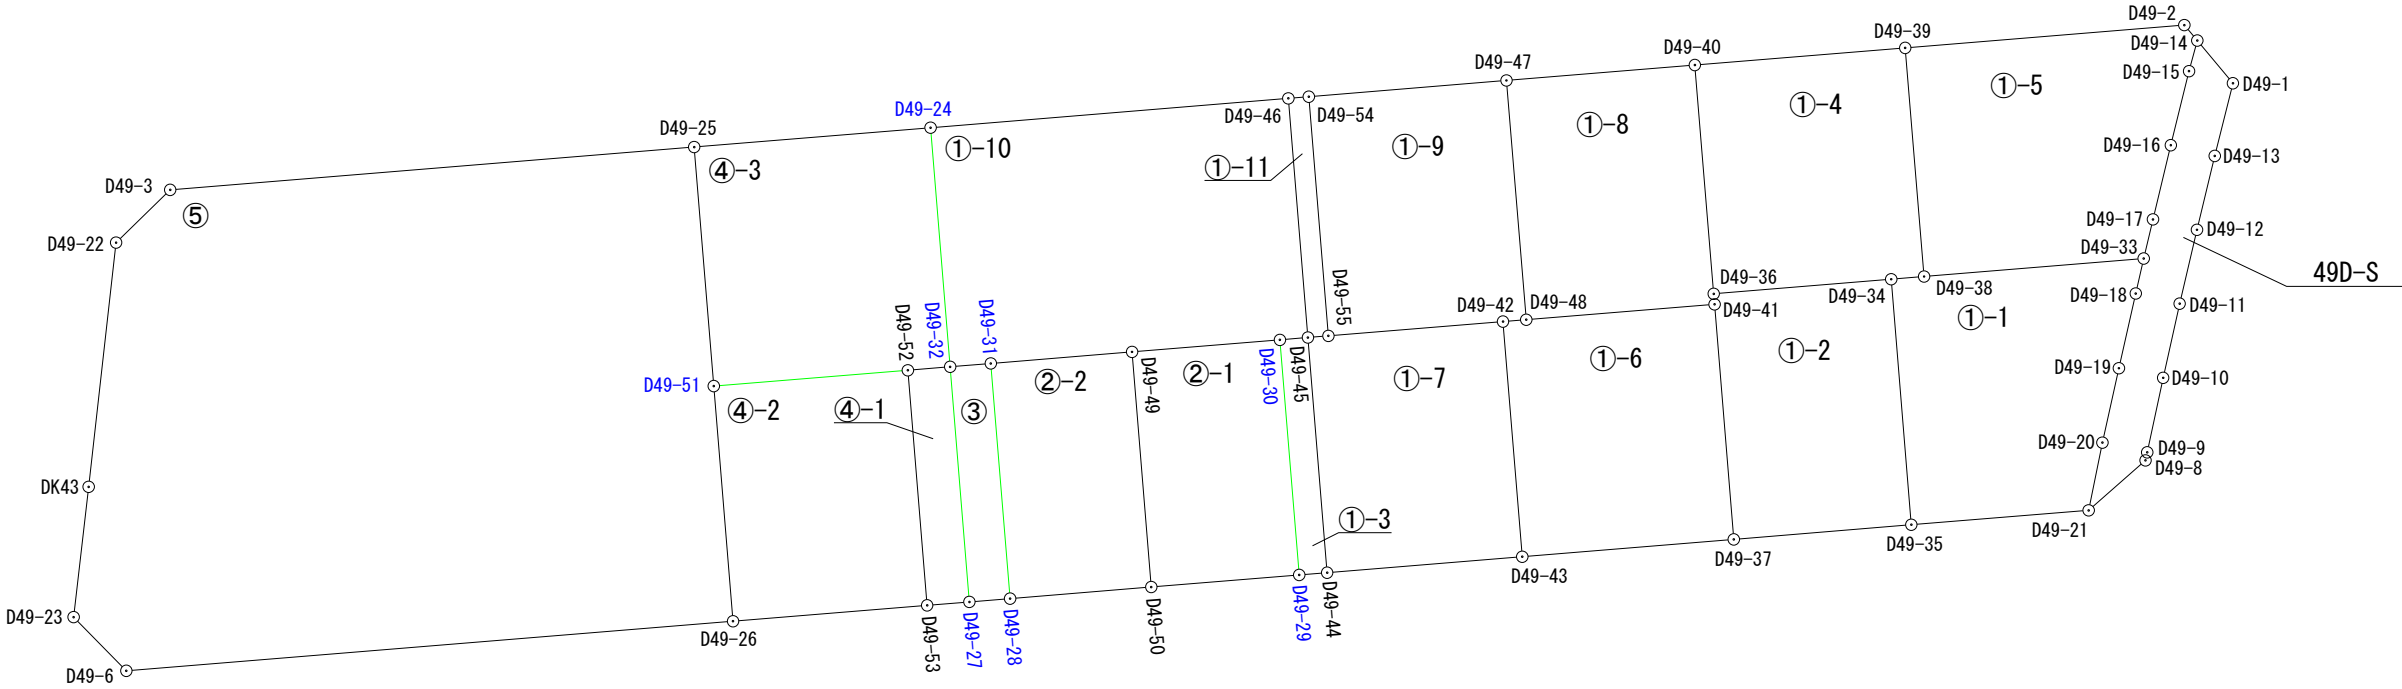


出来形確認測量図（縮尺１：５００）

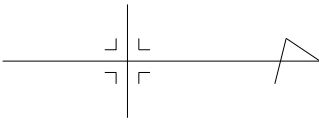

座 標 一 覧 表

測 点 名	X 座 標	Y 座 標
D49-1	61682.580	-6805.482
D49-2	61679.367	-6809.328
D49-3	61546.132	-6798.429
D49-6	61543.231	-6766.628
D49-8	61676.795	-6780.541
D49-9	61676.909	-6781.075
D49-10	61677.962	-6786.000
D49-11	61679.056	-6790.908
D49-12	61680.200	-6795.792
D49-13	61681.373	-6800.675
D49-14	61680.217	-6808.308
D49-15	61679.674	-6806.283
D49-16	61678.471	-6801.384
D49-17	61677.289	-6796.477
D49-18	61676.148	-6791.576
D49-19	61675.036	-6786.638
D49-20	61673.946	-6781.717
D49-21	61673.033	-6777.237
D49-22	61542.553	-6794.941
D49-23	61539.747	-6770.178

測 点 名	X 座 標	Y 座 標
D49-24	61596.428	-6802.542
D49-25	61580.793	-6801.261
D49-26	61583.365	-6769.906
D49-27	61599.000	-6771.183
D49-28	61601.690	-6771.403
D49-29	61620.812	-6772.966
D49-30	61619.537	-6788.514
D49-31	61600.416	-6786.951
D49-32	61597.725	-6786.731
D49-33	61676.675	-6793.889
D49-34	61659.974	-6792.521
D49-35	61661.303	-6776.286
D49-36	61648.235	-6791.558
D49-37	61649.561	-6775.315
D49-38	61662.152	-6792.699
D49-39	61660.900	-6807.821
D49-40	61646.982	-6806.684
D49-41	61648.291	-6790.863
D49-42	61634.296	-6789.720
D49-43	61635.570	-6774.172

測 点 名	X 座 標	Y 座 標
D49-44	61622.663	-6773.117
D49-45	61621.390	-6788.665
D49-46	61620.095	-6804.481
D49-47	61634.525	-6805.664
D49-48	61635.835	-6789.845
D49-49	61609.758	-6787.714
D49-50	61611.032	-6772.166
D49-51	61582.090	-6785.455
D49-52	61594.932	-6786.503
D49-53	61596.206	-6770.955
D49-54	61621.450	-6804.592
D49-55	61622.747	-6788.776
DK43	61540.740	-6778.792

平成26年 4月 1日測量
平成25年 8月29日測量
平成25年 7月30日測量
平成25年 2月25日測量
平成24年10月25日測量
平成24年10月19日測量
平成24年 8月24日測量
平成24年 6月 4日測量
平成23年12月 8日測量
平成23年12月 2日測量

凡 例	
	施工地区界
	道 路
	街区番号
	画地番号
D14-1	計 算 点
D14-2	境界標あり

面積（座標法）計算書

地 番： 49D-1-1

測点名	[1] X(i)	[2] X(i+1)-X(i-1)	[3] Y(i)	[4] Y(i+1)-Y(i-1)	[2]*[3]	[1]*[4]	方向角	夾 角	距 離
D49-34	61659.974	-0.849	-6792.521	16.413	5766.850329	1012025.153262	85-19-13	89-59-33	16.289
D49-35	61661.303	13.059	-6776.286	15.284	-88491.518874	942431.355052	355-21-54	90-02-41	11.768
D49-21	61673.033	12.643	-6777.237	-5.431	-85684.607391	-334946.242223	281-31-08	106-09-14	4.572
D49-20	61673.946	2.003	-6781.717	-9.401	-13583.779151	-579796.766346	282-29-22	180-58-14	5.040
D49-19	61675.036	2.202	-6786.638	-9.859	-14944.176876	-608054.179924	282-41-27	180-12-05	5.062
D49-18	61676.148	1.639	-6791.576	-7.251	-11131.393064	-447213.749148	282-50-07	180-08-40	2.372
D49-33	61676.675	-13.996	-6793.889	-1.123	95087.270444	-69262.906025	175-18-57	72-28-50	14.572
D49-38	61662.152	-16.701	-6792.699	1.368	113444.865999	84353.823936	175-19-40	180-00-43	2.185
合計				倍面積	463.511416	-463.511416			61.860
				面 積	231.7557080	231.7557080			
				坪 数	70.10	70.10			

面積（座標法）計算書

地番：49D-1-2

測点名	[1] X(i)	[2] X(i+1)-X(i-1)	[3] Y(i)	[4] Y(i+1)-Y(i-1)	[2]*[3]	[1]*[4]	方向角	夾角	距離
D49-36	61648.235	-11.683	-6791.558	1.658	79345.772114	102212.773630	85-23-36	90-04-59	0.697
D49-41	61648.291	1.326	-6790.863	16.243	-9004.684338	1001353.190713	85-19-49	179-56-13	15.600
D49-37	61649.561	13.012	-6775.315	14.577	-88160.398780	898665.650697	355-16-22	89-56-33	11.782
D49-35	61661.303	10.413	-6776.286	-17.206	-70561.466118	-1060944.379418	265-19-13	90-02-51	16.289
D49-34	61659.974	-13.068	-6792.521	-15.272	88764.664428	-941671.122928	175-18-37	89-59-24	11.778
合計				倍面積	383.887306	-383.887306			56.146
				面積	191.9436530	191.9436530			
				坪数	58.06	58.06			

面積（座標法）計算書

地番：49D-1-3

測点名	[1] X(i)	[2] X(i+1)-X(i-1)	[3] Y(i)	[4] Y(i+1)-Y(i-1)	[2]*[3]	[1]*[4]	方向角	夾角	距離
D49-30	61619.537	-0.578	-6788.514	15.699	3923.761092	967365.111363	85-18-43	89-58-14	15.600
D49-29	61620.812	3.126	-6772.966	15.397	-21172.291716	948775.642364	355-20-11	90-01-28	1.857
D49-44	61622.663	0.578	-6773.117	-15.699	-3914.861626	-967414.186437	265-19-10	89-58-59	15.600
D49-45	61621.390	-3.126	-6788.665	-15.397	21221.366790	-948784.541830	175-20-29	90-01-19	1.859
合計				倍面積	57.974540	-57.974540			34.916
				面積	28.9872700	28.9872700			
				坪数	8.76	8.76			

面積（座標法）計算書

地番：49D-1-4

測点名	[1] X(i)	[2] X(i+1)-X(i-1)	[3] Y(i)	[4] Y(i+1)-Y(i-1)	[2]*[3]	[1]*[4]	方向角	夾角	距離
D49-40	61646.982	-12.665	-6806.684	16.263	86206.652860	1002564.868266	85-15-52	89-56-05	15.178
D49-36	61648.235	12.992	-6791.558	14.163	-88235.921536	873123.952305	355-18-37	90-02-45	11.778
D49-34	61659.974	13.917	-6792.521	-1.141	-94531.514757	-70354.030334	355-19-40	180-01-03	2.185
D49-38	61662.152	0.926	-6792.699	-15.300	-6290.039274	-943430.925600	265-16-02	89-56-22	15.174
D49-39	61660.900	-15.170	-6807.821	-13.985	103274.644570	-862327.686500	175-19-47	90-03-45	13.964
合計				倍面積	423.821863	-423.821863			58.279
				面積	211.9109315	211.9109315			
				坪数	64.10	64.10			

面積（座標法）計算書

地 番： 49D-1-5

測点名	[1] X(i)	[2] X(i+1)-X(i-1)	[3] Y(i)	[4] Y(i+1)-Y(i-1)	[2]*[3]	[1]*[4]	方向角	夾 角	距 離
D49-39	61660.900	-17.215	-6807.821	16.629	117196.638515	1025359.106100	85-16-02	89-55-57	15.174
D49-38	61662.152	15.775	-6792.699	13.932	-107154.826725	859077.101664	355-18-57	90-02-55	14.572
D49-33	61676.675	15.137	-6793.889	-3.778	-102839.097793	-233014.478150	283-20-48	108-01-51	2.660
D49-17	61677.289	1.796	-6796.477	-7.495	-12206.472692	-462271.281055	283-32-36	180-11-48	5.047
D49-16	61678.471	2.385	-6801.384	-9.806	-16221.300840	-604819.086626	283-47-48	180-15-12	5.045
D49-15	61679.674	1.746	-6806.283	-6.924	-11883.770118	-427070.062776	285-00-38	181-12-50	2.097
D49-14	61680.217	-0.307	-6808.308	-3.045	2090.150556	-187816.260765	230-11-40	125-11-02	1.328
D49-2	61679.367	-19.317	-6809.328	0.487	131535.788976	30037.851729	175-20-05	125-08-25	18.528
合計				倍面積	517.109879	-517.109879			64.451
				面 積	258.5549395	258.5549395			
				坪 数	78.21	78.21			

面積（座標法）計算書

地番：49D-1-6

測点名	[1] X(i)	[2] X(i+1)-X(i-1)	[3] Y(i)	[4] Y(i+1)-Y(i-1)	[2]*[3]	[1]*[4]	方向角	夾角	距離
D49-37	61649.561	12.721	-6775.315	-16.691	-86188.782115	-1028992.822651	265-19-49	90-00-03	15.600
D49-41	61648.291	-13.726	-6790.863	-14.530	93211.385538	-895749.668230	175-19-40	89-59-51	12.498
D49-48	61635.835	-13.995	-6789.845	1.143	95023.880775	70449.759405	175-21-24	180-01-44	1.544
D49-42	61634.296	-0.265	-6789.720	15.673	1799.275800	965994.321208	85-18-56	89-57-32	15.600
D49-43	61635.570	15.265	-6774.172	14.405	-103407.735580	887860.385850	355-19-46	90-00-50	14.038
合計				倍面積	438.024418	-438.024418			59.280
				面積	219.0122090	219.0122090			
				坪数	66.25	66.25			

面積（座標法）計算書

地番：49D-1-7

測点名	[1] X(i)	[2] X(i+1)-X(i-1)	[3] Y(i)	[4] Y(i+1)-Y(i-1)	[2]*[3]	[1]*[4]	方向角	夾角	距離
D49-45	61621.390	-0.084	-6788.665	15.659	570.247860	964929.346010	85-19-10	89-59-45	15.600
D49-44	61622.663	14.180	-6773.117	14.493	-96042.799060	893097.254859	355-19-38	90-00-28	12.950
D49-43	61635.570	11.633	-6774.172	-16.603	-78803.942876	-1023335.368710	265-18-56	89-59-18	15.600
D49-42	61634.296	-12.823	-6789.720	-14.604	87064.579560	-900107.258784	175-19-38	90-00-42	11.588
D49-55	61622.747	-12.906	-6788.776	1.055	87615.943056	65011.998085	175-19-25	179-59-47	1.362
合計				倍面積	404.028540	-404.028540			57.100
				面積	202.0142700	202.0142700			
				坪数	61.10	61.10			

面積（座標法）計算書

地番：49D-1-8

測点名	[1] X(i)	[2] X(i+1)-X(i-1)	[3] Y(i)	[4] Y(i+1)-Y(i-1)	[2]*[3]	[1]*[4]	方向角	夾角	距離
D49-47	61634.525	-11.147	-6805.664	16.839	75862.736608	1037863.766475	85-15-58	89-56-50	15.873
D49-48	61635.835	13.766	-6789.845	14.801	-93469.006270	912271.993835	355-19-40	90-03-42	12.498
D49-41	61648.291	12.400	-6790.863	-1.713	-84206.701200	-105603.522483	265-23-36	90-03-56	0.697
D49-36	61648.235	-1.309	-6791.558	-15.821	8890.149422	-975336.725935	265-15-52	179-52-16	15.178
D49-40	61646.982	-13.710	-6806.684	-14.106	93319.637640	-869592.328092	175-19-08	90-03-16	12.499
合計				倍面積	396.816200	-396.816200			56.745
				面積	198.4081000	198.4081000			
				坪数	60.01	60.01			

面積（座標法）計算書

地番：49D-1-9

測点名	[1] X(i)	[2] X(i+1)-X(i-1)	[3] Y(i)	[4] Y(i+1)-Y(i-1)	[2]*[3]	[1]*[4]	方向角	夾角	距離
D49-54	61621.450	-11.778	-6804.592	16.888	80144.484576	1040663.047600	85-18-43	89-59-57	15.869
D49-55	61622.747	12.846	-6788.776	14.872	-87208.616496	916453.493384	355-19-38	90-00-55	11.588
D49-42	61634.296	13.088	-6789.720	-1.069	-88863.855360	-65887.062424	355-21-24	180-01-46	1.544
D49-48	61635.835	0.229	-6789.845	-15.944	-1554.874505	-982721.753240	265-15-58	89-54-34	15.873
D49-47	61634.525	-14.385	-6805.664	-14.747	97899.476640	-908924.340175	175-18-46	90-02-48	13.119
合計				倍面積	416.614855	-416.614855			57.993
				面積	208.3074275	208.3074275			
				坪数	63.01	63.01			

面積（座標法）計算書

地 番： 49D-1-10

測点名	[1] X(i)	[2] X(i+1)-X(i-1)	[3] Y(i)	[4] Y(i+1)-Y(i-1)	[2]*[3]	[1]*[4]	方向角	夾 角	距 離
D49-24	61596.428	-22.370	-6802.542	17.750	152172.864540	1093336.597000	85-18-38	89-59-39	15.864
D49-32	61597.725	3.988	-6786.731	15.591	-27065.483228	960370.130475	355-19-34	90-00-56	2.700
D49-31	61600.416	12.033	-6786.951	-0.983	-81667.381383	-60553.208928	355-19-51	180-00-17	9.373
D49-49	61609.758	19.121	-6787.714	-1.563	-129787.879394	-96296.051754	355-19-23	179-59-32	9.812
D49-30	61619.537	11.632	-6788.514	-0.951	-78963.994848	-58600.179687	355-20-29	180-01-06	1.859
D49-45	61621.390	0.558	-6788.665	-15.967	-3788.075070	-983908.734130	265-19-09	89-58-40	15.869
D49-46	61620.095	-24.962	-6804.481	-13.877	169853.454722	-855102.058315	175-18-59	89-59-50	23.746
合計				倍面積	753.505339	-753.505339			79.223
				面 積	376.7526695	376.7526695			
				坪 数	113.96	113.96			

面積（座標法）計算書

地番：49D-1-11

測点名	[1] X(i)	[2] X(i+1)-X(i-1)	[3] Y(i)	[4] Y(i+1)-Y(i-1)	[2]*[3]	[1]*[4]	方向角	夾角	距離
D49-46	61620.095	-0.060	-6804.481	15.927	408.268860	981423.253065	85-19-09	90-00-08	15.869
D49-45	61621.390	2.652	-6788.665	15.705	-18003.539580	967763.929950	355-19-25	90-00-16	1.362
D49-55	61622.747	0.060	-6788.776	-15.927	-407.326560	-981465.491469	265-18-43	89-59-18	15.869
D49-54	61621.450	-2.652	-6804.592	-15.705	18045.777984	-967764.872250	175-19-01	90-00-18	1.360
合計				倍面積	43.180704	-43.180704			34.460
				面積	21.5903520	21.5903520			
				坪数	6.53	6.53			

面積（座標法）計算書

地番：49D-2-1

測点名	[1] X(i)	[2] X(i+1)-X(i-1)	[3] Y(i)	[4] Y(i+1)-Y(i-1)	[2]*[3]	[1]*[4]	方向角	夾角	距離
D49-49	61609.758	-8.505	-6787.714	16.348	57729.507570	1007196.323784	85-18-56	89-59-33	15.600
D49-50	61611.032	11.054	-6772.166	14.748	-74859.522964	908639.499936	355-19-25	90-00-29	9.813
D49-29	61620.812	8.505	-6772.966	-16.348	-57604.075830	-1007377.034576	265-18-43	89-59-18	15.600
D49-30	61619.537	-11.054	-6788.514	-14.748	75040.233756	-908764.931676	175-19-23	90-00-40	9.812
合計				倍面積	306.142532	-306.142532			50.825
				面積	153.0712660	153.0712660			
				坪数	46.30	46.30			

面積（座標法）計算書

地番：49D-2-2

測点名	[1] X(i)	[2] X(i+1)-X(i-1)	[3] Y(i)	[4] Y(i+1)-Y(i-1)	[2]*[3]	[1]*[4]	方向角	夾角	距離
D49-31	61600.416	-8.068	-6786.951	16.311	54757.120668	1004764.385376	85-18-56	89-59-05	15.600
D49-28	61601.690	10.616	-6771.403	14.785	-71885.214248	910780.986650	355-19-51	90-00-55	9.373
D49-50	61611.032	8.068	-6772.166	-16.311	-54637.835288	-1004937.542952	265-18-56	89-59-05	15.600
D49-49	61609.758	-10.616	-6787.714	-14.785	72058.371824	-910900.272030	175-19-51	90-00-55	9.373
合計				倍面積	292.442956	-292.442956			49.946
				面積	146.2214780	146.2214780			
				坪数	44.23	44.23			

面積（座標法）計算書

地番： 49D-3

測点名	[1] X(i)	[2] X(i+1)-X(i-1)	[3] Y(i)	[4] Y(i+1)-Y(i-1)	[2]*[3]	[1]*[4]	方向角	夾角	距離
D49-31	61600.416	-3.965	-6786.951	-15.328	26910.260715	-944211.176448	175-19-34	90-00-38	2.700
D49-32	61597.725	-1.416	-6786.731	15.768	9610.011096	971272.927800	85-18-43	89-59-09	15.600
D49-27	61599.000	3.965	-6771.183	15.328	-26847.740595	944189.472000	355-19-28	90-00-45	2.699
D49-28	61601.690	1.416	-6771.403	-15.768	-9588.306648	-971335.447920	265-18-56	89-59-28	15.600
合計				倍面積	84.224568	-84.224568			36.599
				面積	42.1122840	42.1122840			
				坪数	12.73	12.73			

面積（座標法）計算書

地 番： 49D-4-1

測点名	[1] X(i)	[2] X(i+1)-X(i-1)	[3] Y(i)	[4] Y(i+1)-Y(i-1)	[2]*[3]	[1]*[4]	方向角	夾 角	距 離
D49-52	61594.932	-1.519	-6786.503	15.776	10308.698057	971721.647232	85-18-56	89-58-57	15.600
D49-53	61596.206	4.068	-6770.955	15.320	-27544.244940	943653.875920	355-20-05	90-01-09	2.803
D49-27	61599.000	1.519	-6771.183	-15.776	-10285.426977	-971785.824000	265-18-43	89-58-38	15.600
D49-32	61597.725	-4.068	-6786.731	-15.320	27608.421708	-943677.147000	175-19-59	90-01-16	2.802
合計				倍面積	87.447848	-87.447848			36.805
				面 積	43.7239240	43.7239240			
				坪 数	13.22	13.22			

面積（座標法）計算書

地番：49D-4-2

測点名	[1] X(i)	[2] X(i+1)-X(i-1)	[3] Y(i)	[4] Y(i+1)-Y(i-1)	[2]*[3]	[1]*[4]	方向角	夾角	距離
D49-51	61582.090	-11.567	-6785.455	16.597	78487.357985	1022077.947730	85-18-44	89-58-39	15.601
D49-26	61583.365	14.116	-6769.906	14.500	-95563.993096	892958.792500	355-19-47	90-01-03	12.884
D49-53	61596.206	11.567	-6770.955	-16.597	-78319.636485	-1022312.230982	265-18-56	89-59-09	15.600
D49-52	61594.932	-14.116	-6786.503	-14.500	95798.276348	-893126.514000	175-20-05	90-01-09	12.885
合計				倍面積	402.004752	-402.004752			56.970
				面積	201.0023760	201.0023760			
				坪数	60.80	60.80			

面積（座標法）計算書

地番：49D-4-3

測点名	[1] X(i)	[2] X(i+1)-X(i-1)	[3] Y(i)	[4] Y(i+1)-Y(i-1)	[2]*[3]	[1]*[4]	方向角	夾角	距離
D49-25	61580.793	-14.338	-6801.261	17.087	97516.480218	1052231.009991	85-18-32	89-59-34	15.859
D49-51	61582.090	14.139	-6785.455	14.758	-95939.548245	908828.484220	355-20-05	90-01-33	12.885
D49-52	61594.932	15.635	-6786.503	-1.276	-106106.974405	-78595.133232	355-19-59	179-59-54	2.802
D49-32	61597.725	1.496	-6786.731	-16.039	-10152.949576	-987965.911275	265-18-38	89-58-39	15.864
D49-24	61596.428	-16.932	-6802.542	-14.530	115180.641144	-894996.098840	175-18-58	90-00-20	15.687
合計				倍面積	497.649136	-497.649136			63.097
				面積	248.8245680	248.8245680			
				坪数	75.26	75.26			

面積（座標法）計算書

地 番： 49D-5

測点名	[1] X(i)	[2] X(i+1)-X(i-1)	[3] Y(i)	[4] Y(i+1)-Y(i-1)	[2]*[3]	[1]*[4]	方向角	夾 角	距 離
D49-3	61546.132	-38.240	-6798.429	6.320	259971.924960	388971.554240	135-44-16	140-24-32	4.998
D49-22	61542.553	-5.392	-6794.941	19.637	36638.321872	1208511.113261	96-24-20	140-40-04	16.250
DK43	61540.740	-2.806	-6778.792	24.763	19021.290352	1523933.344620	96-34-33	180-10-13	8.671
D49-23	61539.747	2.491	-6770.178	12.164	-16864.513398	748569.482508	45-32-15	128-57-42	4.974
D49-6	61543.231	43.618	-6766.628	0.272	-295146.780104	16739.758832	355-19-50	129-47-35	40.268
D49-26	61583.365	38.859	-6769.906	-18.827	-263071.777254	-1159430.012855	265-18-44	89-58-54	15.601
D49-51	61582.090	-2.572	-6785.455	-31.355	17452.190260	-1930906.431950	265-18-32	179-59-48	15.859
D49-25	61580.793	-35.958	-6801.261	-12.974	244559.743038	-798949.208382	175-19-44	90-01-12	34.777
合計				倍面積	2560.399726	-2560.399726			141.398
				面 積	1280.1998630	1280.1998630			
				坪 数	387.26	387.26			

面積（座標法）計算書

地番： 49D-S

測点名	[1] X(i)	[2] X(i+1)-X(i-1)	[3] Y(i)	[4] Y(i+1)-Y(i-1)	[2]*[3]	[1]*[4]	方向角	夾角	距離
D49-14	61680.217	-2.906	-6808.308	-0.801	19784.943048	-49405.853817	105-00-38	54-54-42	2.097
D49-15	61679.674	-1.746	-6806.283	6.924	11883.770118	427070.062776	103-47-48	178-47-10	5.045
D49-16	61678.471	-2.385	-6801.384	9.806	16221.300840	604819.086626	103-32-36	179-44-48	5.047
D49-17	61677.289	-1.796	-6796.477	7.495	12206.472692	462271.281055	103-20-48	179-48-12	2.660
D49-33	61676.675	-1.141	-6793.889	4.901	7751.827349	302277.384175	102-50-07	179-29-19	2.372
D49-18	61676.148	-1.639	-6791.576	7.251	11131.393064	447213.749148	102-41-27	179-51-20	5.062
D49-19	61675.036	-2.202	-6786.638	9.859	14944.176876	608054.179924	102-29-22	179-47-55	5.040
D49-20	61673.946	-2.003	-6781.717	9.401	13583.779151	579796.766346	101-31-08	179-01-46	4.572
D49-21	61673.033	2.849	-6777.237	1.176	-19308.348213	72527.486808	318-42-31	37-11-23	5.007
D49-8	61676.795	3.876	-6780.541	-3.838	-26281.376916	-236715.539210	282-03-03	143-20-32	0.546
D49-9	61676.909	1.167	-6781.075	-5.459	-7913.514525	-336694.246231	282-04-07	180-01-04	5.036
D49-10	61677.962	2.147	-6786.000	-9.833	-14569.542000	-606479.400346	282-33-57	180-29-50	5.028
D49-11	61679.056	2.238	-6790.908	-9.792	-15198.052104	-603961.316352	283-10-59	180-37-02	5.016
D49-12	61680.200	2.317	-6795.792	-9.767	-15745.850064	-602430.513400	283-30-28	180-19-29	5.022
D49-13	61681.373	2.380	-6800.675	-9.690	-16185.606500	-597692.504370	284-05-42	180-35-14	4.956
D49-1	61682.580	-1.156	-6805.482	-7.633	7867.137192	-470823.133140	230-05-56	126-00-14	3.684
合計				倍面積	172.510008	-172.510008			66.190
				面積	86.2550040	86.2550040			
				坪数	26.09	26.09			