



出来形確認測量図（縮尺１：２５０）

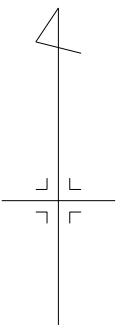

座 標 一 覧 表

測 点 名	X 座 標	Y 座 標
D51-1	61674.084	-6767.197
D51-2	61670.785	-6771.030
D51-3	61641.681	-6768.657
D51-4	61638.040	-6765.233
D51-5	61632.964	-6730.953
D51-6	61634.732	-6728.518
D51-7	61647.367	-6726.186
D51-8	61664.740	-6722.256
D51-9	61667.357	-6723.925
D51-10	61667.698	-6726.612
D51-11	61668.350	-6731.600
D51-12	61669.030	-6736.577
D51-13	61669.737	-6741.549
D51-14	61670.495	-6746.522
D51-15	61671.299	-6751.478
D51-16	61672.139	-6756.432
D51-17	61673.014	-6761.375
D51-18	61673.916	-6766.319
D51-19	61671.714	-6769.955
D51-20	61671.055	-6766.856
D51-21	61670.039	-6761.915
D51-22	61669.164	-6756.944
D51-23	61668.323	-6751.959
D51-24	61667.510	-6746.983
D51-25	61666.754	-6741.992
D51-26	61666.027	-6737.015
D51-27	61665.343	-6732.002
D51-28	61664.707	-6726.998
D51-29	61664.161	-6722.387
D51-30	61645.469	-6726.532
D51-31	61665.695	-6734.583
D51-32	61648.145	-6738.147
D51-34	61659.116	-6735.919
D51-35	61656.438	-6724.133
D51-37	61635.069	-6745.101
D51-38	61634.382	-6740.484
D51-40	61662.401	-6722.784
D51-41	61664.662	-6726.648
D51-42	61663.343	-6726.930
D51-44	61648.046	-6737.716
D51-45	61640.421	-6739.712
D51-46	61641.275	-6743.785

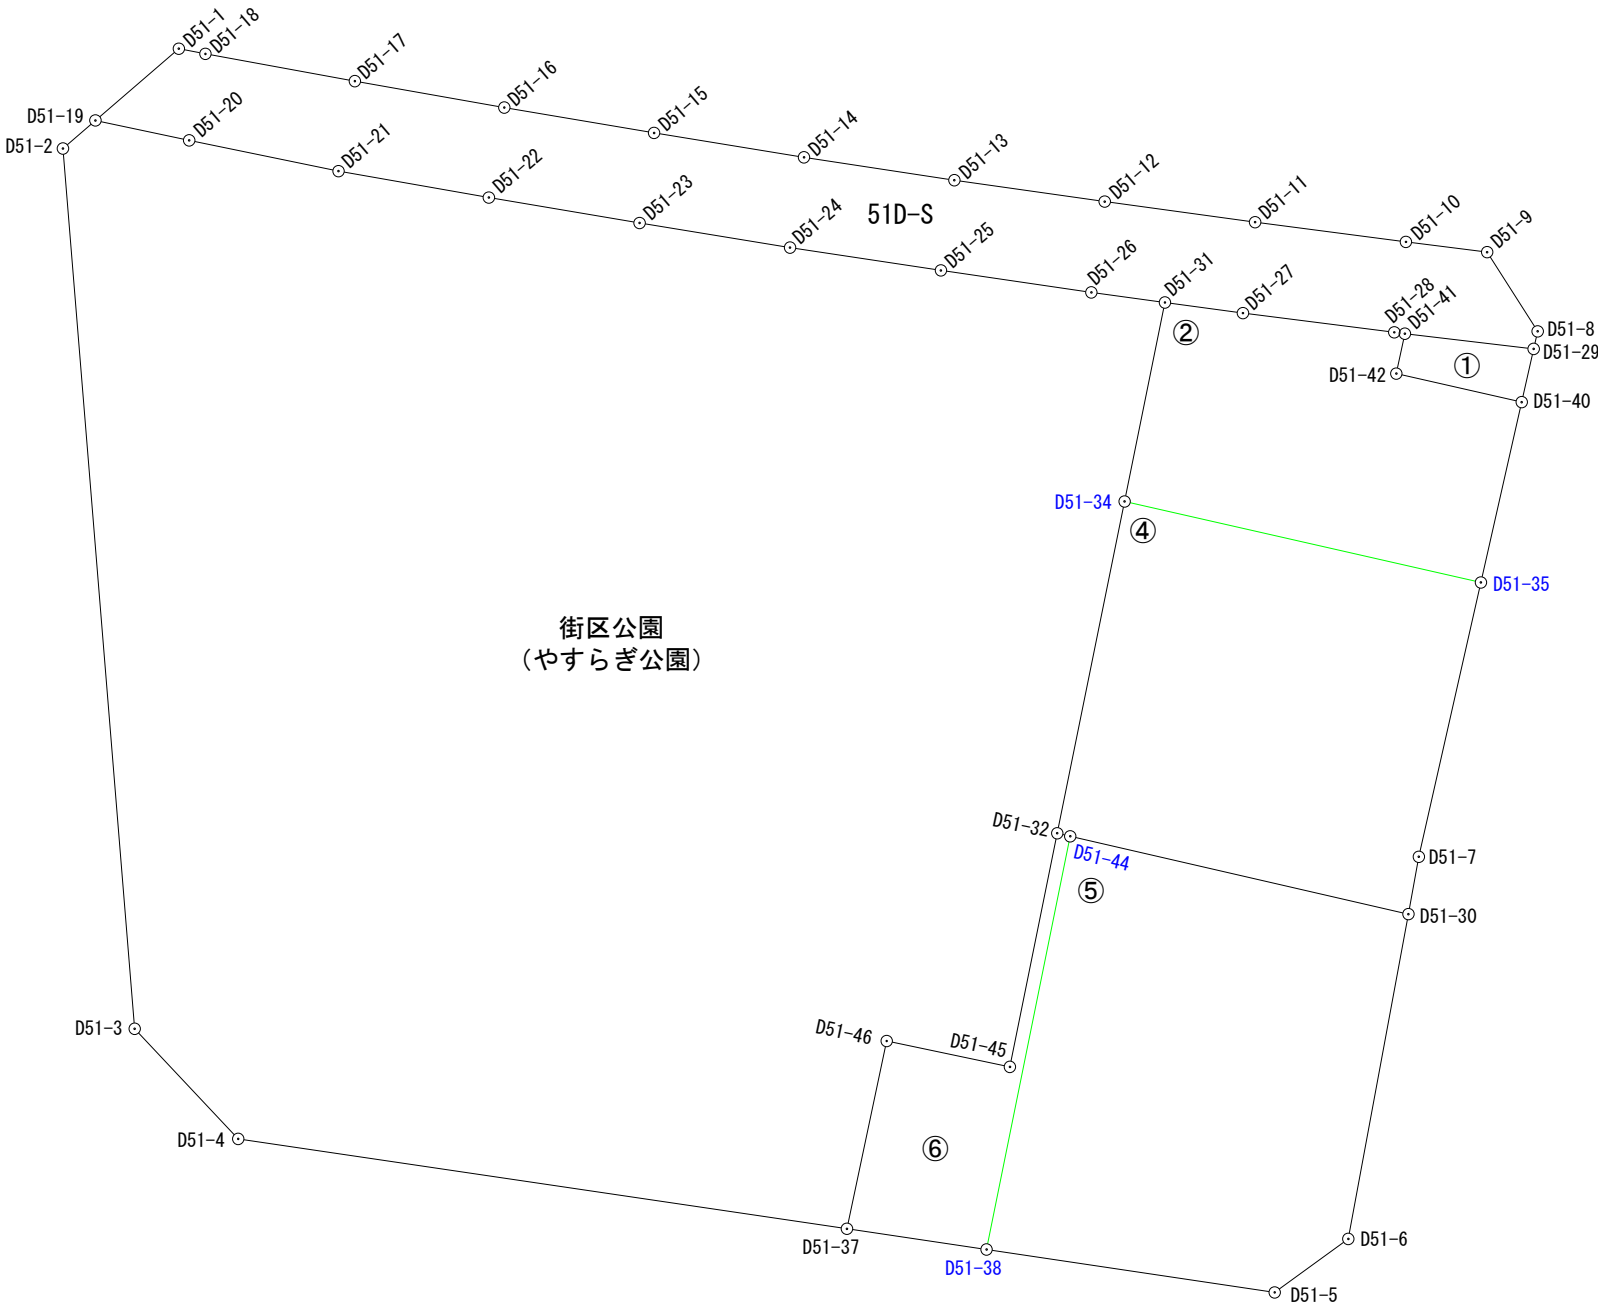

凡 例	
	施工地区界
	道 路
	街区番号
	画 地 番 号
D14-1	計 算 点
D14-2	境界標あり

平成24年10月25日測量
平成24年10月19日測量
平成24年 2月 2日測量
平成23年12月14日測量
平成23年12月13日測量
平成23年12月 8日測量

面積（座標法）計算書

地番：51D-1

測点名	[1] X(i)	[2] X(i+1)-X(i-1)	[3] Y(i)	[4] Y(i+1)-Y(i-1)	[2]*[3]	[1]*[4]	方向角	夾角	距離
D51-41	61664.662	-0.818	-6726.648	-4.543	5502.398064	-280142.559466	192-04-05	95-21-44	1.349
D51-42	61663.343	-2.261	-6726.930	3.864	15209.588730	238267.157352	102-48-02	90-43-57	4.252
D51-40	61662.401	0.818	-6722.784	4.543	-5499.237312	280132.287743	12-42-41	89-54-39	1.804
D51-29	61664.161	2.261	-6722.387	-3.864	-15199.317007	-238270.318104	276-42-21	83-59-40	4.290
合計				倍面積	13.432475	-13.432475			11.695
				面積	6.7162375	6.7162375			
				坪数	2.03	2.03			

面積（座標法）計算書

地 番： 51D-2

測点名	[1] X(i)	[2] X(i+1)-X(i-1)	[3] Y(i)	[4] Y(i+1)-Y(i-1)	[2]*[3]	[1]*[4]	方向角	夾 角	距 離
D51-31	61665.695	-6.227	-6734.583	-3.917	41936.248341	-241544.527315	191-28-44	93-42-46	6.713
D51-34	61659.116	-9.257	-6735.919	10.450	62354.402183	644337.762200	102-48-05	91-19-21	12.086
D51-35	61656.438	3.285	-6724.133	13.135	-22088.776905	809857.313130	12-44-50	89-56-45	6.114
D51-40	61662.401	6.905	-6722.784	-2.797	-46420.823520	-172469.735597	282-48-02	90-03-12	4.252
D51-42	61663.343	2.261	-6726.930	-3.864	-15209.588730	-238267.157352	12-04-05	269-16-03	1.349
D51-41	61664.662	1.364	-6726.648	-0.068	-9175.147872	-4193.197016	277-19-35	85-15-30	0.353
D51-28	61664.707	0.681	-6726.998	-5.354	-4581.085638	-330152.841278	277-14-36	179-55-01	5.044
D51-27	61665.343	0.988	-6732.002	-7.585	-6651.217976	-467731.626655	277-45-58	180-31-22	2.605
合計				倍面積	164.009883	-164.009883			38.516
				面 積	82.0049415	82.0049415			
				坪 数	24.80	24.80			

面積（座標法）計算書

地番：51D-4

測点名	[1] X(i)	[2] X(i+1)-X(i-1)	[3] Y(i)	[4] Y(i+1)-Y(i-1)	[2]*[3]	[1]*[4]	方向角	夾角	距離
D51-34	61659.116	-8.293	-6735.919	-14.014	55860.976267	-864090.851624	191-28-46	88-40-41	11.195
D51-32	61648.145	-11.070	-6738.147	-1.797	74591.287290	-110781.716565	102-56-11	91-27-25	0.442
D51-44	61648.046	-2.676	-6737.716	11.615	18030.128016	716042.054290	102-58-32	180-02-21	11.477
D51-30	61645.469	-0.679	-6726.532	11.530	4567.315228	710772.257570	10-19-53	87-21-21	1.929
D51-7	61647.367	10.969	-6726.186	2.399	-73779.534234	147892.033433	12-45-10	182-25-17	9.300
D51-35	61656.438	11.749	-6724.133	-9.733	-79001.838617	-600102.111054	282-48-05	90-02-55	12.086
合計				倍面積	268.333950	-268.333950			46.429
				面積	134.1669750	134.1669750			
				坪数	40.58	40.58			

面積（座標法）計算書

地番：51D-5

測点名	[1] X(i)	[2] X(i+1)-X(i-1)	[3] Y(i)	[4] Y(i+1)-Y(i-1)	[2]*[3]	[1]*[4]	方向角	夾角	距離
D51-44	61648.046	-11.087	-6737.716	-13.952	74701.057292	-860113.537792	191-27-06	88-28-34	13.942
D51-38	61634.382	-15.082	-6740.484	6.763	101659.979688	416833.325466	98-27-44	87-00-38	9.636
D51-5	61632.964	0.350	-6730.953	11.966	-2355.833550	737500.047224	54-01-03	135-33-19	3.009
D51-6	61634.732	12.505	-6728.518	4.421	-84140.117590	272487.150172	10-28-46	136-27-43	10.919
D51-30	61645.469	13.314	-6726.532	-9.198	-89557.047048	-567015.023862	282-58-32	92-29-46	11.477
合計				倍面積	308.038792	-308.038792			48.983
				面積	154.0193960	154.0193960			
				坪数	46.59	46.59			

面積（座標法）計算書

地 番： 51D-6

測点名	[1] X(i)	[2] X(i+1)-X(i-1)	[3] Y(i)	[4] Y(i+1)-Y(i-1)	[2]*[3]	[1]*[4]	方向角	夾 角	距 離
D51-32	61648.145	-7.625	-6738.147	-1.996	51378.370875	-123049.697420	191-27-14	88-31-03	7.881
D51-45	61640.421	-6.870	-6739.712	-5.638	46301.821440	-347528.693598	281-50-31	270-23-17	4.162
D51-46	61641.275	-5.352	-6743.785	-5.389	36092.737320	-332184.830975	191-58-21	90-07-50	6.344
D51-37	61635.069	-6.893	-6745.101	3.301	46493.981193	203457.362769	98-27-48	86-29-27	4.668
D51-38	61634.382	12.977	-6740.484	7.385	-87471.260868	455169.911070	11-27-06	92-59-18	13.942
D51-44	61648.046	13.763	-6737.716	2.337	-92731.185308	144071.483502	282-56-11	91-29-05	0.442
合計				倍面積	64.464652	-64.464652			37.439
				面 積	32.2323260	32.2323260			
				坪 数	9.75	9.75			

面積（座標法）計算書

地番：51D-K

測点名	[1] X(i)	[2] X(i+1)-X(i-1)	[3] Y(i)	[4] Y(i+1)-Y(i-1)	[2]*[3]	[1]*[4]	方向角	夾角	距離
D51-19	61671.714	-0.270	-6769.955	-4.174	1827.887850	-257417.734236	229-10-01	127-09-43	1.421
D51-2	61670.785	-30.033	-6771.030	1.298	203354.343990	80048.678930	175-20-19	126-10-18	29.201
D51-3	61641.681	-32.745	-6768.657	5.797	221639.673465	357336.824757	136-45-33	141-25-14	4.998
D51-4	61638.040	-6.612	-6765.233	23.556	44731.720596	1451945.670240	98-23-42	141-38-09	20.350
D51-37	61635.069	3.235	-6745.101	21.448	-21820.401735	1321948.959912	11-58-21	93-34-39	6.344
D51-46	61641.275	5.352	-6743.785	5.389	-36092.737320	332184.830975	101-50-31	269-52-10	4.162
D51-45	61640.421	6.870	-6739.712	5.638	-46301.821440	347528.693598	11-27-14	89-36-43	7.881
D51-32	61648.145	18.695	-6738.147	3.793	-125969.658165	233831.413985	11-28-46	180-01-32	11.195
D51-34	61659.116	17.550	-6735.919	3.564	-118215.378450	219753.089424	11-28-44	179-59-58	6.713
D51-31	61665.695	6.911	-6734.583	-1.096	-46542.703113	-67585.601720	277-46-25	86-17-41	2.455
D51-26	61666.027	1.059	-6737.015	-7.409	-7134.498885	-456883.594043	278-18-38	180-32-13	5.030
D51-25	61666.754	1.483	-6741.992	-9.968	-9998.374136	-614694.203872	278-36-48	180-18-10	5.048
D51-24	61667.510	1.569	-6746.983	-9.967	-10586.016327	-614640.072170	279-16-45	180-39-57	5.042
D51-23	61668.323	1.654	-6751.959	-9.961	-11167.740186	-614278.165403	279-34-34	180-17-49	5.055
D51-22	61669.164	1.716	-6756.944	-9.956	-11594.915904	-613978.196784	279-58-59	180-24-25	5.047
D51-21	61670.039	1.891	-6761.915	-9.912	-12786.781265	-611273.426568	281-37-10	181-38-11	5.044
D51-20	61671.055	1.675	-6766.856	-8.040	-11334.483800	-495835.282200	282-00-18	180-23-08	3.168
合計				倍面積	2008.115175	-2008.115175			128.154
				面積	1004.0575875	1004.0575875			
				坪数	303.72	303.72			

面積（座標法）計算書

地 番： 51D-S

測点名	[1] X(i)	[2] X(i+1)-X(i-1)	[3] Y(i)	[4] Y(i+1)-Y(i-1)	[2]*[3]	[1]*[4]	方向角	夾 角	距 離
D51-1	61674.084	-2.202	-6767.197	-3.636	14901.367794	-224246.969424	229-19-37	128-29-41	3.636
D51-19	61671.714	-3.029	-6769.955	0.341	20506.193695	21030.054474	102-00-18	52-40-41	3.168
D51-20	61671.055	-1.675	-6766.856	8.040	11334.483800	495835.282200	101-37-10	179-36-52	5.044
D51-21	61670.039	-1.891	-6761.915	9.912	12786.781265	611273.426568	99-58-59	178-21-49	5.047
D51-22	61669.164	-1.716	-6756.944	9.956	11594.915904	613978.196784	99-34-34	179-35-35	5.055
D51-23	61668.323	-1.654	-6751.959	9.961	11167.740186	614278.165403	99-16-45	179-42-11	5.042
D51-24	61667.510	-1.569	-6746.983	9.967	10586.016327	614640.072170	98-36-48	179-20-03	5.048
D51-25	61666.754	-1.483	-6741.992	9.968	9998.374136	614694.203872	98-18-38	179-41-50	5.030
D51-26	61666.027	-1.059	-6737.015	7.409	7134.498885	456883.594043	97-46-25	179-27-47	2.455
D51-31	61665.695	-0.684	-6734.583	5.013	4606.454772	309130.129035	97-45-58	179-59-33	2.605
D51-27	61665.343	-0.988	-6732.002	7.585	6651.217976	467731.626655	97-14-36	179-28-38	5.044
D51-28	61664.707	-0.681	-6726.998	5.354	4581.085638	330152.841278	97-19-35	180-04-59	0.353
D51-41	61664.662	-0.546	-6726.648	4.611	3672.749808	284335.756482	96-42-21	179-22-46	4.290
D51-29	61664.161	0.078	-6722.387	4.392	-524.346186	270828.995112	12-44-55	96-02-34	0.594
D51-8	61664.740	3.196	-6722.256	-1.538	-21484.330176	-94840.370120	327-28-20	134-43-25	3.104
D51-9	61667.357	2.958	-6723.925	-4.356	-19889.370150	-268623.007092	277-13-57	129-45-37	2.709
D51-10	61667.698	0.993	-6726.612	-7.675	-6679.525716	-473299.582150	277-26-50	180-12-53	5.030
D51-11	61668.350	1.332	-6731.600	-9.965	-8966.491200	-614525.107750	277-46-48	180-19-58	5.023
D51-12	61669.030	1.387	-6736.577	-9.949	-9343.632299	-613545.179470	278-05-35	180-18-47	5.022
D51-13	61669.737	1.465	-6741.549	-9.945	-9876.369285	-613305.534465	278-39-59	180-34-24	5.030
D51-14	61670.495	1.562	-6746.522	-9.929	-10538.067364	-612326.344855	279-12-53	180-32-54	5.021
D51-15	61671.299	1.644	-6751.478	-9.910	-11099.429832	-611162.573090	279-37-25	180-24-32	5.025
D51-16	61672.139	1.715	-6756.432	-9.897	-11587.280880	-610369.159683	280-02-18	180-24-53	5.020
D51-17	61673.014	1.777	-6761.375	-9.887	-12014.963375	-609761.089418	280-20-22	180-18-04	5.026
D51-18	61673.916	1.070	-6766.319	-5.822	-7239.961330	-359065.538952	280-49-56	180-29-34	0.894
合計				倍面積	278.112393	-278.112393			99.315
				面 積	139.0561965	139.0561965			
				坪 数	42.06	42.06			