
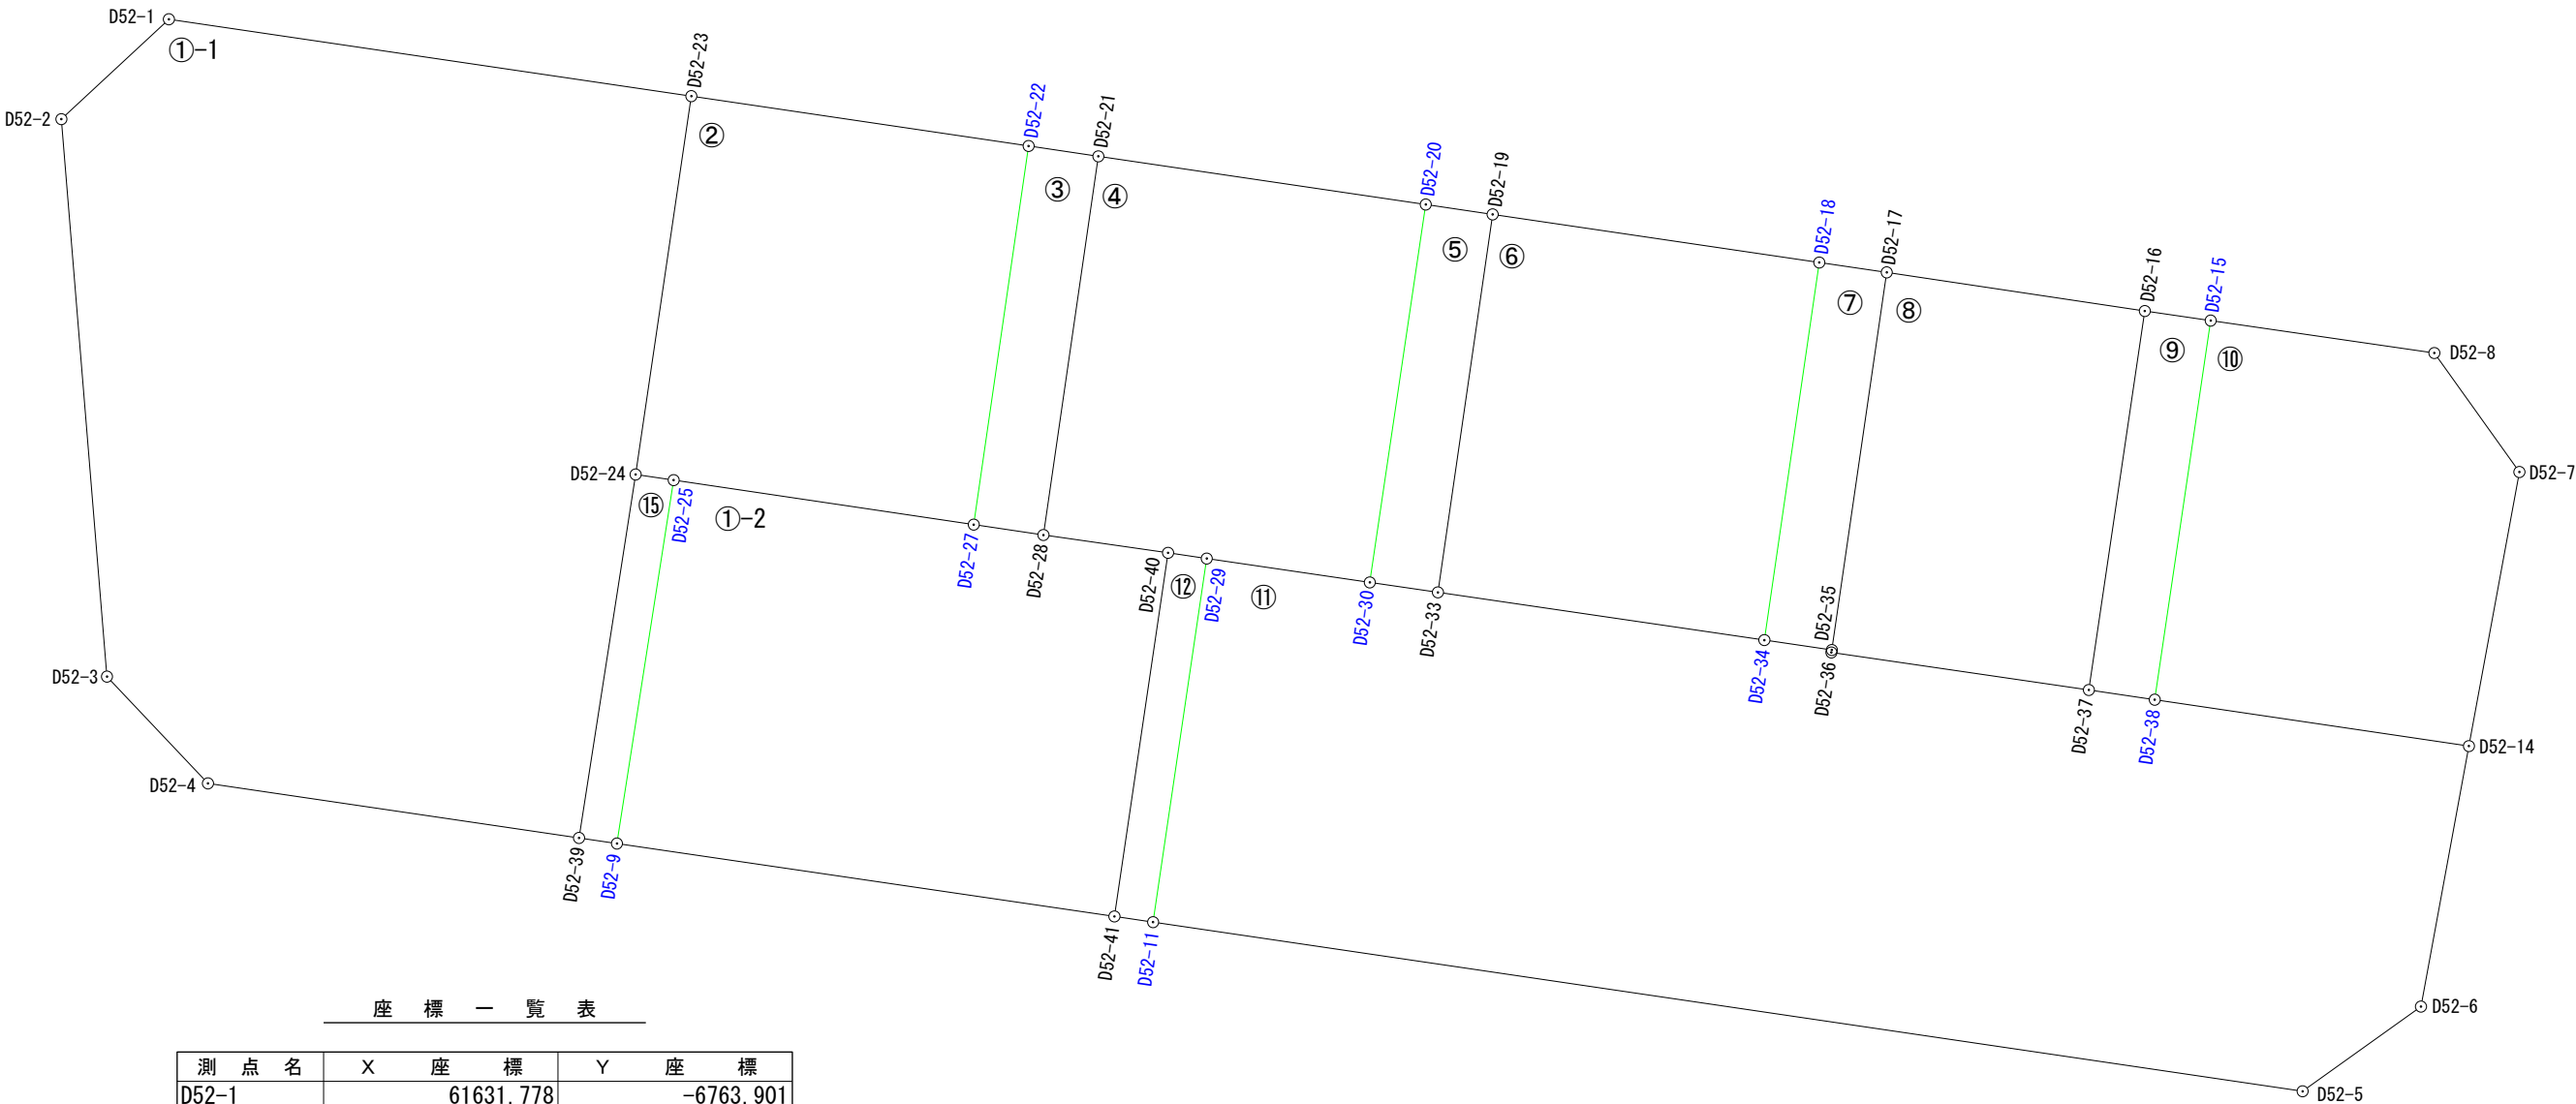


出来形確認測量図（縮尺1：250）

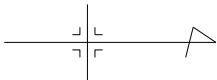

座 標 一 覧 表

測 点 名	X	座 標	Y	座 標
D52-1		61631.778		-6763.901
D52-2		61628.369		-6767.571
D52-3		61609.334		-6766.015
D52-4		61605.686		-6762.567
D52-5		61595.176		-6691.057
D52-6		61598.067		-6687.016
D52-7		61616.321		-6683.657
D52-8		61620.383		-6686.559
D52-9		61603.635		-6748.604
D52-11		61600.950		-6730.302
D52-14		61606.962		-6685.379
D52-15		61621.490		-6694.195
D52-16		61621.816		-6696.445
D52-17		61623.134		-6705.253
D52-18		61623.473		-6707.556
D52-19		61625.115		-6718.708
D52-20		61625.451		-6720.992
D52-21		61627.097		-6732.169
D52-22		61627.450		-6734.552
D52-23		61629.152		-6746.065

測 点 名	X	座 標	Y	座 標
D52-24		61616.235		-6747.966
D52-25		61616.042		-6746.670
D52-27		61614.522		-6736.426
D52-28		61614.168		-6734.044
D52-29		61613.366		-6728.470
D52-30		61612.551		-6722.902
D52-33		61612.211		-6720.576
D52-34		61610.580		-6709.433
D52-35		61610.243		-6707.128
D52-36		61610.158		-6707.144
D52-37		61608.878		-6698.354
D52-38		61608.546		-6696.106
D52-39		61603.825		-6749.899
D52-40		61613.559		-6729.790
D52-41		61601.145		-6731.622

凡 例	
	施工地区界
	道 路
	街区番号
	画地番号
D14-1	計 算 点
D14-2	境界標あり

平成24年 2月 3日測量
平成23年12月13日測量
平成23年12月 8日測量
平成23年12月 2日測量

面積（座標法）計算書

地 番： 52D-1-1

測点名	[1] X(i)	[2] X(i+1)-X(i-1)	[3] Y(i)	[4] Y(i+1)-Y(i-1)	[2]*[3]	[1]*[4]	方向角	夾 角	距 離
D52-1	61631.778	-0.783	-6763.901	-21.506	5296.134483	-1325453.017668	227-06-41	128-44-09	5.009
D52-2	61628.369	-22.444	-6767.571	-2.114	151891.363524	-130282.372066	175-19-36	128-12-55	19.098
D52-3	61609.334	-22.683	-6766.015	5.004	153473.518245	308293.107336	136-36-52	141-17-16	5.020
D52-4	61605.686	-5.509	-6762.567	16.116	37254.981603	992837.235576	98-21-26	141-44-34	12.804
D52-39	61603.825	10.549	-6749.899	14.601	-71204.684551	899477.448825	8-51-12	90-29-46	12.560
D52-24	61616.235	25.327	-6747.966	3.834	-170905.734882	236236.644990	8-22-20	179-31-08	13.056
D52-23	61629.152	15.543	-6746.065	-15.935	-104854.088295	-982060.537120	278-22-32	90-00-12	18.028
合計				倍面積	951.490127	-951.490127			85.575
				面 積	475.7450635	475.7450635			
				坪 数	143.91	143.91			

面積（座標法）計算書

地番：52D-1-2

測点名	[1] X(i)	[2] X(i+1)-X(i-1)	[3] Y(i)	[4] Y(i+1)-Y(i-1)	[2]*[3]	[1]*[4]	方向角	夾角	距離
D52-25	61616.042	-10.887	-6746.670	-12.178	73450.996290	-750360.159476	188-51-36	90-25-12	12.557
D52-9	61603.635	-14.897	-6748.604	15.048	100533.953788	927011.499480	98-20-30	89-28-54	17.164
D52-41	61601.145	9.924	-6731.622	18.814	-66804.616728	1158963.942030	8-23-41	90-03-11	12.548
D52-40	61613.559	13.023	-6729.790	-2.422	-87642.055170	-149228.039898	278-08-49	89-45-08	4.297
D52-28	61614.168	0.963	-6734.044	-6.636	-6484.884372	-408871.618848	278-27-11	180-18-22	2.408
D52-27	61614.522	1.874	-6736.426	-12.626	-12624.062324	-777944.954772	278-26-24	179-59-13	10.356
合計				倍面積	429.331484	-429.331484			59.330
				面積	214.6657420	214.6657420			
				坪数	64.93	64.93			

面積（座標法）計算書

地番：52D-2

測点名	[1] X(i)	[2] X(i+1)-X(i-1)	[3] Y(i)	[4] Y(i+1)-Y(i-1)	[2]*[3]	[1]*[4]	方向角	夾角	距離
D52-23	61629.152	-11.215	-6746.065	-13.414	75657.118975	-826693.444928	188-22-20	89-57-47	13.056
D52-24	61616.235	-13.110	-6747.966	-0.605	88465.834260	-37277.822175	98-28-13	90-05-53	1.310
D52-25	61616.042	-1.713	-6746.670	11.540	11557.045710	711049.124680	98-26-24	179-58-11	10.356
D52-27	61614.522	11.408	-6736.426	12.118	-76849.147808	746644.777596	8-14-53	89-48-29	13.063
D52-22	61627.450	14.630	-6734.552	-9.639	-98526.495760	-594026.990550	278-24-33	90-09-40	11.638
合計				倍面積	304.355377	-304.355377			49.423
				面積	152.1776885	152.1776885			
				坪数	46.03	46.03			

面積（座標法）計算書

地番：52D-3

測点名	[1] X(i)	[2] X(i+1)-X(i-1)	[3] Y(i)	[4] Y(i+1)-Y(i-1)	[2]*[3]	[1]*[4]	方向角	夾角	距離
D52-22	61627.450	-12.575	-6734.552	-4.257	84686.991400	-262348.054650	188-14-53	89-49-19	13.063
D52-27	61614.522	-13.282	-6736.426	0.508	89473.210132	31300.177176	98-27-11	90-12-18	2.408
D52-28	61614.168	12.575	-6734.044	4.257	-84680.603300	262291.513176	8-15-06	89-47-55	13.064
D52-21	61627.097	13.282	-6732.169	-0.508	-89416.668658	-31306.565276	278-25-34	90-10-28	2.409
合計				倍面積	62.929574	-62.929574			30.944
				面積	31.4647870	31.4647870			
				坪数	9.51	9.51			

面積（座標法）計算書

地番： 52D-4

測点名	[1] X(i)	[2] X(i+1)-X(i-1)	[3] Y(i)	[4] Y(i+1)-Y(i-1)	[2]*[3]	[1]*[4]	方向角	夾角	距離
D52-21	61627.097	-11.283	-6732.169	-13.052	75959.062827	-804356.870044	188-15-06	89-52-27	13.064
D52-28	61614.168	-13.538	-6734.044	2.379	91165.487672	146580.105672	98-08-49	89-53-43	4.297
D52-40	61613.559	-0.802	-6729.790	5.574	5397.291580	343433.977866	98-19-06	180-10-17	1.334
D52-29	61613.366	-1.008	-6728.470	6.888	6782.297760	424392.865008	98-19-39	180-00-33	5.627
D52-30	61612.551	12.085	-6722.902	7.478	-81246.270670	460738.656378	8-25-20	90-05-41	13.041
D52-20	61625.451	14.546	-6720.992	-9.267	-97763.549632	-571083.054417	278-22-39	89-57-19	11.298
合計				倍面積	294.319537	-294.319537			48.661
				面積	147.1597685	147.1597685			
				坪数	44.51	44.51			

面積（座標法）計算書

地番：52D-5

測点名	[1] X(i)	[2] X(i+1)-X(i-1)	[3] Y(i)	[4] Y(i+1)-Y(i-1)	[2]*[3]	[1]*[4]	方向角	夾角	距離
D52-20	61625.451	-12.564	-6720.992	-4.194	84442.543488	-258457.141494	188-25-20	90-03-12	13.041
D52-30	61612.551	-13.240	-6722.902	0.416	89011.222480	25630.821216	98-18-58	89-53-38	2.351
D52-33	61612.211	12.564	-6720.576	4.194	-84437.316864	258401.612934	8-14-13	89-55-15	13.039
D52-19	61625.115	13.240	-6718.708	-0.416	-88955.693920	-25636.047840	278-22-08	90-07-55	2.309
合計				倍面積	60.755184	-60.755184			30.740
				面積	30.3775920	30.3775920			
				坪数	9.18	9.18			

面積（座標法）計算書

地番：52D-6

測点名	[1] X(i)	[2] X(i+1)-X(i-1)	[3] Y(i)	[4] Y(i+1)-Y(i-1)	[2]*[3]	[1]*[4]	方向角	夾角	距離
D52-19	61625.115	-11.262	-6718.708	-13.020	75666.089496	-802358.997300	188-14-13	89-51-40	13.039
D52-33	61612.211	-14.535	-6720.576	9.275	97683.572160	571453.257025	98-19-38	90-05-25	11.262
D52-34	61610.580	11.262	-6709.433	13.020	-75561.634446	802169.751600	8-16-59	89-57-21	13.029
D52-18	61623.473	14.535	-6707.556	-9.275	-97494.326460	-571557.712075	278-22-33	90-05-34	11.272
合計				倍面積	293.700750	-293.700750			48.602
				面積	146.8503750	146.8503750			
				坪数	44.42	44.42			

面積（座標法）計算書

地番：52D-7

測点名	[1] X(i)	[2] X(i+1)-X(i-1)	[3] Y(i)	[4] Y(i+1)-Y(i-1)	[2]*[3]	[1]*[4]	方向角	夾角	距離
D52-18	61623.473	-12.554	-6707.556	-4.180	84206.658024	-257586.117140	188-16-59	89-54-33	13.029
D52-34	61610.580	-13.230	-6709.433	0.428	88765.798590	26369.328240	98-19-05	90-02-06	2.330
D52-35	61610.243	12.554	-6707.128	4.180	-84201.284912	257530.815740	8-16-32	89-57-27	13.027
D52-17	61623.134	13.230	-6705.253	-0.428	-88710.497190	-26374.701352	278-22-26	90-05-54	2.328
合計				倍面積	60.674512	-60.674512			30.714
				面積	30.3372560	30.3372560			
				坪数	9.17	9.17			

面積（座標法）計算書

地番：52D-8

測点名	[1] X(i)	[2] X(i+1)-X(i-1)	[3] Y(i)	[4] Y(i+1)-Y(i-1)	[2]*[3]	[1]*[4]	方向角	夾角	距離
D52-17	61623.134	-11.573	-6705.253	-10.683	77599.892969	-658319.940522	188-16-32	89-45-55	13.027
D52-35	61610.243	-12.976	-6707.128	-1.891	87031.692928	-116504.969513	190-39-37	182-23-05	0.086
D52-36	61610.158	-1.365	-6707.144	8.774	9155.251560	540567.526292	98-17-07	87-37-30	8.883
D52-37	61608.878	11.658	-6698.354	10.699	-78089.410932	659153.385722	8-23-36	90-06-29	13.078
D52-16	61621.816	14.256	-6696.445	-6.899	-95464.519920	-425128.908584	278-30-37	90-07-01	8.906
合計				倍面積	232.906605	-232.906605			43.980
				面積	116.4533025	116.4533025			
				坪数	35.22	35.22			

面積（座標法）計算書

地番：52D-9

測点名	[1] X(i)	[2] X(i+1)-X(i-1)	[3] Y(i)	[4] Y(i+1)-Y(i-1)	[2]*[3]	[1]*[4]	方向角	夾角	距離
D52-16	61621.816	-12.612	-6696.445	-4.159	84455.564340	-256285.132744	188-23-36	90-08-57	13.078
D52-37	61608.878	-13.270	-6698.354	0.339	88887.157580	20885.409642	98-24-04	90-00-28	2.272
D52-38	61608.546	12.612	-6696.106	4.159	-84451.288872	256229.942814	8-23-54	89-59-50	13.084
D52-15	61621.490	13.270	-6694.195	-0.339	-88831.967650	-20889.685110	278-14-39	89-50-45	2.273
合計				倍面積	59.465398	-59.465398			30.707
				面積	29.7326990	29.7326990			
				坪数	8.99	8.99			

面積（座標法）計算書

地番：52D-10

測点名	[1] X(i)	[2] X(i+1)-X(i-1)	[3] Y(i)	[4] Y(i+1)-Y(i-1)	[2]*[3]	[1]*[4]	方向角	夾角	距離
D52-15	61621.490	-11.837	-6694.195	-9.547	79239.186215	-588300.365030	188-23-54	90-08-58	13.084
D52-38	61608.546	-14.528	-6696.106	8.816	97281.027968	543140.941536	98-24-00	90-00-06	10.843
D52-14	61606.962	7.775	-6685.379	12.449	-51978.821725	766945.069938	10-25-32	92-01-32	9.516
D52-7	61616.321	13.421	-6683.657	-1.180	-89701.360597	-72707.258780	324-27-25	134-01-53	4.992
D52-8	61620.383	5.169	-6686.559	-10.538	-34562.823471	-649355.596054	278-14-56	133-47-31	7.716
合計				倍面積	277.208390	-277.208390			46.151
				面積	138.6041950	138.6041950			
				坪数	41.92	41.92			

面積（座標法）計算書

地 番： 52D-11

測点名	[1] X(i)	[2] X(i+1)-X(i-1)	[3] Y(i)	[4] Y(i+1)-Y(i-1)	[2]*[3]	[1]*[4]	方向角	夾 角	距 離
D52-29	61613.366	-11.601	-6728.470	-7.400	78056.980470	-455938.908400	188-23-37	90-03-58	12.550
D52-11	61600.950	-18.190	-6730.302	37.413	122424.193380	2304676.342350	98-22-11	89-58-34	39.667
D52-5	61595.176	-2.883	-6691.057	43.286	19290.317331	2666208.788336	54-25-10	136-02-59	4.969
D52-6	61598.067	11.786	-6687.016	5.678	-78813.170576	349753.824426	10-25-40	136-00-30	9.044
D52-14	61606.962	10.479	-6685.379	-9.090	-70056.086541	-560007.284580	278-24-00	87-58-20	10.843
D52-38	61608.546	1.916	-6696.106	-12.975	-12829.739096	-799370.884350	278-24-04	180-00-04	2.272
D52-37	61608.878	1.612	-6698.354	-11.038	-10797.746648	-680038.795364	278-17-07	179-53-03	8.883
D52-36	61610.158	1.365	-6707.144	-8.774	-9155.251560	-540567.526292	10-39-37	272-22-30	0.086
D52-35	61610.243	0.422	-6707.128	-2.289	-2830.408016	-141025.846227	278-19-05	87-39-28	2.330
D52-34	61610.580	1.968	-6709.433	-13.448	-13204.164144	-828539.079840	278-19-38	180-00-33	11.262
D52-33	61612.211	1.971	-6720.576	-13.469	-13246.255296	-829854.869959	278-18-58	179-59-20	2.351
D52-30	61612.551	1.155	-6722.902	-7.894	-7764.951810	-486369.477594	278-19-39	180-00-41	5.627
合計				倍面積	1073.717494	-1073.717494			109.884
				面 積	536.8587470	536.8587470			
				坪 数	162.39	162.39			

面積（座標法）計算書

地番：52D-12

測点名	[1] X(i)	[2] X(i+1)-X(i-1)	[3] Y(i)	[4] Y(i+1)-Y(i-1)	[2]*[3]	[1]*[4]	方向角	夾角	距離
D52-40	61613.559	-12.221	-6729.790	-3.152	82244.763590	-194205.937968	188-23-41	90-04-35	12.548
D52-41	61601.145	-12.609	-6731.622	-0.512	84879.021798	-31539.786240	98-24-12	90-00-31	1.334
D52-11	61600.950	12.221	-6730.302	3.152	-82251.020742	194166.194400	8-23-37	89-59-25	12.550
D52-29	61613.366	12.609	-6728.470	0.512	-84839.278230	31546.043392	278-19-06	89-55-29	1.334
合計				倍面積	33.486416	-33.486416			27.766
				面積	16.7432080	16.7432080			
				坪数	5.06	5.06			

面積（座標法）計算書

地番：52D-15

測点名	[1] X(i)	[2] X(i+1)-X(i-1)	[3] Y(i)	[4] Y(i+1)-Y(i-1)	[2]*[3]	[1]*[4]	方向角	夾角	距離
D52-24	61616.235	-12.217	-6747.966	-3.229	82439.900622	-198958.822815	188-51-12	90-22-59	12.560
D52-39	61603.825	-12.600	-6749.899	-0.638	85048.727400	-39303.240350	98-20-48	89-29-36	1.309
D52-9	61603.635	12.217	-6748.604	3.229	-82447.695068	198918.137415	8-51-36	90-30-48	12.557
D52-25	61616.042	12.600	-6746.670	0.638	-85008.042000	39311.034796	278-28-13	89-36-37	1.310
合計				倍面積	32.890954	-32.890954			27.736
				面積	16.4454770	16.4454770			
				坪数	4.97	4.97			