
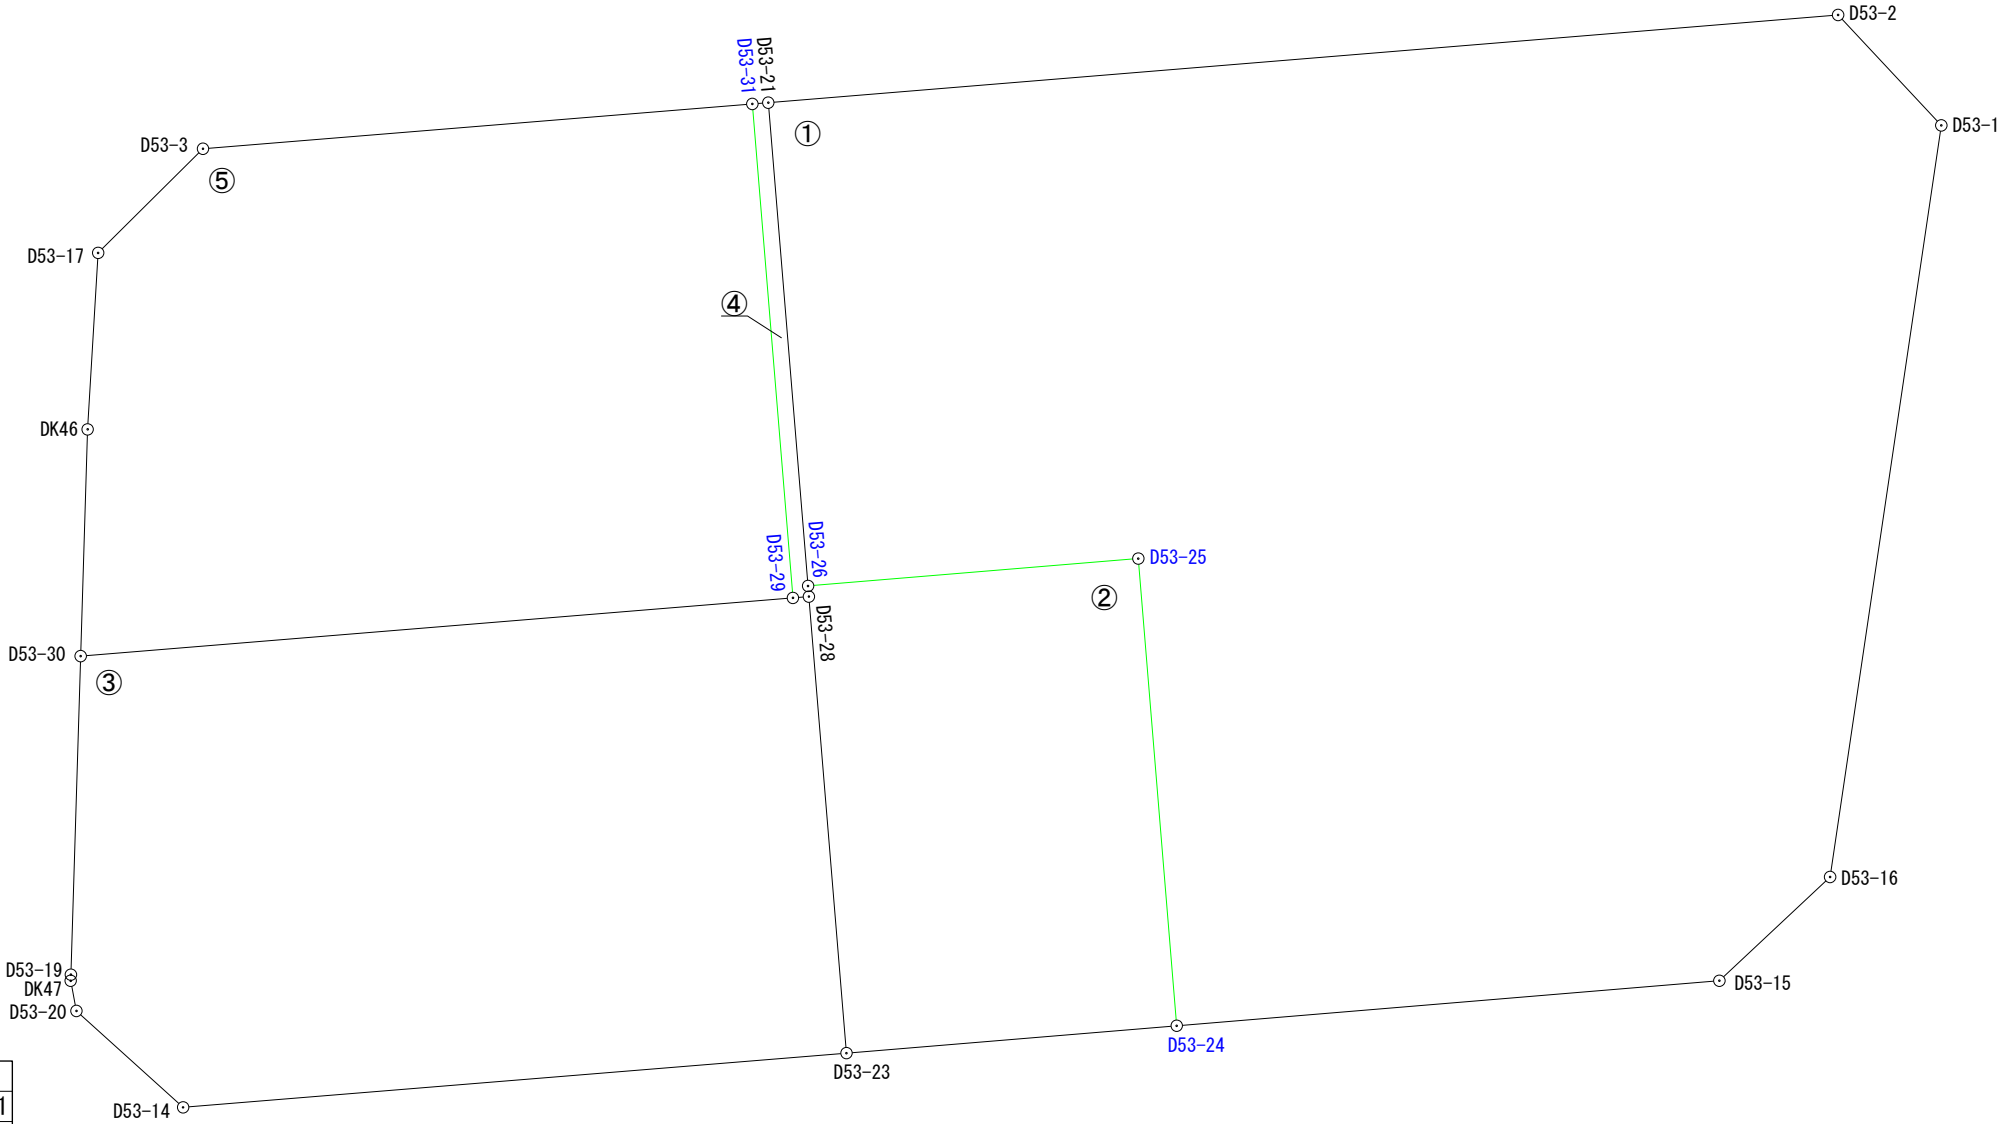


出来形確認測量図（縮尺１：２５０）

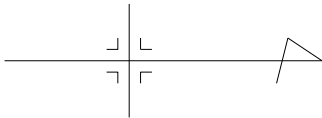

座 標 一 覧 表

測 点 名	X	座 標	Y	座 標
D53-1		61599.448		-6761.251
D53-2		61596.037		-6764.903
D53-3		61541.955		-6760.479
D53-14		61541.298		-6728.783
D53-15		61592.109		-6732.970
D53-16		61595.771		-6736.400
D53-17		61538.487		-6757.036
D53-19		61537.587		-6733.172
D53-20		61537.771		-6731.972
D53-21		61560.654		-6762.004
D53-23		61563.237		-6730.576
D53-24		61574.160		-6731.482
D53-25		61572.890		-6746.930
D53-26		61561.967		-6746.024
D53-28		61561.996		-6745.672
D53-29		61561.468		-6745.629
D53-30		61537.910		-6743.704
D53-31		61560.125		-6761.961
DK46		61538.140		-6751.201
DK47		61537.581		-6732.969

凡 例	
	施工地区界
	道 路
	街区番号
	画 地 番 号
D14-1	計 算 点
D14-2	境界標あり

平成26年 1月10日測量
平成24年 1月30日測量
平成23年12月19日測量
平成23年12月13日測量
平成23年12月 2日測量

面積（座標法）計算書

地番：53D-1

測点名	[1] X(i)	[2] X(i+1)-X(i-1)	[3] Y(i)	[4] Y(i+1)-Y(i-1)	[2]*[3]	[1]*[4]	方向角	夾角	距離
D53-21	61560.654	-34.070	-6762.004	18.879	230381.476280	1162203.586866	85-18-10	89-59-12	16.034
D53-26	61561.967	12.236	-6746.024	15.074	-82544.349664	927985.090558	355-15-31	89-57-21	10.961
D53-25	61572.890	12.193	-6746.930	14.542	-82265.317490	895392.966380	85-18-01	270-02-30	15.500
D53-24	61574.160	19.219	-6731.482	13.960	-129372.352558	859575.273600	355-15-39	89-57-38	18.011
D53-15	61592.109	21.611	-6732.970	-4.918	-145506.214670	-302909.992062	316-52-25	141-36-46	5.017
D53-16	61595.771	7.339	-6736.400	-28.281	-49438.439600	-1741989.999651	278-24-59	141-32-34	25.122
D53-1	61599.448	0.266	-6761.251	-28.503	-1798.492766	-1755769.066344	226-57-15	128-32-16	4.997
D53-2	61596.037	-38.794	-6764.903	-0.753	262437.646982	-46381.815861	175-18-58	128-21-43	35.502
合計				倍面積	1893.956514	-1893.956514			131.144
				面積	946.9782570	946.9782570			
				坪数	286.46	286.46			

面積（座標法）計算書

地番：53D-2

測点名	[1] X(i)	[2] X(i+1)-X(i-1)	[3] Y(i)	[4] Y(i+1)-Y(i-1)	[2]*[3]	[1]*[4]	方向角	夾角	距離
D53-23	61563.237	12.164	-6730.576	14.190	-81870.726464	873582.333030	355-15-31	89-57-29	10.961
D53-24	61574.160	9.653	-6731.482	-16.354	-64978.995746	-1006983.812640	265-18-01	90-02-30	15.500
D53-25	61572.890	-12.193	-6746.930	-14.542	82265.317490	-895392.966380	175-15-31	89-57-30	10.961
D53-26	61561.967	-10.894	-6746.024	1.258	73491.185456	77444.954486	85-17-25	90-01-54	0.353
D53-28	61561.996	1.270	-6745.672	15.448	-8567.003440	951009.714208	85-18-02	180-00-37	15.147
合計				倍面積	339.777296	-339.777296			52.922
				面積	169.8886480	169.8886480			
				坪数	51.39	51.39			

面積（座標法）計算書

地番：53D-3

測点名	[1] X(i)	[2] X(i+1)-X(i-1)	[3] Y(i)	[4] Y(i+1)-Y(i-1)	[2]*[3]	[1]*[4]	方向角	夾角	距離
D53-30	61537.910	-23.881	-6743.704	12.457	161046.395224	766577.744870	91-45-24	96-25-41	10.537
D53-19	61537.587	-0.329	-6733.172	10.735	2215.213588	660605.996445	91-41-35	179-56-11	0.203
DK47	61537.581	0.184	-6732.969	1.200	-1238.866296	73845.097200	79-12-38	167-31-03	1.015
D53-20	61537.771	3.717	-6731.972	4.186	-25022.739924	257597.109406	42-07-08	142-54-30	4.755
D53-14	61541.298	25.466	-6728.783	1.396	-171355.187878	85911.652008	355-19-40	133-12-32	22.012
D53-23	61563.237	20.698	-6730.576	-16.889	-139309.462048	-1039741.509693	265-18-02	89-58-22	15.147
D53-28	61561.996	-1.769	-6745.672	-15.053	11933.093768	-926692.725788	175-20-39	90-02-37	0.530
D53-29	61561.468	-24.086	-6745.629	1.968	162475.220094	121152.969024	175-19-43	179-59-04	23.637
合計				倍面積	743.666528	-743.666528			77.836
				面積	371.8332640	371.8332640			
				坪数	112.47	112.47			

面積（座標法）計算書

地番：53D-4

測点名	[1] X(i)	[2] X(i+1)-X(i-1)	[3] Y(i)	[4] Y(i+1)-Y(i-1)	[2]*[3]	[1]*[4]	方向角	夾角	距離
D53-31	61560.125	0.814	-6761.961	16.375	-5504.236254	1008047.046875	85-17-57	89-56-47	16.387
D53-29	61561.468	1.871	-6745.629	16.289	-12621.071859	1002774.752252	355-20-39	90-02-42	0.530
D53-28	61561.996	0.499	-6745.672	-0.395	-3366.090328	-24316.988420	265-17-25	89-56-46	0.353
D53-26	61561.967	-1.342	-6746.024	-16.332	9053.164208	-1005430.045044	265-18-10	180-00-45	16.034
D53-21	61560.654	-1.842	-6762.004	-15.937	12455.611368	-981092.142798	175-21-10	90-03-00	0.531
合計				倍面積	17.377135	-17.377135			33.835
				面積	8.6885675	8.6885675			
				坪数	2.62	2.62			

面積（座標法）計算書

地番：53D-5

測点名	[1] X(i)	[2] X(i+1)-X(i-1)	[3] Y(i)	[4] Y(i+1)-Y(i-1)	[2]*[3]	[1]*[4]	方向角	夾角	距離
D53-3	61541.955	-21.638	-6760.479	4.925	146283.244602	303094.128375	135-12-26	139-52-12	4.887
D53-17	61538.487	-3.815	-6757.036	9.278	25778.092340	570954.082386	93-24-12	138-11-46	5.845
DK46	61538.140	-0.577	-6751.201	13.332	3895.442977	820426.482480	91-45-26	178-21-14	7.501
D53-30	61537.910	23.328	-6743.704	5.572	-157317.126912	342889.234520	355-19-43	83-34-17	23.637
D53-29	61561.468	22.215	-6745.629	-18.257	-149854.148235	-1123927.721276	265-17-57	89-58-14	16.387
D53-31	61560.125	-19.513	-6761.961	-14.850	131946.144993	-914167.856250	175-20-14	90-02-17	18.230
合計				倍面積	731.649765	-731.649765			76.487
				面積	365.8248825	365.8248825			
				坪数	110.66	110.66			