



出来形確認測量図（縮尺１：２５０）

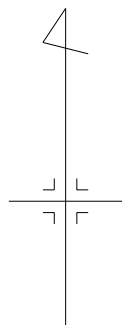

座 標 一 覧 表

測 点 名	X 座 標	Y 座 標
D55-1	61662.084	-6665.843
D55-2	61659.025	-6669.800
D55-3	61628.457	-6675.363
D55-4	61624.385	-6672.458
D55-5	61619.579	-6639.872
D55-6	61622.491	-6635.825
D55-7	61645.568	-6631.804
D55-8	61656.160	-6633.068
D55-9	61659.639	-6636.667
D55-10	61659.359	-6669.355
D55-11	61656.872	-6639.543
D55-12	61654.305	-6636.877
D55-13	61645.652	-6635.848
D55-14	61640.800	-6636.693
D55-15	61640.476	-6634.732
D55-16	61620.818	-6638.147
D55-17	61640.153	-6632.751
D55-18	61659.712	-6637.521
D55-21	61659.186	-6667.276
D55-22	61656.760	-6667.718
D55-23	61656.965	-6670.175
D55-24	61653.834	-6670.745
D55-26	61645.878	-6672.194
D55-27	61640.691	-6673.139
D55-32	61622.579	-6660.230
D55-34	61622.022	-6656.425
D55-35	61621.593	-6653.500
D55-39	61635.189	-6635.635
D55-41	61648.768	-6636.219
D55-52	61638.448	-6657.886
D55-54	61637.885	-6654.082
D55-55	61637.455	-6651.172
D55-64	61635.210	-6674.135
D55-65	61623.001	-6663.110
D55-66	61633.366	-6661.579
D55-67	61637.516	-6673.716
D55-68	61635.683	-6661.237
D55-69	61638.874	-6660.766
D55-70	61661.419	-6658.118

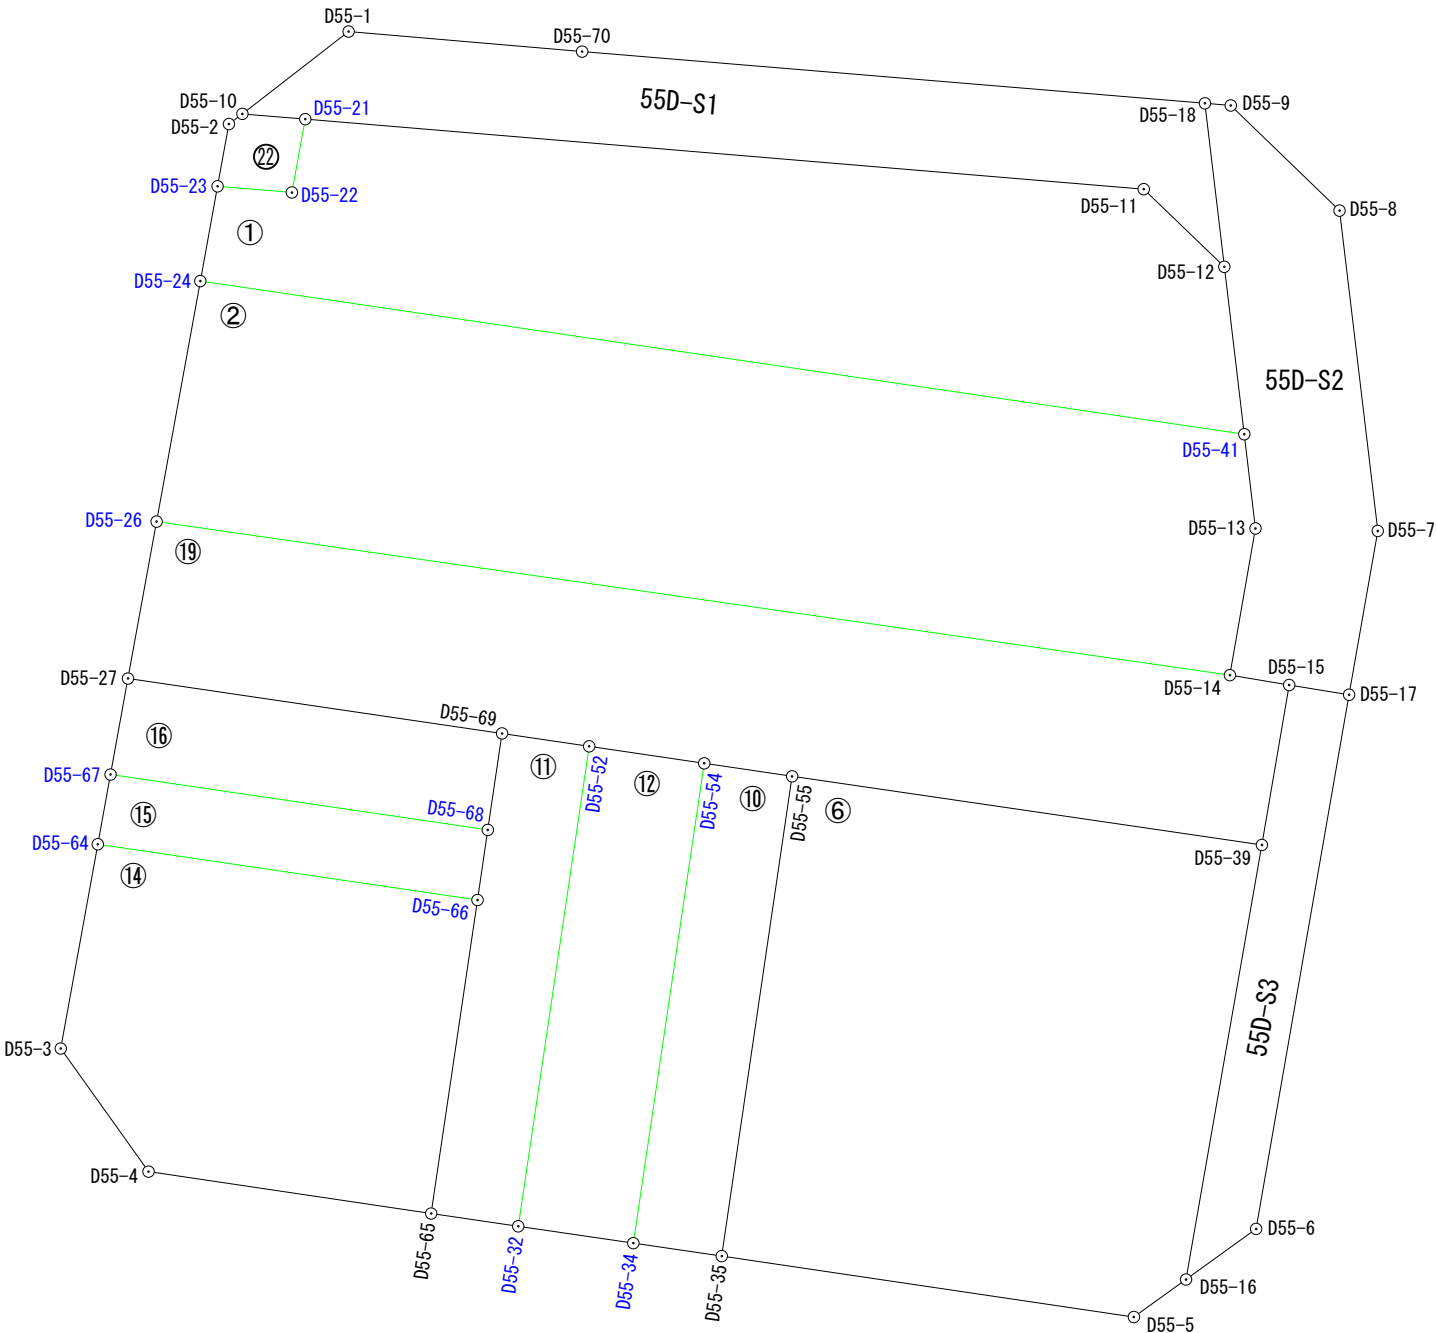

凡 例	
	施工地区界
	道 路
	街区番号
	画地番号
D14-1	計 算 点
D14-2	境界標あり

平成24年10月25日測量
平成24年10月24日測量
平成24年10月23日測量
平成23年12月15日測量
平成23年12月14日測量
平成23年12月13日測量

面積（座標法）計算書

地 番： 55D-1

測点名	[1] X(i)	[2] X(i+1)-X(i-1)	[3] Y(i)	[4] Y(i+1)-Y(i-1)	[2]*[3]	[1]*[4]	方向角	夾 角	距 離
D55-21	61659.186	-0.112	-6667.276	-28.175	746.734912	-1737247.565550	190-19-32	95-33-21	2.466
D55-22	61656.760	-2.221	-6667.718	-2.899	14809.001678	-178742.947240	274-46-10	264-26-38	2.466
D55-23	61656.965	-2.926	-6670.175	-3.027	19516.932050	-186635.633055	190-19-04	95-32-54	3.182
D55-24	61653.834	-8.197	-6670.745	33.956	54680.096765	2093517.587304	98-20-51	88-01-47	34.896
D55-41	61648.768	0.471	-6636.219	33.868	-3125.659149	2087920.474624	353-13-23	74-52-32	5.576
D55-12	61654.305	8.104	-6636.877	-3.324	-53785.251208	-204938.909820	313-54-58	140-41-35	3.701
D55-11	61656.872	4.881	-6639.543	-30.399	-32407.609383	-1874307.251928	274-46-11	140-51-13	27.829
合計				倍面積	434.245665	-434.245665			80.116
				面 積	217.1228325	217.1228325			
				坪 数	65.67	65.67			

面積（座標法）計算書

地番：55D-2

測点名	[1] X(i)	[2] X(i+1)-X(i-1)	[3] Y(i)	[4] Y(i+1)-Y(i-1)	[2]*[3]	[1]*[4]	方向角	夾角	距離
D55-24	61653.834	-2.890	-6670.745	-35.975	19278.453050	-2217996.678150	190-19-19	91-58-28	8.087
D55-26	61645.878	-13.034	-6672.194	34.052	86965.376596	2099165.437656	98-08-25	87-49-06	35.862
D55-14	61640.800	-0.226	-6636.693	36.346	1499.892618	2240396.516800	9-52-45	91-44-20	4.925
D55-13	61645.652	7.968	-6635.848	0.474	-52874.436864	29220.039048	353-12-37	163-19-52	3.138
D55-41	61648.768	8.182	-6636.219	-34.897	-54297.543858	-2151357.056896	278-20-51	105-08-14	34.896
合計				倍面積	571.741542	-571.741542			86.908
				面積	285.8707710	285.8707710			
				坪数	86.47	86.47			

面積（座標法）計算書

地番：55D-6

測点名	[1] X(i)	[2] X(i+1)-X(i-1)	[3] Y(i)	[4] Y(i+1)-Y(i-1)	[2]*[3]	[1]*[4]	方向角	夾角	距離
D55-55	61637.455	-13.596	-6651.172	-17.865	90429.334512	-1101153.133575	188-20-58	90-03-06	16.032
D55-35	61621.593	-17.876	-6653.500	11.300	118937.966000	696324.000900	98-24-24	90-03-26	13.776
D55-5	61619.579	-0.775	-6639.872	15.353	5145.900800	946045.396387	54-18-42	135-54-18	2.124
D55-16	61620.818	15.610	-6638.147	4.237	-103621.474670	261087.405866	9-54-54	135-36-12	14.589
D55-39	61635.189	16.637	-6635.635	-13.025	-110397.059495	-802798.336725	278-17-52	88-22-58	15.701
合計				倍面積	494.667147	-494.667147			62.222
				面積	247.3335735	247.3335735			
				坪数	74.81	74.81			

面積（座標法）計算書

地番：55D-10

測点名	[1] X(i)	[2] X(i+1)-X(i-1)	[3] Y(i)	[4] Y(i+1)-Y(i-1)	[2]*[3]	[1]*[4]	方向角	夾角	距離
D55-54	61637.885	-15.433	-6654.082	-5.253	102692.447506	-323783.809905	188-24-07	89-59-47	16.035
D55-34	61622.022	-16.292	-6656.425	0.582	108446.476100	35864.016804	98-20-38	89-56-31	2.956
D55-35	61621.593	15.433	-6653.500	5.253	-102683.465500	323698.228029	8-20-58	90-00-20	16.032
D55-55	61637.455	16.292	-6651.172	-0.582	-108360.894224	-35872.998810	278-24-20	90-03-22	2.942
合計				倍面積	94.563882	-94.563882			37.965
				面積	47.2819410	47.2819410			
				坪数	14.30	14.30			

面積（座標法）計算書

地番：55D-11

測点名	[1] X(i)	[2] X(i+1)-X(i-1)	[3] Y(i)	[4] Y(i+1)-Y(i-1)	[2]*[3]	[1]*[4]	方向角	夾角	距離
D55-69	61638.874	-2.765	-6660.766	-3.351	18417.017990	-206551.866774	188-23-47	89-58-57	3.226
D55-68	61635.683	-5.508	-6661.237	-0.813	36690.093396	-50109.810279	188-23-47	180-00-00	2.342
D55-66	61633.366	-12.682	-6661.579	-1.873	84482.144878	-115439.294518	188-24-08	180-00-21	10.477
D55-65	61623.001	-10.787	-6663.110	1.349	71874.967570	83129.428349	98-20-10	89-56-02	2.911
D55-32	61622.579	15.447	-6660.230	5.224	-102880.572810	321916.352696	8-24-09	90-03-59	16.041
D55-52	61638.448	16.295	-6657.886	-0.536	-108490.252370	-33038.208128	278-24-50	90-00-41	2.911
合計				倍面積	93.398654	-93.398654			37.908
				面積	46.6993270	46.6993270			
				坪数	14.12	14.12			

面積（座標法）計算書

地番：55D-12

測点名	[1] X(i)	[2] X(i+1)-X(i-1)	[3] Y(i)	[4] Y(i+1)-Y(i-1)	[2]*[3]	[1]*[4]	方向角	夾角	距離
D55-52	61638.448	-15.306	-6657.886	-6.148	101905.603116	-378953.178304	188-24-09	89-59-01	16.041
D55-32	61622.579	-16.426	-6660.230	1.461	109400.937980	90030.587919	98-19-41	89-55-32	3.846
D55-34	61622.022	15.306	-6656.425	6.148	-101883.241050	378852.191256	8-24-07	90-04-26	16.035
D55-54	61637.885	16.426	-6654.082	-1.461	-109299.950932	-90052.949985	278-25-08	90-01-01	3.845
合計				倍面積	123.349114	-123.349114			39.767
				面積	61.6745570	61.6745570			
				坪数	18.65	18.65			

面積（座標法）計算書

地番：55D-14

測点名	[1] X(i)	[2] X(i+1)-X(i-1)	[3] Y(i)	[4] Y(i+1)-Y(i-1)	[2]*[3]	[1]*[4]	方向角	夾角	距離
D55-64	61635.210	-4.909	-6674.135	-13.784	32763.328715	-849579.734640	190-18-23	91-57-06	6.864
D55-3	61628.457	-10.825	-6675.363	1.677	72260.804475	103350.922389	144-29-44	134-11-21	5.002
D55-4	61624.385	-5.456	-6672.458	12.253	36404.930848	755083.589405	98-25-18	133-55-34	9.450
D55-65	61623.001	8.981	-6663.110	10.879	-59841.390910	670396.627879	8-24-08	89-58-50	10.477
D55-66	61633.366	12.209	-6661.579	-11.025	-81331.218011	-679507.860150	278-21-17	89-57-09	12.691
合計				倍面積	256.455117	-256.455117			44.484
				面積	128.2275585	128.2275585			
				坪数	38.78	38.78			

面積（座標法）計算書

地番：55D-15

測点名	[1] X(i)	[2] X(i+1)-X(i-1)	[3] Y(i)	[4] Y(i+1)-Y(i-1)	[2]*[3]	[1]*[4]	方向角	夾角	距離
D55-67	61637.516	-0.473	-6673.716	-12.898	3156.667668	-795000.681368	190-17-54	91-56-32	2.344
D55-64	61635.210	-4.150	-6674.135	12.137	27697.660250	748066.543770	98-21-17	88-03-23	12.691
D55-66	61633.366	0.473	-6661.579	12.898	-3150.926867	794947.154668	8-23-47	90-02-30	2.342
D55-68	61635.683	4.150	-6661.237	-12.137	-27644.133550	-748072.284571	278-21-22	89-57-35	12.613
合計				倍面積	59.267501	-59.267501			29.990
				面積	29.6337505	29.6337505			
				坪数	8.96	8.96			

面積（座標法）計算書

地番：55D-16

測点名	[1] X(i)	[2] X(i+1)-X(i-1)	[3] Y(i)	[4] Y(i+1)-Y(i-1)	[2]*[3]	[1]*[4]	方向角	夾角	距離
D55-27	61640.691	-1.358	-6673.139	-12.950	9062.122762	-798246.948450	190-18-00	91-56-45	3.227
D55-67	61637.516	-5.008	-6673.716	11.902	33421.969728	733609.715432	98-21-22	88-03-22	12.613
D55-68	61635.683	1.358	-6661.237	12.950	-9045.959846	798182.094850	8-23-47	90-02-25	3.226
D55-69	61638.874	5.008	-6660.766	-11.902	-33357.116128	-733625.878348	278-21-15	89-57-28	12.506
合計				倍面積	81.016516	-81.016516			31.572
				面積	40.5082580	40.5082580			
				坪数	12.25	12.25			

面積（座標法）計算書

地番：55D-19

測点名	[1] X(i)	[2] X(i+1)-X(i-1)	[3] Y(i)	[4] Y(i+1)-Y(i-1)	[2]*[3]	[1]*[4]	方向角	夾角	距離
D55-26	61645.878	-0.109	-6672.194	-36.446	727.269146	-2246745.669588	190-19-31	92-11-06	5.272
D55-27	61640.691	-7.004	-6673.139	11.428	46738.665556	704429.816748	98-21-15	88-01-44	12.506
D55-69	61638.874	-2.243	-6660.766	15.253	14940.098138	940177.745122	98-24-50	180-03-35	2.911
D55-52	61638.448	-0.989	-6657.886	6.684	6584.649254	411991.386432	98-25-08	180-00-18	3.845
D55-54	61637.885	-0.993	-6654.082	6.714	6607.503426	413836.759890	98-24-20	179-59-12	2.942
D55-55	61637.455	-2.696	-6651.172	18.447	17931.559712	1137026.132385	98-17-52	179-53-32	15.701
D55-39	61635.189	3.021	-6635.635	16.440	-20046.253335	1013282.507160	9-41-33	91-23-41	5.364
D55-15	61640.476	5.611	-6634.732	-1.058	-37227.481252	-65215.623608	279-22-54	89-41-21	1.988
D55-14	61640.800	5.402	-6636.693	-37.462	-35851.415586	-2309187.649600	278-08-25	178-45-31	35.862
合計				倍面積	404.595059	-404.595059			86.391
				面積	202.2975295	202.2975295			
				坪数	61.19	61.19			

面積（座標法）計算書

地番：55D-22

測点名	[1] X(i)	[2] X(i+1)-X(i-1)	[3] Y(i)	[4] Y(i+1)-Y(i-1)	[2]*[3]	[1]*[4]	方向角	夾角	距離
D55-10	61659.359	-0.161	-6669.355	-2.524	1073.766155	-155628.222116	233-06-34	138-21-10	0.556
D55-2	61659.025	-2.394	-6669.800	-0.820	15967.501200	-50560.400500	190-19-02	137-12-28	2.094
D55-23	61656.965	-2.265	-6670.175	2.082	15107.946375	128369.801130	94-46-10	84-27-08	2.466
D55-22	61656.760	2.221	-6667.718	2.899	-14809.001678	178742.947240	10-19-32	95-33-22	2.466
D55-21	61659.186	2.599	-6667.276	-1.637	-17328.250324	-100936.087482	274-45-24	84-25-52	2.086
合計				倍面積	11.961728	-11.961728			9.668
				面積	5.9808640	5.9808640			
				坪数	1.80	1.80			

面積（座標法）計算書

地 番： 55D-S1

測点名	[1] X(i)	[2] X(i+1)-X(i-1)	[3] Y(i)	[4] Y(i+1)-Y(i-1)	[2]*[3]	[1]*[4]	方向角	夾 角	距 離
D55-1	61662.084	-2.060	-6665.843	-11.237	13731.636580	-692896.837908	232-11-30	137-16-18	4.445
D55-10	61659.359	-2.898	-6669.355	-1.433	19327.790790	-88357.861447	94-45-24	42-33-54	2.086
D55-21	61659.186	-2.487	-6667.276	29.812	16581.515412	1838183.653032	94-46-11	180-00-47	27.829
D55-11	61656.872	-4.881	-6639.543	30.399	32407.609383	1874307.251928	133-54-58	219-08-47	3.701
D55-12	61654.305	2.840	-6636.877	2.022	-18848.730680	124665.004710	353-12-28	39-17-30	5.445
D55-18	61659.712	7.114	-6637.521	-21.241	-47219.324394	-1309713.942592	274-44-15	101-31-47	20.668
D55-70	61661.419	2.372	-6658.118	-28.322	-15793.055896	-1746374.708918	274-55-12	180-10-57	7.754
合計				倍面積	187.441195	-187.441195			71.928
				面 積	93.7205975	93.7205975			
				坪 数	28.35	28.35			

面積（座標法）計算書

地番：55D-S2

測点名	[1] X(i)	[2] X(i+1)-X(i-1)	[3] Y(i)	[4] Y(i+1)-Y(i-1)	[2]*[3]	[1]*[4]	方向角	夾角	距離
D55-18	61659.712	-5.334	-6637.521	-0.210	35404.537014	-12948.539520	173-12-28	78-19-19	5.445
D55-12	61654.305	-10.944	-6636.877	1.302	72633.981888	80273.905110	173-13-23	180-00-55	5.576
D55-41	61648.768	-8.653	-6636.219	1.029	57423.203007	63436.582272	173-12-37	179-59-14	3.138
D55-13	61645.652	-7.968	-6635.848	-0.474	52874.436864	-29220.039048	189-52-45	196-40-08	4.925
D55-14	61640.800	-5.176	-6636.693	1.116	34351.522968	68791.132800	99-22-54	89-30-09	1.988
D55-15	61640.476	-0.647	-6634.732	3.942	4292.671604	242986.756392	99-15-38	179-52-44	2.007
D55-17	61640.153	5.092	-6632.751	2.928	-33773.968092	180482.367984	9-55-11	90-39-33	5.497
D55-7	61645.568	16.007	-6631.804	-0.317	-106155.286628	-19541.645056	353-11-41	163-16-30	10.667
D55-8	61656.160	14.071	-6633.068	-4.863	-93333.899828	-299833.906080	314-01-43	140-50-02	5.006
D55-9	61659.639	3.552	-6636.667	-4.453	-23573.441184	-274570.372467	274-53-09	140-51-26	0.857
合計				倍面積	143.757613	-143.757613			45.106
				面積	71.8788065	71.8788065			
				坪数	21.74	21.74			

面積（座標法）計算書

地番：55D-S3

測点名	[1] X(i)	[2] X(i+1)-X(i-1)	[3] Y(i)	[4] Y(i+1)-Y(i-1)	[2]*[3]	[1]*[4]	方向角	夾角	距離
D55-15	61640.476	-4.964	-6634.732	-2.884	32934.809648	-177771.132784	189-41-33	90-25-55	5.364
D55-39	61635.189	-19.658	-6635.635	-3.415	130443.312830	-210484.170435	189-54-54	180-13-21	14.589
D55-16	61620.818	-12.698	-6638.147	-0.190	84291.190606	-11707.955420	54-13-38	44-18-44	2.862
D55-6	61622.491	19.335	-6635.825	5.396	-128303.676375	332514.961436	9-52-24	135-38-46	17.928
D55-17	61640.153	17.985	-6632.751	1.093	-119290.026735	67372.687229	279-15-38	89-23-14	2.007
合計				倍面積	75.609974	-75.609974			42.750
				面積	37.8049870	37.8049870			
				坪数	11.43	11.43			