



出来形確認測量図（縮尺１：２５０）

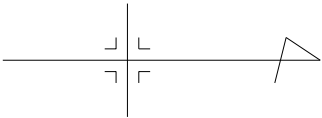

座 標 一 覧 表

測 点 名	X	座 標	Y	座 標
D58-1		61708.692		-6632.568
D58-2		61707.941		-6633.227
D58-3		61651.106		-6626.402
D58-4		61647.463		-6622.977
D58-5		61641.991		-6592.963
D58-6		61642.589		-6592.167
D58-7		61643.960		-6592.060
D58-8		61646.939		-6591.858
D58-9		61649.897		-6591.680
D58-10		61652.856		-6591.544
D58-11		61655.820		-6591.449
D58-12		61658.783		-6591.394
D58-13		61660.249		-6591.379
D58-14		61665.052		-6591.321
D58-15		61685.736		-6592.106
D58-16		61709.592		-6594.997
D58-17		61710.247		-6595.774
D58-18		61709.323		-6614.285
D58-19		61709.269		-6615.454
D58-20		61709.048		-6620.518
D58-21		61708.862		-6625.588
D58-22		61708.731		-6630.656
D58-26		61664.251		-6628.001
D58-27		61647.062		-6620.752
D58-28		61646.565		-6617.999
D58-29		61657.589		-6591.410
D58-38		61662.429		-6617.984
D58-39		61661.928		-6615.234
D58-42		61676.621		-6591.760
D58-43		61675.214		-6629.313
D58-44		61683.215		-6592.011
D58-45		61681.788		-6630.099
D58-46		61708.811		-6627.530
D58-47		61681.925		-6626.443
D58-48		61681.899		-6627.133
D58-49		61708.794		-6628.220
D58-50		61664.943		-6628.084

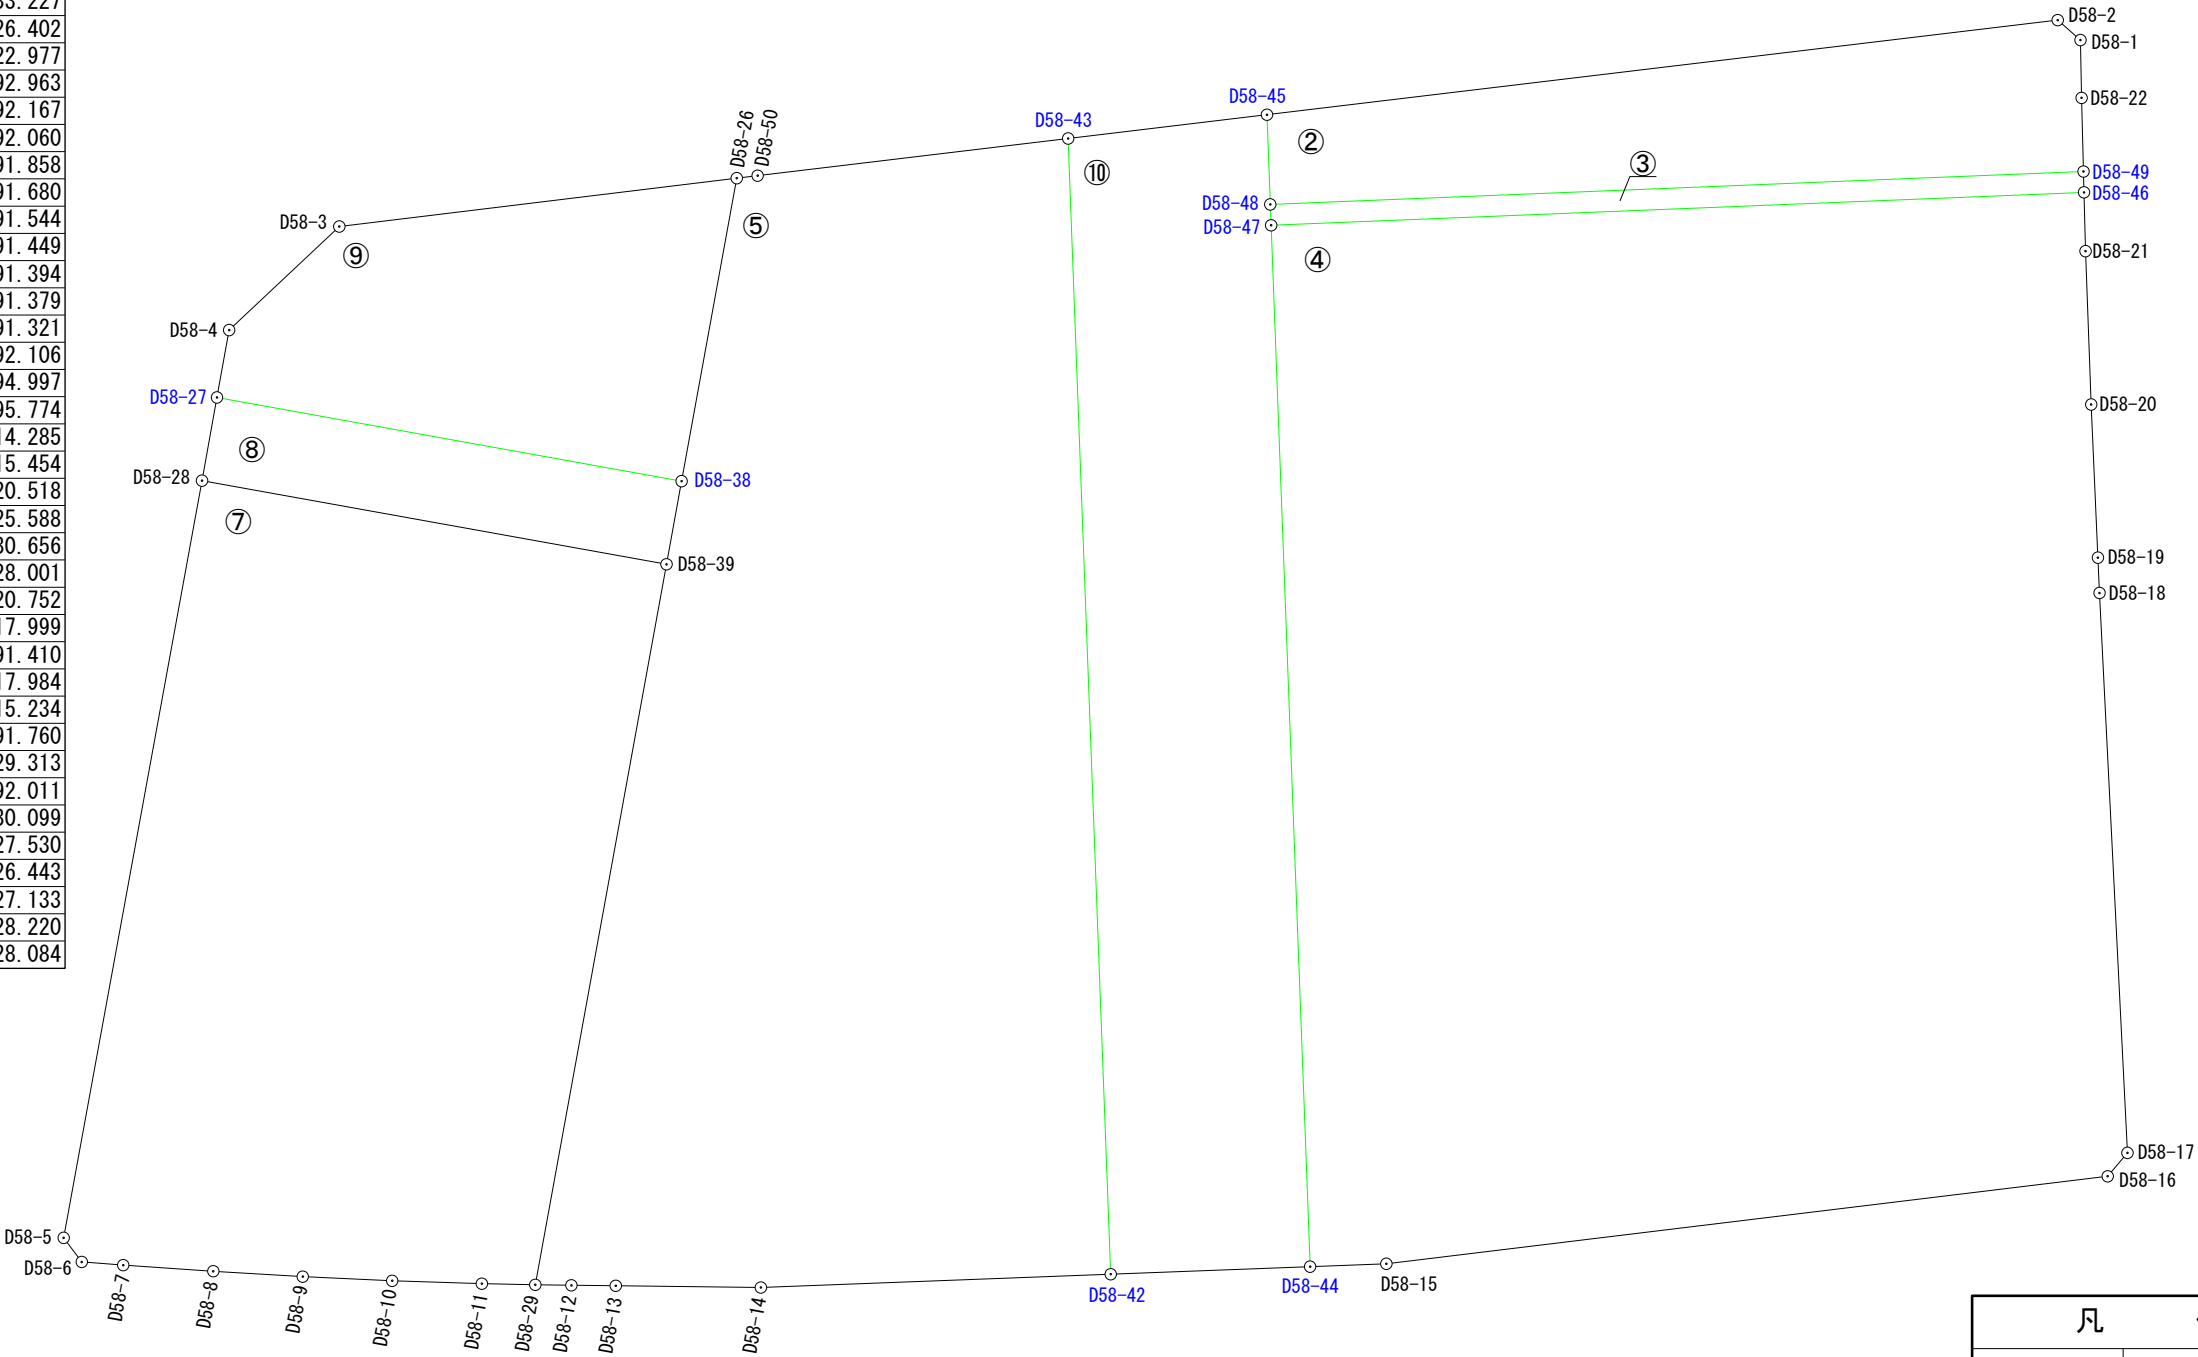

凡 例	
	施工地区界
	道 路
	街区番号
	画地番号
D14-1	計 算 点
D14-2	境界標あり

平成24年10月26日測量
平成23年12月16日測量
平成23年12月15日測量

面積（座標法）計算書

地 番： 58D-2

測点名	[1] X(i)	[2] X(i+1)-X(i-1)	[3] Y(i)	[4] Y(i+1)-Y(i-1)	[2]*[3]	[1]*[4]	方向角	夾 角	距 離
D58-45	61681.788	-26.042	-6630.099	6.094	172661.038158	375888.816072	87-51-24	94-40-37	2.968
D58-48	61681.899	27.006	-6627.133	1.879	-178972.353798	115900.288221	357-41-08	89-49-44	26.917
D58-49	61708.794	26.832	-6628.220	-3.523	-177848.399040	-217400.081262	268-31-07	90-49-59	2.437
D58-22	61708.731	-0.102	-6630.656	-4.348	676.326912	-268309.562388	268-49-53	180-18-46	1.912
D58-1	61708.692	-0.790	-6632.568	-2.571	5239.728720	-158653.047132	221-16-01	132-26-08	0.999
D58-2	61707.941	-26.904	-6633.227	2.469	178460.339208	152356.906329	173-10-47	131-54-46	26.339
合計				倍面積	216.680160	-216.680160			61.572
				面 積	108.3400800	108.3400800			
				坪 数	32.77	32.77			

面積（座標法）計算書

地番：58D-3

測点名	[1] X(i)	[2] X(i+1)-X(i-1)	[3] Y(i)	[4] Y(i+1)-Y(i-1)	[2]*[3]	[1]*[4]	方向角	夾角	距離
D58-48	61681.899	-26.869	-6627.133	1.777	178064.436577	109608.734523	87-50-31	90-09-23	0.690
D58-47	61681.925	26.912	-6626.443	-0.397	-178330.834016	-24487.724225	357-41-05	89-50-34	26.908
D58-46	61708.811	26.869	-6627.530	-1.777	-178075.103570	-109656.557147	268-35-19	90-54-14	0.690
D58-49	61708.794	-26.912	-6628.220	0.397	178378.656640	24498.391218	177-41-08	89-05-49	26.917
合計				倍面積	37.155631	-37.155631			55.205
				面積	18.5778155	18.5778155			
				坪数	5.61	5.61			

面積（座標法）計算書

地番：58D-4

測点名	[1] X(i)	[2] X(i+1)-X(i-1)	[3] Y(i)	[4] Y(i+1)-Y(i-1)	[2]*[3]	[1]*[4]	方向角	夾角	距離
D58-47	61681.925	-25.596	-6626.443	35.519	169610.435028	2190880.294075	87-51-16	90-10-11	34.456
D58-44	61683.215	3.811	-6592.011	34.337	-25122.153921	2118016.553455	357-50-31	89-59-15	2.523
D58-15	61685.736	26.377	-6592.106	-2.986	-173879.979962	-184193.607696	353-05-25	175-14-54	24.031
D58-16	61709.592	24.511	-6594.997	-3.668	-161649.971467	-226350.783456	310-07-49	137-02-24	1.016
D58-17	61710.247	-0.269	-6595.774	-19.288	1774.263206	-1190267.244136	267-08-33	137-00-44	18.534
D58-18	61709.323	-0.978	-6614.285	-19.680	6468.770730	-1214439.476640	267-21-19	180-12-46	1.170
D58-19	61709.269	-0.275	-6615.454	-6.233	1819.249850	-384633.873677	267-30-04	180-08-45	5.069
D58-20	61709.048	-0.407	-6620.518	-10.134	2694.550826	-625359.492432	267-53-56	180-23-52	5.073
D58-21	61708.862	-0.237	-6625.588	-7.012	1570.264356	-432702.540344	268-29-44	180-35-48	1.943
D58-46	61708.811	-26.937	-6627.530	-0.855	178525.775610	-52761.033405	177-41-05	89-11-21	26.908
合計				倍面積	1811.204256	-1811.204256			120.723
				面積	905.6021280	905.6021280			
				坪数	273.94	273.94			

面積（座標法）計算書

地番：58D-5

測点名	[1] X(i)	[2] X(i+1)-X(i-1)	[3] Y(i)	[4] Y(i+1)-Y(i-1)	[2]*[3]	[1]*[4]	方向角	夾角	距離
D58-26	61664.251	-2.514	-6628.001	10.100	16662.794514	622808.935100	100-18-32	107-08-54	10.181
D58-38	61662.429	-2.323	-6617.984	12.767	15373.576832	787244.231043	100-19-30	180-00-58	2.795
D58-39	61661.928	-4.840	-6615.234	26.574	32017.732560	1638604.074672	100-19-19	179-59-49	24.216
D58-29	61657.589	-3.145	-6591.410	23.840	20729.984450	1469916.921760	0-46-04	80-26-45	1.194
D58-12	61658.783	2.660	-6591.394	0.031	-17533.108040	1911.422273	0-35-10	179-49-06	1.466
D58-13	61660.249	6.269	-6591.379	0.073	-41321.354951	4501.198177	0-41-31	180-06-21	4.803
D58-14	61665.052	16.372	-6591.321	-0.381	-107913.107412	-23494.384812	357-49-37	177-08-06	11.577
D58-42	61676.621	10.162	-6591.760	-37.992	-66985.465120	-2343218.185032	267-51-15	90-01-38	37.579
D58-43	61675.214	-11.678	-6629.313	-36.324	77417.117214	-2240290.473336	173-10-36	85-19-21	10.344
D58-50	61664.943	-10.963	-6628.084	1.312	72663.684892	80904.405216	173-09-38	179-59-02	0.697
合計				倍面積	1111.854939	-1111.854939			104.852
				面積	555.9274695	555.9274695			
				坪数	168.16	168.16			

面積（座標法）計算書

地番：58D-7

測点名	[1] X(i)	[2] X(i+1)-X(i-1)	[3] Y(i)	[4] Y(i+1)-Y(i-1)	[2]*[3]	[1]*[4]	方向角	夾角	距離
D58-28	61646.565	-19.937	-6617.999	22.271	131943.046063	1372930.649115	100-21-13	90-09-03	25.450
D58-5	61641.991	-3.976	-6592.963	25.832	26213.620888	1592335.911512	53-05-03	132-43-50	0.996
D58-6	61642.589	1.969	-6592.167	0.903	-12979.976823	55663.257867	4-27-45	131-22-42	1.375
D58-7	61643.960	4.350	-6592.060	0.309	-28675.461000	19047.983640	3-52-45	179-25-00	2.986
D58-8	61646.939	5.937	-6591.858	0.380	-39135.860946	23425.836820	3-26-37	179-33-52	2.963
D58-9	61649.897	5.917	-6591.680	0.314	-39002.970560	19358.067658	2-37-54	179-11-17	2.962
D58-10	61652.856	5.923	-6591.544	0.231	-39041.715112	14241.809736	1-50-09	179-12-15	2.966
D58-11	61655.820	4.733	-6591.449	0.134	-31197.328117	8261.879880	1-15-47	179-25-38	1.769
D58-29	61657.589	6.108	-6591.410	-23.785	-40260.332280	-1466525.754365	280-19-19	99-03-32	24.216
D58-39	61661.928	-11.024	-6615.234	-26.589	72926.339616	-1639529.003592	190-12-10	89-52-51	15.610
合計				倍面積	789.361729	-789.361729			81.293
				面積	394.6808645	394.6808645			
				坪数	119.39	119.39			

面積（座標法）計算書

地 番： 58D-8

測点名	[1] X(i)	[2] X(i+1)-X(i-1)	[3] Y(i)	[4] Y(i+1)-Y(i-1)	[2]*[3]	[1]*[4]	方向角	夾 角	距 離
D58-27	61647.062	-15.864	-6620.752	-0.015	105031.609728	-924.705930	100-14-00	90-01-20	2.798
D58-28	61646.565	14.866	-6617.999	5.518	-98383.173134	340165.745670	10-12-10	89-58-10	15.610
D58-39	61661.928	15.864	-6615.234	0.015	-104944.072176	924.928920	280-19-30	90-07-20	2.795
D58-38	61662.429	-14.866	-6617.984	-5.518	98382.950144	-340253.283222	190-12-40	89-53-10	15.614
合計				倍面積	87.314562	-87.314562			36.817
				面 積	43.6572810	43.6572810			
				坪 数	13.20	13.20			

面積（座標法）計算書

地番：58D-9

測点名	[1] X(i)	[2] X(i+1)-X(i-1)	[3] Y(i)	[4] Y(i+1)-Y(i-1)	[2]*[3]	[1]*[4]	方向角	夾角	距離
D58-3	61651.106	-16.788	-6626.402	5.024	111244.036776	309735.156544	136-46-00	143-42-08	5.000
D58-4	61647.463	-4.044	-6622.977	5.650	26783.318988	348308.165950	100-12-59	143-26-59	2.261
D58-27	61647.062	14.966	-6620.752	4.993	-99086.174432	307803.780566	10-12-40	89-59-41	15.614
D58-38	61662.429	17.189	-6617.984	-7.249	-113756.526976	-446990.947821	280-18-32	90-05-52	10.181
D58-26	61664.251	-11.323	-6628.001	-8.418	75048.855323	-519089.664918	173-03-52	72-45-20	13.242
合計				倍面積	233.509679	-233.509679			46.298
				面積	116.7548395	116.7548395			
				坪数	35.31	35.31			

面積（座標法）計算書

地番：58D-10

測点名	[1] X(i)	[2] X(i+1)-X(i-1)	[3] Y(i)	[4] Y(i+1)-Y(i-1)	[2]*[3]	[1]*[4]	方向角	夾角	距離
D58-43	61675.214	-5.167	-6629.313	38.339	34253.660271	2364566.029546	87-51-15	94-40-20	37.579
D58-42	61676.621	8.001	-6591.760	37.302	-52740.671760	2300661.316542	357-49-12	89-57-57	6.599
D58-44	61683.215	5.304	-6592.011	-34.683	-34964.026344	-2139358.945845	267-51-16	90-02-04	34.456
D58-47	61681.925	-1.316	-6626.443	-35.122	8720.398988	-2166392.569850	267-50-31	179-59-15	0.690
D58-48	61681.899	-0.137	-6627.133	-3.656	907.917221	-225509.022744	267-51-24	180-00-53	2.968
D58-45	61681.788	-6.685	-6630.099	-2.180	44322.211815	-134466.297840	173-10-55	85-19-31	6.621
合計				倍面積	499.490191	-499.490191			88.913
				面積	249.7450955	249.7450955			
				坪数	75.54	75.54			